


1218

C. B. Edwards Subdivision of Lot 190 of Bramble Farm Detroit Michigan 1854

I C. B. Edwards approve and adopt the annexed Plat of C. B. Edwards Subdivision of Lot No One hundred and ninety of the Lambert Bramble Farm on the West side of Bramble Street and North of the Gratiot Road and authorize the same to be recorded October 10 1854 In presence of C. H. Garrison

Chas. B. Edwards

Survey by the above Plat to be correct from actual calculation and survey Oct 10 1854 John J. Moore Surveyor

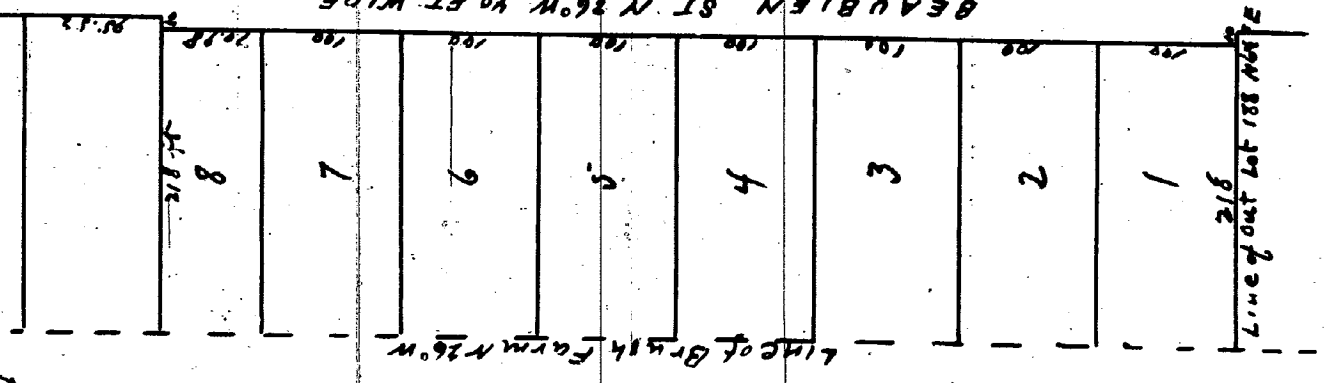

Rec'd for Record this 10th October 1854 at 12 o'clock from Henry Campbell Reg.


State of Michigan } Be it remembered that on this 10th day of October A.D. 1854 before me a Notary Public in and for said County and State personally came C. B. Edwards known to me to be the person who executed the annexed Plat and acknowledged the same to be his free act and will and with a view and for the purpose to have the same recorded according to Law C. H. Garrison Notary Public Wayne County Michigan

I hereby certify that this plat is a correct copy of the plat now on record in the Register of Deeds office, being made under the supervision of the Auditor General by tracing the plat on record and affixing thereto a carefully compared copy of the dedication and certificate.

Dated this 10th day of May 1910 Geo. W. Bennett Clerk Aud. Genl. Dept.

Plat of the Subdivision of the Louis Moran farm between Fort and Elizabeth Streets.

Common Council 2-17-62 670-62

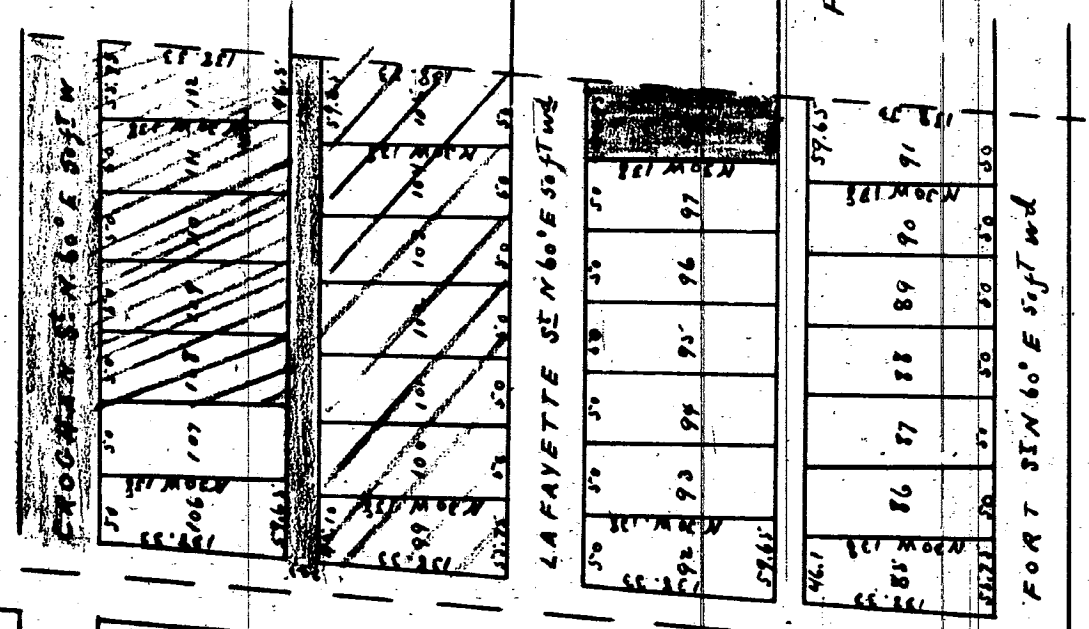

FOR VACATION OF PLAT SEE V. No 474-57

Rec'd for Record this 18th October A.D. 1854 at 12 o'clock M. Henry Campbell Reg.

State of Michigan } This is to certify that I William Hale County of Wayne } the owner of the part of the Louis Moran farm so called (being private claim number six in the City of Detroit State of Michigan) which is included on the plat and division hereinto have caused the same to be subdivided and laid out into lots and streets and all as they same appears by this plat And I do hereby acknowledge that the annexed plat of that part of said farm from Fort Street in said City and running back to Elizabeth Street in said City is my free act and deed and divise the same to be recorded - Done at Detroit this 18th October 1854

Signed and sealed and taken and acknowledged before me a Notary Public in and for said County this 18th October 1854

Wm Hale Notary Public Wayne Co Mich.

I hereby certify that this plat is a correct copy of the plat now on record in the Register of Deeds office, being made under the supervision of the Auditor General by tracing the plat on record and affixing thereto a carefully compared copy of the dedication and certificate.

Dated this 10th day of May 1910 Geo. W. Bennett Clerk Aud. Genl. Dept.

10717

8021
26341
8058 W. 141-1
10717

Resolved, That all that part of Port Elizabeth Street, City of Detroit, Wayne County, Michigan, as recorded in the Public Records of the County of Wayne, Michigan, in the name of the Detroit Edison Company, more particularly described as follows: Sec. 

FORWARD TO
STATE TREASURER

PET. # 6034

such event the petitioner or assigns shall be liable for all costs incidental to the repair of such broken or damaged utility, *Books 29-33*
P. 1402-7

Wayne

All of the foregoing in the following subdivisions:

1. Plat of Crawford's Subdivision of part of the Antoine Beaubien Farm as recorded in Liber 49, Page 495, Deeds, Wayne County records. *11266*
2. Plat of Crane and Wesson's Section of the Antoine Beaubien Farm, north of Elizabeth Street, Detroit, Michigan, as recorded in Liber 1, Page 9, Plats, Wayne County records, *10689*
3. Plat of the Subdivision of the Charles Moran Farm, between Gratiot and Indiana Streets, City of Detroit, Wayne County, Michigan, as recorded in Liber 1, Page 254, Plats, Wayne County records, *10516*
4. Plat of the Subdivision of the Louis Moran Farm between Fort and Elizabeth Streets, as recorded in Liber 55, Pages 243 and 244, Deeds, Wayne County records, *10717*
5. Plat of the Crane and Wesson Section of the Louis Moran Farm as recorded in Liber 1, Page 58, Plats, Wayne County records, *11407*
6. Plat of that part of Claim No. 181 north of Jefferson Avenue for the heirs of Antoine Rivard as subdivided into lots April 19, 1841, as recorded in Book 12, Pages 348, 349, 350, and 351, City Records, Probate File 998, *7990*
7. Plat of the Subdivision of Outlot 181, Rivard Farm, as recorded in Liber 1, Page 111, Plats, Wayne County records, *11318*
8. Plat of the Subdivision of part of Lot No. 182, Rivard Farm, Surveyed by Thomas Campau, as recorded in Liber 41, Page 449, Deeds, Wayne County records, *11277*

PROVIDED FURTHER, that if any utility located or to be located in said property shall break or be damaged as a result of any action on the part of the petitioner or assigns (by way of illustration but not limitation), such as storage of excessive weights of materials or construction not in accordance with Section 2, mentioned above, then in such event the petitioner or assigns shall be liable for all costs incidental to the repair of such broken or damaged utility,

All of the foregoing in the following subdivisions:

1. Plat of Crawford's Subdivision of part of the Antoine Beaubien Farm as recorded in Liber 49, Page 495, Deeds, Wayne County records.
2. Plat of Crane and Wesson's Section of the Antoine Beaubien Farm, north of Elizabeth Street, Detroit, Michigan, as recorded in Liber 1, Page 9, Plats, Wayne County records.
3. Plat of the Subdivision of the Charles Moran Farm, between Gratiot and Indiana Streets, City of Detroit, Wayne County, Michigan, as recorded in Liber 1, Page 254, Plats, Wayne County records.
4. Plat of the Subdivision of the Louis Moran Farm between Fort and Elizabeth Streets, as recorded in Liber 55, Pages 243 and 244, Deeds, Wayne County records.
5. Plat of the Crane and Wesson Section of the Louis Moran Farm as recorded in Liber 1, Page 58, Plats, Wayne County records.
6. Plat of that part of Claim No. 181 north of Jefferson Avenue for the heirs of Antoine Rivard as subdivided into lots April 19, 1841, as recorded in Book 12, Pages 348, 349, 350, and 351, City Records, Probate File 998.
7. Plat of the Subdivision of Outlot 181, Rivard Farm, as recorded in Liber 1, Page 111, Plats, Wayne County records.
8. Plat of the Subdivision of part of Lot No. 182, Rivard Farm, Surveyed by Thomas Campau, as recorded in Liber 41, Page 449, Deeds, Wayne County records.
9. Subdivision of Lot 1 of S. B. Morse's Subdivision of the Mullett Farm, north of Gratiot Street, Detroit, as recorded in Liber 1, Page 55, Plats, Wayne County records;

and be it further
RESOLVED, That all that part of Vernor Highway abutting the westerly line of Rivard Street, extended northerly, abutting the westerly line of Russell Street and abutting the southerly line of the Fisher Freeway Right of Way is closed on a temporary basis for a period to end May 29, 1975,

PROVIDED, That petitioner shall be subject to any tax which may be levied against it pursuant to law with regard to such use of public property, and further

PROVIDED, Petitioner first furnishes an Agreement, in form approved by the Corporation Counsel, saving and protecting the City of Detroit harmless from any and all claims, damages or expenses that may arise by reason of the issuance of said permit, and providing for the faithful performance by the grantee of the terms hereof, and files same with the City Controller, and further

PROVIDED, That said permit shall be issued only after a certified copy of this resolution has been duly recorded in the office of the Wayne County Register of Deeds, by and at the permittee's expense, and further

PROVIDED, That no building or other structure is constructed in said alley; that petitioner shall observe the rules and regulations of the Department of Public Works, and further subject to the following provisions:

The City of Detroit retains all rights and interests in the area herein temporarily closed;
The City and all utility companies retain their rights to establish, maintain, and service any utilities in said area of temporarily closed alley, and further

PROVIDED, That at the expiration of said permit, all obstructions therein shall be removed at the expense of the grantee, and the public property affected shall be restored to a condition satisfactory to the Department of Public Works, by and at the permittee's expense, and further

PROVIDED, This resolution is revocable at the will, whim or caprice of the Common Council, and further, that grantee acquires no implied or other privileges hereunder, not expressly stated herein, and be it further

RESOLVED, That all that part of Elizabeth Street lying in the limited access right of way of the Chrysler Freeway

Be and the same is hereby vacated to become a part and parcel of the Michigan Department of State Highways property, and be it further

Resolved, That, if, at any time in the future, it becomes necessary to remove the paved street and alley returns leading to the above vacated public rights of way except that portion of Elizabeth Street within the Chrysler Freeway Right of Way, such removal and curb construction, and any pavement adjustments, and, if necessary, any manhole and catch basin installations shall be done by the petitioner by City permit and inspection and according to City

specifications, with the entire cost of said construction being borne by the petitioner or his assigns.

Resolved, That the City Clerk is hereby authorized and directed to send a certified copy of this resolution to the Detroit Edison Company, the Michigan Bell Telephone Company, and the Michigan Consolidated Gas Company, and be it further

RESOLVED, That the Community Development Commission is hereby authorized and directed to negotiate the sale of the vacated alleys owned in fee by the City, said alleys are in the block bounded by St. Antoine, the Chrysler Freeway, Gratiot, and Adams; and in the block bounded by St. Antoine, the Chrysler Freeway, Adams, and Elizabeth.

Adopted as follows:
Yeas — Councilmen Browne, Eberhard, Henderson, Hood, Levin, Rogell, Wierzbicki, and President Ravitz — 8.
Nays — None.

Map attached
Li: 18456
Pa: 894-5
Rec: 6-15-73
11250
7990
1128
11277
11264
10689
10514
10107
11407

STATE OF MICHIGAN)
CITY OF DETROIT) ss.

SHORT FORM--TRUE COPY CERTIFICATE

I, GEORGE C. EDWARDS, CITY CLERK of the City of Detroit, do hereby certify that the annexed paper is a True Copy of a Resolution


adopted by the Common Council on MAY 29 1973

And approved by the Mayor on JUN 5 1973

as appears from the Journal of said Common Council, on file in my office.

IN WITNESS WHEREOF, I have hereunto set my hand and affixed the Corporate Seal of said City, at Detroit, on

JUN 14 1973
George C. Edwards
City Clerk

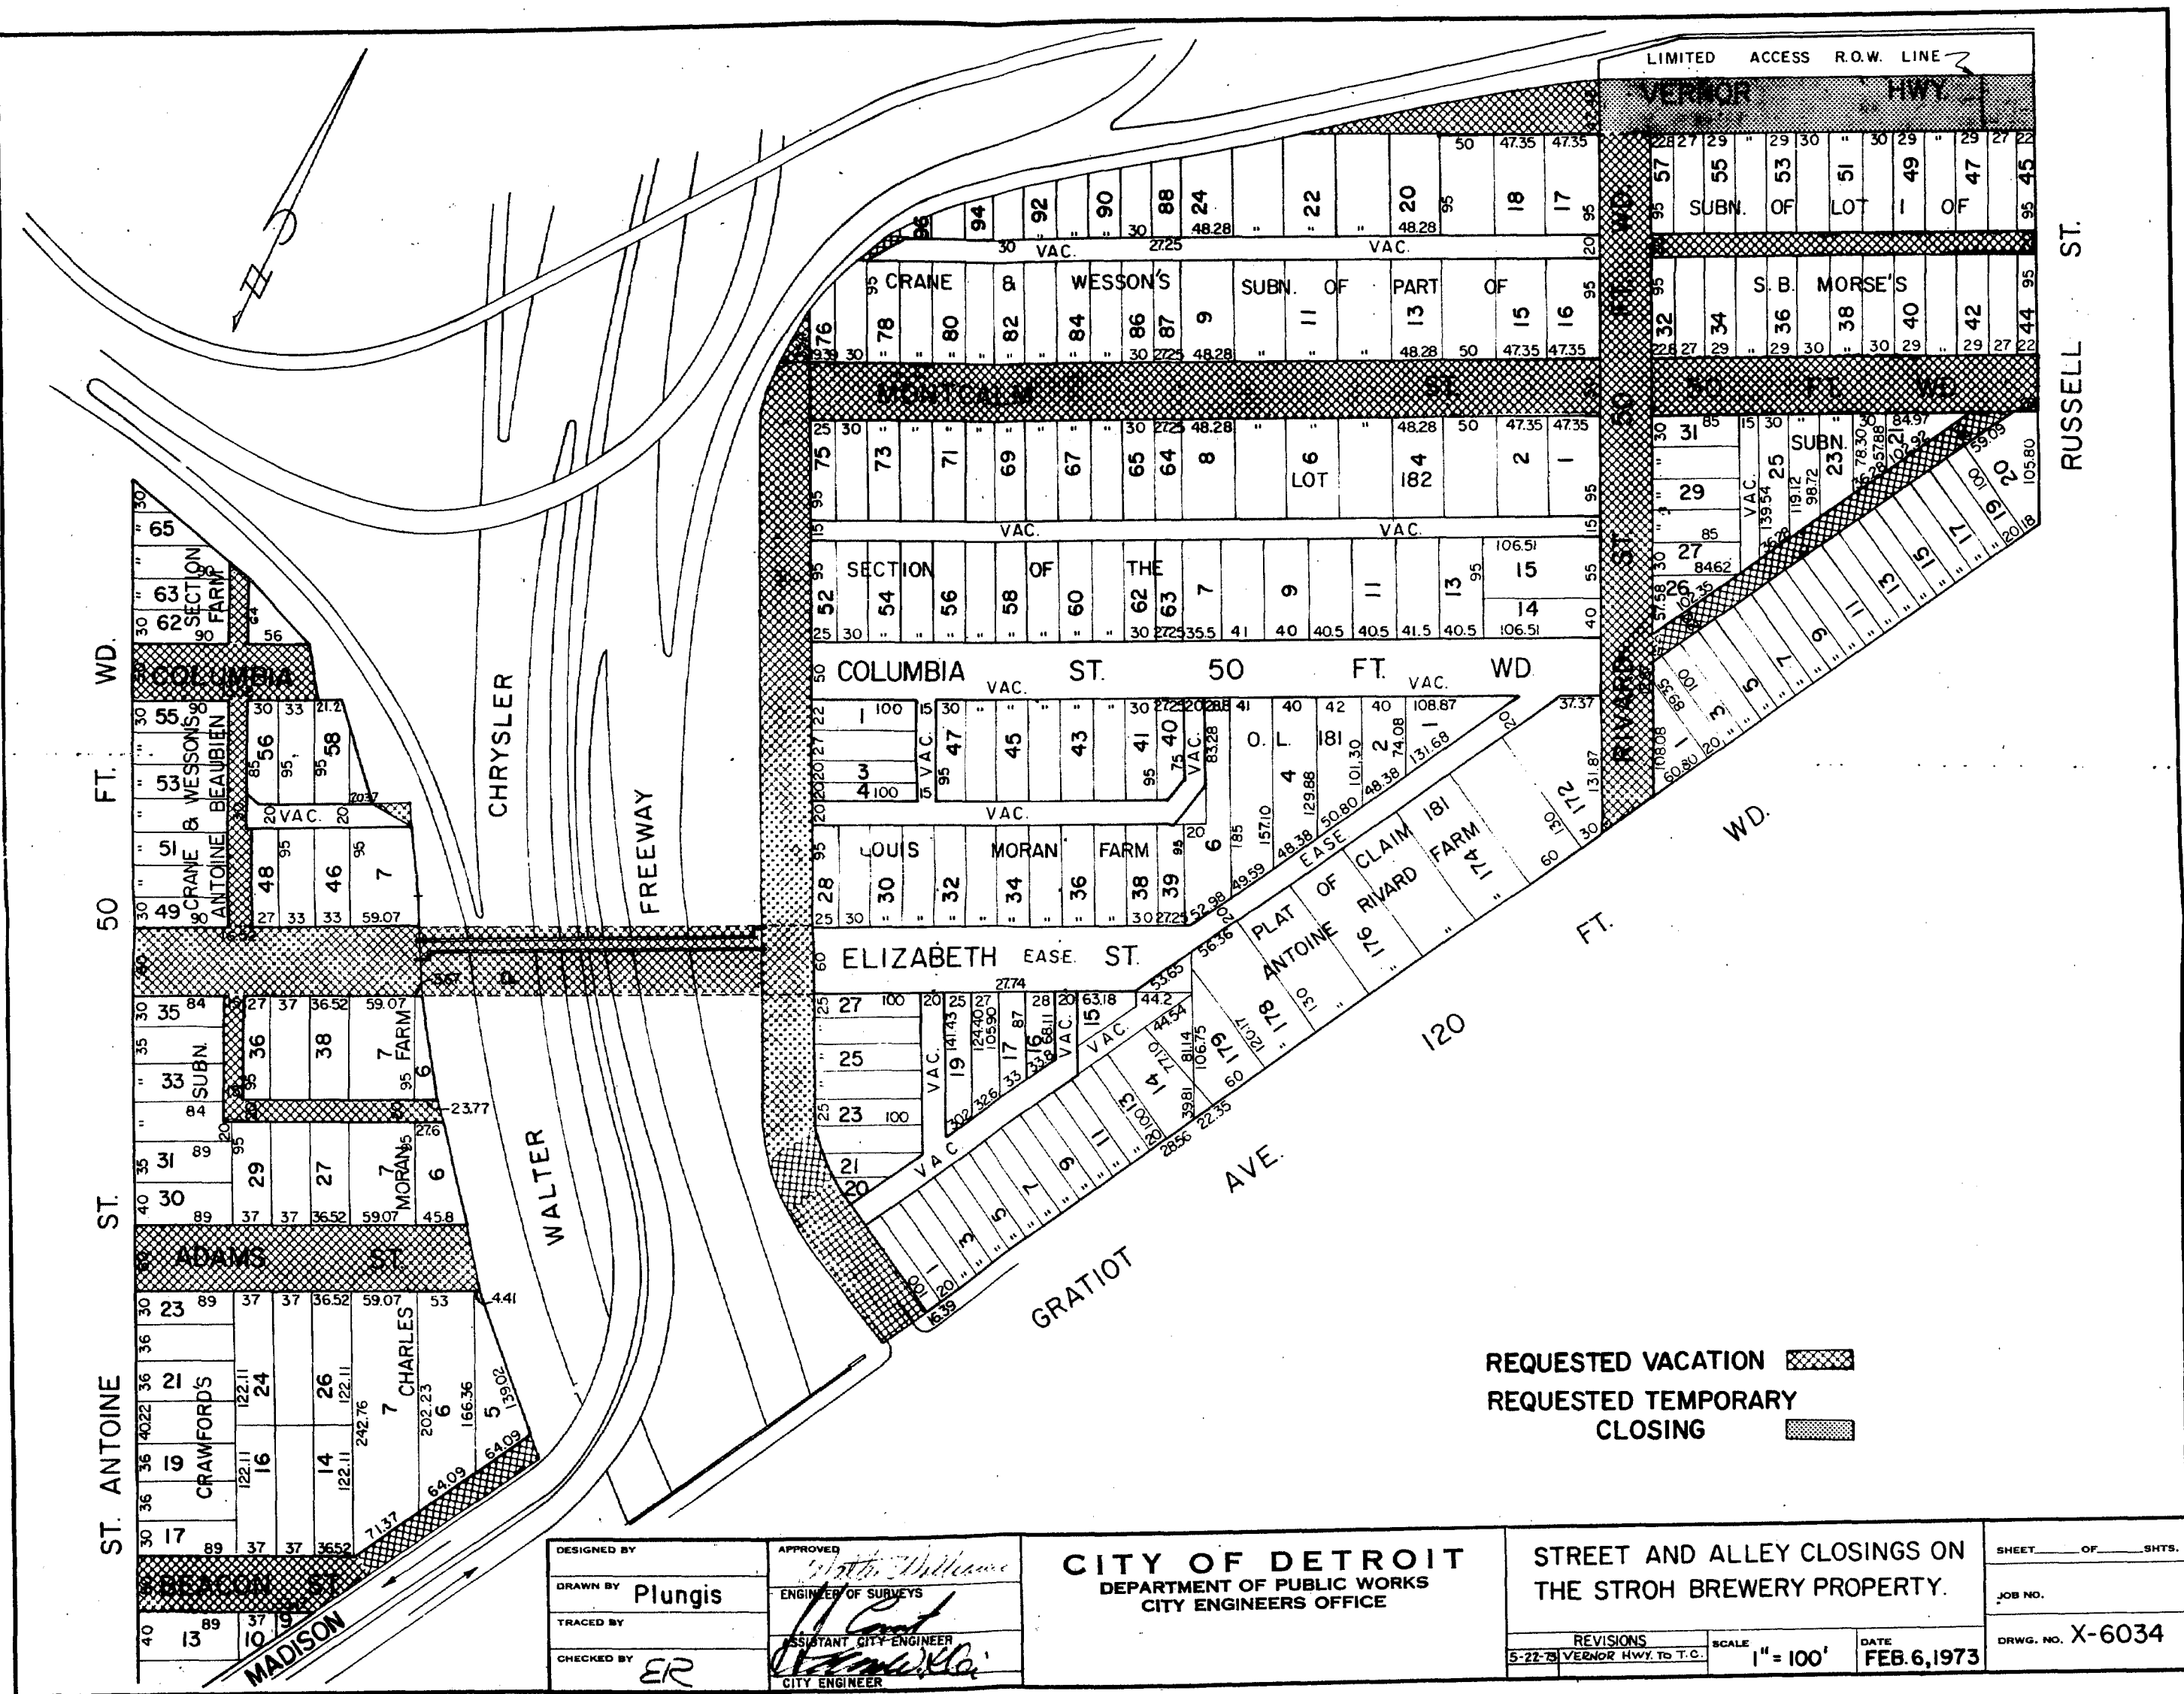

(copy of street names only)
(no maps for these items)

Wayne Co.

16/04

(No sketch needed)

By Councilman Beck:

Resolved, That the following described sections of Edsel Ford Freeway and Conner Interchange be renamed in accordance with the following designations:

Existing name: St. Jean Avenue, New name: Conner Avenue between Harper Avenue and the North line of the Edsel Ford Freeway, described as follows:

E. W. Guenther's Subdivision of Lot 1 and part of Lot 2 of Subdivision of St. Jean Farm, Private Claim 26 from the Estate of Henry Plass, as recorded in Liber 39, Page 60 of Plats, Wayne County Records.

Approved:

ROBERT REESE,
Corporation Counsel.

Adopted as follows:

Yeas—Councilmen Beck, Brickley, Connor, Poindexter, Ravitz, Rogell, Van Antwerp, Wierzbicki and President Carey—9.
Nays—None.

By Councilman Beck:

Resolved, That the following described sections be named Walter P. Chrysler East Service Drive in accordance with the following designations:

Existing name: None, New name: Walter P. Chrysler East Service Drive, from Gratiot Avenue to Elizabeth Street, described as follows:

Plat of Crane and Wesson's Section of the Louis Moran Farm, as recorded in Liber 1, Page 58 of Plats, Wayne County Records.

Subdivision of the Louis Moran Farm between Fort and Elizabeth Streets, as recorded in Liber 55, Pages 243 and 244 of Deeds, Wayne County Records.

Existing name: Hastings Street, New name: Walter P. Chrysler East Service Drive from Elizabeth Street to Montcalm Street, described as follows:

Plat of Crane and Wesson's Section of the Louis Moran Farm, as recorded in Liber 1, Page 58 of Plats, Wayne County Records.

Approved:

ROBERT REESE,
Corporation Counsel.

Adopted as follows:

Yeas—Councilmen Beck, Brickley, Connor, Poindexter, Ravitz, Rogell, Van Antwerp, Wierzbicki and President Carey—9.
Nays—None.

By Councilman Beck:

Resolved, That the following described section be named Walter P. Chrysler West Service Drive in accordance with the following designations.

Existing name: None, New name: Walter P. Chrysler West Service Drive from Hendrie Street to Ferry Street, described as follows:

Ferry and Lysters Subdivision of Blocks 38 through 45, inclusive, of Antoine Beaubien Farm between Harper and Ferry Avenues, as recorded in Liber 12, Page 43 of Plats, Wayne County Records.

Approved:

ROBERT REESE,
Corporation Counsel.

Adopted as follows:

Yeas—Councilmen Beck, Brickley, Connor, Poindexter, Ravitz, Rogell, Van Antwerp, Wierzbicki and President Carey—9.
Nays—None.

By Councilman Beck:

Resolved, That the following described section be named Edsel Ford South Service Drive, in accordance with the following designations:

Existing Name: None, New Name: Edsel Ford South Service Drive, from Beaubien Street to Hendrie Street, described as:

Plan of the Lambert Beaubien Farm as surveyed into lots for the proprietors by John Mullett, Surveyor, as recorded in Liber 1, Pages 46, 47, 48, 49, 50, 51 and 52 of Plats, Wayne County Records.

Ferry and Lysters Subdivision of Blocks 39 through 45, inclusive, of Antoine Beaubien Farm between Harper and Ferry Avenues, as recorded in Liber 12, Page 43 of Plats, Wayne County Records.

Approved:

ROBERT REESE,
Corporation Counsel.

Adopted as follows:

Yeas—Councilmen Beck, Brickley, Connor, Poindexter, Ravitz, Rogell, Van Antwerp, Wierzbicki and President Carey—9.
Nays—None.

STATE OF MICHIGAN)
CITY OF DETROIT) ss.

SHORT FORM--TRUE COPY CERTIFICATE

I, THOMAS D. LEADBETTER, CITY CLERK of the City of Detroit, do hereby certify that the annexed paper is a True Copy of a Resolution

adopted by the Common Council on 4-20-65

and approved by the Mayor on 4-26-65

as appears from the Journal of said Common Council, on file in my office.

IN WITNESS WHEREOF, I have hereunto set my hand and affixed the Corporate Seal of said City, at Detroit, on

4-27-65

Thomas D. Leadbetter
City Clerk