


ROBERT E. WALKER'S SUB'DN
OF PART OF FR'L SECS. 22 & 27 T. 1 S, R. 12 E,
HAMTRAMCK, WAYNE CO., MICH
SCALE: 200 FT. PER INCH

Order of Vacating

By resolution, the Common Council
Vacated part of 7 foot public alley
between east line of Fisher St. and west
line of alley first east thereof and adjoining
north line of Lot 208 of this plat, Nov. 27th 1917
Filed Dec. 8th 1917 Voucher 1164-1917

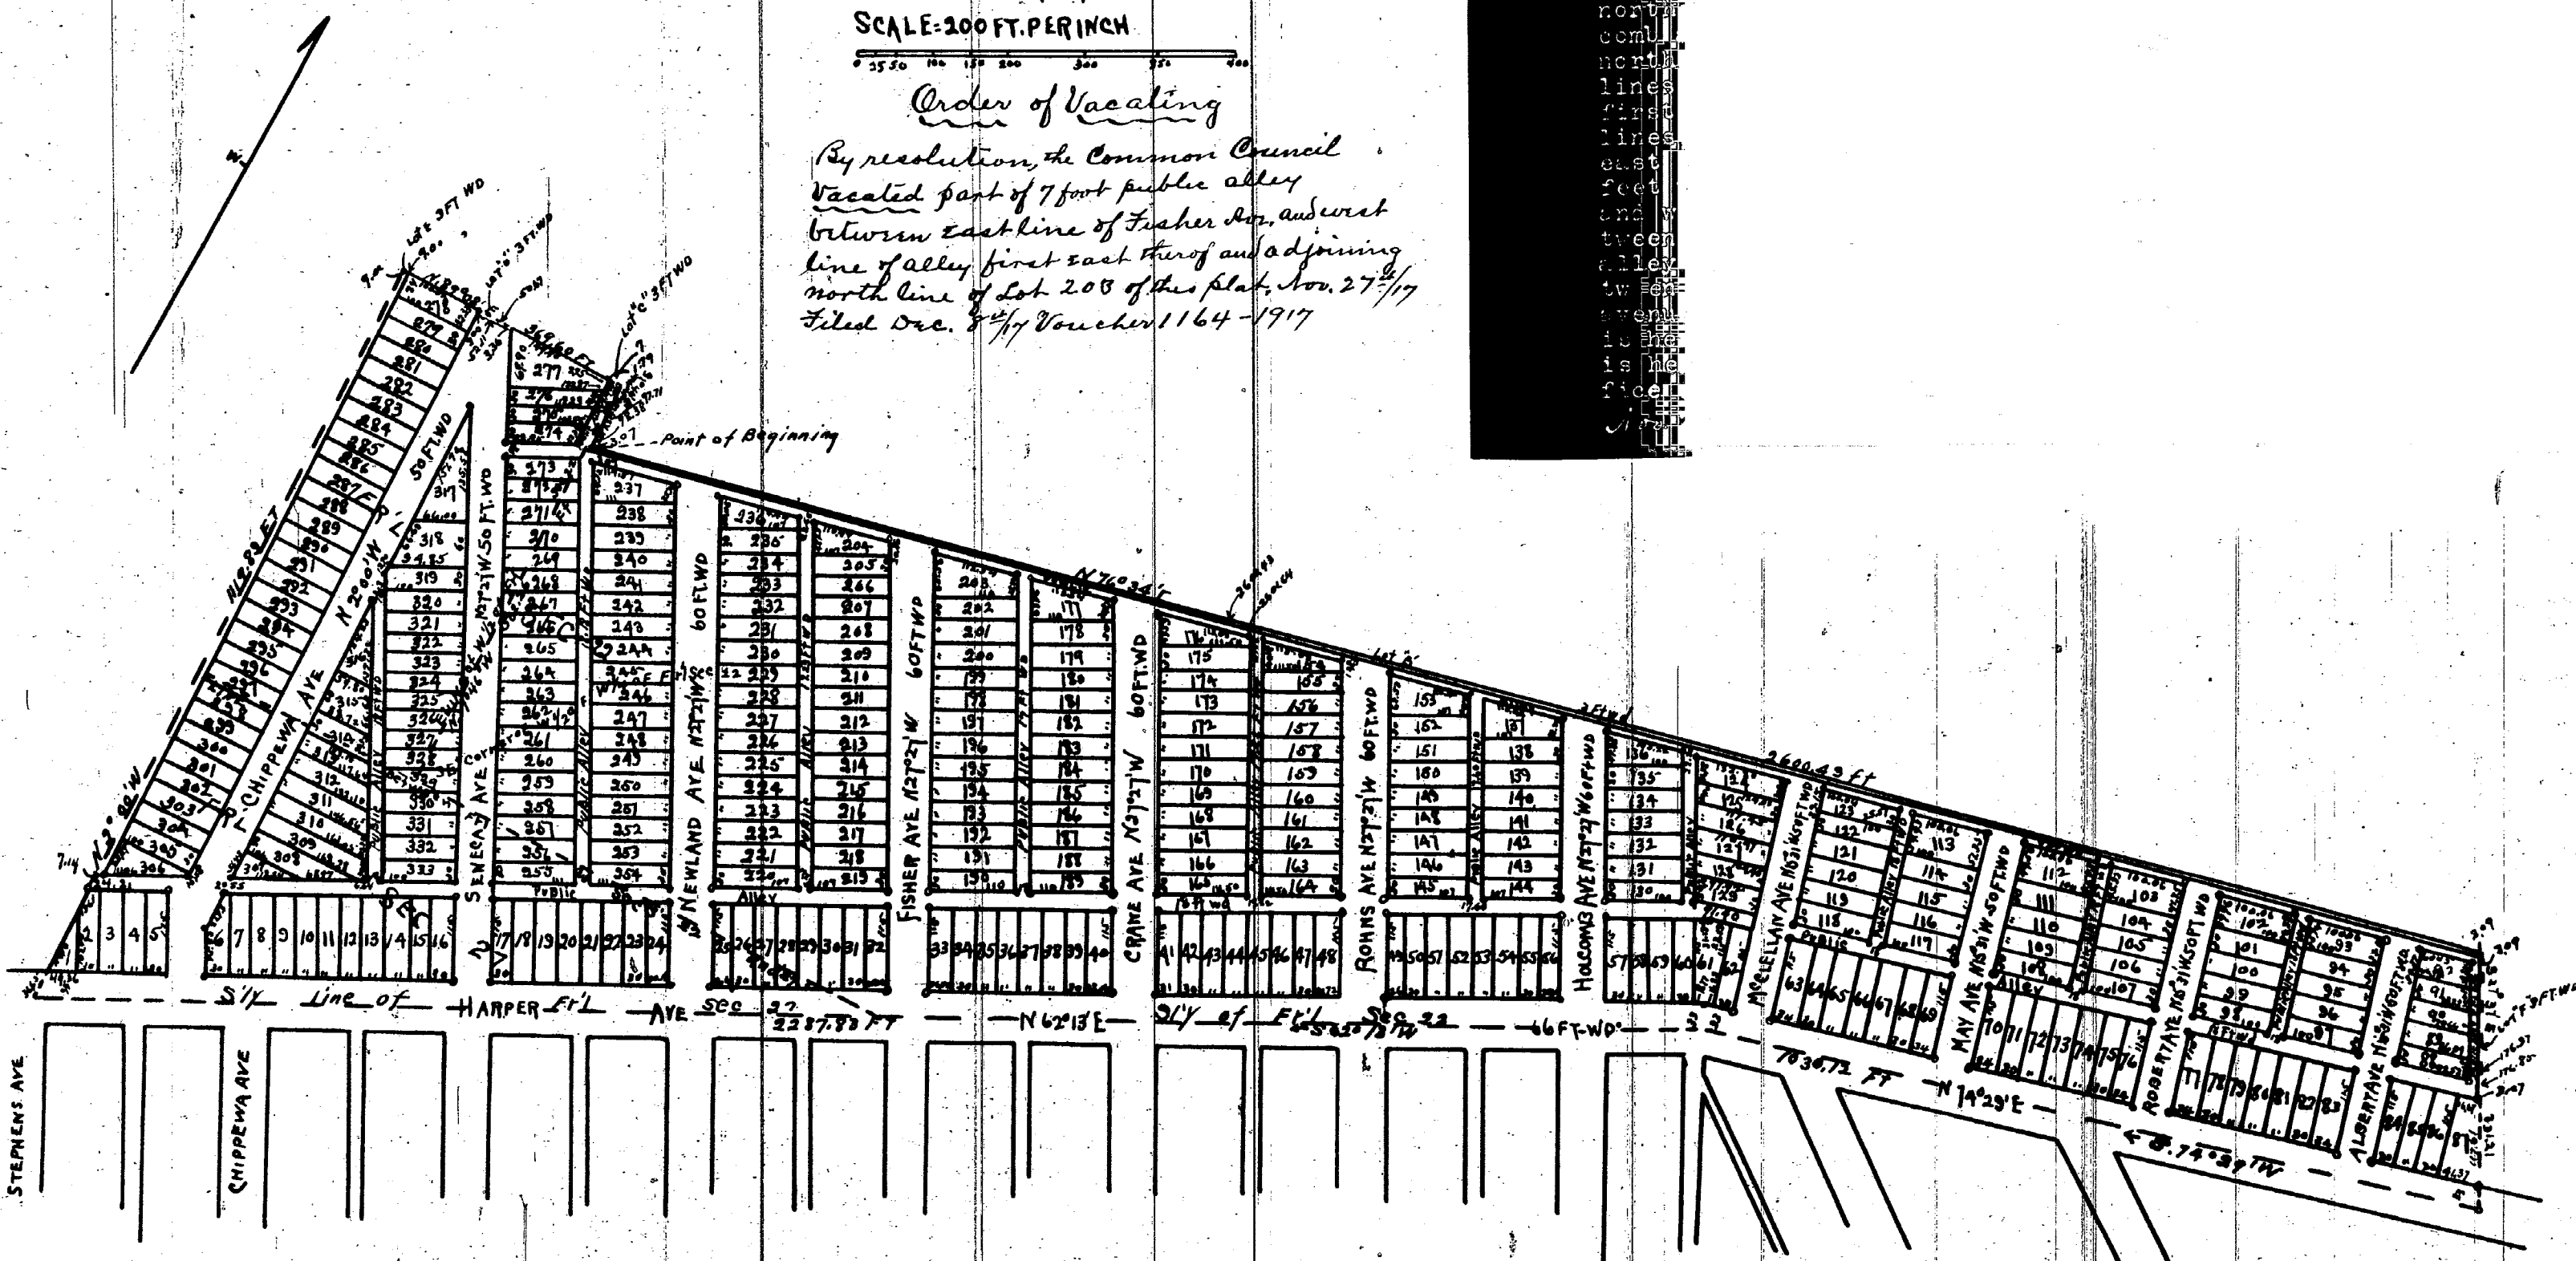

I hereby certify that the above Plat is correct, and that monument
consisting of Iron 1 1/4 inches in diameter and 15 inches long have
been placed in the ground at all angles in the boundaries and at the
intersection of all streets or streets and alleys as shown on plat by C.
Detroit June 1 1907
Mason, L. Brown & Co
Engineers and Surveyors

Know all men by these presents, that we
Henry O. Walker and Emma Cooper individuals and also as
trustees for Mary Grace Johnston, under the last will and testament of
said Mary Grace Johnston, have caused the land embraced in the above plat to be surveyed and
out and plotted to be known as Sec. 22 & 27 T. 1 S. R. 12 E.
Hamtramck Wayne Co. Michigan and that the streets and
alleys shown on said plat are hereby dedicated to the use of the public
Witness our hands and seals this 18th day of June
A.D. Nineteen hundred and seven
In presence of

J.B. Walker Henry O. Walker D.S.
Eugene M. Swiney Emma Cooper L.S.
Alice H. M. Swiney Henry O. Walker L.S.
Emma Cooper L.S.
Subscribed, signed, sealed and
testament of Robert E. Walker, deceased

State of Michigan } ss.
County of Wayne }
On this 17th day of June 1907 before
me, a Notary Public in and for said County, personally appeared the
above named Henry O. Walker, individually and also as trustee for Mary
Grace Johnston, under the last will and testament of Robert E. Walker
known to me to be the same persons who executed the above dedications
and who acknowledged the same to be his free act and deed
Mae E. Nepleburn Notary Public
Wayne County Michigan
My commission expires September 26, 1908

State of Michigan } ss.
County of Wayne }
We O.P. Gullett Register of
Deeds and Mason, L. Brown & Co Surveyors hereby
certify that we have each carefully compared this copy with the original
Plat of Robert E. Walker's Subdivision of part of Fr'l Secs. 22 & 27, T. 1 S, R. 12 E
Hamtramck, Wayne Co., Mich. and that it is an exact copy thereof and of
the whole of each original map or Plat
O.P. Gullett Register of Deeds
Mason, L. Brown & Co Surveyors

Examined and Approved
July 20th 1907
John F. Wilkinson
Deputy Auditor General

State of Michigan } ss.
County of Saginaw }
On this 18th day of June 1907 before
me, a Notary Public in and for said County, personally appeared the
above named Emma Cooper, individually and also as trustee for Mary
Grace Johnston, under the last will and testament of Robert E. Walker
known to me to be the same person who executed the above dedications
and who acknowledged the same to be her free act and deed
Eugene M. Swiney Notary Public
Saginaw County Michigan
My commission expires Feb'y 25, 1911

Description
Beginning at a corner monument on the east line of the West 1/2
of 1/4 Sec. 22 T. 1 S, R. 12 E, Hamtramck, Wayne Co., Michigan, said monument
being distant 171.46 N. 50° 26' E. from the southeast corner of said West
1/2 of 1/4 Sec. 22, thence N 76° 39' E 260.43 ft to an iron monument, thence
thence along the said S. E. line of said Sec. 22 S 24° 03' W 106.46 ft to an
iron monument, thence continuing along the said S. E. line of said Sec. 22
S 63° 13' W 228.73 ft to an iron monument, thence N 20° 00' W 119.83 ft to
the east line of West 1/2 of 1/4 Sec. 22, thence S 49° 06' E 94.64 ft along the said
east line of West 1/2 of 1/4 Sec. 22 to the point of beginning, being
a part of land conveyed to Robert E. Walker by Elizabeth D.
Van Dyke and E. M. Walker, executors of the last will of James
A. Van Dyke as recorded in City 123 of Deeds, on page 31, and
all that part of 1/4 Section 22 conveyed to Robert E. Walker by
Charles C. Jr and Charlotte C., his wife, as recorded in City 102 of Deeds,
on page 146.

I hereby certify that this Plat is a correct copy of the Plat
now on Record in the Register of Deeds Office, being made
under the supervision of the Auditor General, by tracing
the Plat on Records and affixing thereto a carefully compared
copy of the Dedication and Certificate D
Dated the 28th day of February 1911
Alton B. Wood
Clerk, Aud Gen Dept.
Register of Deeds Office } ss. This instrument was received for
Wayne County } record this 9th day of August 1907 at 3:15
O'clock P.M. and recorded in City 135 of Deeds on Page 56
as proper Certificate was furnished in compliance with
Sect 135 of Senate Bill No 199 File 212 Act of 1893
O.P. Gullett
Register of Deeds.

DORCHESTER STREET, CITY OF DETROIT.

Verdict Rendered in
Recorder's Court, in Detroit.
Confirmed Oct. 1, 1917.
By resolution of Common Council.

Voucher 1148 -- 1917.

Vol. 8 page, 504 ✓

Dorchester Street, from McClellan Ave. to Pennsylvania Ave. opened, as follows:
The N. 25 ft. of Lot 250 of Brandon's Sub. of that part of P.C. 337-257 between Jefferson Ave. and Mack St. and west of the east line of Cadillac Blvd., also the S. 34 ft. of that part of P.C. 257 between Jefferson Ave. and Mack St., and the S. 33 ft. of Lot 251, of Subdivision last mentioned.

PLAT

BUTTERFIELD & WOODS' SUBDIVISION, NOW IN DETROIT.

In the matter of the petition of
Mary Doran, et al. for the vacation
of said plat.

Dec. 8, 1917.

Clyde S. Webster,
Circuit Judge.

Ordered that the plat known as
Butterfield & Woods' Subdivision, in
¼ Sec. 47, Ten Thousand Acre Tract, for-
merly in the Township of Greenfield, now
in the City of Detroit, be vacated,
with the streets and alleys thereof.

Voucher No. 1156 -- 1917.

Vol. 139 page 10976 ✓

ROBERT E. WALKER'S SUBDIVISION, IN DETROIT, ALLEY VACATED.

re petition of William Roine
to Common Council of Detroit,

Nov. 27, 1917.

Voucher No. 1164 --- 1917.

RESOLVED that all that part of the 7 ft. public alley first south of and parallel to Peter Hunt Ave. lying between east line of Fischer Ave. and the west side of the alley first east thereof and adjoining the north line of Lot 203, Robert E. Walker Subdivision, be vacated.

Vol. 138 page 10856 ✓

WADE AVENUE, IN DETROIT, VACATION OF PART OF.

Re petition of Mrs.
Agnes H. Reed to the
Common Council of Detroit.

Dec. 4, 1917.

Voucher No. 1168 -- 1917.

vol. 3 page 154 ✓

Resolved that all that part of Wade Ave. lying in the rear of and adjoining Lot 14, of Wm.C.Maybury's Sub. of Lot 18 of Mandelbaum's Sub. etc. described as beginning at the southwest corner of Lot 14, thence in a westerly direction along the southerly line of said lot 24.45 ft. more or less to a point, thence in a northeasterly direction 28.18 ft. to a point on the westerly line of said lot, thence in a southeasterly direction 32.85 ft. along the westerly line to the place of beginning, also

All that part of Wade Ave. lying in the rear of and adjoining Lot 15 of above