


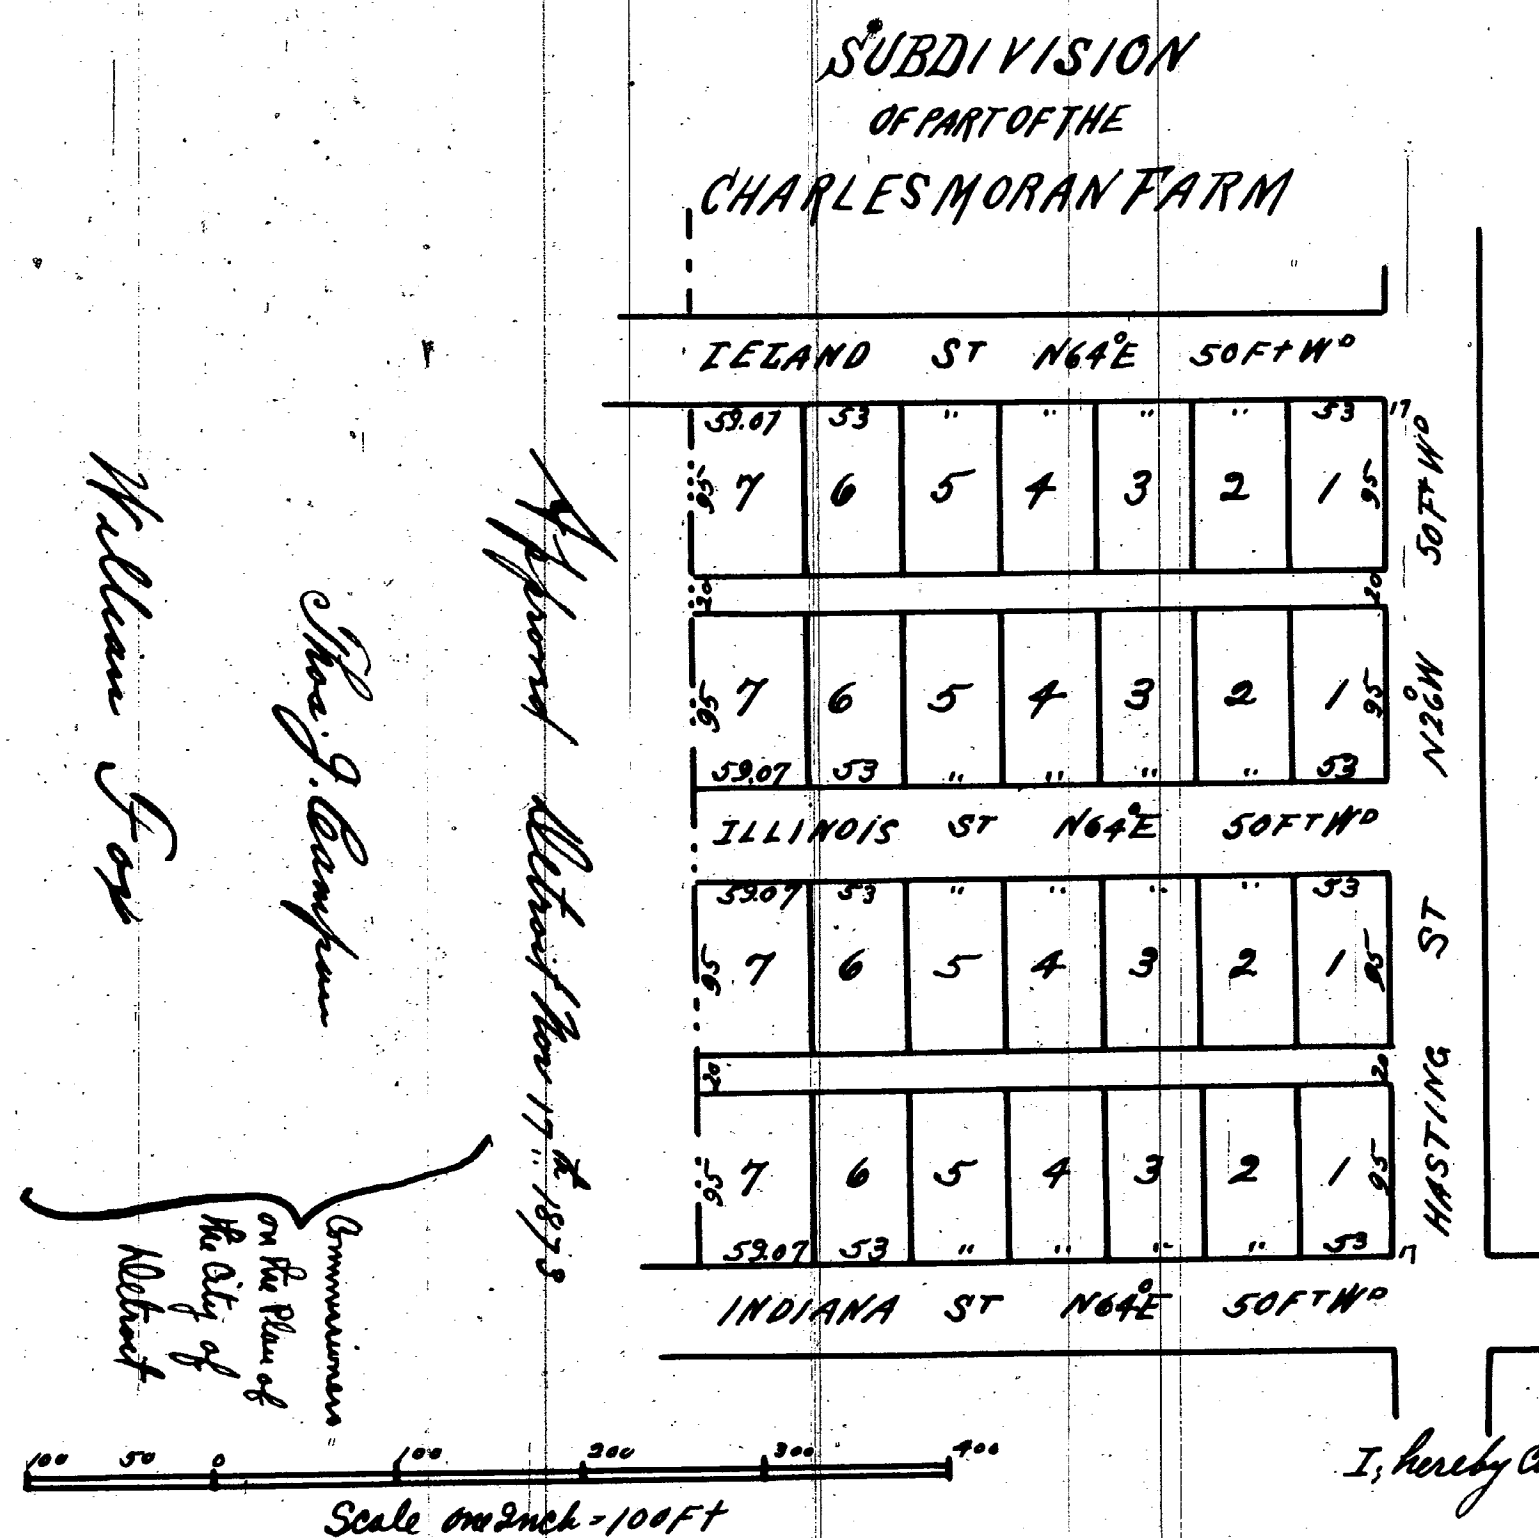

I, hereby certify the above Plat to be correct.
Eugene Robinson
City Surveyor

Know all men by these presents
that we Charles Moran and Justina Moran
his wife do hereby dedicate to the perpetual
use of the public all the streets and alleys
on the plat hereto annexed especially reserving
to ourselves our heirs and assigns the reversion
thereof whenever the same may be discontinued
by law

Witness our hands and seals this 2^d day of December

A. D. 1873.

C. W. Moran
Justina Moran.

Signed sealed and de-
livered in presence
Philip N Van Dyke
Wm B Moran
State of Michigan
County of Wayne.

On this 2^d day of December 1873 before me a
Notary Public in and for said County personally
appeared Charles Moran and Justina his wife known
to me to be the persons who executed the within in-
strument and acknowledged the same to be their
free act and deed, and the said Justina Moran
wife of the said Charles on a private examination
apart from her husband acknowledged that she executed
the same freely and without fear or compulsion from
any one

Philip N Van Dyke
Notary Public
Wayne County
Michigan

Recorded Dec 4th 1873
J. W. McMillan
Register

We John W. McMillan
Register of Deeds and Eugene Robinson
Surveyor certify that we have compared
the above copy of Plat with the original
and that it is an exact duplicate thereof
J. W. McMillan
Eugene Robinson City Surveyor

I hereby certify that this Plat is a correct
copy of the Plat now on Record in the Register
of Deeds Office, being made under the
supervision of the Auditor General by
tracing the Plat on Record and affixing
thereto a carefully compared copy of the
Dedication and Certificate

Dated the 9th day of March 1911
Alton B. Hurd
Clerk and Gen. Supt.

[illegible][illegible]

Alexander Avenue and the south-
 easterly line of new Beaubien Avenue,
 120 feet wide, as platted in the Med-
 ical Center Urban Renewal Plat No.
 1 as recorded in Liber 104, page 74,
 1975, Wayne County Records, and
 Records and as platted in Van Dyke's
 Subdivision of Part of the Antoine
 Beaubien Farm, north of Grace Street,
 1975, as recorded in Liber 104, page 74,
 1975, Wayne County Records, all of
 the above being more particularly
 described as follows: Beginning at the
 intersection of the south easterly line
 of Alexander Avenue and with the
 west line of St. Antoine Street;
 thence N. 26d 09m 00s W., along the
 westerly line of St. Antoine Street,
 120 feet to a point; thence
 along a curve concave to the left,
 radius 520.00 feet, central angle 52d
 52m 52s, chord bearing N 38d 29m
 00s W., distance 228.02 feet to a
 point on the east line of St.
 Antoine Street; thence S. 26d 09m
 00s E., along the east line of St.
 Antoine Street, 228.02 feet to the
 south easterly line of Alexander Ave-
 nue of Alexander Avenue; thence
 S. 63d 41m 30s W., along the south
 line of Alexander Avenue to the
 beginning.
 And the same are hereby vacated
 as public streets to become a part and
 parcel of the adjoining property sub-
 ject to the following reservations:
 1) Underground easements are
 hereby reserved within the right-of-
 way of the streets hereinabove de-
 scribed for the public utilities.
 2) The right of ingress and egress
 to and over said easements for the
 purpose of installing, maintaining,
 repairing, removing or replacing pub-
 lic utilities.
 3) Public utilities shall not be in-
 stalled on surface but only under-
 ground and no buildings or structures
 of any nature whatsoever (such as
 fences) shall be built or
 placed upon said easements, and
 further
 RESOLVED, That the Detroit Edison
 Company, and the Michigan Bell
 Telephone Company are hereby di-
 rected to remove all their overhead
 poles and wires from the vacated
 streets without expense to the city,
 and to acknowledge their receipt of a
 copy of this resolution; and be it
 further
 RESOLVED, That the City Clerk is
 hereby directed to mail to the Detroit
 Edison Company, the Michigan Bell
 Telephone Company, and the Michi-
 gan Consolidated Gas Company, a
 certified copy of this resolution.
 Adopted as follows:
 Yeas—Councilmen Brickley, Con-
 nolly, McMane, Ravitz, Rogell,
 and President Carey—7.
 Nays—None.

By Councilman C. H. Taylor, Jr., City Clerk.








13, except the

City Clerk

WOODWARD AVE. 120 FT. WD.

CANFIELD AVE. 60 FT. WD.

WILLIS AVE. 100 FT. WD.

ALEXANDRINE AVE. 100 FT. WD.

MARTIN PLACE 100 FT. WD.

ORCHESTRA PLACE 30 FT. WD.

BRADY ST. 50 FT. WD.

JOHN R. ST. 60 FT. WD.

BRUSH ST. 60 FT. WD.

CANFIELD

WILLIS

SUPERIOR

ALEXANDRINE

LELAND

ILLINOIS




I HEREBY
TO BE ACQUIRED BY
PUBLIC PURPOSES
COMMON COUNCIL

REFERENCE DRAWINGS		DESIGNED BY	APPROVED: <i>Behm</i>	CITY OF DETROIT DEPARTMENT OF PUBLIC CITY ENGINEERS OF																												
DRAWN BY J.B. JONES		ENGINEER OF STREETS																														
TRACED BY		ASSISTANT CITY ENGINEER																														
CHECKED BY <i>R. Kowalski</i>																																
<table border="1"> <thead> <tr> <th>COORD</th> <th>DESCRIPTION</th> <th>DATE</th> <th>APPROVED</th> </tr> </thead> <tbody> <tr> <td>1</td> <td></td> <td></td> <td></td> </tr> <tr> <td>2</td> <td></td> <td></td> <td></td> </tr> <tr> <td>3</td> <td></td> <td></td> <td></td> </tr> <tr> <td>4</td> <td></td> <td></td> <td></td> </tr> <tr> <td>5</td> <td></td> <td></td> <td></td> </tr> <tr> <td>6</td> <td></td> <td></td> <td></td> </tr> </tbody> </table>					COORD	DESCRIPTION	DATE	APPROVED	1				2				3				4				5				6			
COORD	DESCRIPTION	DATE	APPROVED																													
1																																
2																																
3																																
4																																
5																																
6																																

CANFIELD




AVE. 60 FT. WD.

BRUSH ST. 60 FT. WD.

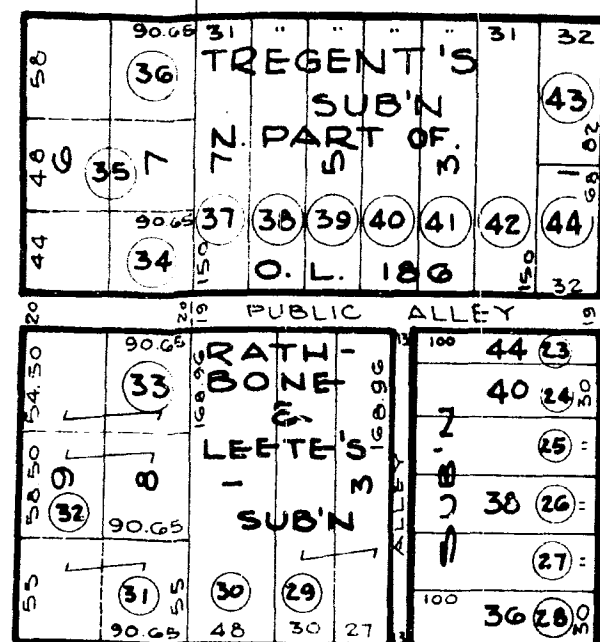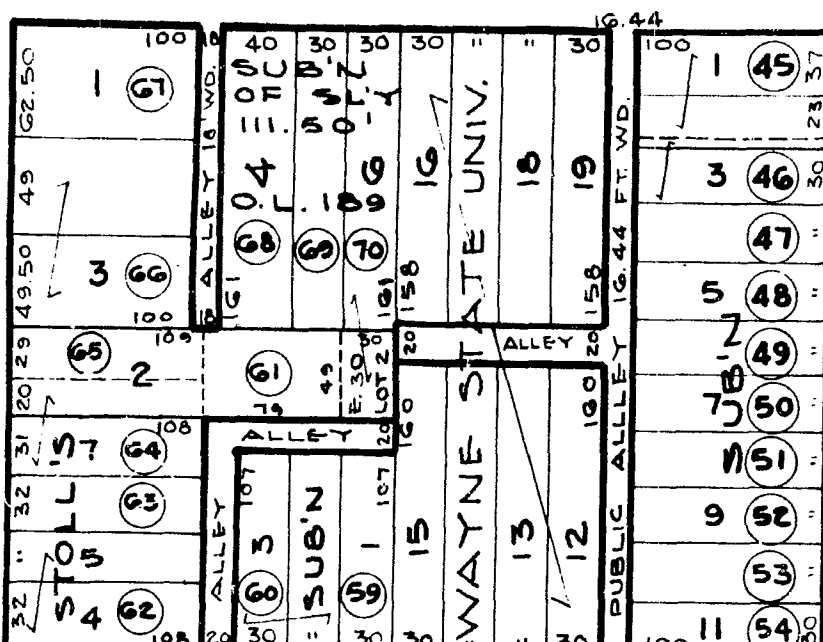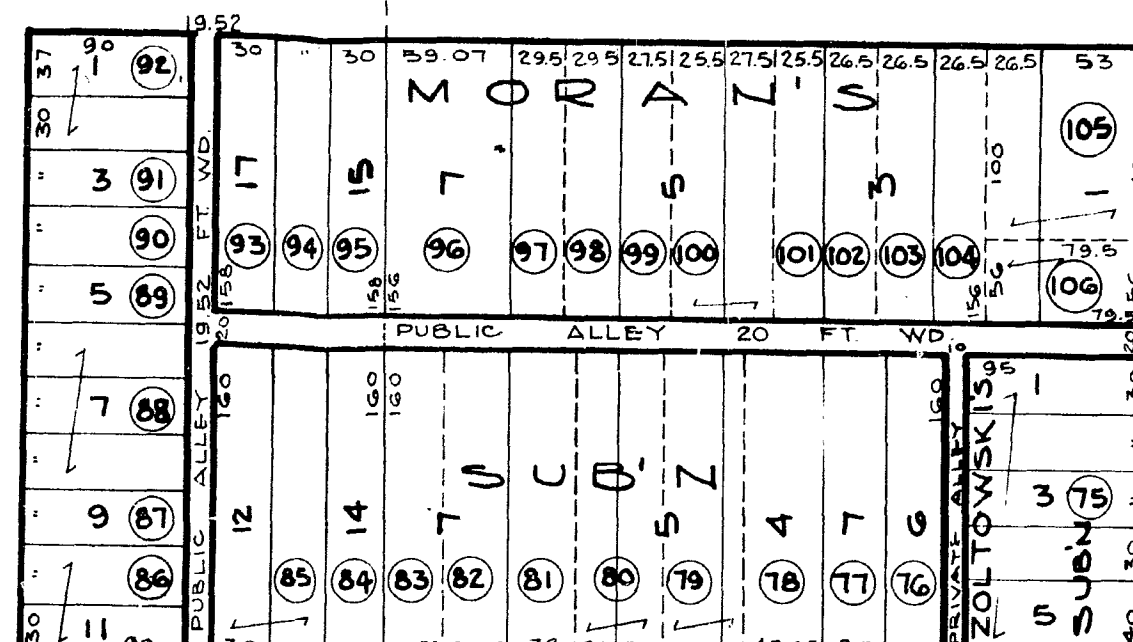




WILLIS

AVE. 50 FT. WD.

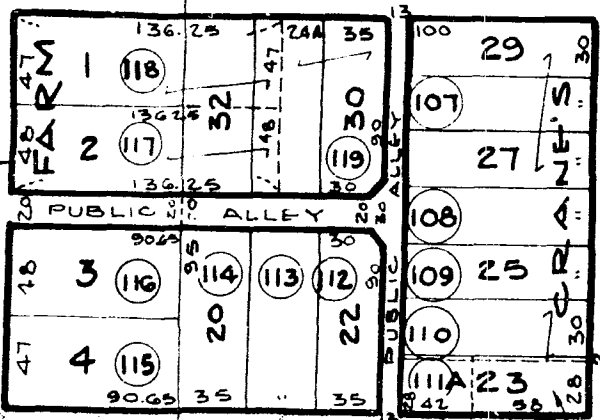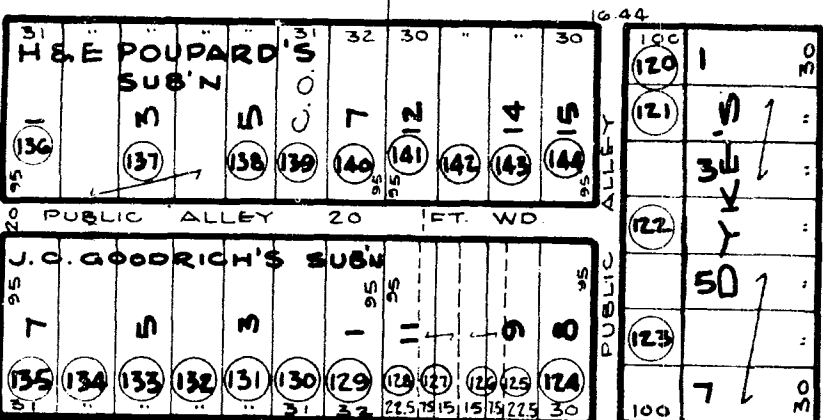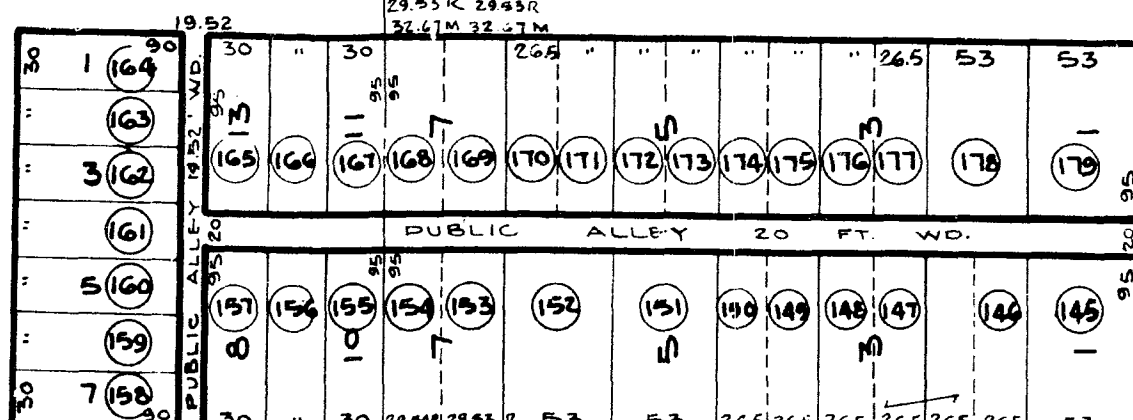




SUPERIOR

AVE. 50 FT. WD.

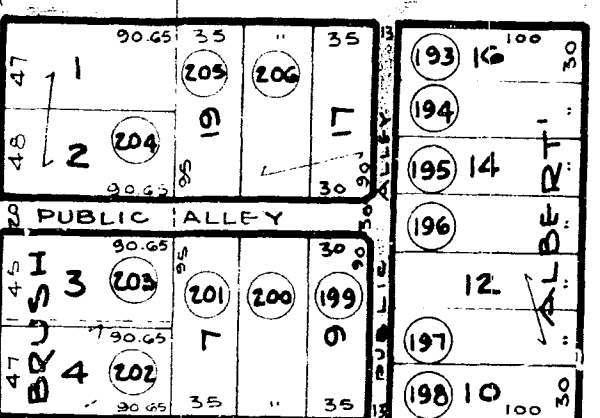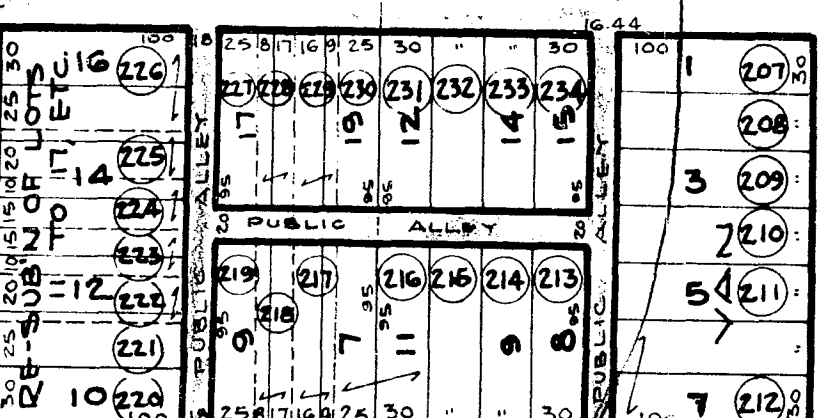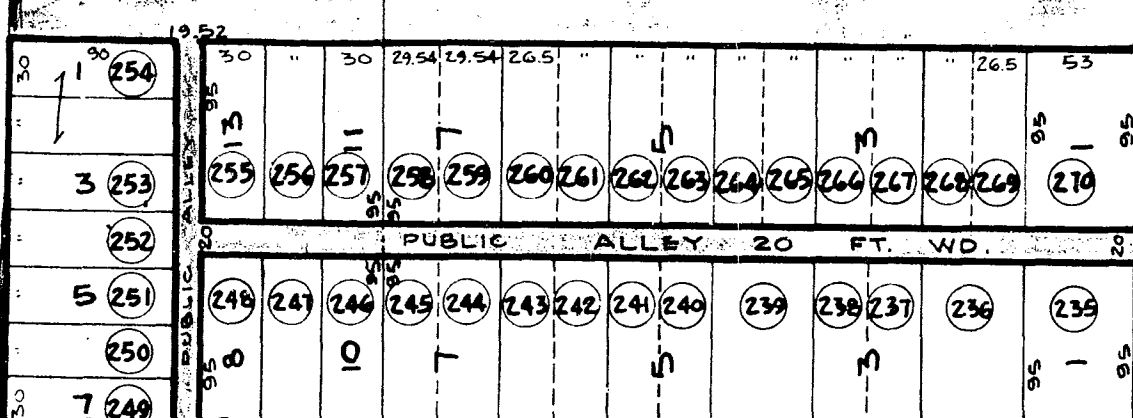




ALEXANDRINE

AVE. 50 FT. WD.

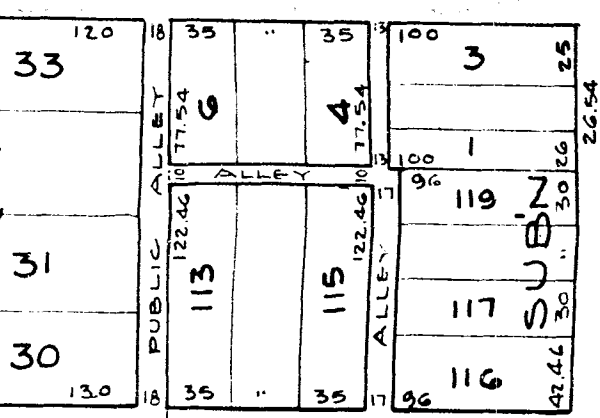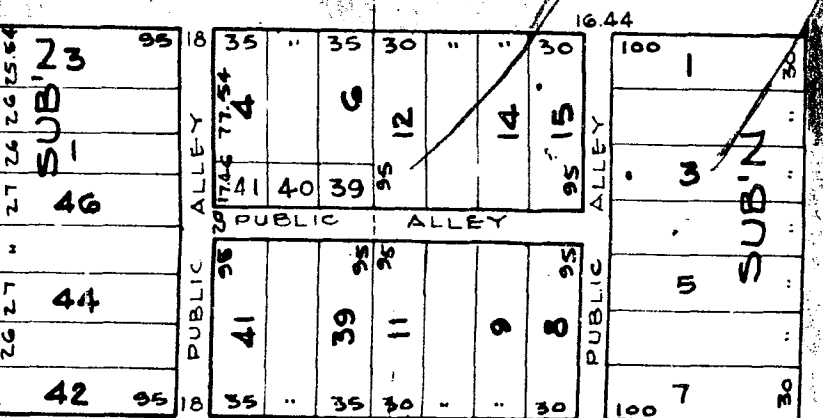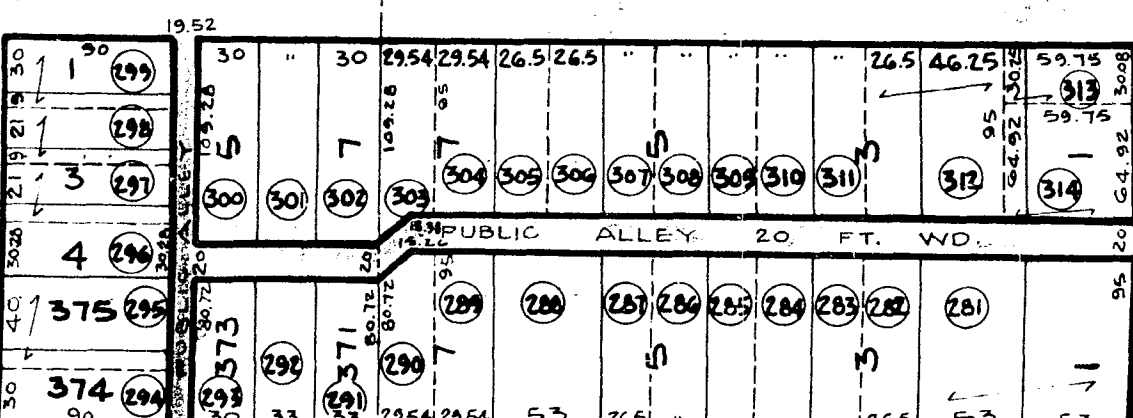

LELAND

AVE. 50 FT. WD.

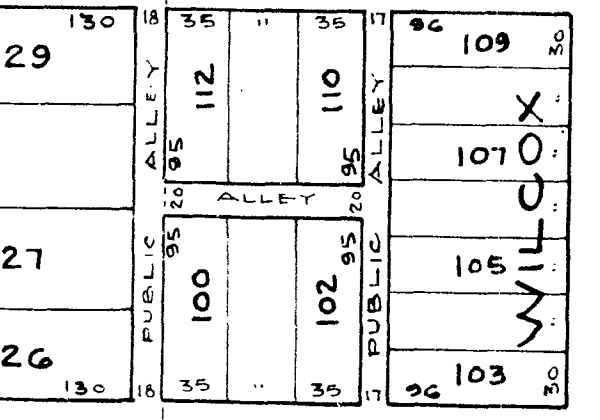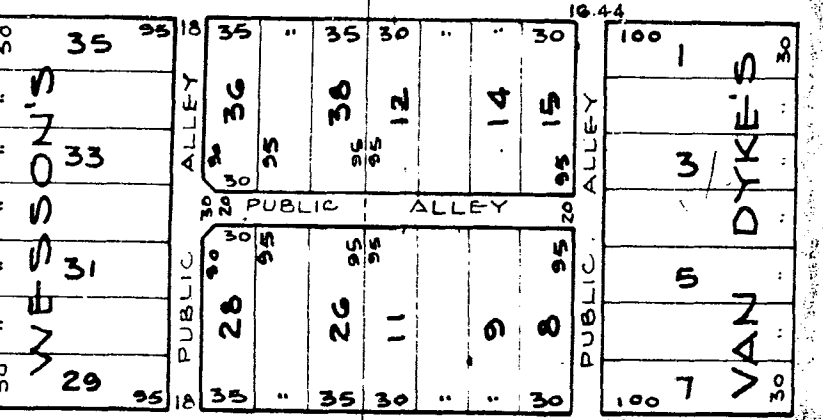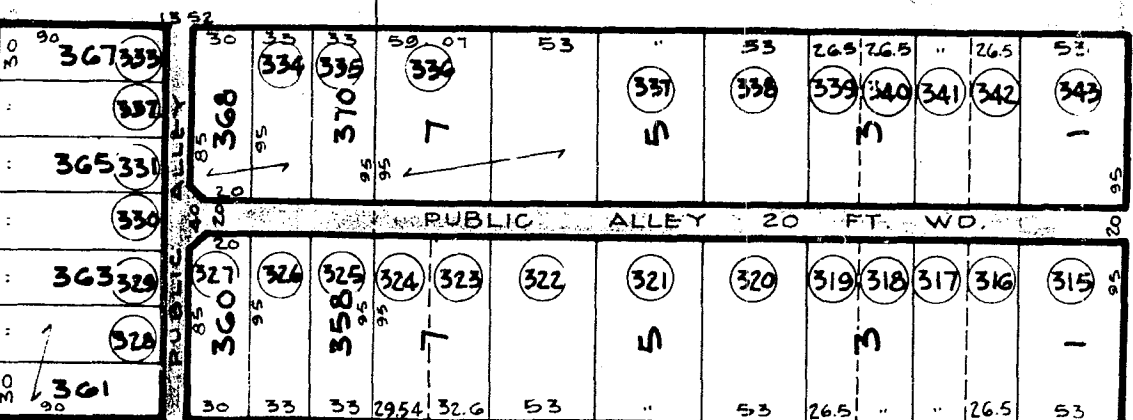

ILLINOIS

AVE. 50 FT. WD.

I HEREBY CERTIFY THAT THE PORTION OF THIS PLAT IN HEAVY OUTLINE SHOWS PROPERTY TO BE ACQUIRED BY THE CITY OF DETROIT FOR URBAN RENEWAL DEVELOPMENT AND OTHER MUNICIPAL PUBLIC PURPOSES, MEDICAL CENTER PROJECT SECTION 2, IN ACCORDANCE WITH A RESOLUTION OF THE COMMON COUNCIL ON OCTOBER 9, 1962 J.C.C. PAGES 2313-2315.

CITY ENGINEER

REQUESTED VACATION OF STREETS & ALLEYS
REQUESTED VACATION WITH RESERVATION FOR
UNDERGROUND EASEMENT.

DRAWING NO. 2296

CITY OF DETROIT

DEPARTMENT OF PUBLIC WORKS
CITY ENGINEERS' OFFICE

LAND TO BE ACQUIRED FOR MEDICAL CENTER-SECTION 2
LOCATED IN AN AREA BOUNDED BY WOODWARD, CHRYSLER FREEWAY,
ILLINOIS AND CANFIELD AVENUES.

SCALE 1"=100'

SHEET 1 OF 1 SHEETS

JOB
NO. MO 2 (1-531)

DRWG NO. 2296

DATE 1-21-63