

Henry Fralich  
Jeanette Fralich  
S. W. Kellogg  
W. W. Kellogg  
C. B. Fincher

Calvin B. Crosby Notary Public  
Wayne County Michigan

A. E. Warden  
Notary Public  
Kent Co. Michigan

Dated this 18<sup>th</sup> day of July 1910

Geo W Bennett

Clerk and Genl's Dept

RECEIVED

Wayne Co. # 11362

The following resolution was offered by Com. Kouk and supported by Com. Boyer:

WHEREAS, the City of Plymouth is desirous of providing for the people a right-of-way across property owned by it, to provide access from Church Street to S. Main Street, adjacent to the new Municipal Building, and

NOW, THEREFORE, BE IT RESOLVED, that the City of Plymouth sets off and dedicates for the use of the public, as a public street or highway, all of the following described land situated in the City of Plymouth, County of Wayne, State of Michigan:

Lot No. 11 of Fraleigh's Addition to the Village of Plymouth, T. 1 S., R. 8 E., Wayne County, Michigan, as recorded in the Wayne County records in Liber 2 of Plats, on Page 24; except a triangularly shaped piece in the Northeastly corner of said Lot No. 11, the two legs of said triangularly shaped piece being, (a) one leg 58 feet long measured S. 34° 12' W., along the Westerly line of said Lot No. 11, from the said Northeastly corner and (b) one leg 66 feet long measured Northwesterly 66 feet, along the Northerly line of said Lot No. 11, from the said Northeastly corner; the hypotenuse of said triangle being the line connecting the ends of the said two legs, also

The southerly twenty (20) feet of Lot No. 261, Lot 262, except the southerly six (6) feet thereof, the Northerly 92 feet, adjacent to the side, bearing and distance reading S. 46° 09' 00" E., 70.09 feet of Lot No. 264 and the Easterly twelve (12) feet of the southerly 55.71 feet of said Lot No. 264, adjacent to the side, bearing and distance reading S. 34° 56' 07" W., 108.35 feet on the Plat of Assessor's Plymouth Plat No. 10 or part of the V. 1/2 of Section 26, South of Main Street, and Lot 1 of Fraleigh's Addition to the Village of Plymouth of part of Section 26, T. 1 S., R. 8 E., City of Plymouth, Wayne County, Michigan, as recorded in the Wayne County records in Liber 65 of Plats, on Page 8, on January 28, 1933.


BE IT FURTHER RESOLVED, that said street shall be named Church Street.

BE IT FURTHER RESOLVED, that the City Clerk shall forward to the Auditor General, and shall record with the Register of Deeds, a certified copy of this resolution.

Carried unanimously.

I, Richard D. Shaker, City Clerk of the City of Plymouth, Michigan, hereby certify that the foregoing is a true and correct copy of a resolution adopted by the City Commission, said city, at a regular meeting held on Monday, November 16, 1934.

*Richard D. Shaker*  
Richard D. Shaker - City Clerk

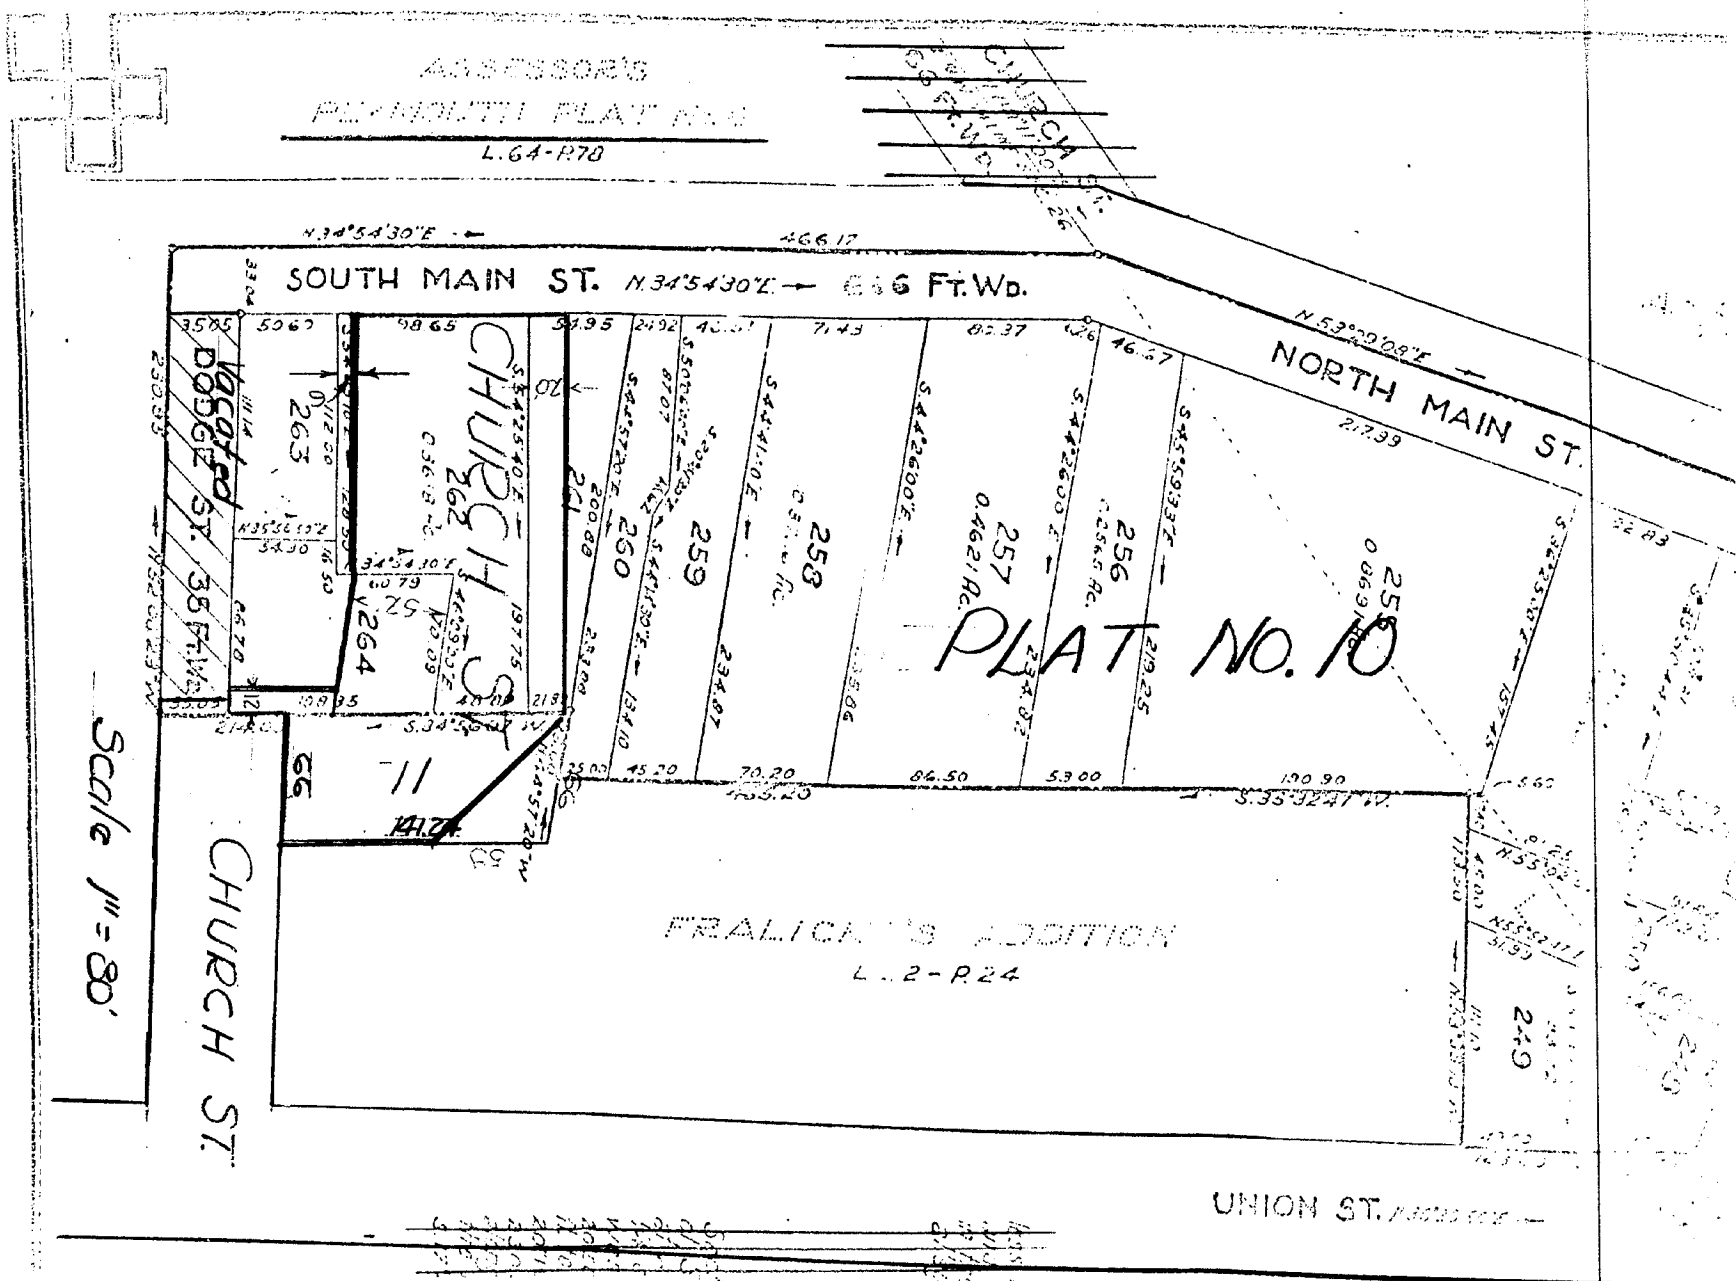

Wayne Co.

11362  
25907

RESOLUTION

The following resolution was offered by Comm. Bouk and supported by Comm. Jabars:

WHEREAS, this City Commission has determined that the name of a certain street in the City of Plymouth should be changed to conform with the provisions contained in the Subdivision Ordinance relating to the continuation of names of streets,

NOW, THEREFORE, BE IT RESOLVED, that Dodge Street, located in Assessor's Plymouth Plat No. 10 and in Prall's Addition to the Village of Plymouth, in the City of Plymouth, Michigan, be and the same hereby is changed from Dodge Street to Church Street.

BE IT FURTHER RESOLVED, that the Clerk shall forward to the Auditor General and shall record with the Register of Deeds, a certified copy of this resolution, together with his certification giving the name or names of any plat, subdivision or addition affected by this resolution, as required by Section 560.7 C.L. 1946, as amended by Act 52 P.A. 1992.

YES: Comm. Beyer, Bouk, Jabars, Layton, Smith and Mayor Vernette.  
NO: None.  
Carried unanimously.

I, Richard D. Shaffer, City Clerk of the City of Plymouth, Michigan, hereby certify that the foregoing is a true and correct copy of a resolution adopted by the City Commission, said City, at a regular meeting held on Monday, November 2, 1964. I further certify that the said street is located in Assessor's Plymouth Plat No. 10 and in Prall's Addition to the Village of Plymouth.

*Richard D. Shaffer*  
Richard D. Shaffer - City Clerk

TELEPHONE  
GLENNVIEW 51234  
RICHARD H. WERNETTE  
MAYOR  
ALBERT F. GLASFORD  
CITY MANAGER



CITY OF PLYMOUTH  
MICHIGAN

November 23, 1964

Billie S. Farnum  
Auditor General  
Capitol Building  
Lansing, Michigan

Dear Mr. Farnum:

Enclosed are two resolutions adopted by the City Commission of the City of Plymouth and certified by the City Clerk.

One resolution changes the name of Dodge Street to Church Street and the other dedicates certain land for public use as a street, also to be known as Church Street.

Very truly yours,

*A. F. Glasford*  
A. F. Glasford  
City Manager

AFG:lls

