
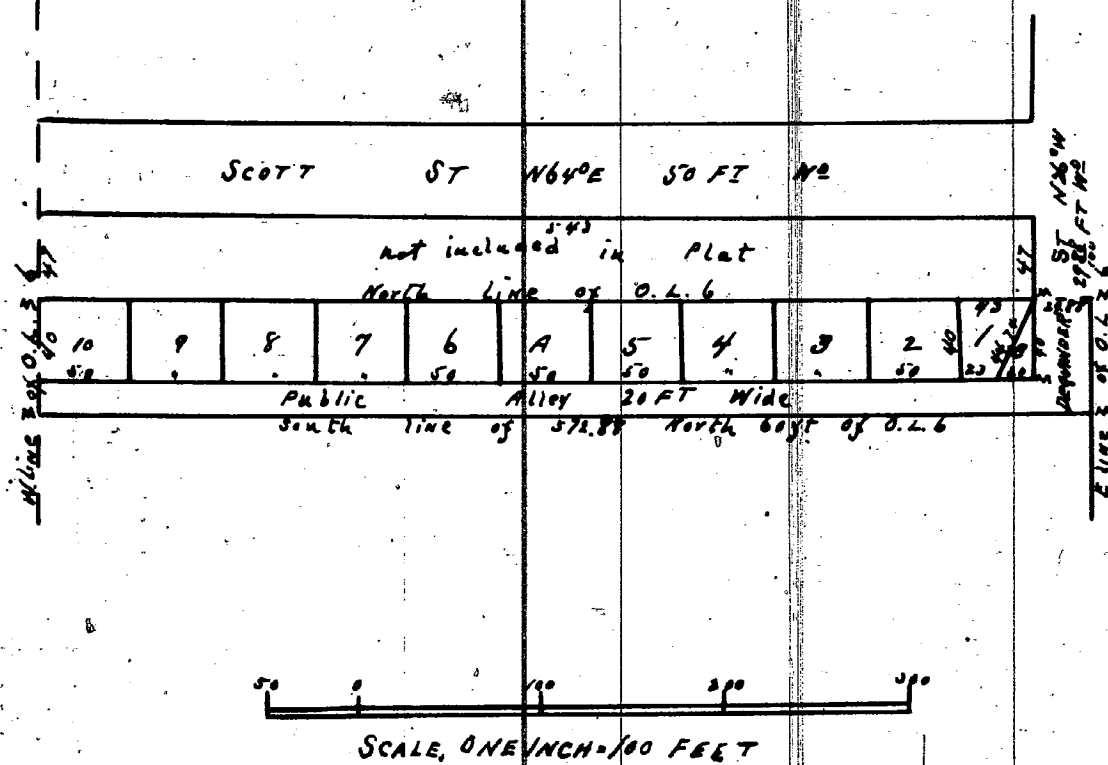


— "FARRAND'S"—
 — "Sub of the North 60 ft."—
 — "OF OUTLOT 6"—
 — "Of the Sub of the DEQUINDRE FARM"—
 — "Detroit, Wayne Co Mich"—

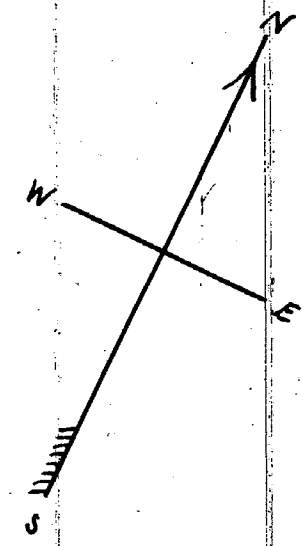

Know all men by these presents that the Board of Water Commissioners of the City of Detroit Michigan a body corporate under the laws of the State of Michigan have caused to be made for record this map of Farrand's Subdivision of the North 60 feet of Outlot 6 of the Subdivision of the Dequindre Farm Detroit Wayne County Michigan by McLaughlin and Camp surveyors and we hereby adopt the same and dedicate the streets and alleys shown for the use of the public

In presence of
 Frank A. Luce
 Frederick J. Stevens

Witness our hands and seals this Fourteenth day of
 March A.D. Eighteen hundred and eighty nine
 Jacob S. Farrand (S)
 President of the Board of Water Commissioners
 Leverette N. Case (S)
 Secretary of the Board of Water Commissioners

We hereby certify that the plat herein delineated is a correct one and that permanent monuments consisting of White Oak stakes have been planted at points marked "M" as thereon shown at all angles in the boundaries of the land platted and at all intersections of streets or streets and alleys

John McLaughlin
 and Thomas Camp
 Surveyors

Examined and approved
 March 20. 1889
 H. P. Pratt
 Deputy Auditor General

I hereby certify that this plat is a correct copy of the plat now on record in the Register of Deeds Office being made under the supervision of the Auditor General by tracing the plat on record and affixing thereto a carefully compared copy of the dedication and certificate.
 Dated this 20th day of Sept 1910
 Geo. W. Bennett
 Clerk Aud. Genl. Dept.

State of Michigan } ss.
 County of Wayne }

On this Fourteenth day of March A.D. Eighteen hundred and eighty nine before me the subscriber a Notary Public in and for said County personally appeared Jacob S. Farrand and Leverette N. Case President and Secretary of the Board of Water Commissioners who severally acknowledged that they executed the foregoing instrument as their free act and deed and the free act and deed of said Board of Water Commissioners and that they are duly authorized by said Board to execute the same in its behalf and to affix its corporate seal thereto
 Frederick J. Stevens
 Notary Public Wayne Co. Mich.

State of Michigan } ss.
 County of Wayne }

We P.C. Bird Dep. Register of Deeds John McLaughlin and Thomas Camp Surveyors hereby certify that we have read carefully compared this copy with the original plat of Farrand's Subdivision of the North 60 feet of Outlot 6 of the Subdivision of the Dequindre Farm Detroit Wayne County Michigan and that it is an exact copy thereof and of the whole of such original map or plat
 P.C. Bird Dep. Register of Deeds
 John McLaughlin and Thomas Camp } Surveyors.

Approved March 26 1889
 Thomas McGrath } Board of
 James H. Hawley } Public Works
 William H. Langley } City of Detroit

REGISTER'S OFFICE } ss.
 COUNTY OF WAYNE }
 Received for Record, the 27 day
 of March A.D. 1889 at 5
 o'clock P.M. and Recorded in Liber
 of Plate on Page 64
 P.C. Bird
 Dep. Register

By Councilman Ravitz:
Resolved, That all of Pierce Street, 40 feet wide, east of Riopelle Street, as platted in P. J. B. Crane's Subdivision of Outlots 53, 54, 57 and 58 of Riopelle Farm as recorded in Liber 53, Page 346 of Deeds Wayne County Records lying south of and adjoining the westerly line of Lot 15, south of and adjoining the southerly line of the 15.64 foot public alley adjoining Lot 15, north of and adjoining the northerly line of Lot 16, north of and adjoining the southerly line of the 15.64 foot public alley adjoining Lot 15, all of the above mentioned subdivision;
Also all that part of Dequindre Street, 29.88 feet wide, south of Scott Avenue, as platted in the Plat of the Subdivision of Lot 5 of Dequindre Farm as recorded in Liber 53, Page 195 of Deeds Wayne County Records lying east of and adjoining the easterly line of Lot 17 of the above mentioned subdivision;
Also all that part of Dequindre Street, south of Scott Avenue as platted in the Subdivision of the north 60.00 feet of Outlot 6 of the Subdivision of the Dequindre Farm as recorded in Liber 12, Page 64 of Deeds Wayne County Records lying north of and adjoining the corner of Lot 1 of the above mentioned subdivision, thence southerly along a line 44.74 feet to a point in the southerly line of Lot 1, said point being 23.00 feet easterly of the south-west corner of said Lot 1, thence southerly along a line 23.00 feet easterly of and parallel to the west line of Lot 1, 20.574, being in fact the southerly line of Lot 10 and 22 of P. J. B. Crane's Subdivision of Outlots 53, 54, 57 and 58 Riopelle Farm as recorded in Liber 53, Page 346 of Deeds Wayne County Records lying north of and adjoining the northerly line of Lots 11 and 31, north of and adjoining the northerly line of the 15.64 foot alley lying between Lots 11 and 31, south of and adjoining the southerly line of Lots 10 and 22, south of and adjoining the southerly line of the 15.64 foot alley lying between Lots 10 and 22, all of the above mentioned subdivision; J. B. Crane's Subdivision of Outlots 53, 54, 57 and 58 Riopelle Farm as recorded in Liber 53, Page 346 of Deeds Wayne County Records lying south of and adjoining the southerly line of Lot 1 extended easterly; thence westerly along the northerly line of Lot 1 extended easterly, 29.88 feet to the place of beginning;
Also, all of the east-west public alley, 20 feet wide, east of Orleans Street, south of Scott Street, as Rear of Dequindre Farm as recorded in Liber 53, Page 195 of Deeds Wayne County Records lying south of and adjoining the southerly line of the north 60.00 feet of Outlot 6 of the Subdivision of the Dequindre Farm as recorded in Liber 12, Page 64 of Deeds Wayne County Records lying south of and adjoining the southerly line of the westerly 23.00 feet of Lot 1, south of and adjoining the southerly line of Lots 2, 3, 4 and 5, all of the above mentioned subdivision;
Also all of the east-west public alley, 20 feet wide, south of Scott Street, west of Orleans Street as platted in Farrand's Subdivision of the north 60.00 feet of Outlot 6 of the Subdivision of the Dequindre Farm as recorded in Liber 12, Page 64 of Deeds Wayne County Records lying south of and adjoining the southerly line of Lot 6 to 10 both inclusive, all of the above mentioned subdivision;
Also, all of the north-south public alley, 15.64 feet wide, east of Riopelle Street between Pierce Street and

Scott Street, as platted in P. J. B. Crane's Subdivision of Outlots 53, 54, 57 and 58 Riopelle Farm as recorded in Liber 53, Page 346 of Deeds Wayne County Records lying east of and adjoining the easterly line of Lots 11 to 15 both inclusive, and west of and adjoining the westerly line of Lots 30 and 31, all of the above mentioned subdivision;
Also, all of the north-south public alley, 15.64 feet wide, east of Riopelle Street between Pierce Street and Erskine Street as platted in P. J. B. Crane's Subdivision of Outlots 53, 54, 57 and 58 Riopelle Farm as recorded in Liber 53, Page 346 of Deeds Wayne County Records lying east of and adjoining the easterly line of Lot 5 to 10, both inclusive, west of and

adjoining the westerly line of Lots 32 and 33, all of the above mentioned subdivision;
Also, all that part of the east-west public alley, 20 feet wide, east of Riopelle Street between Hale Street and Scott Street, as platted in the Plat of Subdivision of Lot 5 of Dequindre Farm as recorded in Liber 53, Page 195 of Deeds Wayne County Records lying north of and adjoining the northerly line of Lot 32, all of the above mentioned subdivision;
Also all that part of the east-west public alley, 20 feet wide, west of Orleans Street between Hale Street and Scott Street, as platted in the Plat of Subdivision of Lot 5 of Dequindre Farm as recorded in Liber 53, Page 195 of Deeds Wayne County Records lying north of and adjoining the northerly line of Lot 32, all of the above mentioned subdivision;
Be and the same are hereby vacated as public streets and alleys to become a part and parcel of the adjoining property; and further
Resolved, That all that part of Scott Street, 50 feet wide, east of Riopelle Street, the southerly 40.00 feet of said street as platted in P. J. B. Crane's Subdivision of Outlots 53, 54, 57 and 58 of Riopelle Farm as recorded in Liber 53, Page 346 of Deeds Wayne County Records lying north of and adjoining the northerly line of Lots 11 and 31, north of and adjoining the northerly line of the 15.64 foot alley lying between Lots 11 and 31, south of and adjoining the southerly line of Lots 10 and 22, south of and adjoining the southerly line of the 15.64 foot alley lying between Lots 10 and 22, all of the above mentioned subdivision; 


STATE OF MICHIGAN)
CITY OF DETROIT) ss.

SHORT FORM--TRUE COPY CERTIFICATE

I, THOMAS D. LEADBETTER, CITY CLERK of the City of Detroit, do hereby Certify that the annexed paper is a True Copy of a Resolution


adopted by the Common Council on 5-21-63

and approved by the Mayor on 5-28-63

as appears from the Journal of said Common Council, on file in my office,

IN WITNESS WHEREOF, I have hereunto set my hand and affixed the Corporate Seal of said City, at Detroit, on

Thomas D. Leadbetter
City Clerk

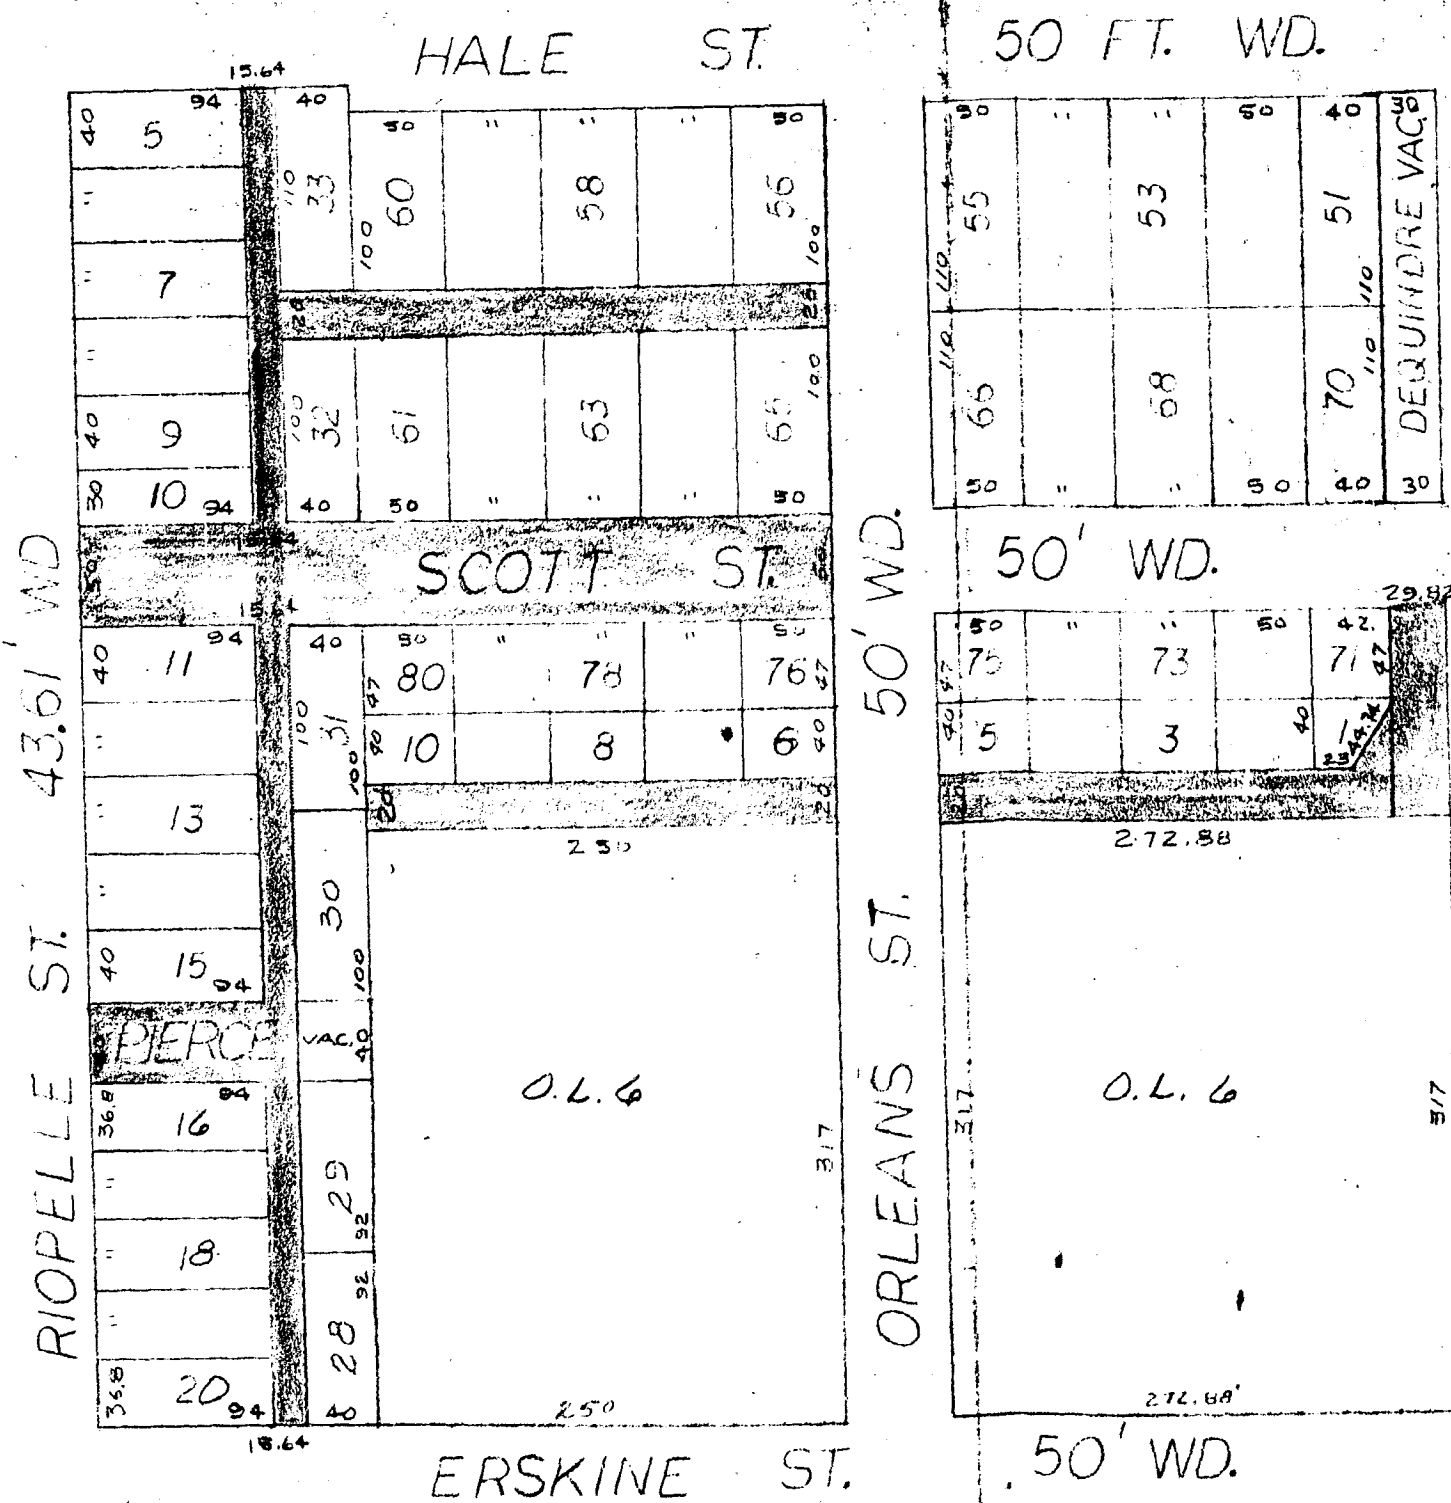

REQUESTED VACATIONS
STREETS & ALLEYS
IN RED

PETITIONER:
DEPARTMENT OF WATER SUPPLY

CRANE'S SUB'N
FARRAND'S SUB'N
PLAT OF DEQUINDRE FARM
TOPO. 39

FOR OFFICE USE ONLY

DESIGNED BY	APPROVED:	CITY OF DETROIT	REQUESTED VACATION AREAS IN RED
DRAWN BY	W. J. K.	DEPARTMENT OF PUBLIC WORKS	BOUNDED BY RIOPELLE, HALE, GRAND TRUNK RR, & ERSKINE
TRACED BY	ENGINEER OF	CITY ENGINEER'S OFFICE	BOOK NO.
CHECKED BY	R. K.	BUREAU OF DESIGN	SCALE 1" = 100'
DATE			DATE 2-18-63
			DRG. NO. X-2192