

PLAT of
LANGLEY'S Subdivision of Lot 159 Lambert Beaubien Farm.

City of Detroit. County of Wayne. Michigan.

T. 2 S. R. 12 E.

J. F. Munro Sur.

Know all men by these presents that I Henry Langley of City of Detroit, Wayne County, Michigan do hereby adopt the foregoing Plat for the purpose of Division. Witness my Hand and Seal this Month day of July in the year Eighteen Hundred and Seventy Five.

In Presence of
W. T. Galtier
John Campbell

Henry Langley Seal

State of Michigan }
County of Wayne } ss

On this Ninth day of July in the year Eighteen Hundred and Seventy Five before me the Subscriber a Notary Public in and for said County personally appeared Henry Langley to me known to be the same person described in and who executed the above instrument and acknowledged the same to be his free act and deed.

John Campbell
Notary Public
Wayne County

WE Charles Dupont Register of Deeds for the County of Wayne Michigan and John F. Munro Surveyor do hereby certify that we have carefully compared the Plat of Langley's Subdivision of Lot 159 Lambert Beaubien Farm, City of Detroit, County of Wayne Michigan with the Original Plat of said Subdivision and do also certify that it is an exact duplicate copy thereof and of the whole of such Plat.

I hereby certify that this plat is a correct copy of the Plat now on record in the Register of Deeds office, being made under the supervision of the Auditor General by tracing the plat on record and affixing thereto carefully compared copies of the dedication and certification.

Dated this 17th day of Aug 1910
Geo W Bennett
Clerk and Genl. Supt.

Chas Dupont Register
John F. Munro Surveyor

I John F. Munro do hereby certify the above Plat to be correct by Survey and Calculation. Dated July 7th 1875.
John F. Munro Sur

State of Michigan }
County of Wayne } ss


On this Ninth day of July in the year Eighteen Hundred and Seventy Five before me the Subscriber a Notary Public in and for said County personally appeared John F. Munro to me known to be the same person described in and who executed the above Certificate and acknowledged the same to be his free act and deed.

John Campbell
Notary Public
Wayne County

Registers Office }
Wayne County }

Received for record the 9th day of July A.D. 1875 at 10 O'clock P. M.

Chas Dupont
Register

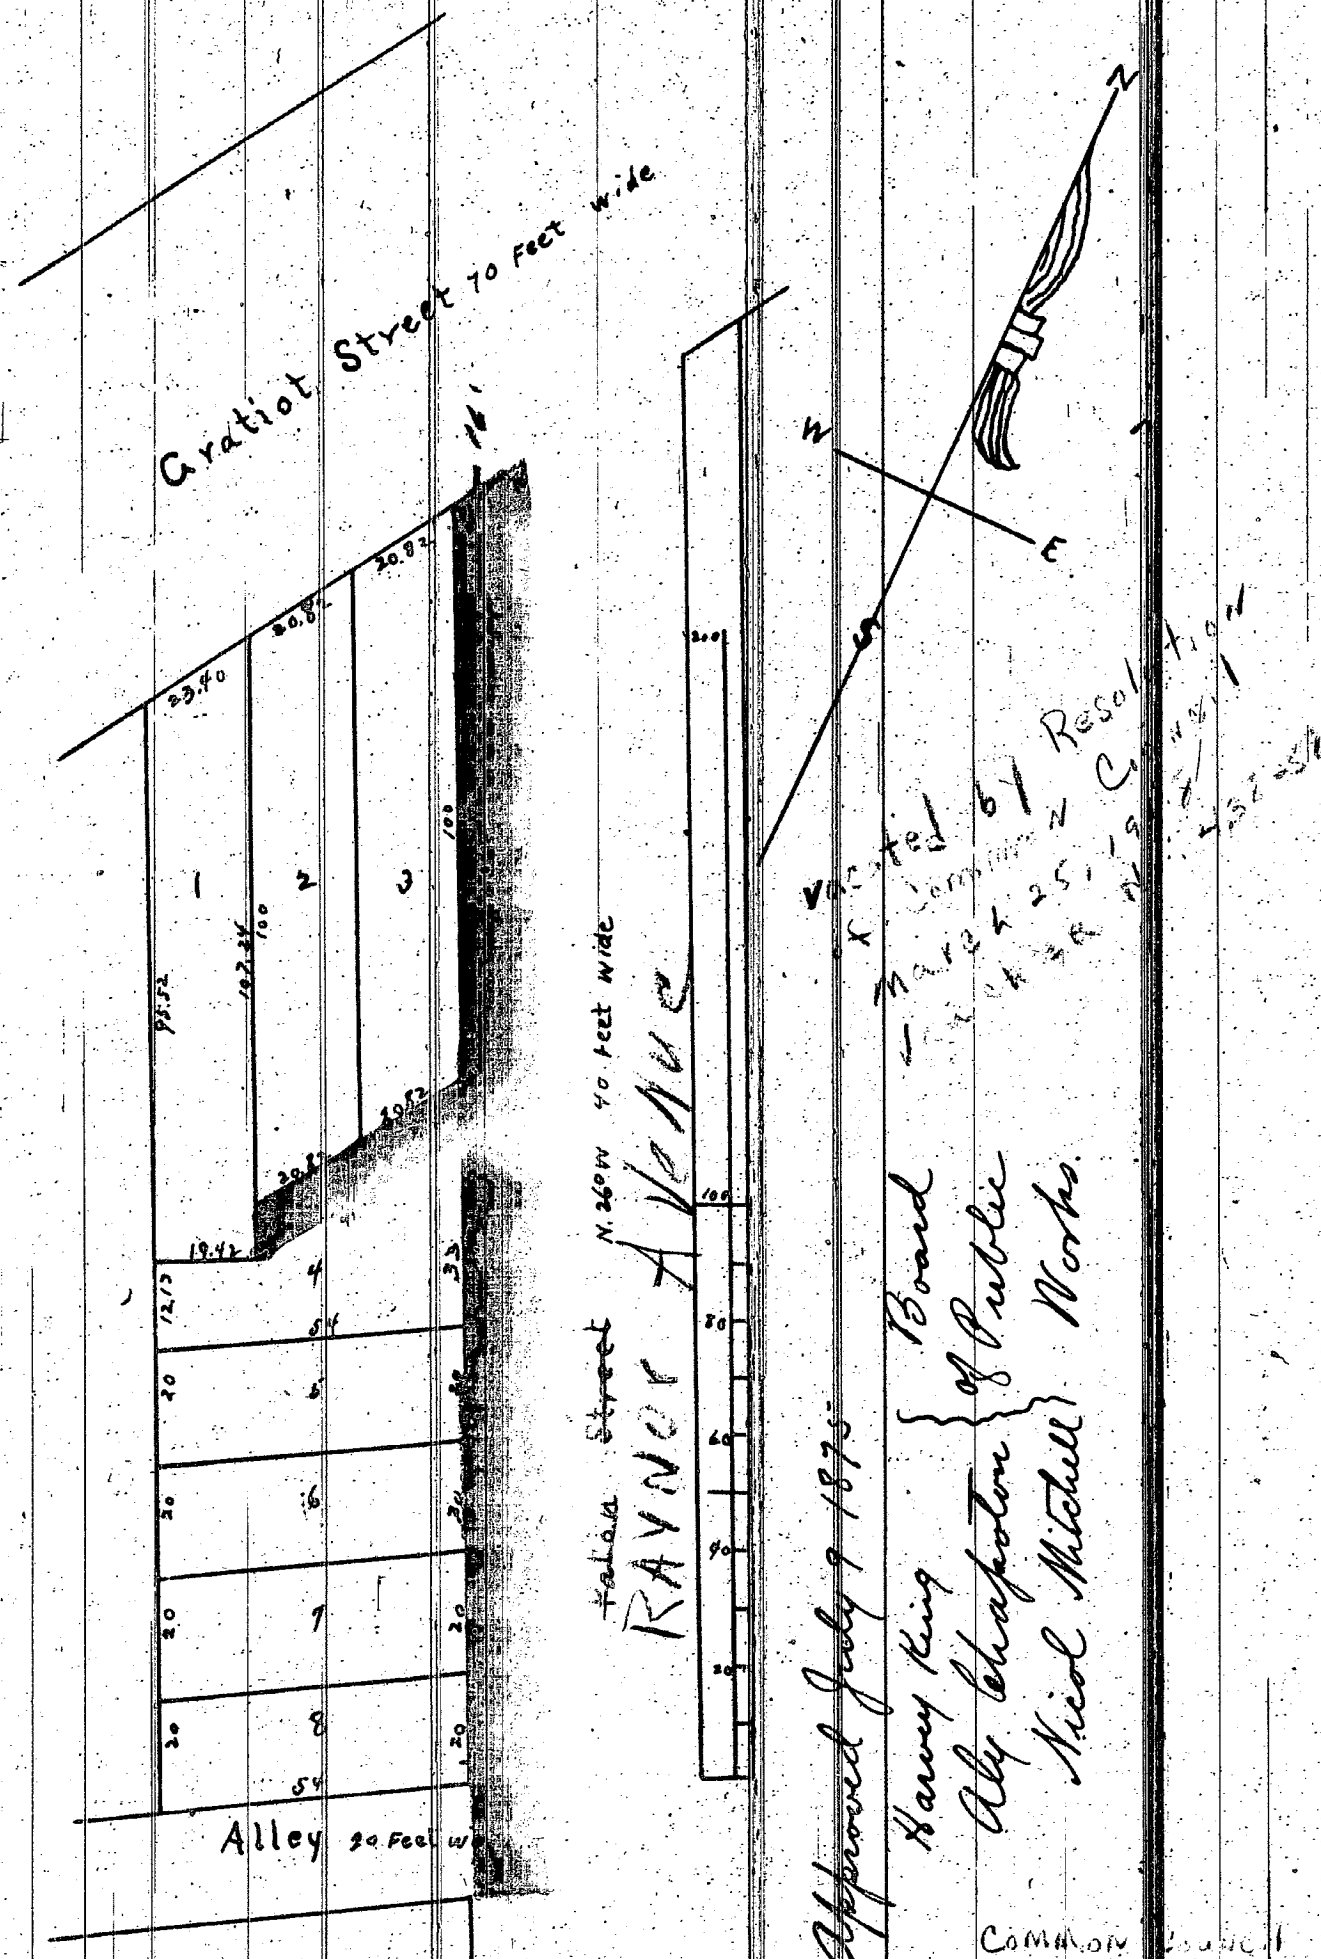

COMMON PLAT
SEPTEMBER 27 1875
61 60