

CHICAGO

BEACH

5378

Dedication

Know all Men by these Presents, That we Charles B. Buck and
proprietor and Ella C. Buck his wife have conveyed the land embraced
in the Chicago and Avenue plat to be surveyed and plotted to be known as Chicago Beach
and that the streets and avenues as shown on said plat are hereby dedicated to the use of the public
and of the whole of such area as
Charles B. Buck
Ella C. Buck

State of Michigan

before me a Notary Public in and for said County personally came the named
Charles B. Buck and Ella C. Buck his wife known to me to be the persons
who executed the above described instrument and acknowledged the same to be their
free and voluntary act and deed.

Notary Public in and for said County
W. H. Wood

Examined and Approved
August 1st 1903.
John F. Williamson
Deputy Auditor General

The land embraced in the annexed plat of Chicago Beach is described as follows:
containing of more or less land, being the same as the land of said lot 2 of Section 3,
of Right of way of Marguerite Road, Thence South westerly along
said Right of way 127.70 feet to 65 feet line, Thence South westerly along
said 65 feet line to Marguerite Road, Thence South westerly along
Marguerite Road to street, Thence South westerly along street 139.50 feet to
75.25 feet line, Thence South westerly along 75.25 feet line to plat of Chicago Beach.

I hereby certify that the plat of
Chicago Beach is a correct copy and that permanent
monuments, consisting of iron stakes, have been
planted at points marked thereon, as the same are shown
at all angles in the boundaries of the land of Chicago Beach,
and at all intersections of streets or streets
and ranges.


State of Michigan




State of Michigan
J. C. Brewster, Surveyor, hereby certify that
we have each carefully compared the annexed
copy with the plat of Chicago Beach, and that it is an exact copy thereof,
and of the whole of such area as

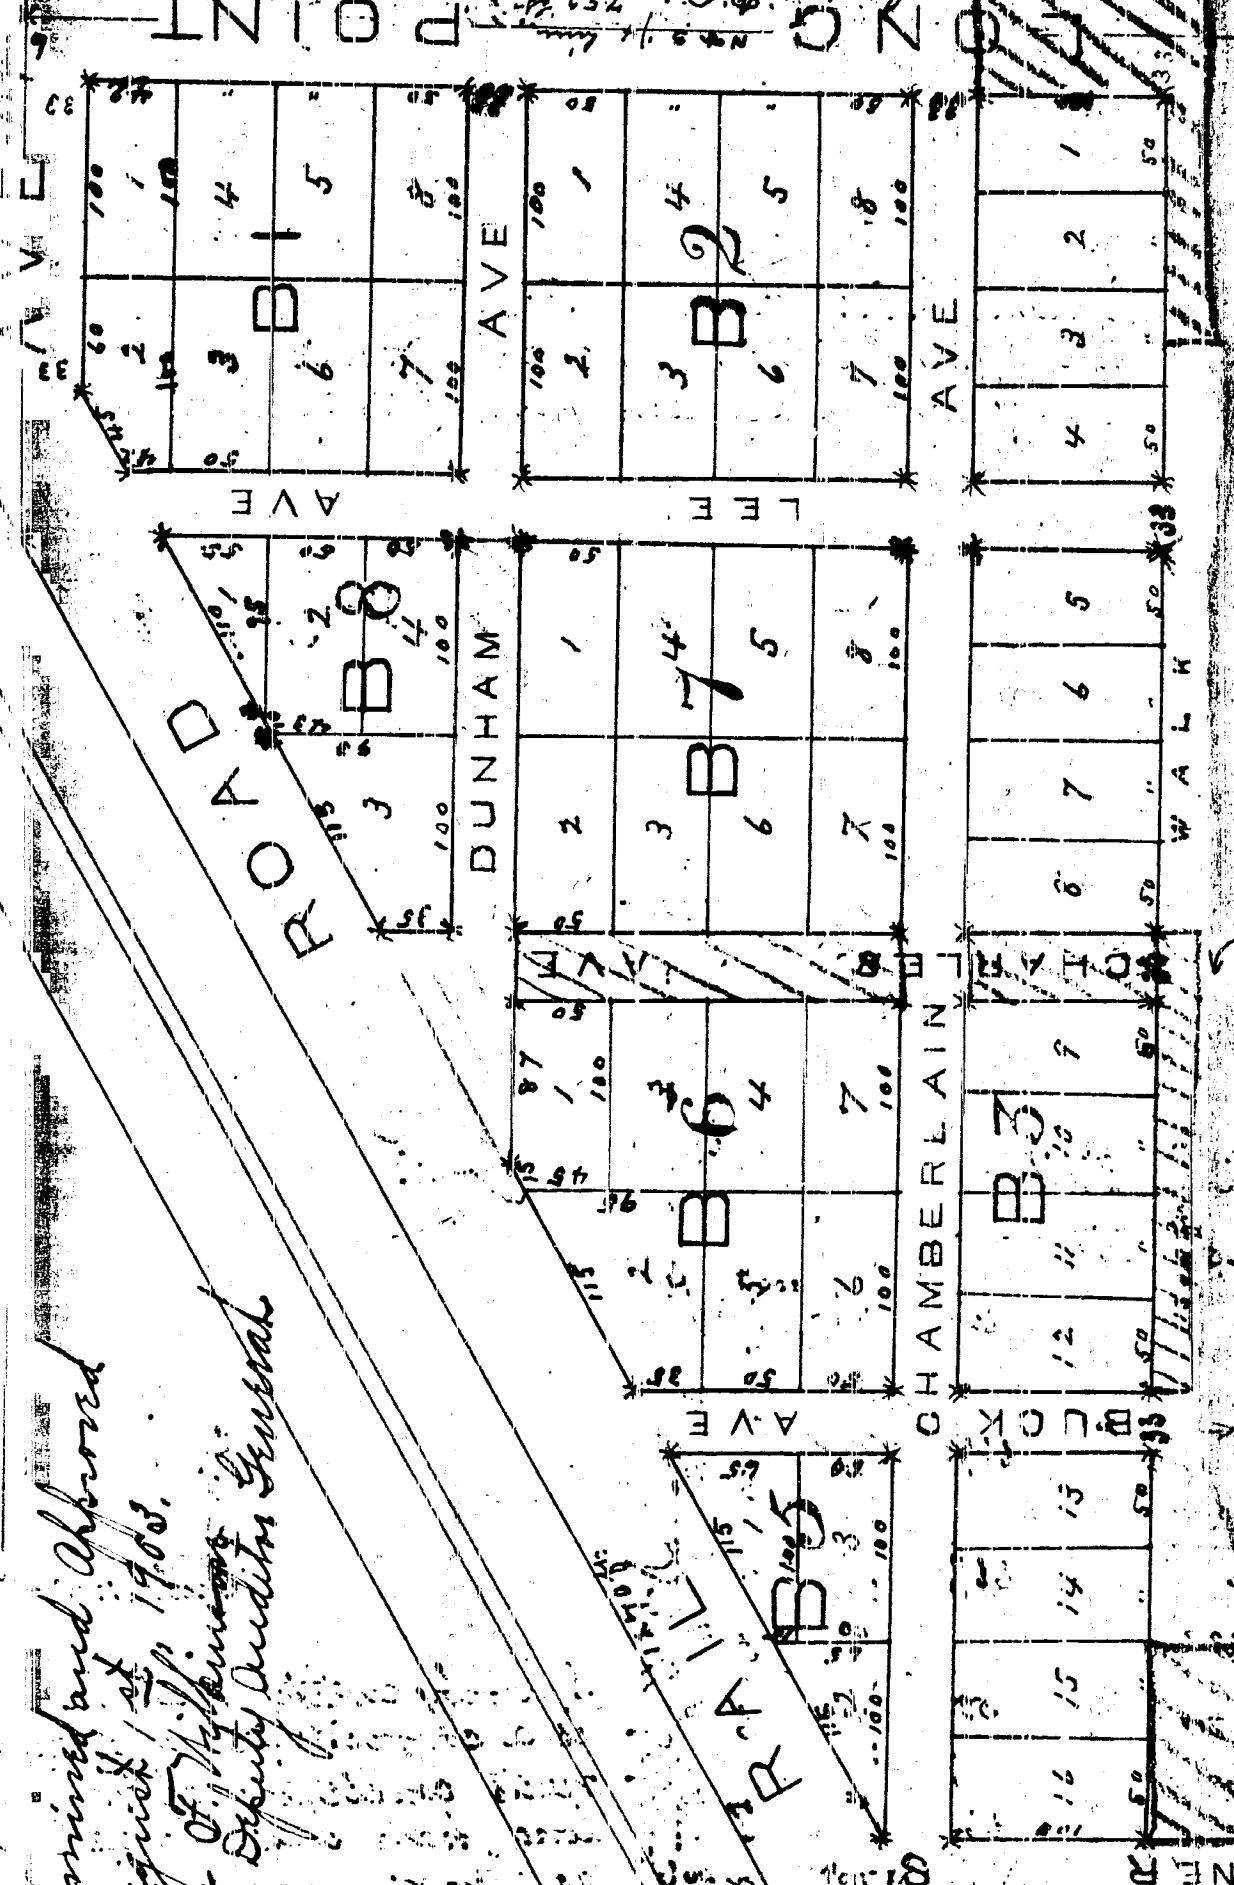

VACATED BY CIRCUIT COURT
ORDER 10-14-10

VACATED BY CIRCUIT COURT
ORDER 10-14-10

VACATED BY CIRCUIT COURT
ORDER 10-14-10

VACATED BY CIRCUIT COURT
ORDER 10-14-10

RECEIVED AND FILED
IN AUDITOR GENERAL'S OFFICE
NEWAYGO COUNTY, MICH.
Oct 5-1903

Received for Record, this 22nd day
of August, A. D. 1903, at 10 o'clock
A. M.
at the State of Michigan
Charles E. Gannon
Register of Deeds

11686