

SCALE 150 FEET - 1 INCH

I hereby certify that this plat is a correct copy of the plat now on record in the Register of Deeds office being made under the supervision of the recorder General by having the plat on record and affixing thereto a carefully compared copy of the dedication and certificate

Dated this 16th day of May 1911
John B. G. Tamm
County Clerk

State of Michigan

In the County of Delta

In the matter of the petition of Otto Mathews Samuel B. Rathfon and George M. Rathfon for the alteration of the plat of the Mathews addition to the City of Gladstone, Delta County Michigan

Geo Mathews, Samuel B Rathfon and George M Rathfon having presented to the Court a petition for the alteration of the plat of the Mathews addition to the City of Gladstone Delta County Michigan, this petition having been brought on for hearing and satisfactory evidence having been furnished by said petitioners that they are the owners of the Mathews addition to the City of Gladstone, Delta County Michigan, and that the notices required by section 3316 of the Compiled Laws of 1891 have been given, and that there is no reasonable objection to making the alteration prayed for in said petition

Now therefore it is adjudged and determined by the said Court that said plat be and hereby is altered by changing the size of the frontage of all the lots in the block from 10 feet to 25 feet with the exception of lot 28 of block 4, which is to remain with 40 feet frontage, being the same lot and block which was formerly lot 18 of block 4, and lot 27 of block 4, which is 30 feet, and changing the name of the street, in accordance with the blue print hereto attached and marked exhibit A and made a part of this order

Dated July 25th 1900
J. M. Stone
Circuit Judge

State of Michigan }
County of Delta }

O. O. Jordan, Clerk of said County of Delta, and Clerk of the Court for said County, do hereby certify that I have compared the foregoing plat of said Mathews addition with the original record thereof now remaining in my office and that it is a true and correct transcript thereof, and of the whole of such original record

STATE OF MICHIGAN
REGISTER OF DEEDS
DELTA COUNTY

Received for Record this 25th day of July A.D. 1900 at 10 o'clock A.M. and recorded in Liber 2 of Delta

OT Jordan
Register



R E S O L U T I O N

MOTION BY: Commissioner Norton
SUPPORTED: Commissioner Kee

Delta Co.

This matter having come on to be heard by the City Commission of the City of Gladstone on this 27th day of July 1966 pursuant to resolution adopted by this Commission on the 27th day of June 1966 and due notice thereof having been published in the Delta Reporter, a newspaper published and circulated in the City of Gladstone, Michigan on the 6th day of July 1966;

After listening to objections and arguments thereon, it being made to appear that it would be in the best interest and welfare of the City of Gladstone if the City right-of-way lying between the East boundary of Lots 17 through 24 inclusive of Block 11 in the Alteration of the Marble Addition to the City of Gladstone, County of Delta, State of Michigan and the Soo Line Railroad right-of-way from Highway M-35 Southerly to the intersection of the City right-of-way with the alley in Block 11 of the Alteration of the Marble Addition to the City of Gladstone should be vacated and abandoned,


BE IT RESOLVED that the City right-of-way lying between the East boundary of Lots 17 through 24 inclusive of Block 11 in the Alteration of the Marble Addition to the City of Gladstone, County of Delta, State of Michigan and the Soo Line right-of-way from Highway M-35 Southerly to the intersection of the City right-of-way with the alley in Block 11 of the Alteration of the Marble Addition to the City of Gladstone should be and the same is hereby abandoned.

YEAS: Commissioners Kee, Norton and Stupak
NAYS: None
ABSENT Commissioners Nelson and Young
MOTION DECLARED CARRIED

file 118 34

I hereby certify that the above is a true and correct copy of the resolution passed by the Gladstone City Commission at a special meeting held on July 27, 1966 A.D.

H. J. Henrikson
H. J. HENRIKSON, City Clerk
City of Gladstone
County of Delta, Michigan

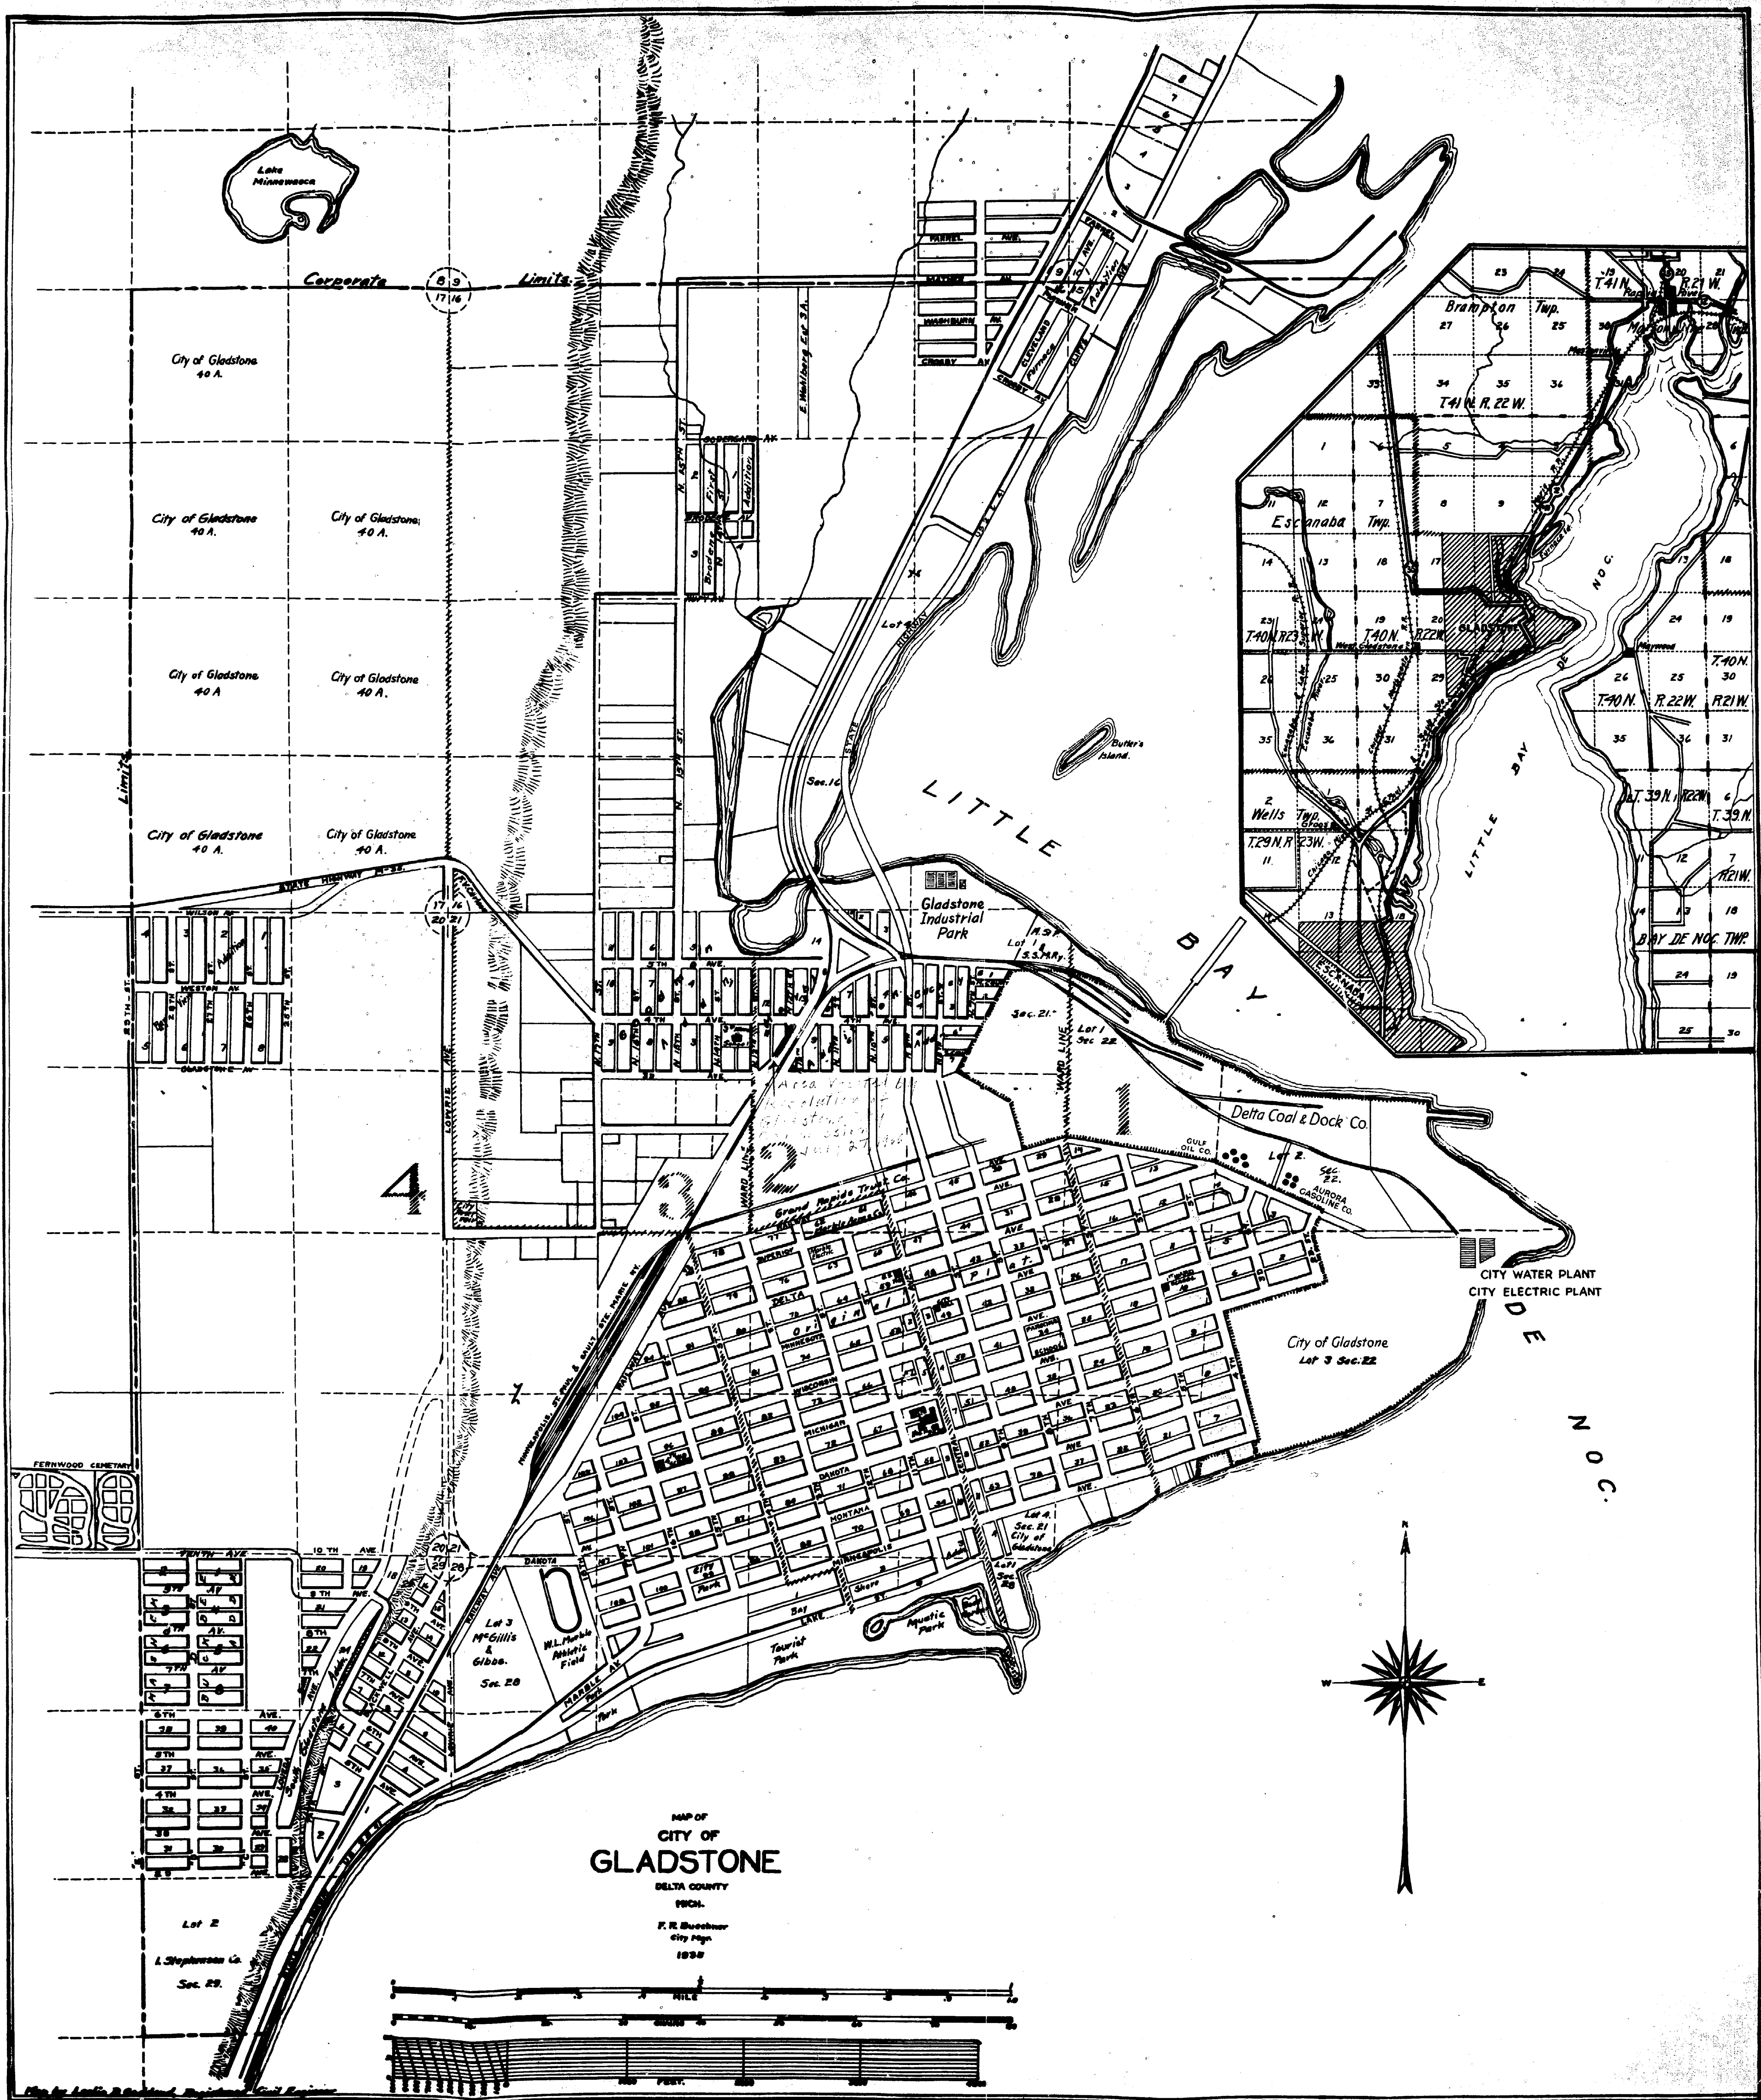

Delta County Vacations

P L A T-- PROPRIETORS ADDITION TO THE CITY OF ESCANABA

In re petition)
E.R.Royce to
Vacate BLOCK 101
and an Alley)

ORDERED: That that part of the City of Escanaba known as Block 101 of Proprietors Addition be Vacated together with an Alley running East and West through said Block from Cleveland Avenue on the East to an alley on West line of said Block; That said Alley so vacated divides lots 1,2, and 3 on the south side from lots 4,5, and 6 on its north side, and that the south 10 feet, being the south half of said alley, be attached to that part of Lots 1,2, and 3 that borders on said alley and that the north 10 feet, being the north half of said Alley be attached to that part of Lots 4,5, and 6 that borders on said Alley and the title shall vest in the owners respectively.

Order Judge J.W.Stone
November 3 1893
C C Jour E page 190-1
County Plat Book A 23

Aud Gen Dept Vol 42 88

Page 2595 5951

Eddy & Bennett
Plat Examiners
October 12 1915

Delta County Vacations

PLAT--Marble Addition to City of Gladstone

In re petition)
Peter Matthews)
et al for Alter)
action of Plat)

ORDERED : That said plat be and hereby is Altered by changing the size of the frontage of all the lots in the blocks from 40 feet to 25 feet, with EXCEPTIONS of LOT 28 of Block 4 which is to remain with 40 feet frontage being the same lot and block which was formerly Lot 18 of Block 4, and Lot 27 of Block 4, which is 30 feet, and
Changing the Names of the Streets, in accordance with the blue print hereto attached and marked exhibit "A" and made a part of this order.

Note: See the 11834
state plat page 11162 Vol 145 for
copy order and the exhibit "A"


Order Judge J.W.Stone
July 25,1900
C C Jour F page 122
County Plat Book A-28

Aud Gen Dept Vol 145

page 2808 11834

Eddy & Bennett-Plat Examiners-October 12 1915

141

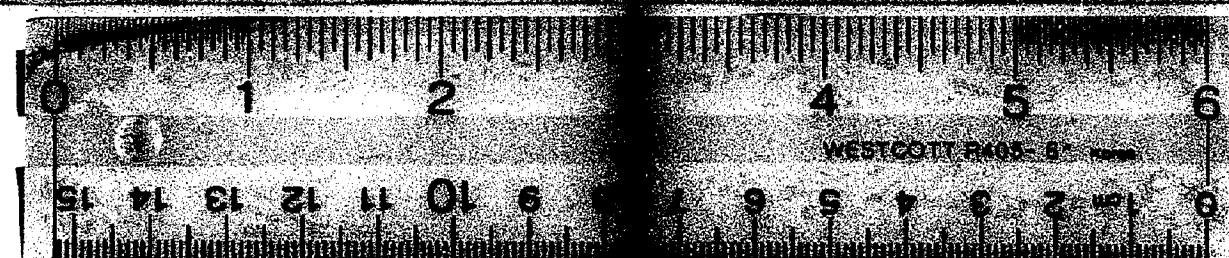

16 X