


A Plat of the Survey of Section 16 T.2 S. of R.6. E

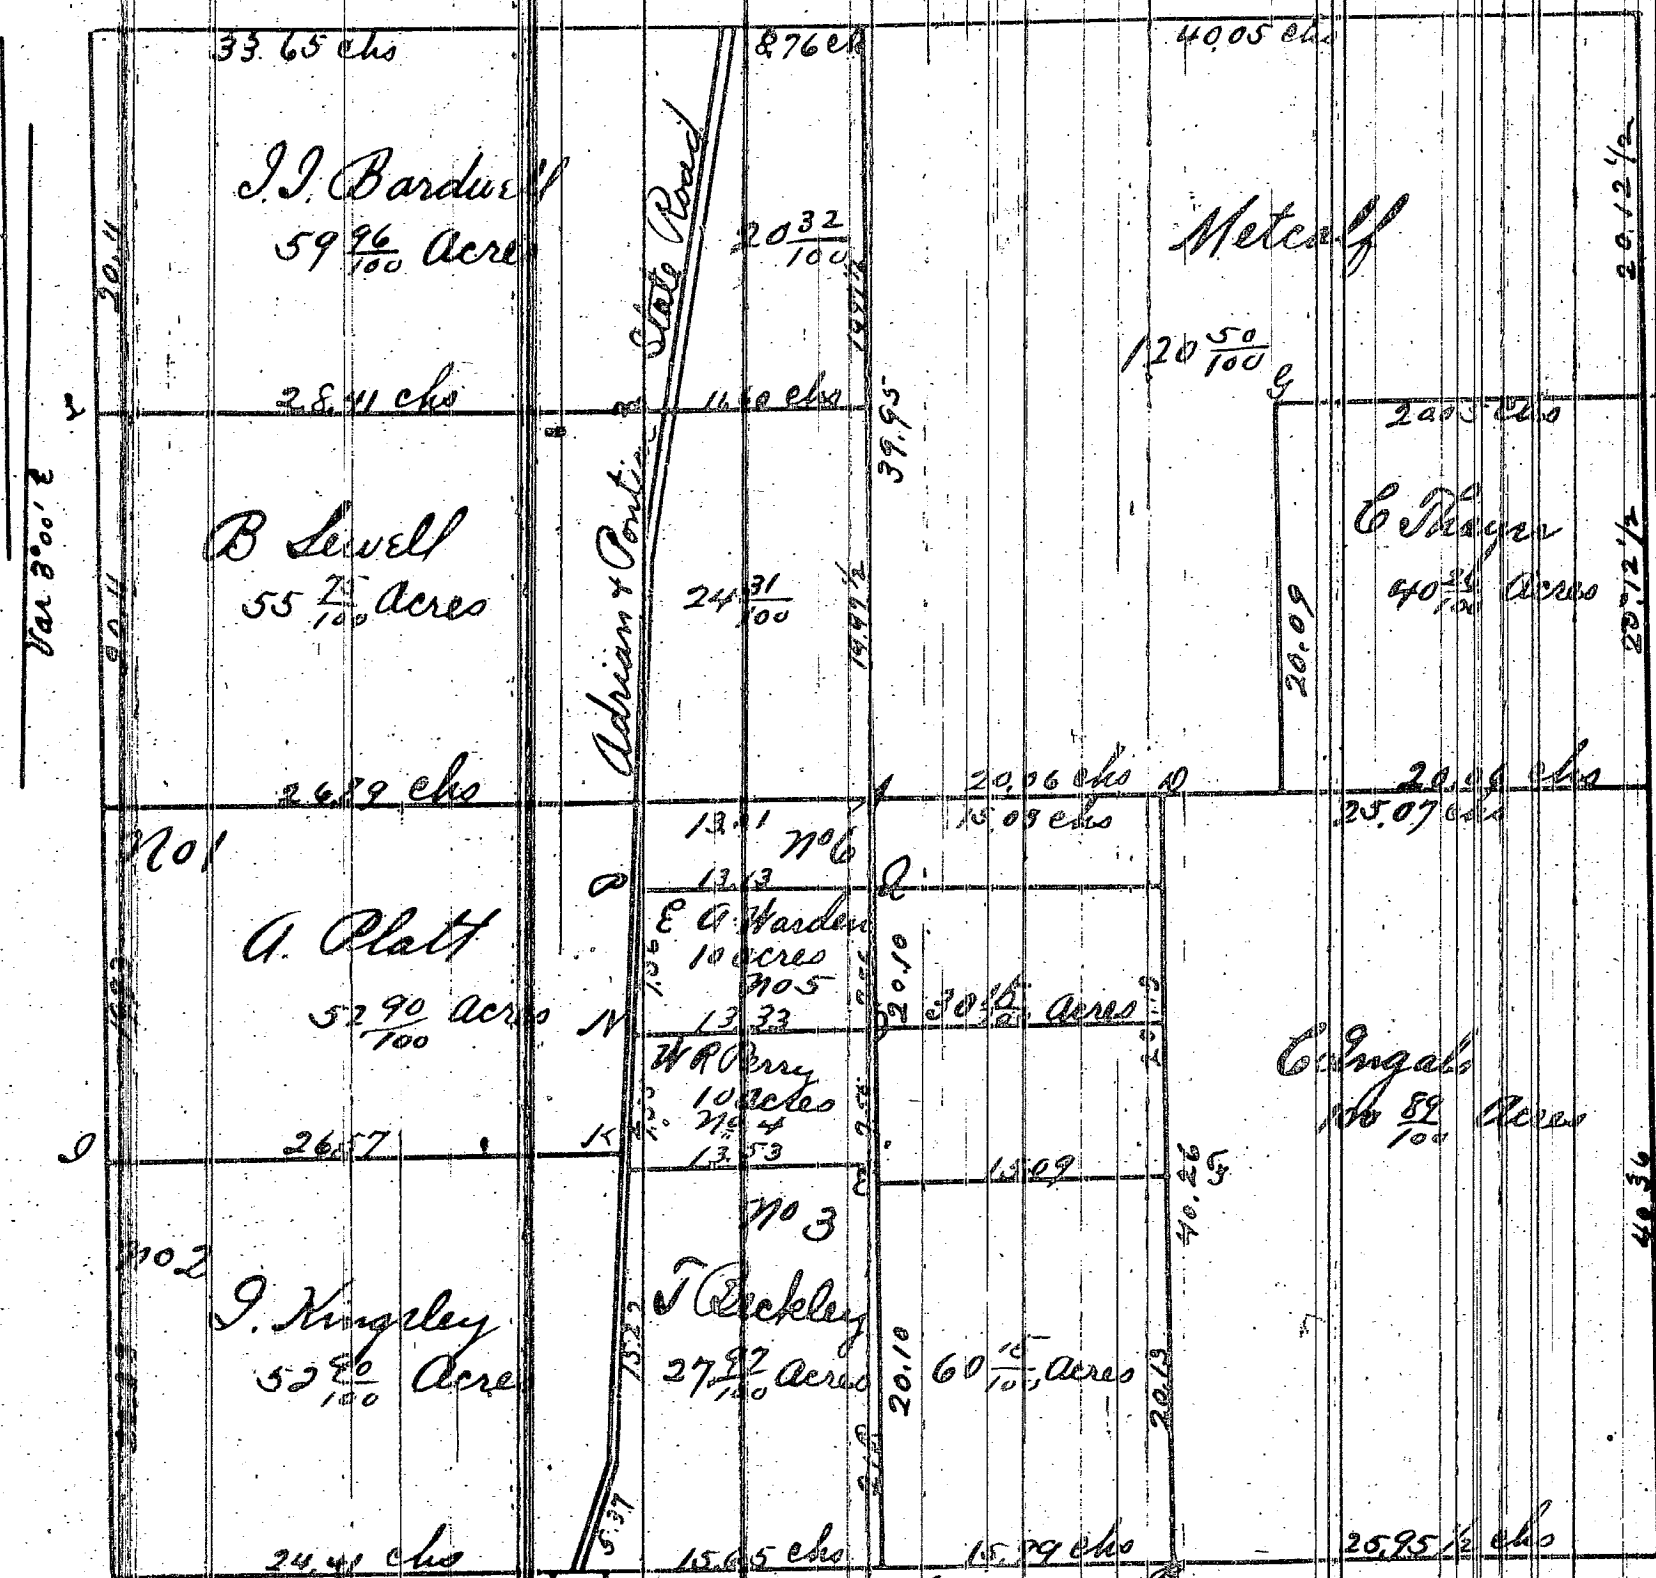

A	Hickory	12	71520	12
B	Hickory	5	5230	3 1/2
C	H. Oak	14	824 1/2	46 1/2
D	H. Oak	15	837 1/2	81
E	H. Oak	30	838	16 1/2
F	H. Oak	20	810	105
G	H. Oak	28	764 1/2	78
H	B. Walnut	20	856	33
I	Maple	7	874	84
J	H. Oak	14	710 1/2	19
K	Lump Oak	10	760 1/2	10 1/2
L	H. Oak	24	770	44
M	H. Oak	20	850	29
N	Hickory	8	712 1/2	44
O	Hickory	9	824 1/2	120
P	Elm & Lump	30	712 1/2	47

Scale 10 chains to an inch
Surveyed in December 1837
by John Farnsworth

The S. 1/4 of Section 16 of Township 2 South, Range 6 East is divided by Jas. Kingley into the original purchase into lots of various sizes which are numbered on said Plat from 1 to 6 Geo. Consilius Register of Deeds.
Dated Aug 4th 1841

I hereby certify that this Plat is a correct copy of the Plat now on record in the Register of Deeds Office being made under the Supervision of the Auditor General by tracing the Plat on Record and affixing thereto a carefully compared copy of the Certificate.
Dated the 10th day of January 1841

Alton B. Hunt
Clerk, Aud Gen Rept