

Alteration of
Block VIII of
Edmond & John Canfield's
Addition to the
Village of Manistee

We the undersigned owner and possessor of Block VIII in Edmond & John Canfield's addition to the Village now City of Manistee hereby affirm and acknowledge that on the 28th day of November 1871 we did petition the Common Council of the City of Manistee that the alley running north and south through said block be changed eastward as shown by the plat hereon delineated and that said petition was entertained by said Council and by Motion carried with and granted as shown by public record of Proceeding of said Council November 28th 1871 and we do hereby further acknowledge that the above change is made and our signatures hereto affixed of our own free will and accord.

May 11th A.D. 1872


Robert M. Risdon
John Canfield

State of Michigan } ss.
County of Manistee }

On this 11th day of May 1872 personally appeared before me a Notary Public in and for said County the above Robert M. Risdon and John Canfield to me known to be the persons who signed the above instrument and acknowledged the same to be their free act and deed.



N.W. Nelson
Notary Public

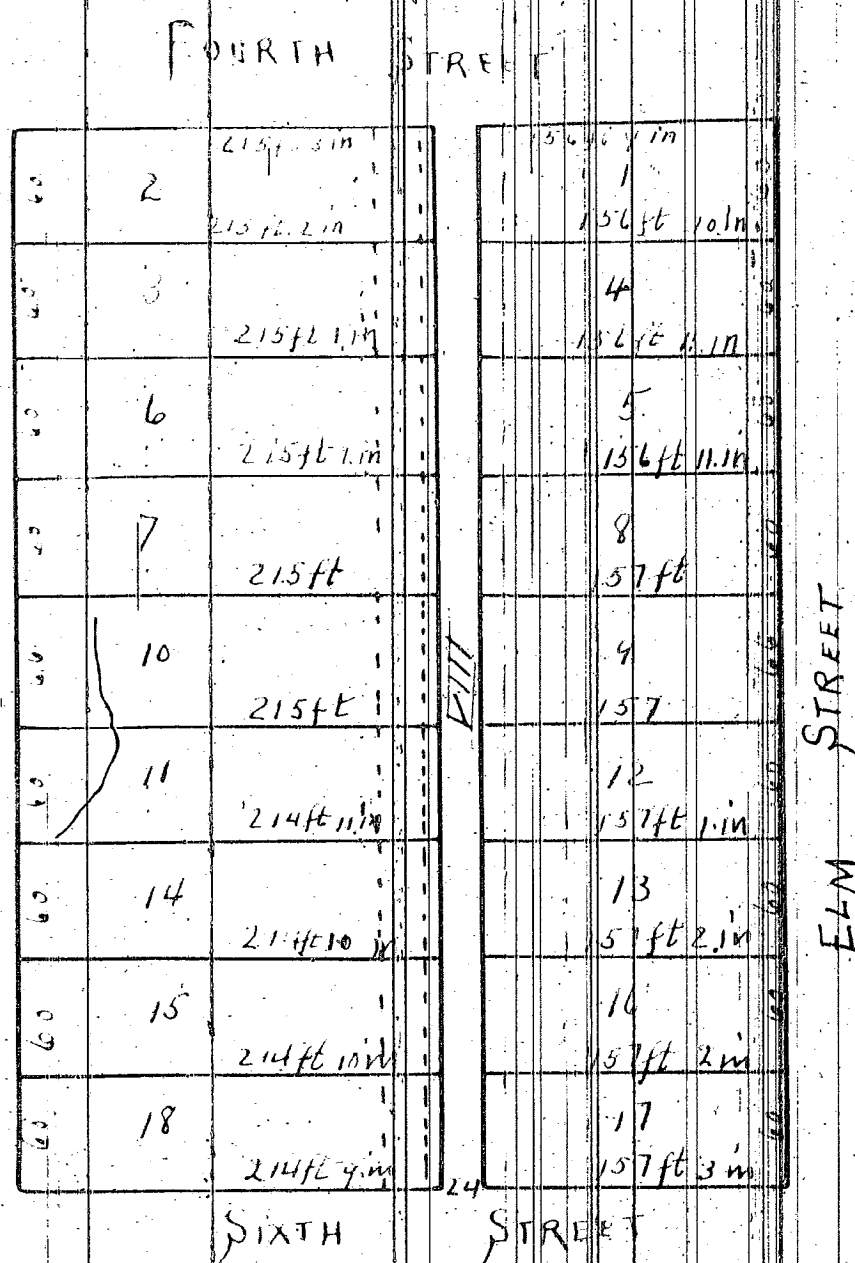

The undersigned City Surveyor of the City of Manistee do hereby affirm and acknowledge that I made the plat hereon delineated showing the change of alley through Block VIII of Edmond & John Canfield's addition to the Village now City of Manistee in accordance with the petition of Robert M. Risdon and John Canfield November 28th 1871 and that I was instructed by them to make such plat and that the same is correct to the best of my knowledge and belief.

Dated this 7th day of May 1872

William Vincent

State of Michigan } ss.
County of Manistee }

On this 7th day of May 1872 personally appeared before me a Notary Public in and for said County the above William Vincent to me known to be the person who signed the above instrument and acknowledged the same to be his free act and deed.

Samuel S. Glover
Notary Public

Register office
Manistee County }

Received for record at 10 o'clock A.M. May 11th A.D. 1872

Thos. C. Walker
Deputy Register

Notary certify that this plat is a correct copy of the plat now on record in the Register of Deeds of Manistee County being made under the supervision of the Auditor General of Michigan the plat on record and affixing thereto a carefully compared copy of the election and certificate.

Dated this 17th day of July 1871
John S. F. Whitcomb
Clerk of the Court