4777

Deeds Office
County.
ment was rece... 23
November 9 25
C.M. and record... 21
on page 72 was ...
a compliance ...
No. 186 File ...

S R Kingsley

CENTRAL PLACE SUBDIVISION ON

THE S.½ OF SECTION 28 IN THE CITY OF WYANDOTTE IN
T. 3. S. R. 11. E. WAYNE COUNTY MICHIGAN

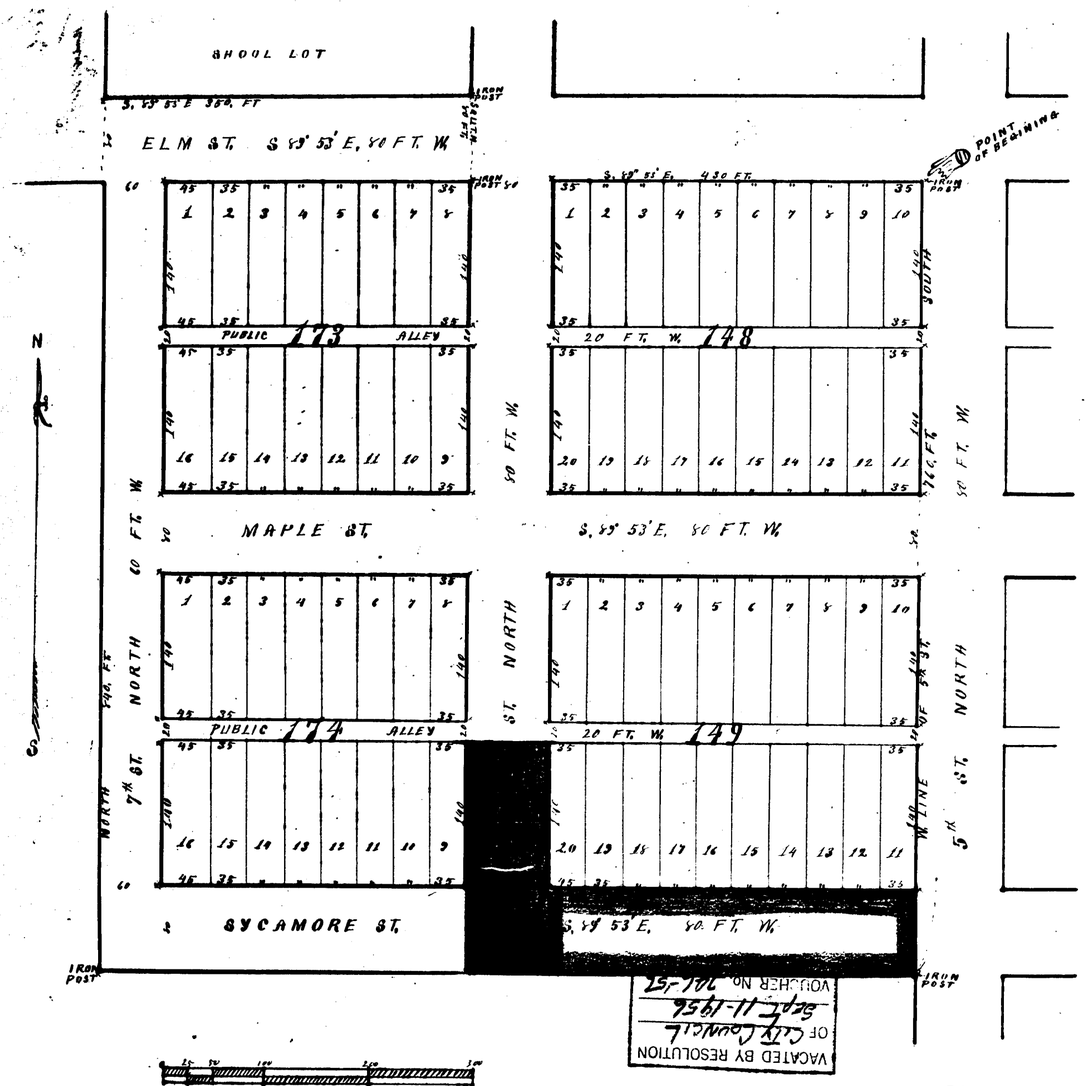

RECEIVED AND FILED.
IN AUDITOR GENERAL'S OFFICE,
Jany 5 1900
John F. Wilkinson
Deputy Auditor General.

I hereby Certify that the plat hereon delineated is a correct one and that permanent monuments consisting of oak Stakes (except where iron is marked) have been planted at all the angles in the boundaries of the land platted, and at all intersections of Street and streets and alleys, at points marked thus x as thereon shown

Det. Sept 20th 1899 A. H. Willmarth
Surveyor

Examined and Approved
Sept 25th 1899
John F. Wilkinson
Deputy Auditor General

Description of the land platted

The land embraced in the plat hereon laid down is described as follows. Commencing at an iron post at the S. W. Corner of Elm and fifth Streets on the S.½ of Section 28 in the City of Wyandotte, T. 3. S. R. 11. E. Wayne County Mich, Thence along the west line of fifth street, South 780 feet to an iron post. Thence N. 88° 53' W. 750 feet to an iron post. Thence north, 890 feet to a post at the S. W. corner of the school lot. Thence along the South line of said lot. S. 89° 53' E. 350. feet to an iron post Thence south 80. feet to an iron post. Thence S. 89° 53 E. 430 feet to the place of beginning

Know All Men by these Presents that the Wyandotte Land Company by their legal representative, W. Howie Muir, have caused the land embraced in the annexed plat to be surveyed, laid out and platted, to be known as Central Place subdivision, on S.½ of Section 28 in the City of Wyandotte, in T. 3. S. R. 11. E. Wayne County Michigan, and that the streets and alleys as thereon shown are hereby dedicated to the use of the public, Witness their Corporate Seal

Signed and Sealed in presence of Witness R. J. McKinnon, E. A. Parkinson

W. Howie Muir (L.S.)

Corporate Seal

State of Michigan } ss
County of Wayne } On this 25th day of September A.D. 1899 before me the subscriber a Notary Public in and for said county, personally appeared W. Howie Muir to me known to be the same person who executed the above dedication, who has acknowledged the same, to be the free act and deed of the Wyandotte Land Company, as their secretary duly authorized

Charles A. Parkinson
Notary Public
Wayne County, Michigan

State of Michigan } ss
County of Wayne } We S R Kingsley Register of Deeds and A. H. Willmarth Surveyor, hereby certify that we have each carefully compared this copy with the original plat of Central Place subdivision in the City of Wyandotte and that it is an exact copy thereof and of the whole of such original map or plat

S R Kingsley Register of Deeds
A. H. Willmarth Surveyor

State of Michigan } ss
County of Wayne } We S R Kingsley Register of Deeds and A. H. Willmarth Surveyor, hereby certify that we have each carefully compared the annexed copy with the plat of Central Place Subdivision in the City of Wyandotte, now of Record in the office of said Register of Deeds, and that it is a true transcript therefrom and of the whole of such record

S R Kingsley Register of Deeds
A. H. Willmarth Surveyor

514-1900

State of Michigan } ss
County of Wayne }
Seal City of Wyandotte

I hereby Certify that the foregoing plat was approved by the Common Council of the City of Wyandotte this 6th of November A.D. 1899 (Sic)

Jany 5
E. W. Sheldon City Clerk

4201

November 9 1900 23
Plat 72
21

S. R. Kingsley

CENTRAL PLACE SUBDIVISION ON

THE S½ OF SECTION 29 IN THE CITY OF WYANDOTTE IN T. 3, S. R. 11 E. WAYNE COUNTY MICHIGAN

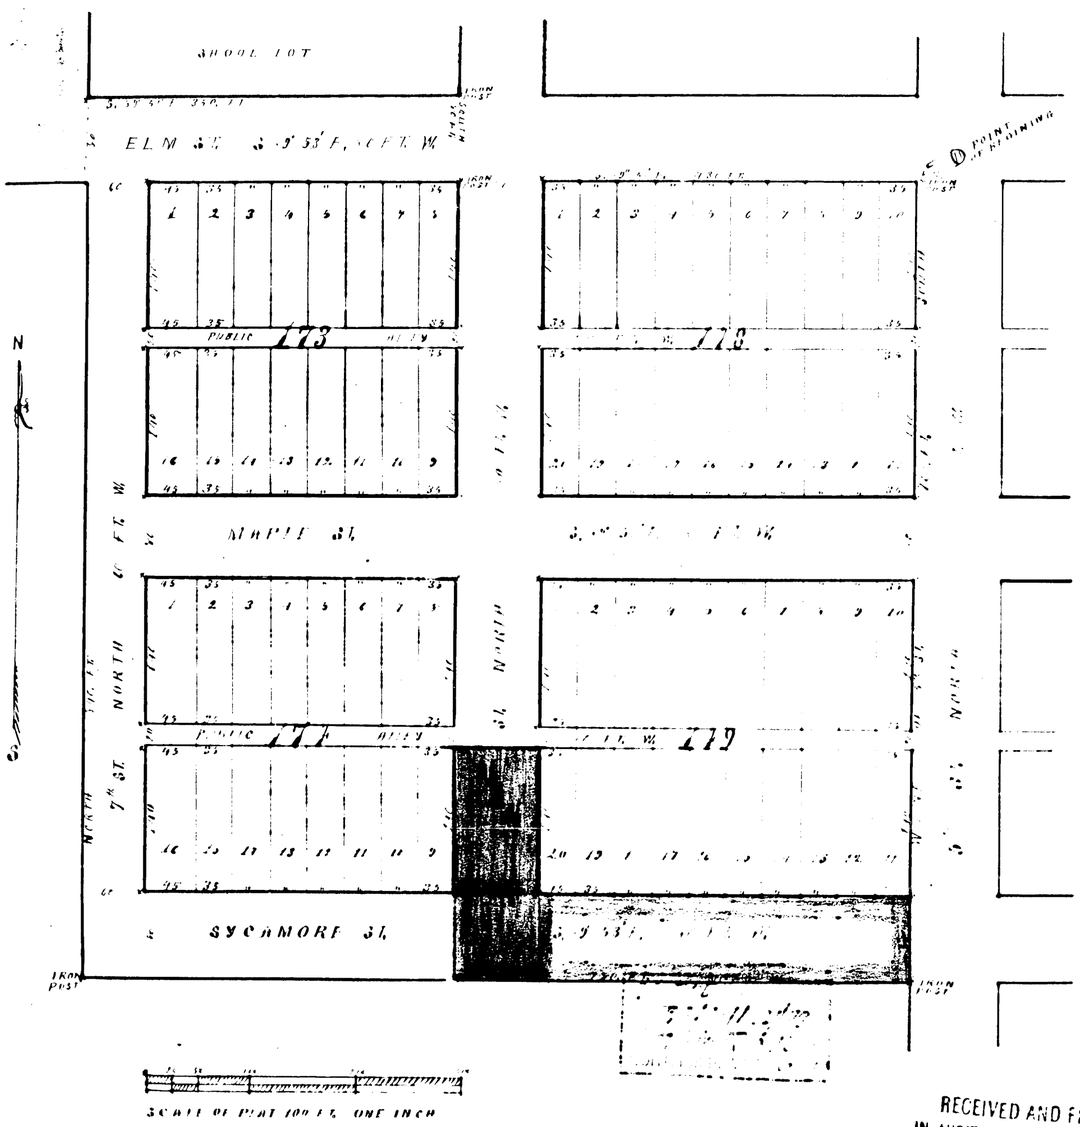

Description of the land platted



Know all men by these Presents that the Wyandotte Land Company by their legal representative, W. Hawes Smith, have caused the land embraced in the annexed plat to be surveyed, laid out and platted, to be known as Central Place Subdivision on S½ of Section 29 in the City of Wyandotte in T. 3. S. R. 11. E. Wayne County Michigan, and that the Streets and alleys as thereon shown are hereby dedicated to the use of the public, witness their corporate Seal

Signed and Sealed in presence of C. G. McKinney, C. C. Parkinson — W. Hawes Smith (Seal)

(Corporate Seal)

State of Michigan } ss
County of Wayne } On this 21st day of September A.D. 1899 before me the Subscriber a Notary Public in and for said County, personally appeared W. Hawes Smith to me known to be the same person who executed the above instrument, who has acknowledged the same, to be the free act and deed of the Wyandotte Land Company, as their Secretary duly authorized.

Carlos C. Parkinson
Notary Public
Wayne County Michigan

My term expires Jan 1st 1901

State of Michigan } ss
County of Wayne } I, C. C. Parkinson, Register of Deeds and ex officio Secretary, hereby certify that we have each carefully compared this copy with the original plat of Central Place Subdivision in the City of Wyandotte and that this is a true copy thereof and of the whole of such original map or plat.

S. R. Kingsley Register of Deeds
ex officio Secretary

RECEIVED AND FILED.
IN AUDITOR GENERAL'S OFFICE,
Jany 5 1900
Deputy Auditor General.

I hereby certify that the plat hereon delineated is a correct one and that permanent monuments consisting of oak Stakes (except where iron is marked) have been planted at all the angles in the boundaries of the Land platted, and at all other points of Blocks and Streets and angles, at points marked thus x as shown thereon.

Dtd. Sept 26th 1899 — A. H. McDermuth, Surveyor

State of Michigan } ss
County of Wayne } State of Michigan } ss
County of Wayne } I hereby Certify that the foregoing plat was approved by the Common Council of the City of Wyandotte this 6th of November A.D. 1899 (Seal) Geo. W. Sheeler City Clerk

Examined and approved
Sept 25th 1899
John H. Wilkinson
County Cor Wayne