
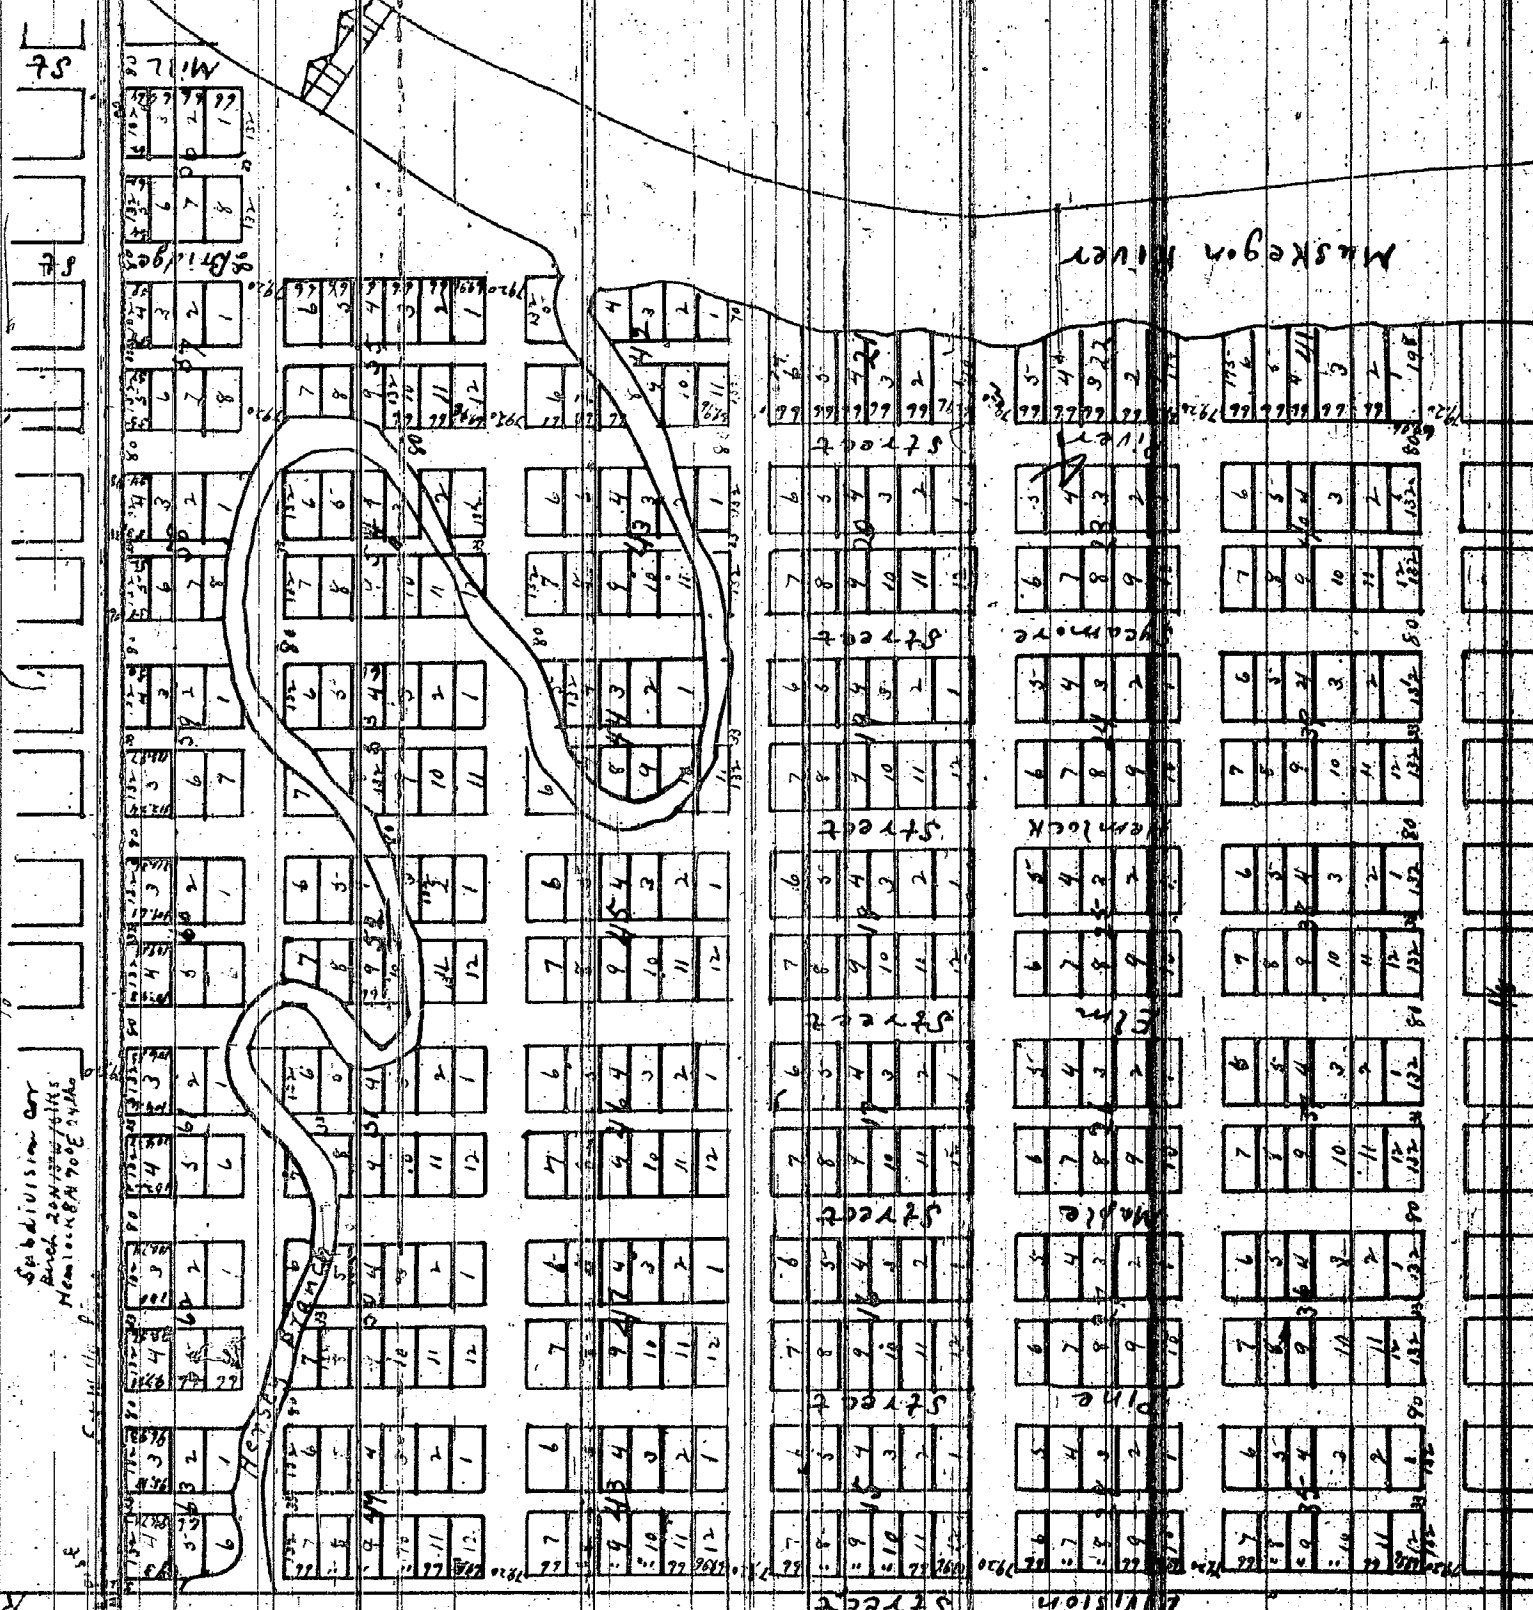


VILLAGE OF HERSEY.

VILLAGE OF HERSEY.

Scale one inch to 396 feet

 

Recorded for record February 8th 1911 at 12 o'clock pm

John A. Kange Register

Thereby certify that this plat is a correct copy of the plat now on record in the Register of Deeds of this county under the supervision of the Auditor General by tracing the plat and comparing it with the original copy of the certificate.

Dated this 23rd day of July 1911
Solon Robinson
Clerk and Gen. Opt.

PLAT ---- HAMMILL & McALLISTER'S ADDITION TO VILLAGE OF EVART.

C O January 8, 1907.
Misc. Liber 3. Page 486.

Plat Vacated.

Vol. 146. Page 12037.

Curts & Taylor
Plat Examiners

PLAT ---- VILLAGE OF HERSEY.

C O January 2, 1888.
Misc. Liber 1. Page 472.

South
Streets and alleys vacated. Gooch Street from First Street to Seventh Street and that portion of Fifth and Sixth Street lying west of Wood Street and the alley running north and south through the center of Blocks No. 12 and 31, according to the recorded plat to Delos A. Blodgett.

Vol. 146. Page 12030.

Curts & Taylor
Plat Examiners


PLAT ---- RUPERTS ADDITION TO VILLAGE OF REED CITY.

C O June 25, 1890.
Misc. Liber 1. Page 596.

Streets vacated. The whole of Frederick Street. The whole of Rupert Street and the whole of Williams Street.

Vol. 78. Page 5368.

Curts & Taylor
Plat Examiners

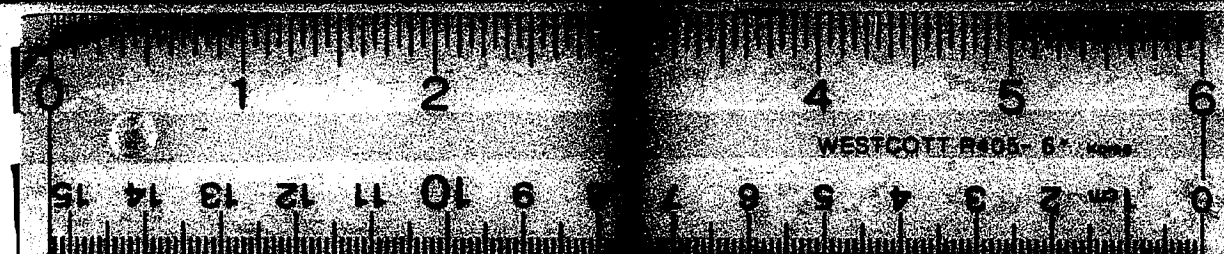

16 X