

Map of Thatchers Addition

16



Salina

comprising the East 1/2 of the North West 1/4 of Sec 36 and that part of the North East 1/4 of the South West 1/4 of Sec 36 lying north of Saginaw and Bad River Plank Road all in Township 12 N R 4 E in the County of Saginaw & State of Michigan
Excerpt from the map of H. B. Seavey
by Fred W. Thacker

City of East Saginaw.

Ernest Thacker

Plat map of Block
vacated Jan 19 1932
Voucher 2132-1932

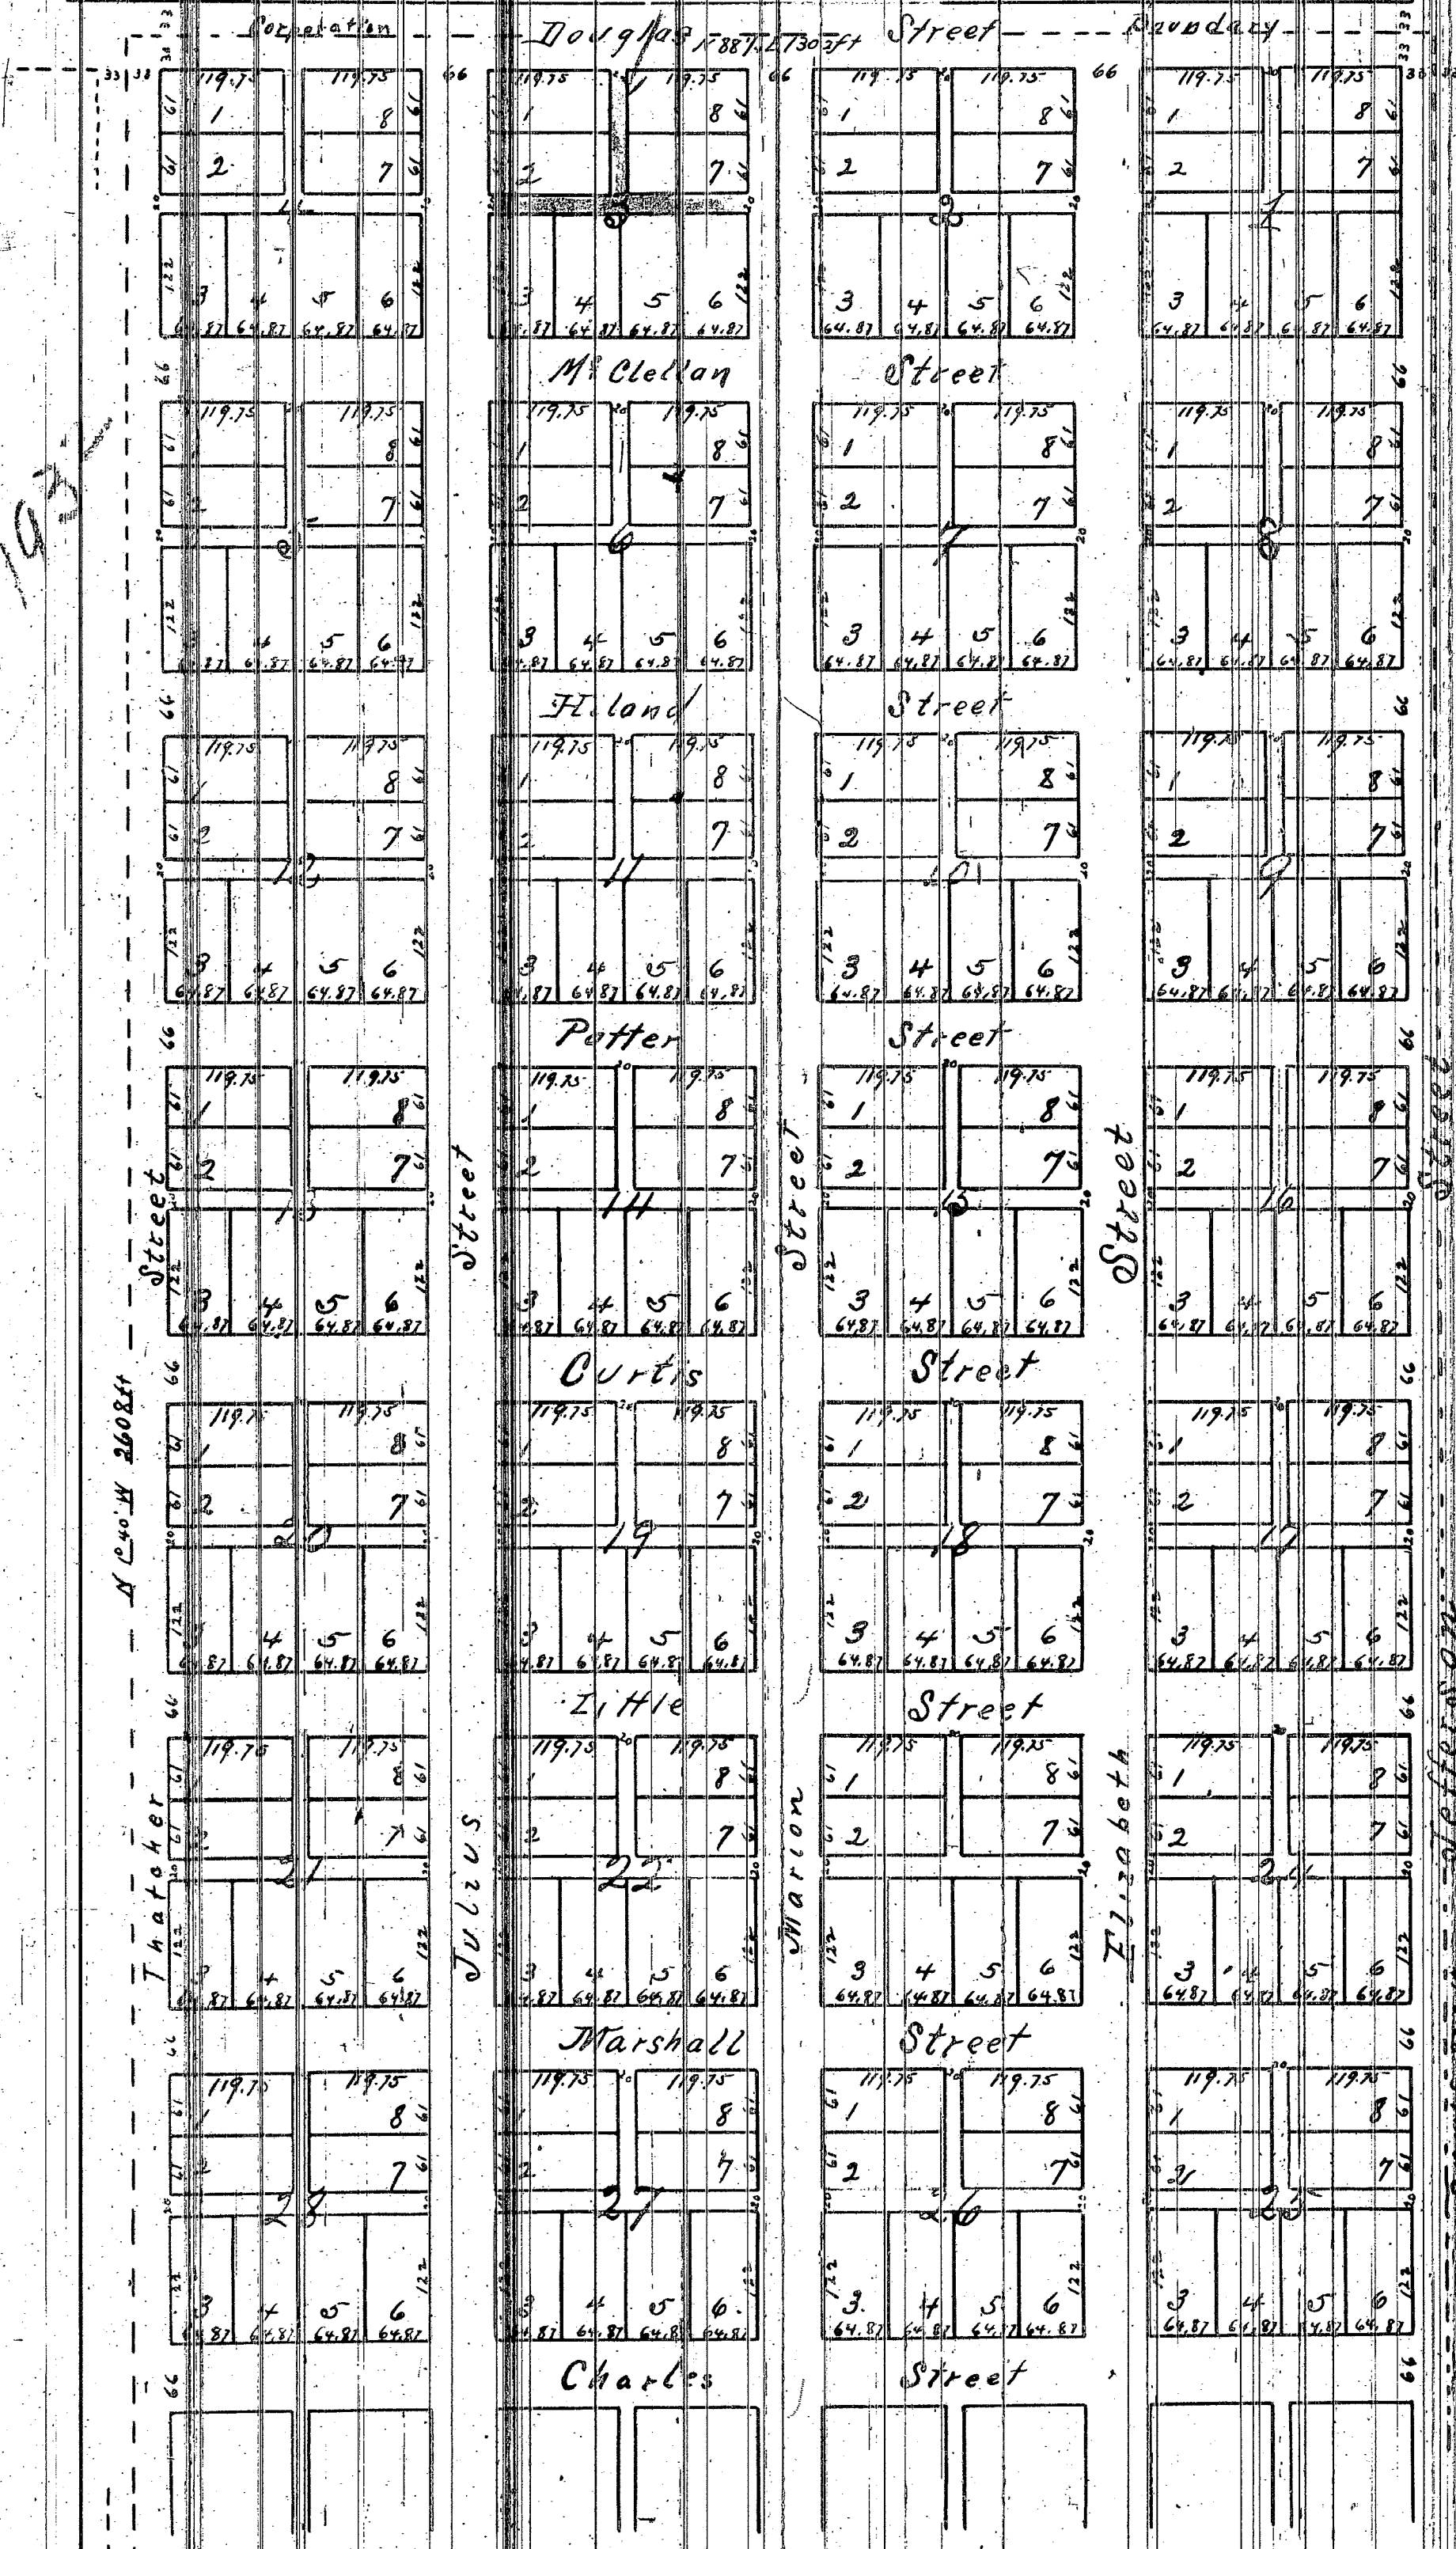 


ALLEY VACATED
CITY ORDINANCE
NO. 158-8-19-40
VOUCHER 226-49

Set 1932
2132-1932

12058

VACATED BY CITY
ORDINANCE NO. D-162
OCT. 7, 1942
VOUCHER 243-49

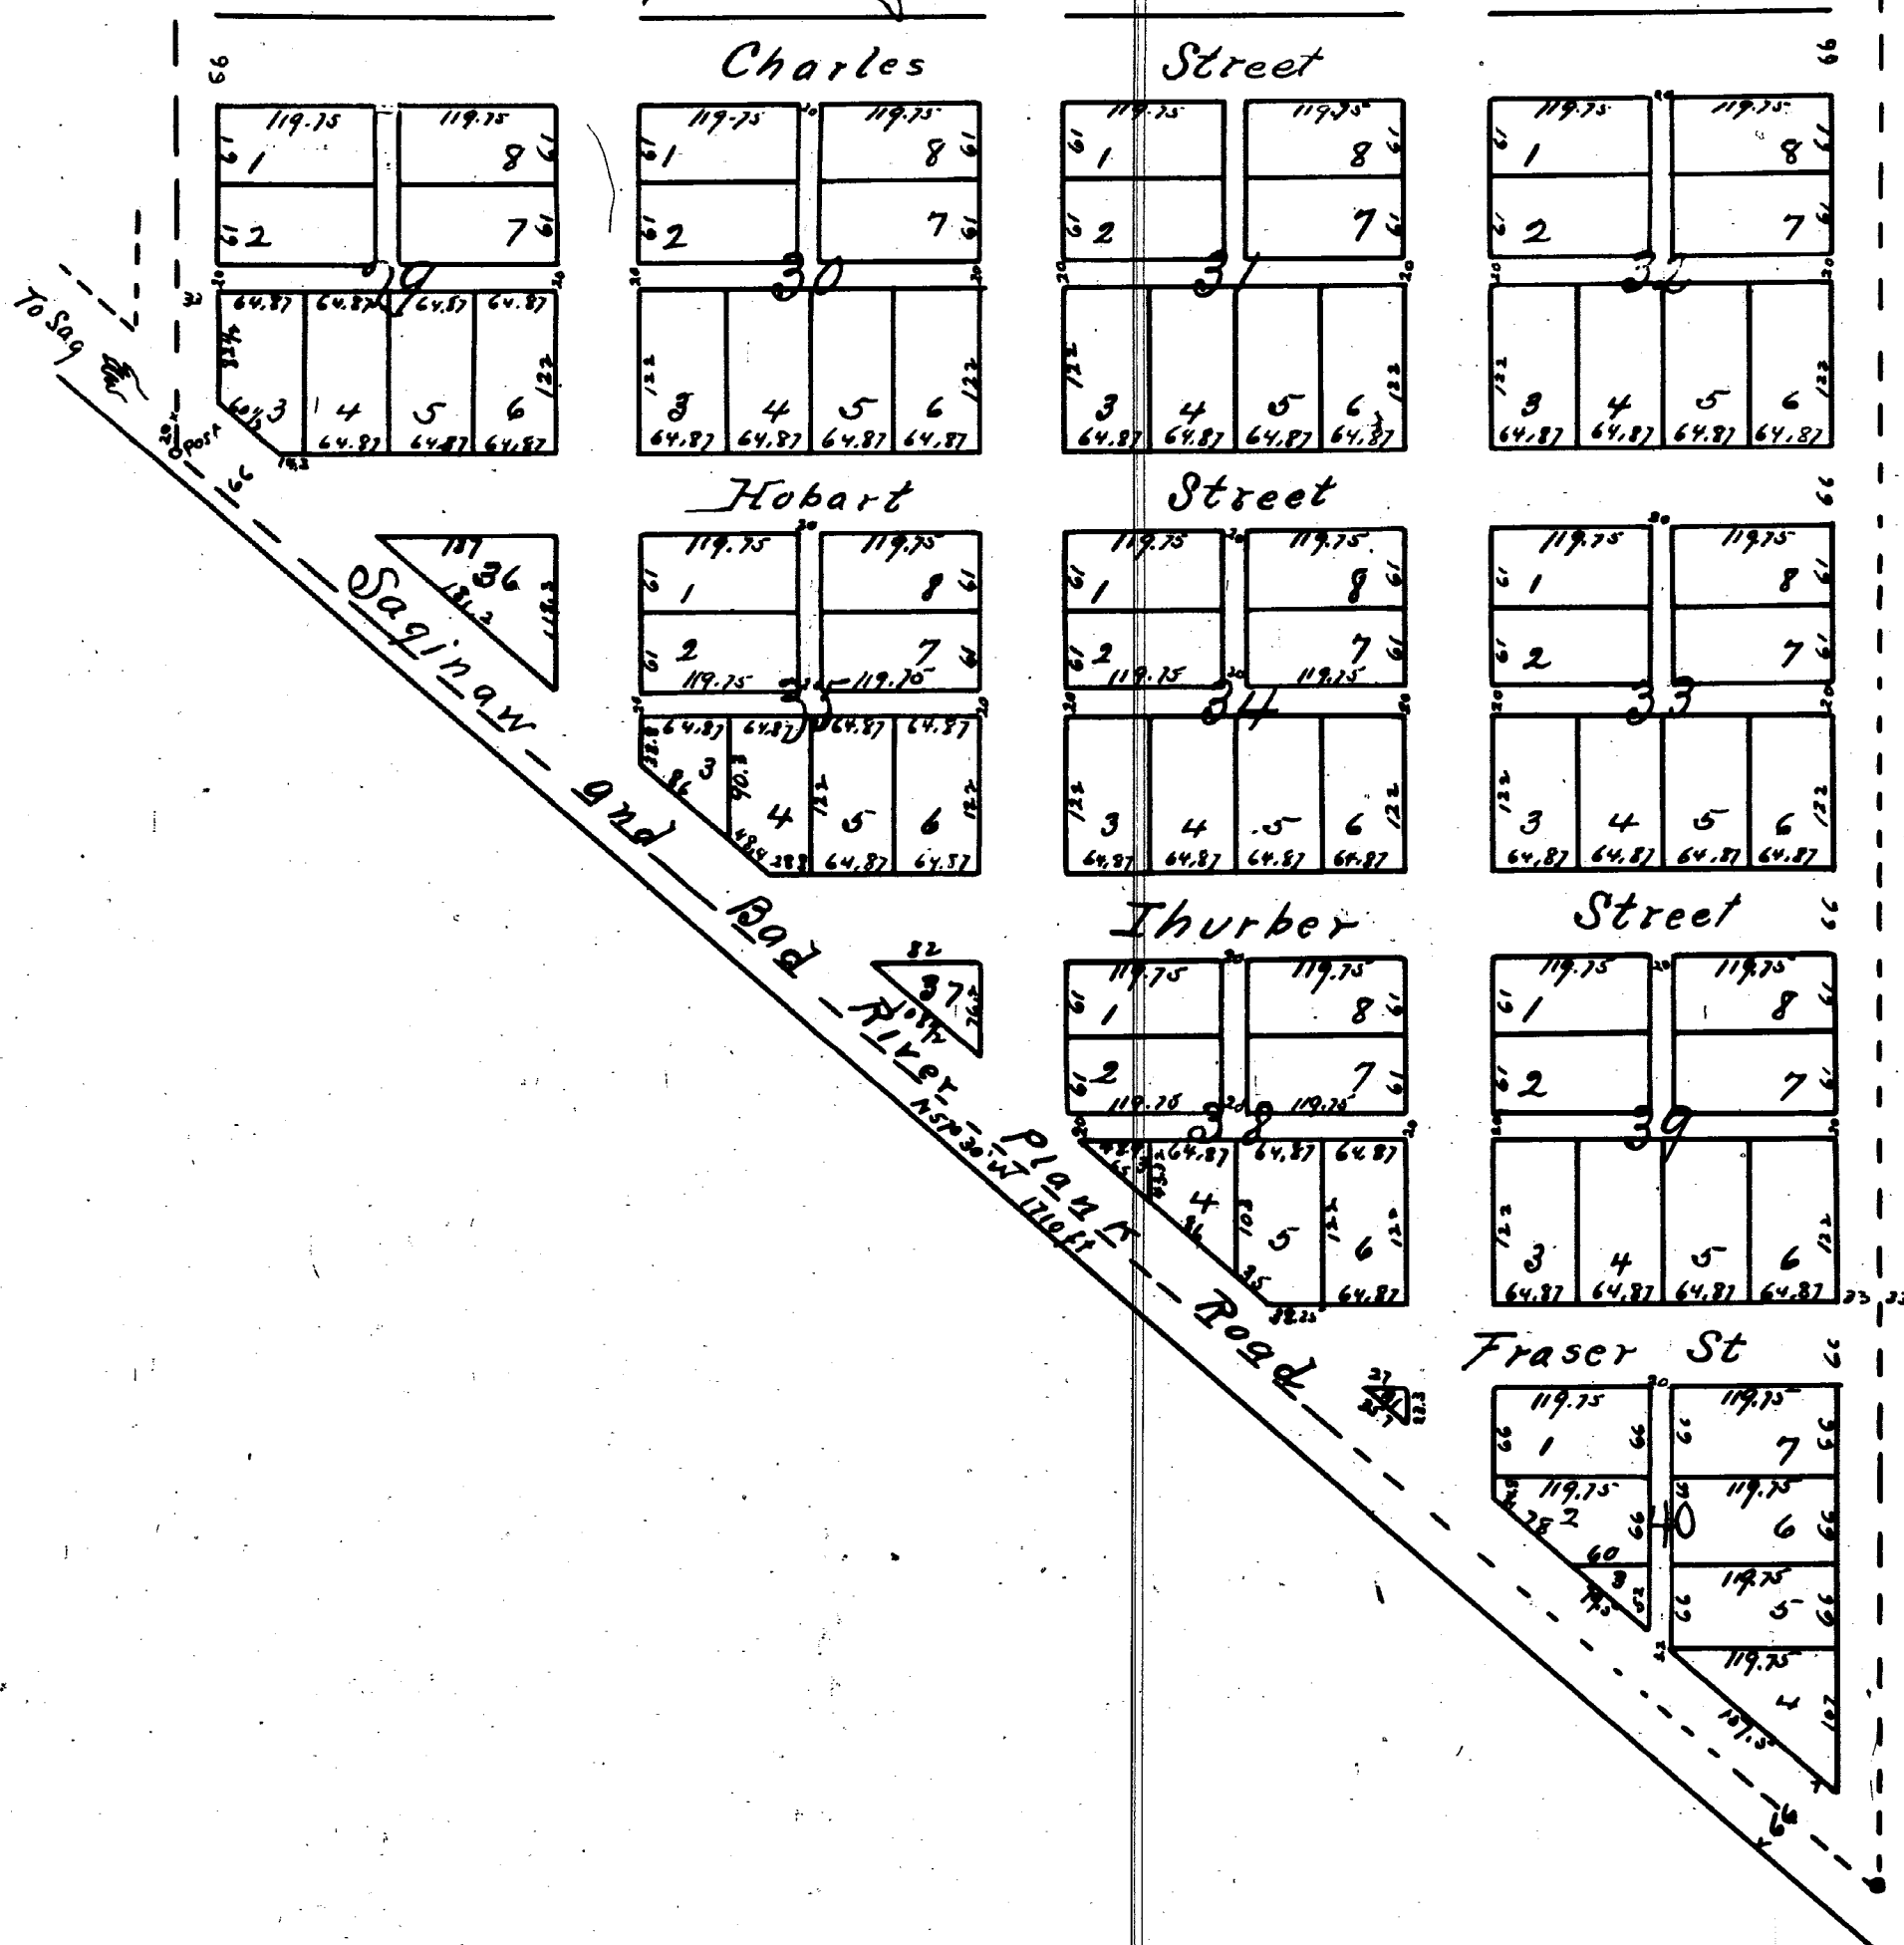

Know all men by these presents that the land laid out or plotted on the within Map is owned by Erastus Thatcher of Spaulding Saginaw County and State of Michigan
That the said Map or plot is now executed by the said Erastus Thatcher as proprietor in accordance with the provisions of an act to provide for recording Town Plats and for vacating the same in certain cases and the acts amendatory thereto and for the purpose of being recorded as Thatcher's Addition to the Village of Batavia Saginaw County & State of Michigan
The size of the lots and width of the Streets as given on said Map in feet and hundredths of a foot
In Witness whereof we have hereunto set our hands and Seals this ninth day of November A.D. One Thousand eight hundred and Sixty Six


In presence of } Erastus Thatcher [S]
Wm L. Webber }
Erving M. Smith } Fred W. Herbert Sumner [S]

Registers Office } ss.
Saginaw County }
Received for Record November
9 A.D. 1866 at 5 O'Clock P.M.
and recorded in Liber No 38 of
Deeds & Plats Page 125
Jas. M. Gater
Register

I hereby certify that this Plat is a correct copy of the Plat now on Record in the Register of Deeds Office, being made under the supervision of the Auditor General by tracing the Plat on Record and affixing thereto a carefully compared copy of the Certificate
Dated the 28th day of July 1911

Alton B. Hard.
Clerk, Aud Gen Dept.

State of Michigan } ss.
Saginaw County }
On this ninth day of November
A.D. 1866 Before me a Notary Public person-
ally appeared Erastus Thatcher proprietor
and Frederick W. Herbert Sumner who sev-
erally acknowledged the execution of the above
Plat to be their free act and deed pursuant
to the Statute for the recording of Town Plats &c
Witness my hand and Seal at East
Saginaw the day & year aforesaid
[SEAL] Wm L. Webber
Notary Public
for Sag. Co., Mich.

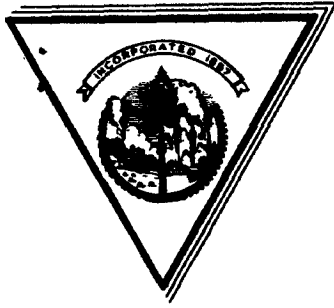

CITY OF SAGINAW

MICHIGAN

October 21, 1969

Office of the State Treasurer
Lansing, Michigan 48902

Gentlemen:

Enclosed are certified copies of ordinances No. D-895,
D-896, and D-897.

Yours very truly,

F. B. Niederstadt
egd

F. B. NIEDERSTADT
City Clerk

egd

Enc.

Saginaw
12058



12058

STATE OF MICHIGAN
COUNTY OF SAGINAW
CITY OF SAGINAW

OFFICE OF THE CITY CLERK
CITY OF SAGINAW

I, F. B. NIEDERSTADT, Clerk of the City of Saginaw, County and State aforesaid, Do
Hereby Certify, that I have compared the annexed copy of Ordinance No. D-895

with the original on file in the office of the City Clerk
and that it is a true and correct transcript therefrom and of the whole of such original.

In Witness Whereof, I have hereunto set my hand affixed
the Corporate Seal of the City at Saginaw, Michigan, this

Twenty-first day of October 1969

F. B. Niederstadt

CITY CLERK.

Certificate No. 2851

AN ORDINANCE TO VACATE THE EAST-WEST ALLEY IN THE BLOCK
BOUNDED BY THATCHER, MORRIS, JULIUS AND RANDOLPH STREETS
AND TO RESERVE AN EASEMENT THEREIN FOR PUBLIC UTILITIES

THE CITY OF SAGINAW ORDAINS:

Section 1. That the east-west alley in the block bounded by
Thatcher, Morris, Julius and Randolph streets (Block 20, Thatcher's
Addition) be, and the same is hereby vacated, subject to the easement
hereinafter reserved.

Section 2. That there is hereby reserved in said alley an ease-
ment for public utilities to the same extent as though said alley had not
been vacated.

Section 3. That the Map of the City of Saginaw is hereby amended
accordingly.

Section 4. That this ordinance shall take effect October 30, 1969.

~~Adopted unanimously.~~


Enacted: October 20, 1969.

F. B. NIEDERSTADT
CITY CLERK

WARREN C. LIGHT
MAYOR

12058

12058

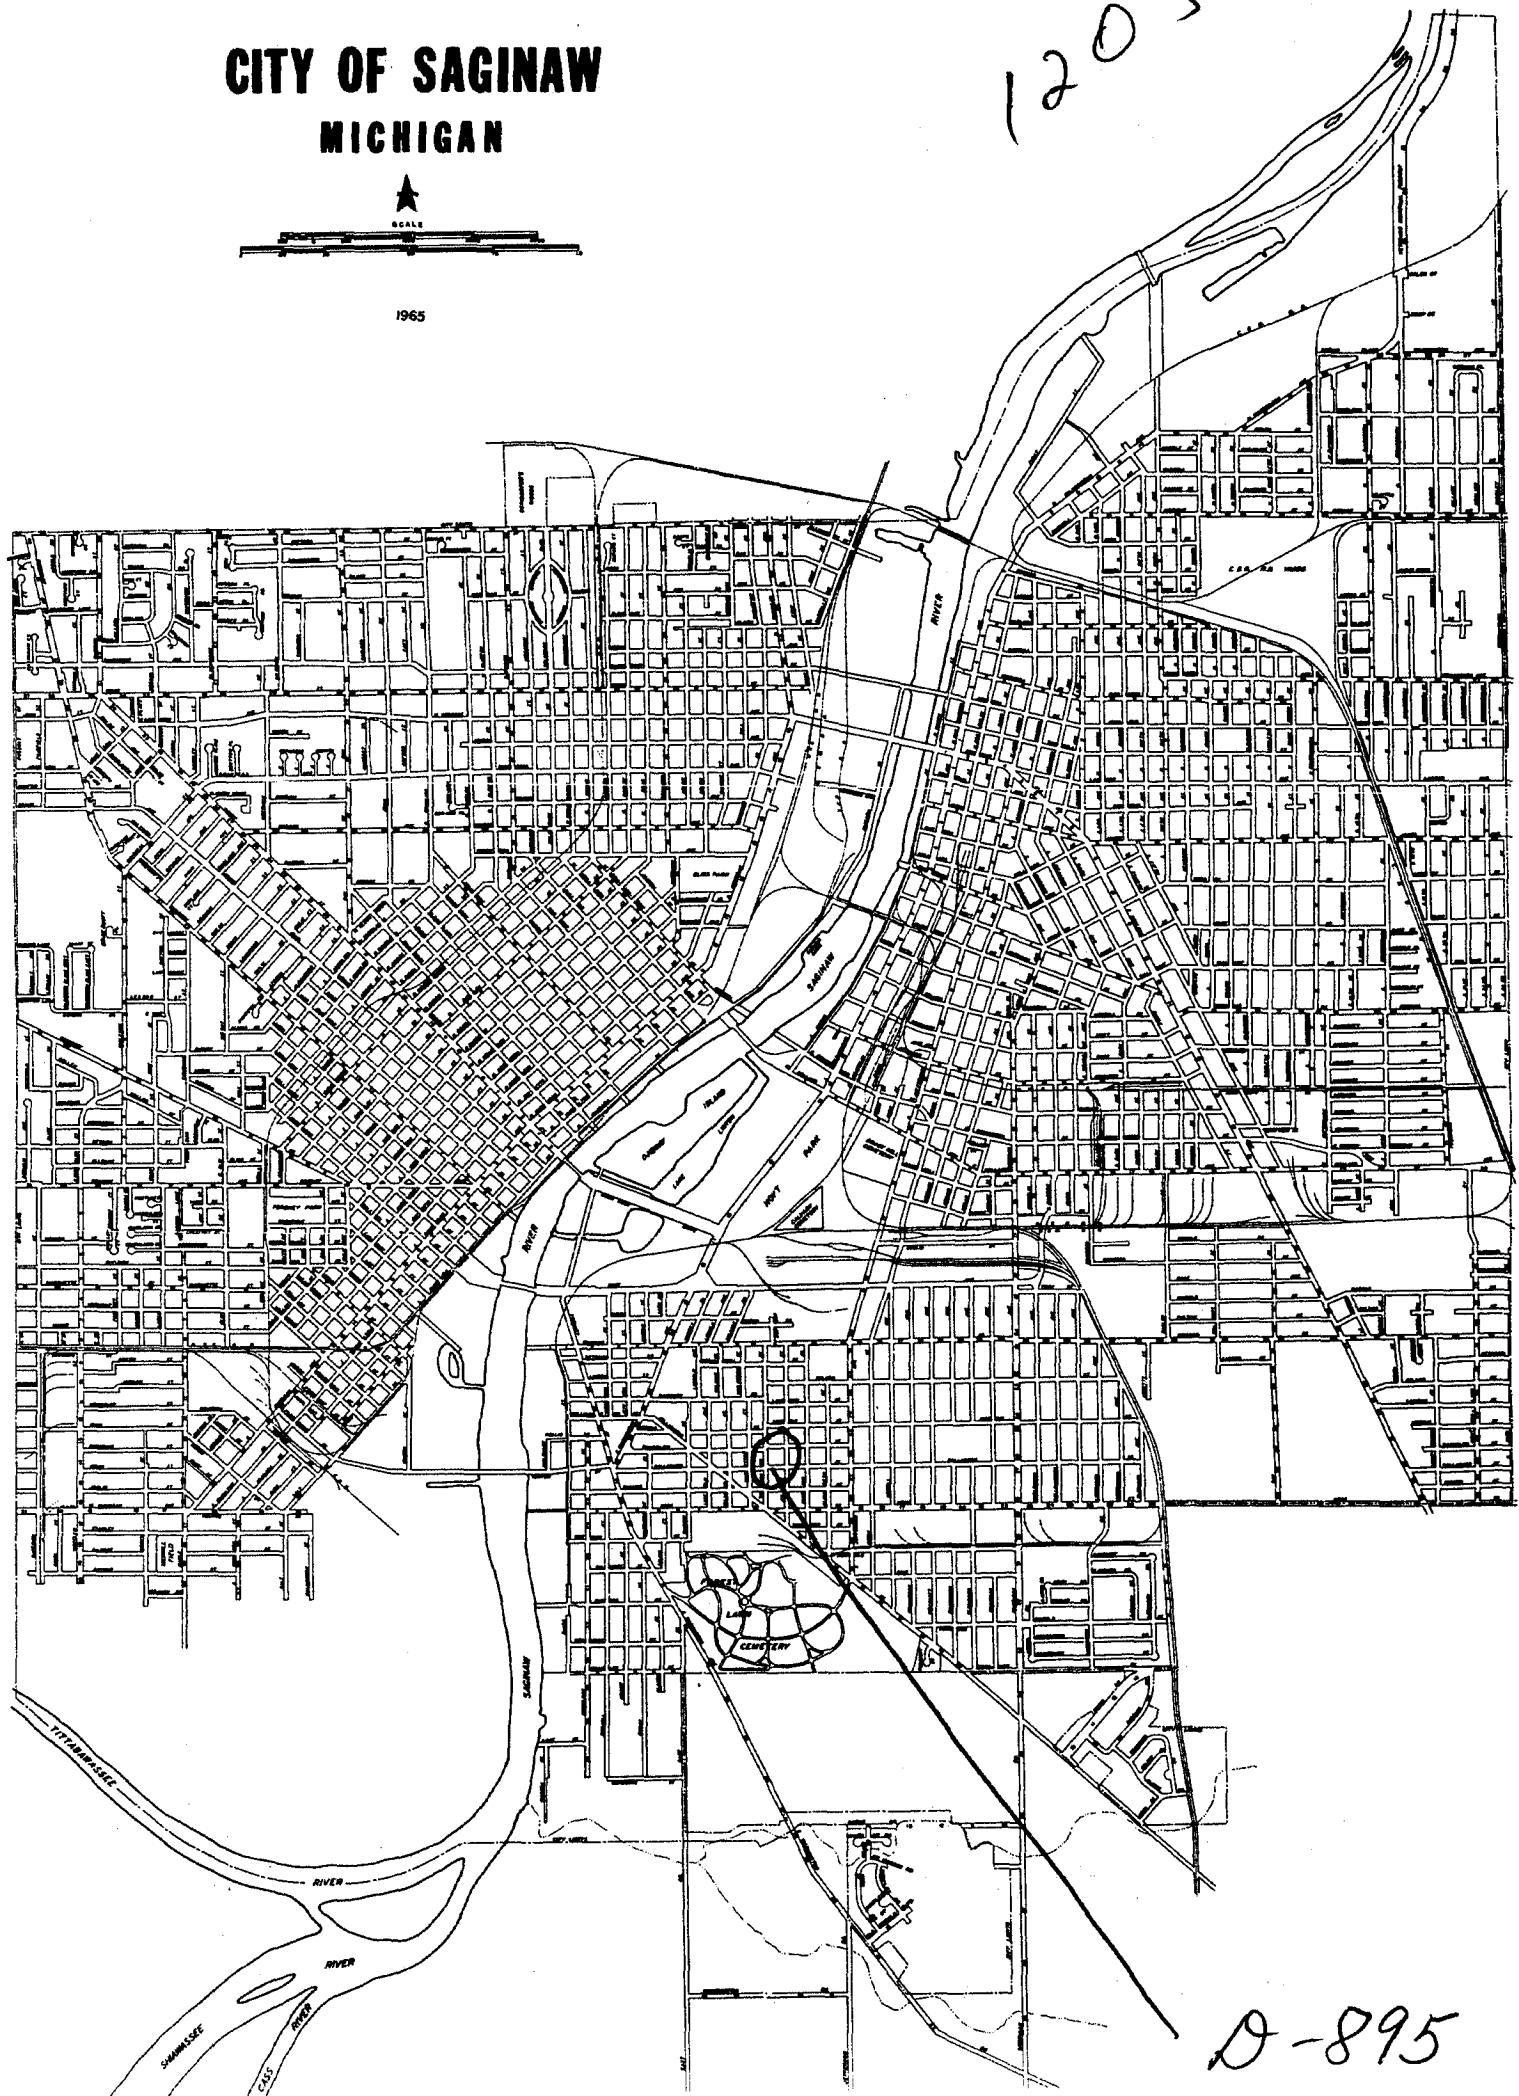


D-895

MORRIS

THATCHER

JULIUS

RANDOLPH

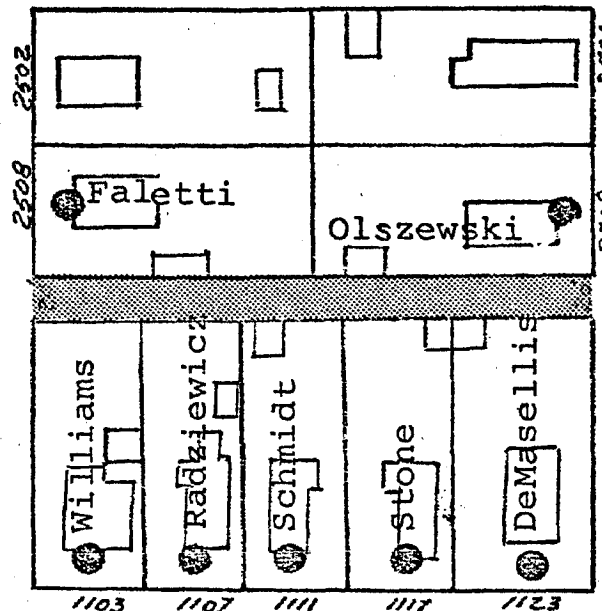

N

Scale 1" = 100'

LEGEND

Alley proposed to
be vacated

Petitioners who signed.

Petition A-12164
of
William Stone et al.
requesting vacation of the
alley in the block bounded
by Thatcher, Morris, Julius,
and Randolph Streets.

Dept. of Community Development
9-11-69

683-9-3
9-26-69
205

Barbara L.

WHEREAS, the interests of the City of Reed City require the vacation of said portion of Franklin Street for municipal parking lot purposes.

and Hatch
Page 12028



















Jan 24, 1967

SEAL

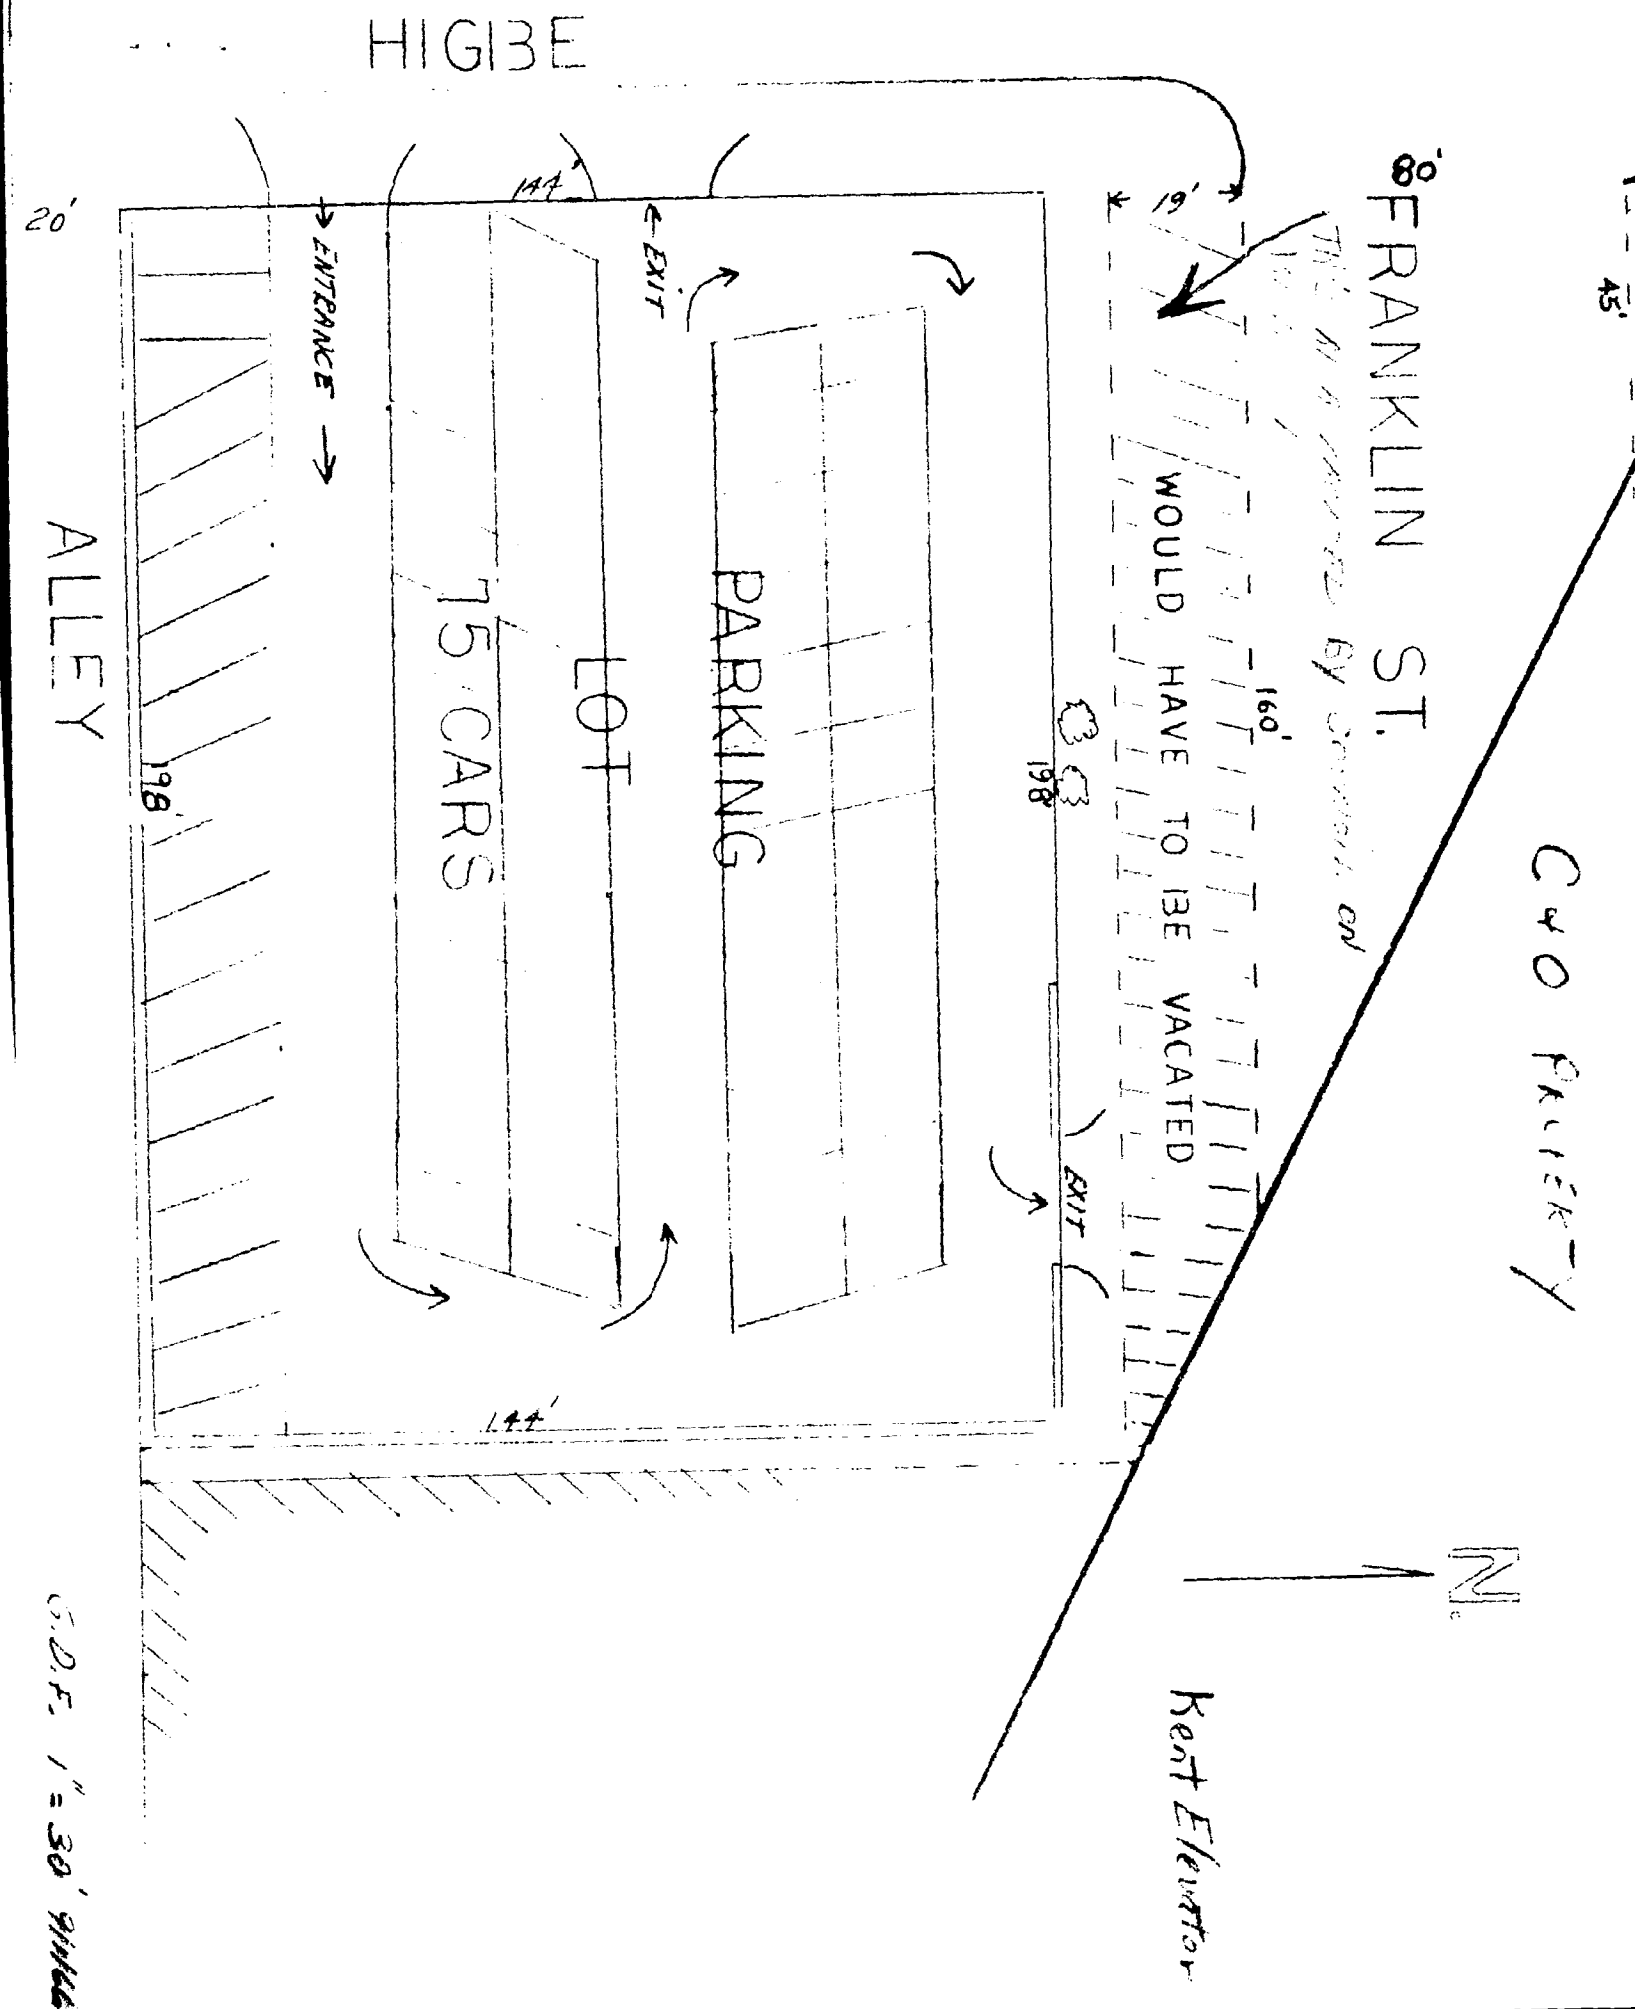

Streets vacated-cont-

Niagara Street from Sylvan to Sherman vacated by common council April 22-1901

Curts & Taylor
Flat Examiners

PLAT ----- PORTION OF THATCHER'S ADDITION TO EAST SAGINAW.

Re application to
discontinue certain
streets in said
Addition.

Apr. 10, 1879.

Voucher 341 --- 1916.

Vol. 146 page 12058 ✓

RESOLVED by the common council of the City of
East Saginaw that the vacating and discontinuing of said
streets, viz.: Sherman St. from the east side of Marion
St. to the west side of Jefferson St. and Elizabeth St.
from the south side of Webber St. to the north side of
Hiland St.; and also the alleys in Blocks 1-2-7-8
of Thatcher's Addition to Salina, is necessary
and the same are hereby declared vacated.

PLAT ----- J. BLACKMORE'S ADDITION TO EAST SAGINAW.

In the matter of the
petition of the Con-
solidated Coal Company
to vacate part of said
plat.

Dated Aug. 25, 1916.

W. G. Gage,
Circuit Judge.

ORDERED that Lots 22 to 32 incl. and that
Lot 33 except the south 33 ft. of said Addition be
vacated.

Voucher 1048 --- 1916.

Vol. 148 page 12153 ✓

PLATS ----- GRAHAM'S ADDITION TO SAGINAW.
PARSON'S ADDITION TO SAGINAW.
ANDRE'S ADDITION TO SAGINAW.

In the matter of the
petition of William J.
Passolt, et al. to
vacate part of said
plats.

Aug. 16, 1915.

William G. Gage,
Circuit Judge.


Voucher 1053 -- 1916.

Vol. 73 page 4994

Reason add " 148 " 12186 ✓
note add " 148 " 12248 ✓

line of Section Twenty-two, Town Twelve north, Four east, including Graham St. and
Adams St., where the same passes along, thru, or between any of the lots of said
Andre's Addition within the boundaries designated, the same being all those lots
and parts of lots of said Addition southeasterly of the northwesterly boundary line
of Graham St. and includes Lots or parts of Lots of said Andre's Addition numbered
One to Nine, Eighteen, Nineteen, Twenty, and Thirty-six to Forty, incl.
Be vacated.

26

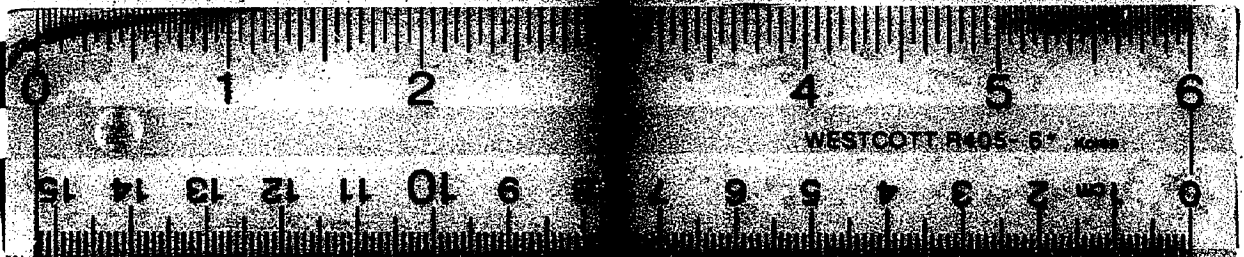

16 X

✓ PLAT - SAGINAW

Resolution of City Council
passed February 15th, 1859

⁷
Liber 291 of Deeds page 605


By Alderman Melchers

Wherefore application has heretofore been made to this council to vacate and discontinue Sherman Street from the East side of Marion Street to the west side of Jefferson Street and Elizabeth Street from the south side of Wabber Street to the north side of Hiland Street and also the alleys in Block one, two, seven, and eight of Thatchers Addition to Salina-and now a part of East Saginaw, be it resolved by the common council of the city of East Saginaw that the vacating and discontinuing of said streets and alleys within the descriptions above set forth is deemed and hereby declared necessary and that the same is a necessary public improvement and the same are hereby declared vacated and discontinued for the uses and purposes of streets and alleys-

Adopted.

Curts & Taylor Plat Examiners

Val-146-Page-12058✓

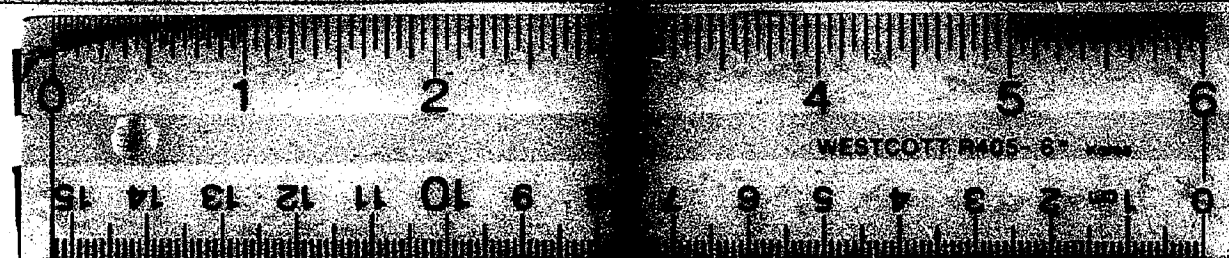

16 X