


12147

BLAKELEY'S ADDITION TO THE CITY OF GRAND RAPIDS.

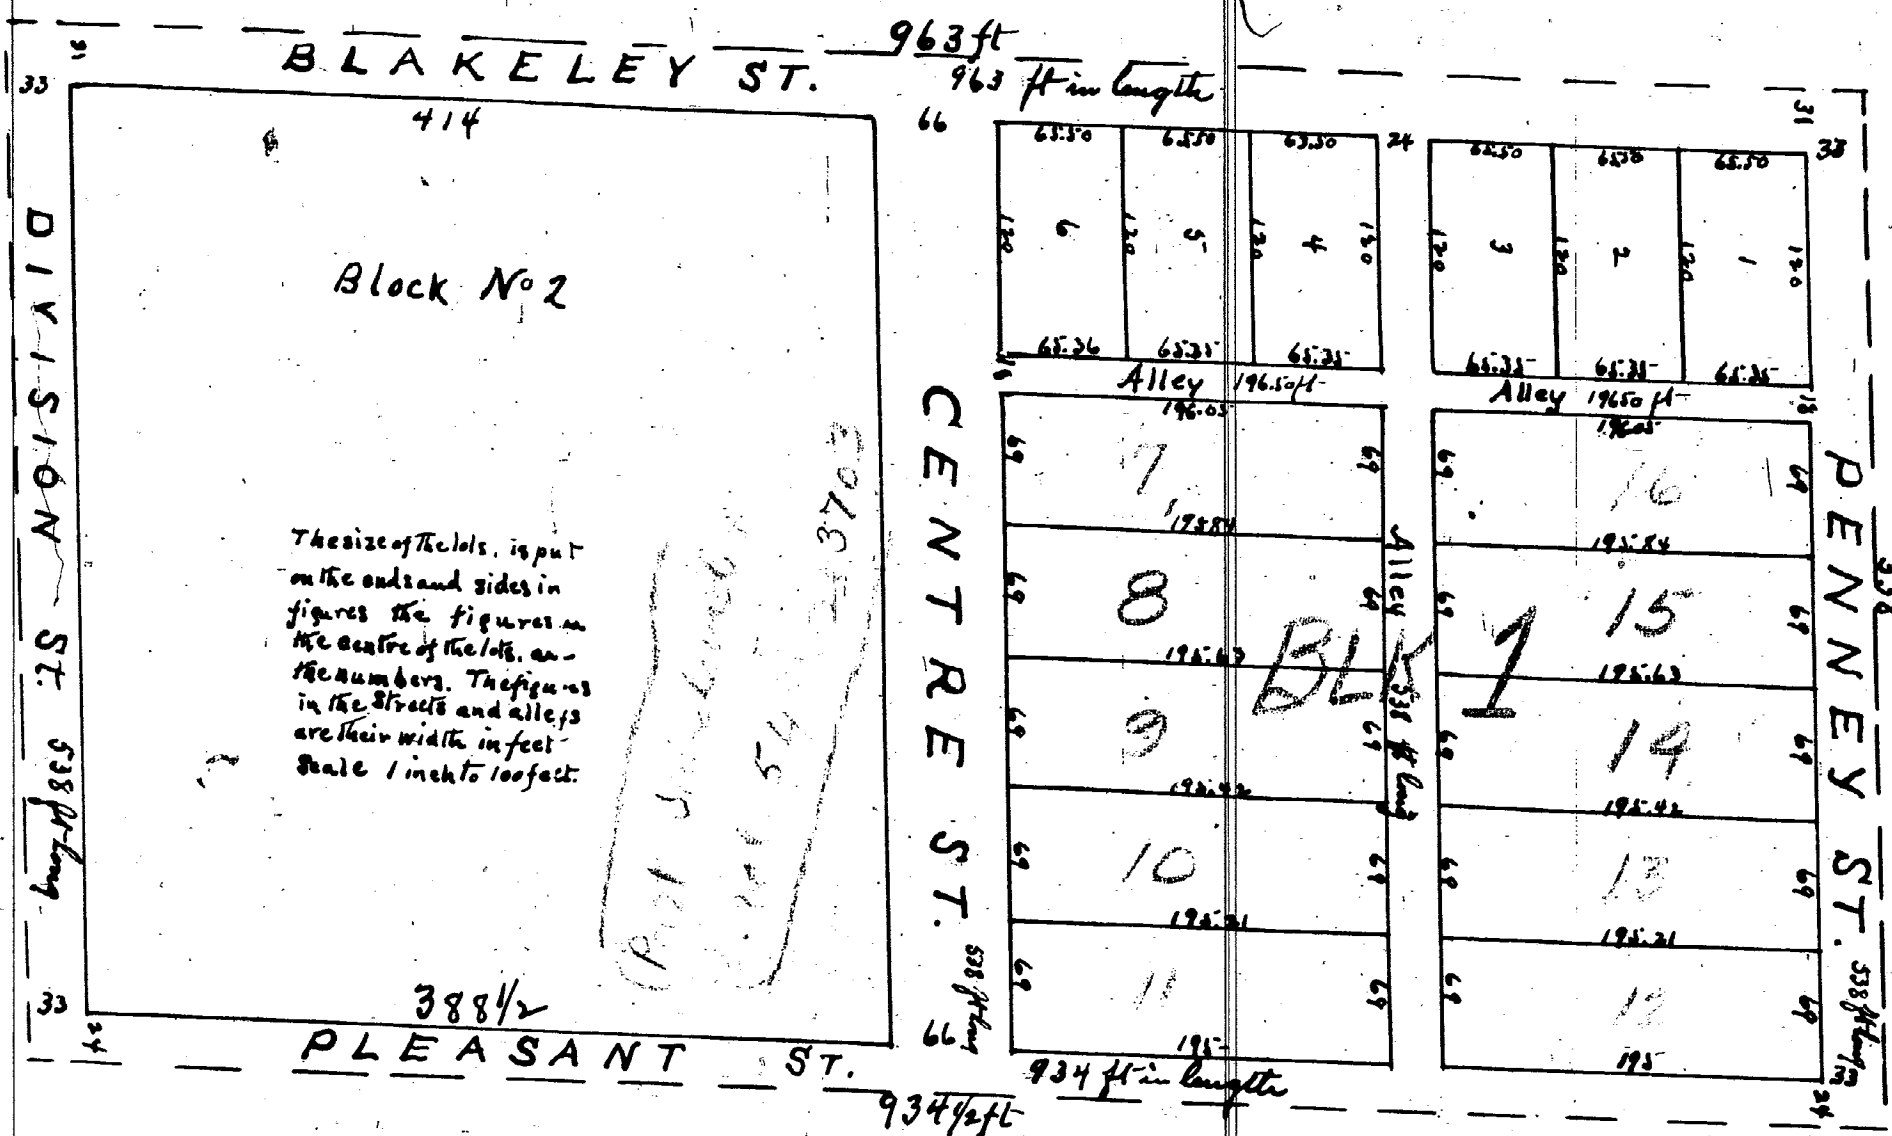

Block 1 lot numbers
added in Bl. #1 (1861)
per letter to town of
Reg. of Deeds
Voucher # 1117-6

State of Michigan }
Kent County Register's office }
This Plat was received for record June 3d A.D. 1861. at
10 o'clock A.M. John R. Stewart Register
By B. A. Harlan Secy.

A description of the within plat of Blakeley's addition to the City of Grand Rapids, Kent County and State of Michigan is as follows. Beginning on the West boundary line of Section number thirty one (31), of Township number Seven (7) North, of Range number eleven (11) West, one thousand and thirty two (1032) feet South of the North West Corner of said Section. Thence Eastward parallel with the North line of said Section nine hundred and sixty three (963) feet, to the East line of the fractional Eighty (80) acre lot in the North West quarter of said Section thirty one (31). Thence Southward along the East line of said fractional lot five hundred and thirty eight (538) feet. Thence Westward parallel with the North line of said Section nine hundred and thirty four and one half (934 1/2) feet, to the West boundary line of said Section. Thence North along said West boundary line five hundred and thirty eight (538) feet to the place of beginning all of which is laid out and platted as follows, viz. laying out a strip of thirty one (31) feet wide on the North line called Blakeley Street a strip of thirty three feet (33) wide on the East line called Penny Street a strip of twenty four (24) feet wide on the South line called Pleasant Street and a strip of thirty three feet wide on the West line called Division Street. and the balance of said Ground is laid out into two blocks as platted within. Block No. 1. is divided into lots, alleys, and streets as shown in the plat with all the sizes, widths of alleys, streets &c. marked upon them in figures. Block Number 2 is not laid out into lots but is reserved as the residence of the Proprietor Wm. D. Blakeley.

Witness our hands and seals at Grand Rapids this 3d day of June in the year of our Lord one thousand eight hundred and sixty one.

Signed and Sealed in Presence of
B. A. Harlan, John R. Stewart.

Surveyed and platted By W. L. Coffinberry.

William D. Blakeley (Seal)
Proprietor
W. L. Coffinberry (Seal)
Surveyor

State of Michigan }
Kent County } Before me a Notary Public in and for said County personally came William D. Blakeley the proprietor and Wright L. Coffinberry the Surveyor and Draughtsman of the annexed and foregoing Plat of "Blakeley's Addition to the City of Grand Rapids Michigan" Known to me to be the individual persons who executed the same and severally acknowledged the said plat to be their free act and deed for the uses and purposes therein set forth. In Witness Whereof I have hereunto set my hand and Official Seal at the City of Grand Rapids this third day of June A.D. 1861.

I hereby certify that this plat is a correct copy of the plat now on record in the Register of Deeds office being made under the supervision of the Auditor General by tracing the plat on record and affixing thereto a carefully compared copy of the dedication and certificate.

Dated this 11th day of Jan 1910


Geo W Bennett

Clerk And. Civil's Dept.

(Seal)

B. A. Harlan
Notary Public

BLAKELEY'S ADDITION TO THE CITY OF GRAND RAPIDS.

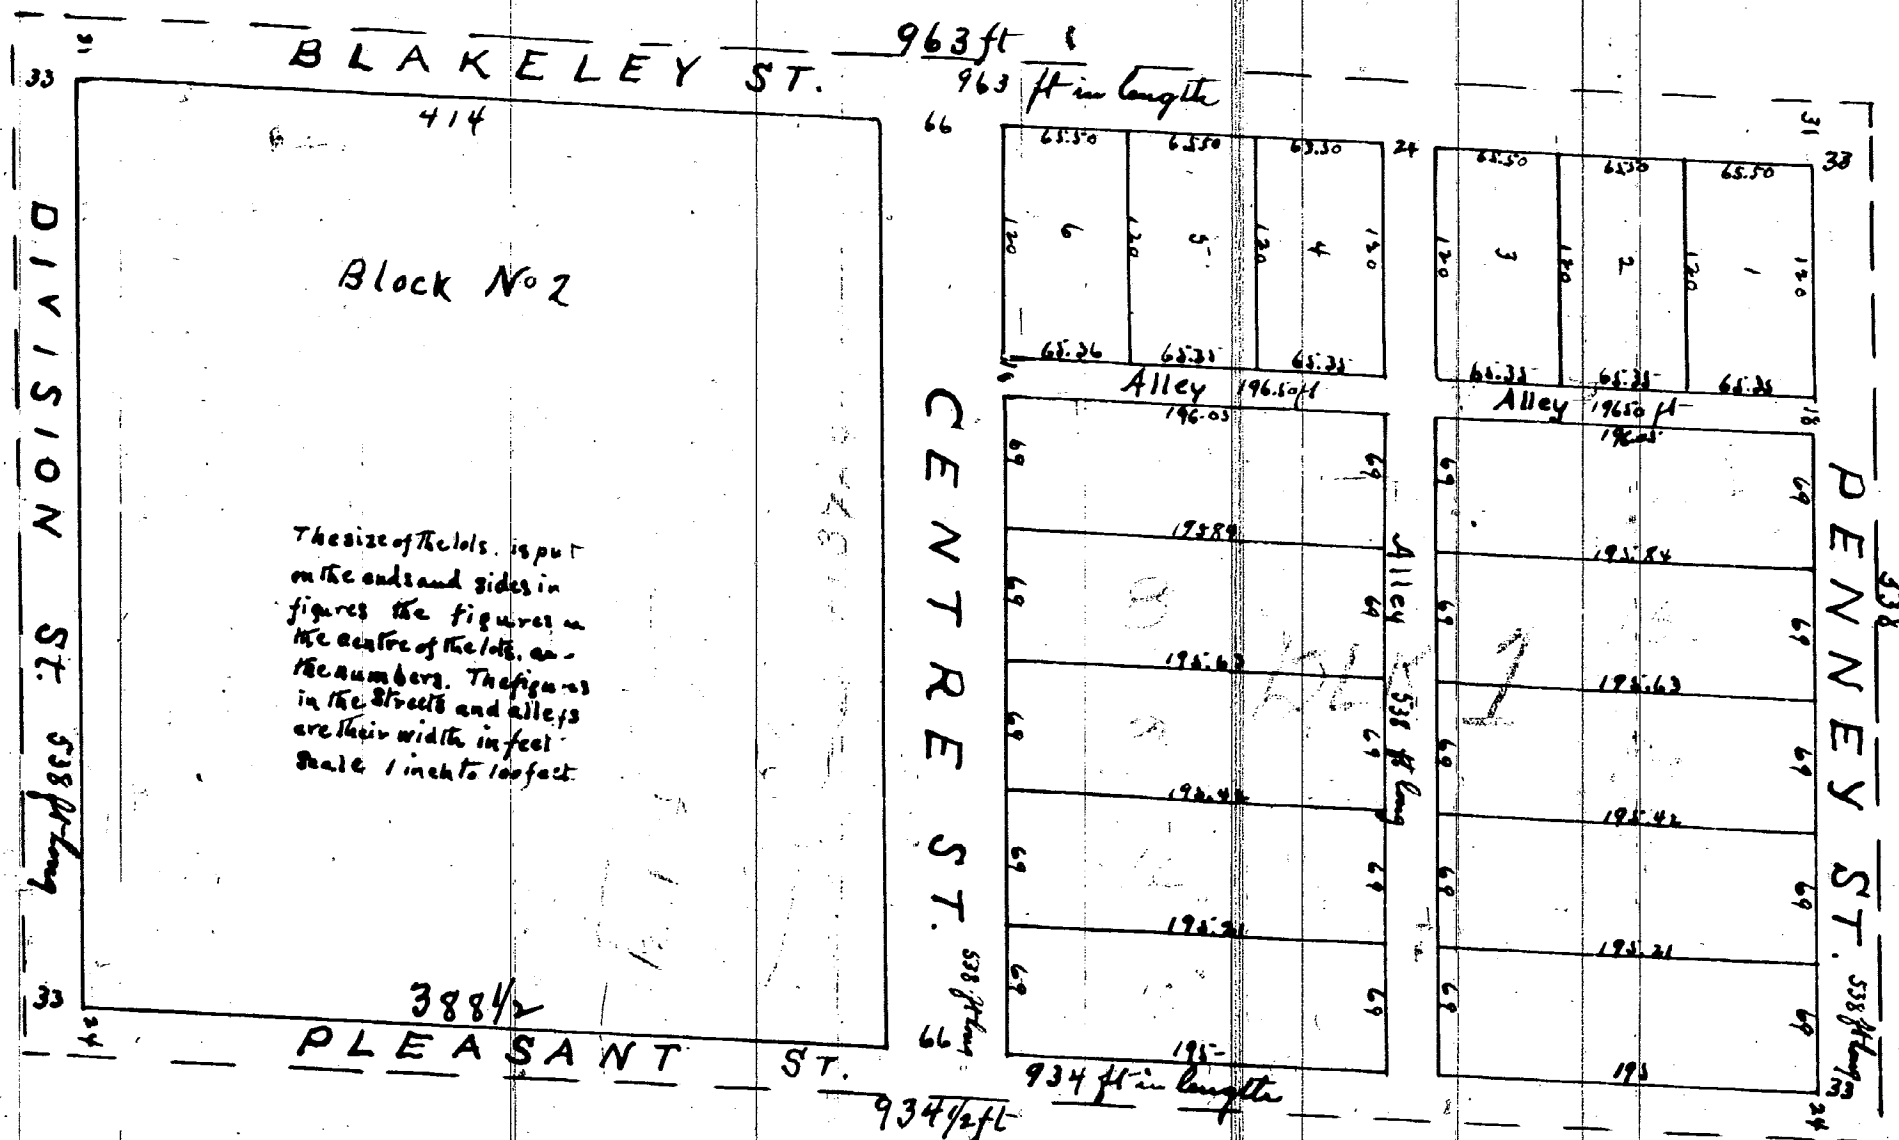

State of Michigan }
 Kent County Register's Office }
 This Plat was received for record June 3^d A.D. 1861. at
 10 o'clock A.M. John R. Stewart, Register
 By B. A. Harlan, Notary Public

A description of the within plat of Blakeley's addition to the City of Grand Rapids Kent County and State of Michigan is as follows. Beginning on the West boundary line of Section number thirty one (31) of Township number Seven (7) North. of Range number eleven (11) West. one thousand and thirty two (1032) feet South of the North West Corner of said Section. Thence Easterly parallel with the North line of said Section nine hundred and sixty three (963) feet, to the East line of the fractional Eighty (80) acre lot in the North West quarter of said Section thirty one (31). Thence Southwesterly along the East line of said fractional lot five hundred and thirty eight (538) feet. Thence Westerly parallel with the North line of said Section nine hundred and thirty four and one half (934 1/2) feet, to the West boundary line of said Section. Thence North along said West boundary line five hundred and thirty eight (538) feet to the place of beginning all of which is laid out and platted as follows, viz. laying out a strip of thirty one (31) feet wide on the North line called Blakeley Street a strip of thirty three feet (33) wide on the East line called Penny Street a strip of twenty four (24) feet wide on the South line called Pleasant Street and a strip of thirty three feet wide on the West line called Division Street. and the balance of said Ground is laid out into two blocks as platted within. Block No. 1. is divided into lots, alleys, and streets as shown in the plat with all the sizes, widths of alleys, streets &c. marked upon them in figures. Block Number 2 is not laid out into lots but is reserved as the residence of the Proprietor Wm. J. Blakeley.

Witness Our hands and seals at Grand Rapids this 3^d day of June in the year of our Lord one thousand eight hundred and sixty one.
 Signed and Sealed in Presence of }
 B. A. Harlan, John R. Stewart.

Surveyed and platted By W. L. Coffinberry.

William J. Blakeley (Seal)
 Proprietor
 W. L. Coffinberry (Seal)
 Surveyor

State of Michigan }
 Kent County } Before me a Notary Public in and for said County personally came William J. Blakeley the
 and foregoing Plat of Blakeley's Addition to the City of Grand Rapids Michigan known to me
 to be the individual persons who executed the same and severally acknowledged the said plat to be their free act
 and deed for the uses and purposes therein set forth. In Witness Whereof I have hereunto set my hand and
 Official Seal at the City of Grand Rapids this third day
 of June A.D. 1861.
 I hereby certify that this plat is a correct copy of the plat on
 record in the Register of Deeds Office being made under the
 supervision of the Auditor General by tracing the plat on
 record and affixing thereto a carefully compared copy of the
 dedication and certificate.

Dated this 11th day of Jan 1910
 Geo W Bennett
 Clerk And Civil's Dept.

Seal B. A. Harlan,
 Notary Public