


MAP OF GEORGE W. HESSE'S ADDITION
TO THE
VILLAGE OF SALINA
MICH
AD. 1863

Description

The Land here platted is a portion of the W 1/2 of the NW 1/4 of Section Thirty (30) six Town Twelve (12) North Range 4 East described as follows Commencing at the North West corner of Section 36 1/2 N R 4 E. Thence South on Section line 567 1/2 ft Thence East parallel with the North line of Sec 36 - 1304 ft to the N 1/2 half quarter line Thence North on said half quarter line 567 1/2 ft to the N. E. corner of the W 1/2 of N. W 1/4 of Sec 36 Thence West in section line 1304 ft to the place of beginning
Note: The figures in Red ink show the correct numbers of the lots

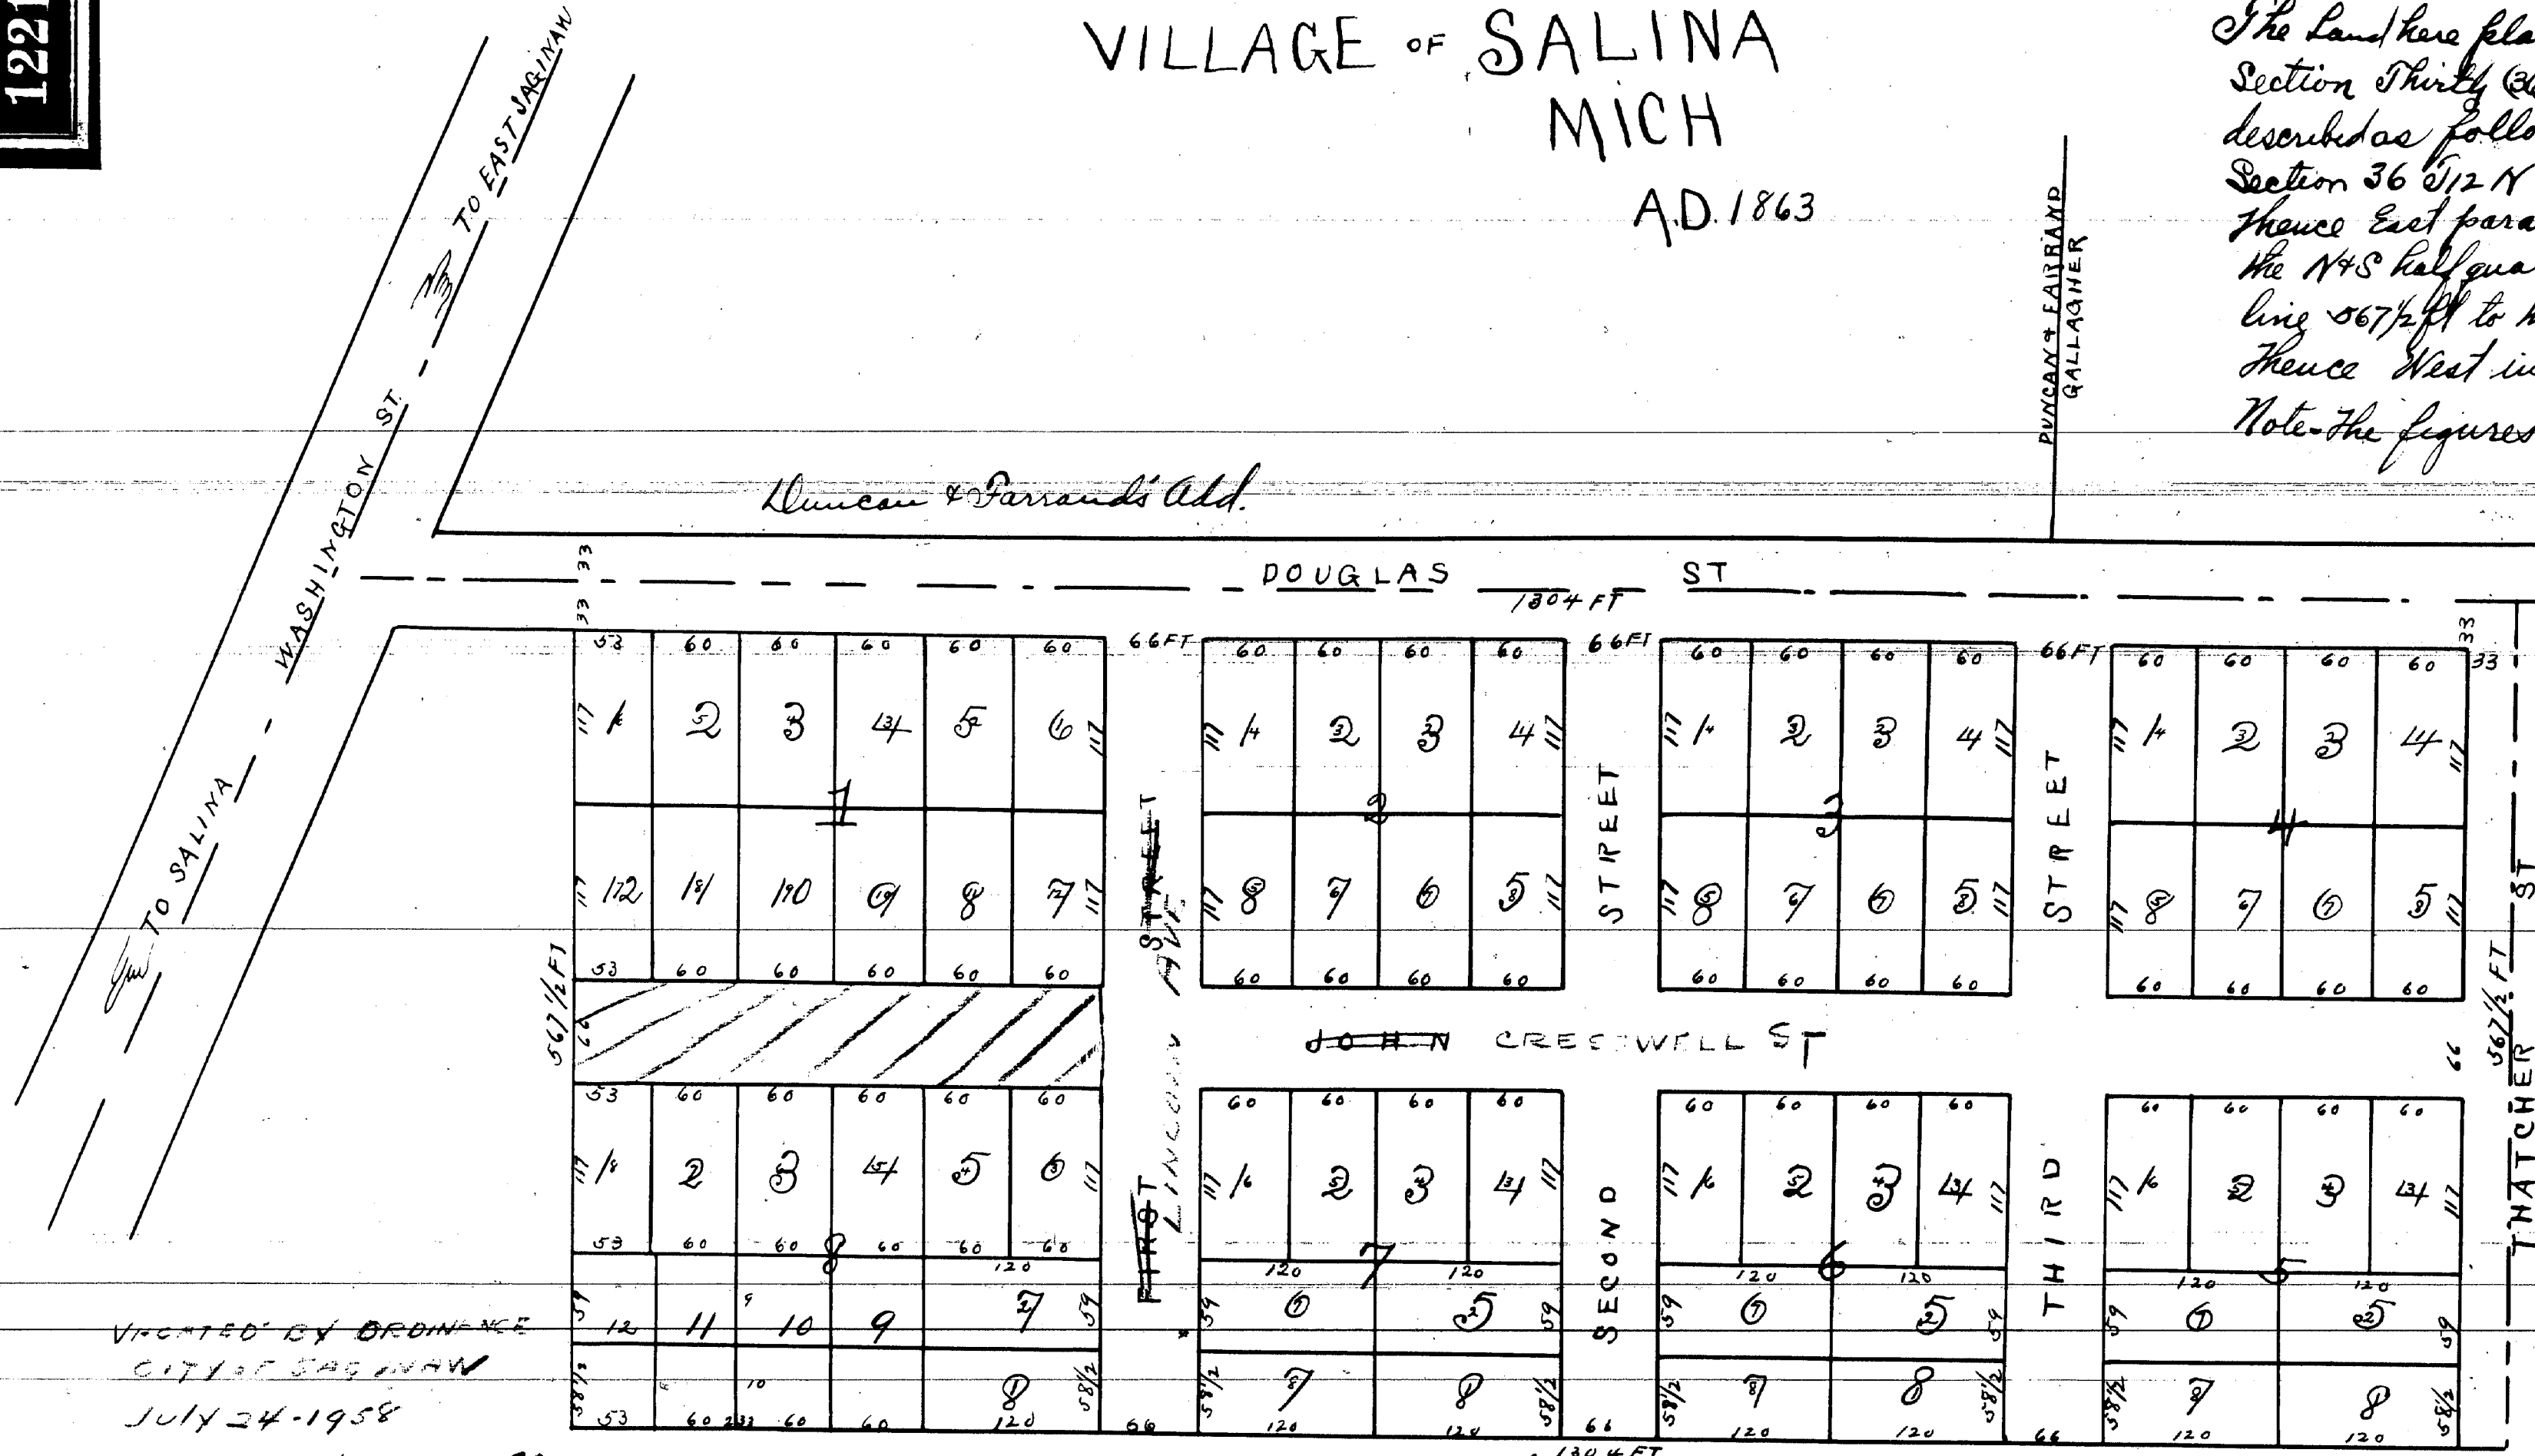

Thatcher's Add.

Register Office
Saginaw County } ss
Received for Record Oct
2nd A.D. 1863 at 11 1/2 O'clock
A.M. and recorded in Liber
No 38 of Deeds on Page 39
Jas. N. Gotee Register

State of Michigan } ss.
Saginaw County }
On this 20th day of August
A.D. 1863 before me a Notary Public personally came
the above named George W. Hesse and David N.
Kirkpatrick known to me to be the persons who executed
the above and who severally acknowledge the execution
of the same for the purposes therein expressed Witness
my hand and Seal on the day and year above written
M. H. Allardt
Notary Public in and for Saginaw
County State of Michigan

I hereby certify that this Plat is a correct copy
of the Plat now on Record in the Register of
Deeds Office, being made under the supervision
of the Auditor General by tracing the Plat
on Record and affixing thereto a carefully
compared copy of the certificate
Dated the 10th day of June 1911
Alton B. Hurd
Clerk, Aud Gen Dept.

I know all men by these Presents that the land laid out or
platted on the within Map is owned by George W. Hesse of
the City of Saginaw, Saginaw County, and State of Michigan
That said Map or Plat is now executed by the said George W.
Hesse as proprietor and David N. Kirkpatrick as surveyor
in accordance with the provisions of an act to provide
for Recording Town Plats and for vacating the same in certain
cases and the acts amendatory thereto and for the purpose of
being recorded as "George W. Hesse's Addition to the Village
of Salina" Saginaw County & State of Michigan
The size of the lots and the width of the streets are given
on said Map in feet and fractional parts of feet
In witness where of we have hereunto set our hands
and Seals this twentieth day of August A.D. One Thous and
eight hundred and sixty three
In presence of
Peter Kentschel
M. H. Allardt
George W. Grafton [L.S.]
D. H. Kirkpatrick [L.S.]

[Signature in German]
JAH.