

By H. Herbert

12/24 at 6 a.m. Dec.


July 6, 1874

Wm. H. F. 703

Daniel H. Felt;
 James T. Felt;
 James S. Felt;
 Theodore Weld
 by W. T. Miller



Dated this 13th day of July 1911

Pay ∇ C. Warner.
6 lks, and 1/2 lks. left.



City of Bay City

301 WASHINGTON AVE.
BAY CITY, MICHIGAN 49708
FAX: (517) 894-1070

February 9, 1993

Department of Treasury
Bureau of Local Government Services
Second Floor, Treasury Building
Lansing, MI 48222

Gentlemen:

Pursuant to Section 256 of the New Subdivision Act of 1967 (Public Act 288), we herewith submit a certified copy of the resolution vacating a 50' x 45' turn-around located at the north end of the alley in the block bounded by Washington Avenue, Columbus Avenue, Saginaw Street, and Eleventh Street, Flat of Add. to Lower Saginaw. A copy of the recorded easement mentioned in the vacation is also enclosed for your information.


A sketch from the Planning Office which identifies the area affected is also attached.

Sincerely,

CITY OF BAY CITY

Connie M. Deford
Connie M. Deford, CMC/AM
City Clerk

Enclosures

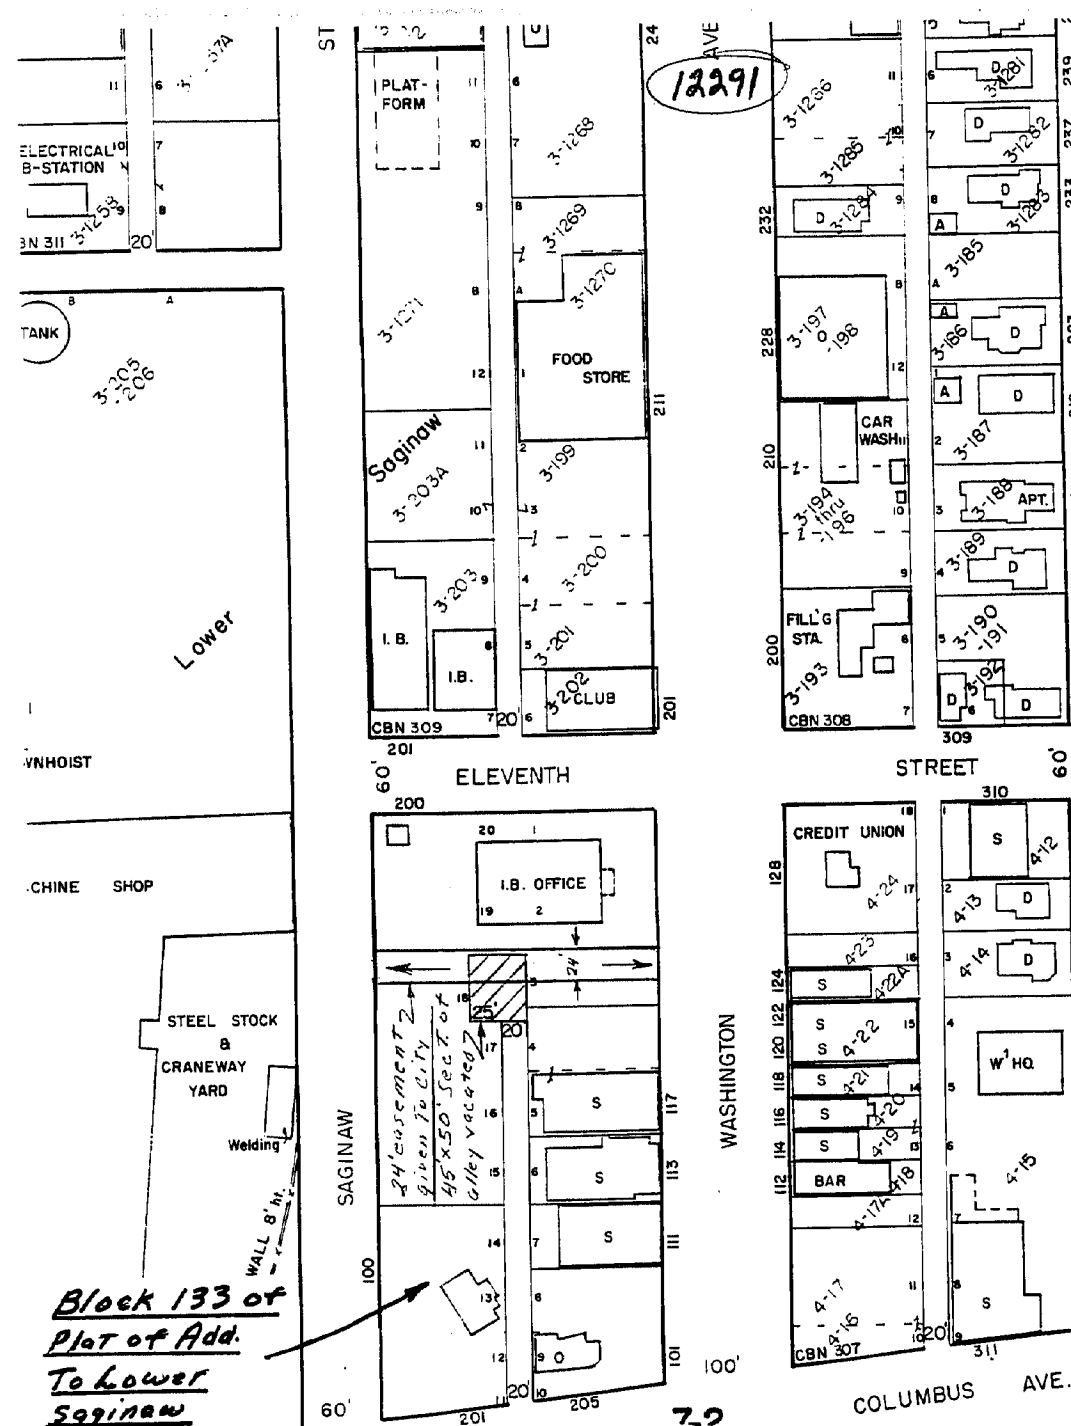

CLERK: 8168A 09/04/92 OTHER 9.00
8168A 09/04/92 REMON 2.00
12291
CITY OF BAY CITY, MICH.
OFFICE OF CITY CLERK
(AFFIDAVIT)
LIBER 1230 PAGE 405
STATE OF MICHIGAN
COUNTY OF BAY
CITY OF BAY CITY
I, Connie M. Deford Clerk of the City of
Bay City, County and State aforesaid, Do hereby Certify, that I have
compared the annexed excerpt from the regular meeting of the City
Commission of the City of Bay City held August 24, 1992
with the original on file in my office and that it is a true and
correct transcript therefrom and of the whole of such original.

In Witness Whereof, I have hereunto set my hand affixed the
Corporate Seal of the City of Bay City, Mich., this

26th day of August 1992
Connie M. Deford
Connie M. Deford City Clerk

RECORDED
SEP 4 2 22 PM '92
REGISTERED
BAY COUNTY - MICHIGAN

LIBER 1228 PAGE 607

GRANT OF EASEMENTS

FOR A SOLE CONSIDERATION of mutual benefits, the AMERICAN RED CROSS-BAY COUNTY CHAPTER, a Michigan non-profit corporation, of 119 Washington Avenue, Bay City, Michigan, 48706, grants and conveys to J & K ASSOCIATES, a Michigan co-partnership of 2298 N. Eastman Avenue, Midland, Michigan, a perpetual, non-exclusive easement for driveway purposes over and across the North 9 feet easement of Lot 4, Block 133, of the Addition of Lower Saginaw (now Bay City), according to the recorded plat thereof.

The above-described easement is granted to provide access from Washington Street in the City of Bay City, Bay County, Michigan, to Lots 1, 2, 3, 15, 16, 17, 18, 19 and 20, Block 133, of the Addition of Lower Saginaw, (now Bay City), now owned by J & K ASSOCIATES, a Michigan co-partnership, and such easement shall run with and be appurtenant to Lots 1, 2, 3, 15, 16, 17, 18, 19 and 20, Block 133, of the Addition of Lower Saginaw, (now Bay City).

The above-described easement is a non-exclusive easement, and J & K ASSOCIATES shall have the right and authority to grant an additional easement for driveway purposes over and across the above-described easement to the City of Bay City, Michigan.

J & K ASSOCIATES, a Michigan co-partnership, grants to the AMERICAN RED CROSS-BAY CITY CHAPTER, a Michigan non-profit corporation, an easement for parking purposes sufficient to accommodate parking of ten (10) automobiles, on Lot 16, Block 133, Addition of Lower Saginaw (now Bay City).

This instrument was executed August 11, 1992.

WITNESS:

Mildred C. Pawlaski
MILDRED C. PAWLASKI
Michelle M. Super
MICHELLE M. SUPER

Martin C. Oette
MARTIN C. OETTE
Leary Z. Cox
LEARY Z. COX

STATE OF MICHIGAN)
COUNTY OF BAY) ss.

On this 14th day of August, A.D., 1992, before me personally appeared Karen Brown-Hepf, to me personally known, who being by me sworn, did say that she is the Executive Director of RED CROSS, a Michigan non-profit corporation, the corporation named in and which executed the within instrument, and that said instrument was signed and sealed in behalf of said corporation by authority of its board of directors; and said KAREN BROWN-HEPF acknowledged said instrument to be the free act and deed of said corporation.

Kathryn M. Hertz
Notary Public
Bay County, Michigan
My Commission Expires: 8-24-1995

KATHRYN M. HERTZ
Notary Public, Bay County, Mich.
My Commission Expires: 8-24-1995

City Manager and Planning Director.
It is recommended that the following resolution regarding the vacation of the 50' x 45' turn-around in Block 133 of the Addition to Lower Saginaw (Block bounded by Washington, Columbus, Saginaw, and Eleventh Streets) be approved:
Whereas, the Bay City Planning Commission held a public hearing on June 17, 1992 to consider the petition of J & K Associates to vacate a 50' x 45' turn-around located at the north end of the alley in Block 133 of the Addition to Lower Saginaw; said alley is located in the block bounded by Washington Avenue, Columbus Avenue, Saginaw Street and Eleventh Street; and
Whereas, said turn-around was originally established when the through alley was vacated a number of years ago to accommodate business traffic using this alley; and
Whereas, the location of this turn-around is very close to the former IB office building, which will house the EPA super computer; and
Whereas, renovation of the office building and development of off-street parking facilities require the vacation of said turn-around; and
Whereas, developers of this property have agreed to grant an acceptable easement meeting the City Engineer's criteria which will allow the general public ingress and egress over the property from the north end of the remaining portion of the public alley in this block; and
Whereas, public utilities exist within this portion of the alley; and
Whereas, the Planning Commission recommended the petition be approved as requested, with the condition that usual utility easements be retained and with the future condition that J & K Associates grant an acceptable easement meeting the City Engineer's design criteria to the general public for purposes of ingress and egress from the north end of the remaining portion of the public alley in this block; and
Whereas, a resolution was adopted by the City Commission on July 13, 1992 ordering publication of notices and the holding of a hearing; said notice having been published in The Bay City Democrat, the official newspaper of the City of Bay City, on July 23, 24 and August 6 and 13, 1992 relative to the aforementioned hearing, and certified notices thereof having been mailed to the public utilities, railroad and abutting property owners; and
Whereas, a public hearing was held by the City Commission on Monday, August 24, 1992 relative to the aforementioned alley vacation.

LIBER 1230 PAGE 406

Now, Therefore Be It Resolved and Ordered by the City Commission that the 50' x 45' turn-around located at the north end of the alley in the block bounded by Washington Avenue, Columbus Avenue, Saginaw Street and Eleventh Street, being in Block 133 of the Addition to Lower Saginaw, is hereby closed and vacated; provided, however, that said alley is vacated upon the condition that title to all gas, electric and communication poles, wires, pipes, conduits, cables, appurtenances and facilities now in, under or over said alley are reserved and shall remain in the respective owners thereof, together with the easement and rights to occupy said alley for public utility purposes with present and additional facilities to operate, maintain, repair, replace or remove the same; and, furthermore, that no permanent structures be placed in said alley and if fences are constructed that they be removed at no expense to the utility companies when they are making repairs or installing lines; and that said vacation also be conditioned upon the developers of the property (J & K Associates) adjacent to said portion of alley turn-around deed acceptable easements from the alley to Washington Avenue and Saginaw Street to take the place of said turn-around.

Commissioner Lewandowski moved to allow public input. There was no objection. No one came forward. Commissioner Katt moved adoption of resolution.
Adopted by the following vote:
Yes, Commissioners Bock, Sheppard, Lewandowski, LeVasseur, Katt, LeRoux, Newsham, Wladkowski, R.
No, None.

LIBER 1228 PAGE 608


STATE OF MICHIGAN)
COUNTY OF MIDLAND) ss.

On this 24th day of August, A.D., 1992, before me personally appeared JAMES E. JOHNSON and KENNETH A. KEELEY, to me personally known, who being by me sworn, did say that they are partners in J & K ASSOCIATES, a Michigan co-partnership, the co-partnership named in and which executed the within instrument, and that said instrument was signed and sealed in behalf of said co-partnership by authority of its partners; and said JAMES E. JOHNSON and KENNETH A. KEELEY acknowledged said instrument to be the free act and deed of said co-partnership.

Mark R. Maddox
MARK R. MADDOX
Notary Public
Midland County, Michigan
My Commission Expires: 4-3-94

This instrument prepared by:
Mark R. Maddox P25385
Attorney at Law
5820 Eastman Avenue
Midland, MI 48640
P.O. Box 2125

RECORDED
SEP 21 1 32 PM '92
REGISTERED
BAY COUNTY - MICHIGAN

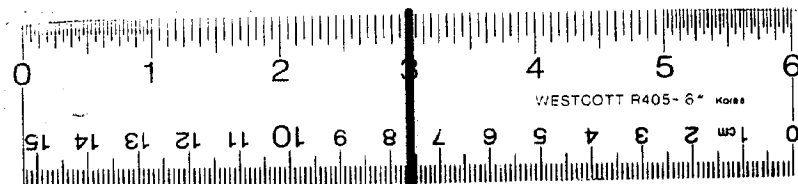

24 X