



May 4, 1994

Subdivision Control
Department of Commerce
P.O. Box 30004
Lansing, MI 48909-7504

Gentlemen:

In accordance with the Subdivision Control Act of 1967, as amended, submitted is a certified copy of the resolution vacating the alley in the block bounded by 36th Street, 37th Street, Stanton Street and Broadway, plat of Edward Ingraham's Add.

A sketch from the Planning Office which identifies the area affected is also attached.

If you have any questions, please contact my office at (517) 894-8168.

Sincerely,

CITY OF BAY CITY

Connie M. Deford

Connie M. Deford, CMC/AE
City Clerk

Enclosure

City of Bay City

301 WASHINGTON AVE.
BAY CITY, MICHIGAN 48708
FAX: (517) 894-1070

12326
MAY 06 1994

CLB-3c LIBER 1318 PAGE 111

CITY OF BAY CITY, MICH.
OFFICE OF CITY CLERK
(AFFIDAVIT)

STATE OF MICHIGAN
COUNTY OF BAY
CITY OF BAY CITY

I, Connie M. Deford, Clerk of the City of
Bay City, County and State aforesaid, Do hereby Certify, that I have
compared the annexed excerpt from the regular meeting of the City
Commission of the City of Bay City held December 6, 1993

with the original on file in my office and that it is a true and
correct transcript therefrom and of the whole of such original.

In Witness Whereof, I have hereunto set my hand affixed the
Corporate Seal of the City of Bay City, Mich., this

28th day of January 19 94

Connie M. Deford
Connie M. Deford, City Clerk

Of City Manager and City Planner:

In accordance with City Commission
action taken on November 1, 1993 regard-
ing the petition of S. Schaffer and others to
vacate the alley in the block bounded by
36th Street, 37th Street, Stanton Street,
and Broadway, the following is presented:

Whereas, the Planning Commission
held a public hearing on October 20, 1993,
to consider vacating the above-described
alley; and

Whereas, said alley has utilities lo-
cated within it; and

Whereas, a resolution was adopted by
the City Commission on November 1, 1993
ordering publication of notices and the
holding of a public hearing, said notices
having been published in The Bay City
Democrat, the official newspaper of the
City of Bay City, on November 11, 18, 25,
and December 2, 1993 relative to the

aforementioned hearing; and certified no-
tices thereof having been mailed to the
public utility companies and abutting prop-
erty owners; and

Whereas, a public hearing was held on
December 6, 1993 relative to the afore-
mentioned request for vacation

Now, Therefore, Be It Resolved and
Ordered by the City Commission that
the alley in the block bounded by 36th
Street, 37th Street, Stanton Street, and
Broadway is hereby closed and vacated;
provided, however, that said alley is va-
cated upon the condition that title to all gas,
electric and communication poles, wires,
pipes, conduits, cables, appurtenances
and facilities now in, under or over said
alley are reserved to and shall remain in the
respective owners thereof, together with
the easement and rights to occupy said
alley for public utility purposes with present

and additional facilities to operate, main-
tain, repair, replace or remove the same;
and furthermore, that no permanent struc-
tures be placed in said alley, and if fences
are constructed, that they be removed at
no expense to the utility companies when
they are making repairs or installing lines;
and that a sign(s) be erected reading "Alley
Closed," said sign to be paid for by benefi-
ting property owners.



Commissioner Shaw moved to allow
public input. There was no objection. No
one came forward.

Commissioner Shaw moved adoption
of resolution.


Adopted by the following vote:

Yes, Commissioners Shaw, Shep-
pard, Banaszak, Gwizdala, Katt, Hutter,
Newsham, Schram, B.

No, None.
Abstain, Commissioner Lock, 1.

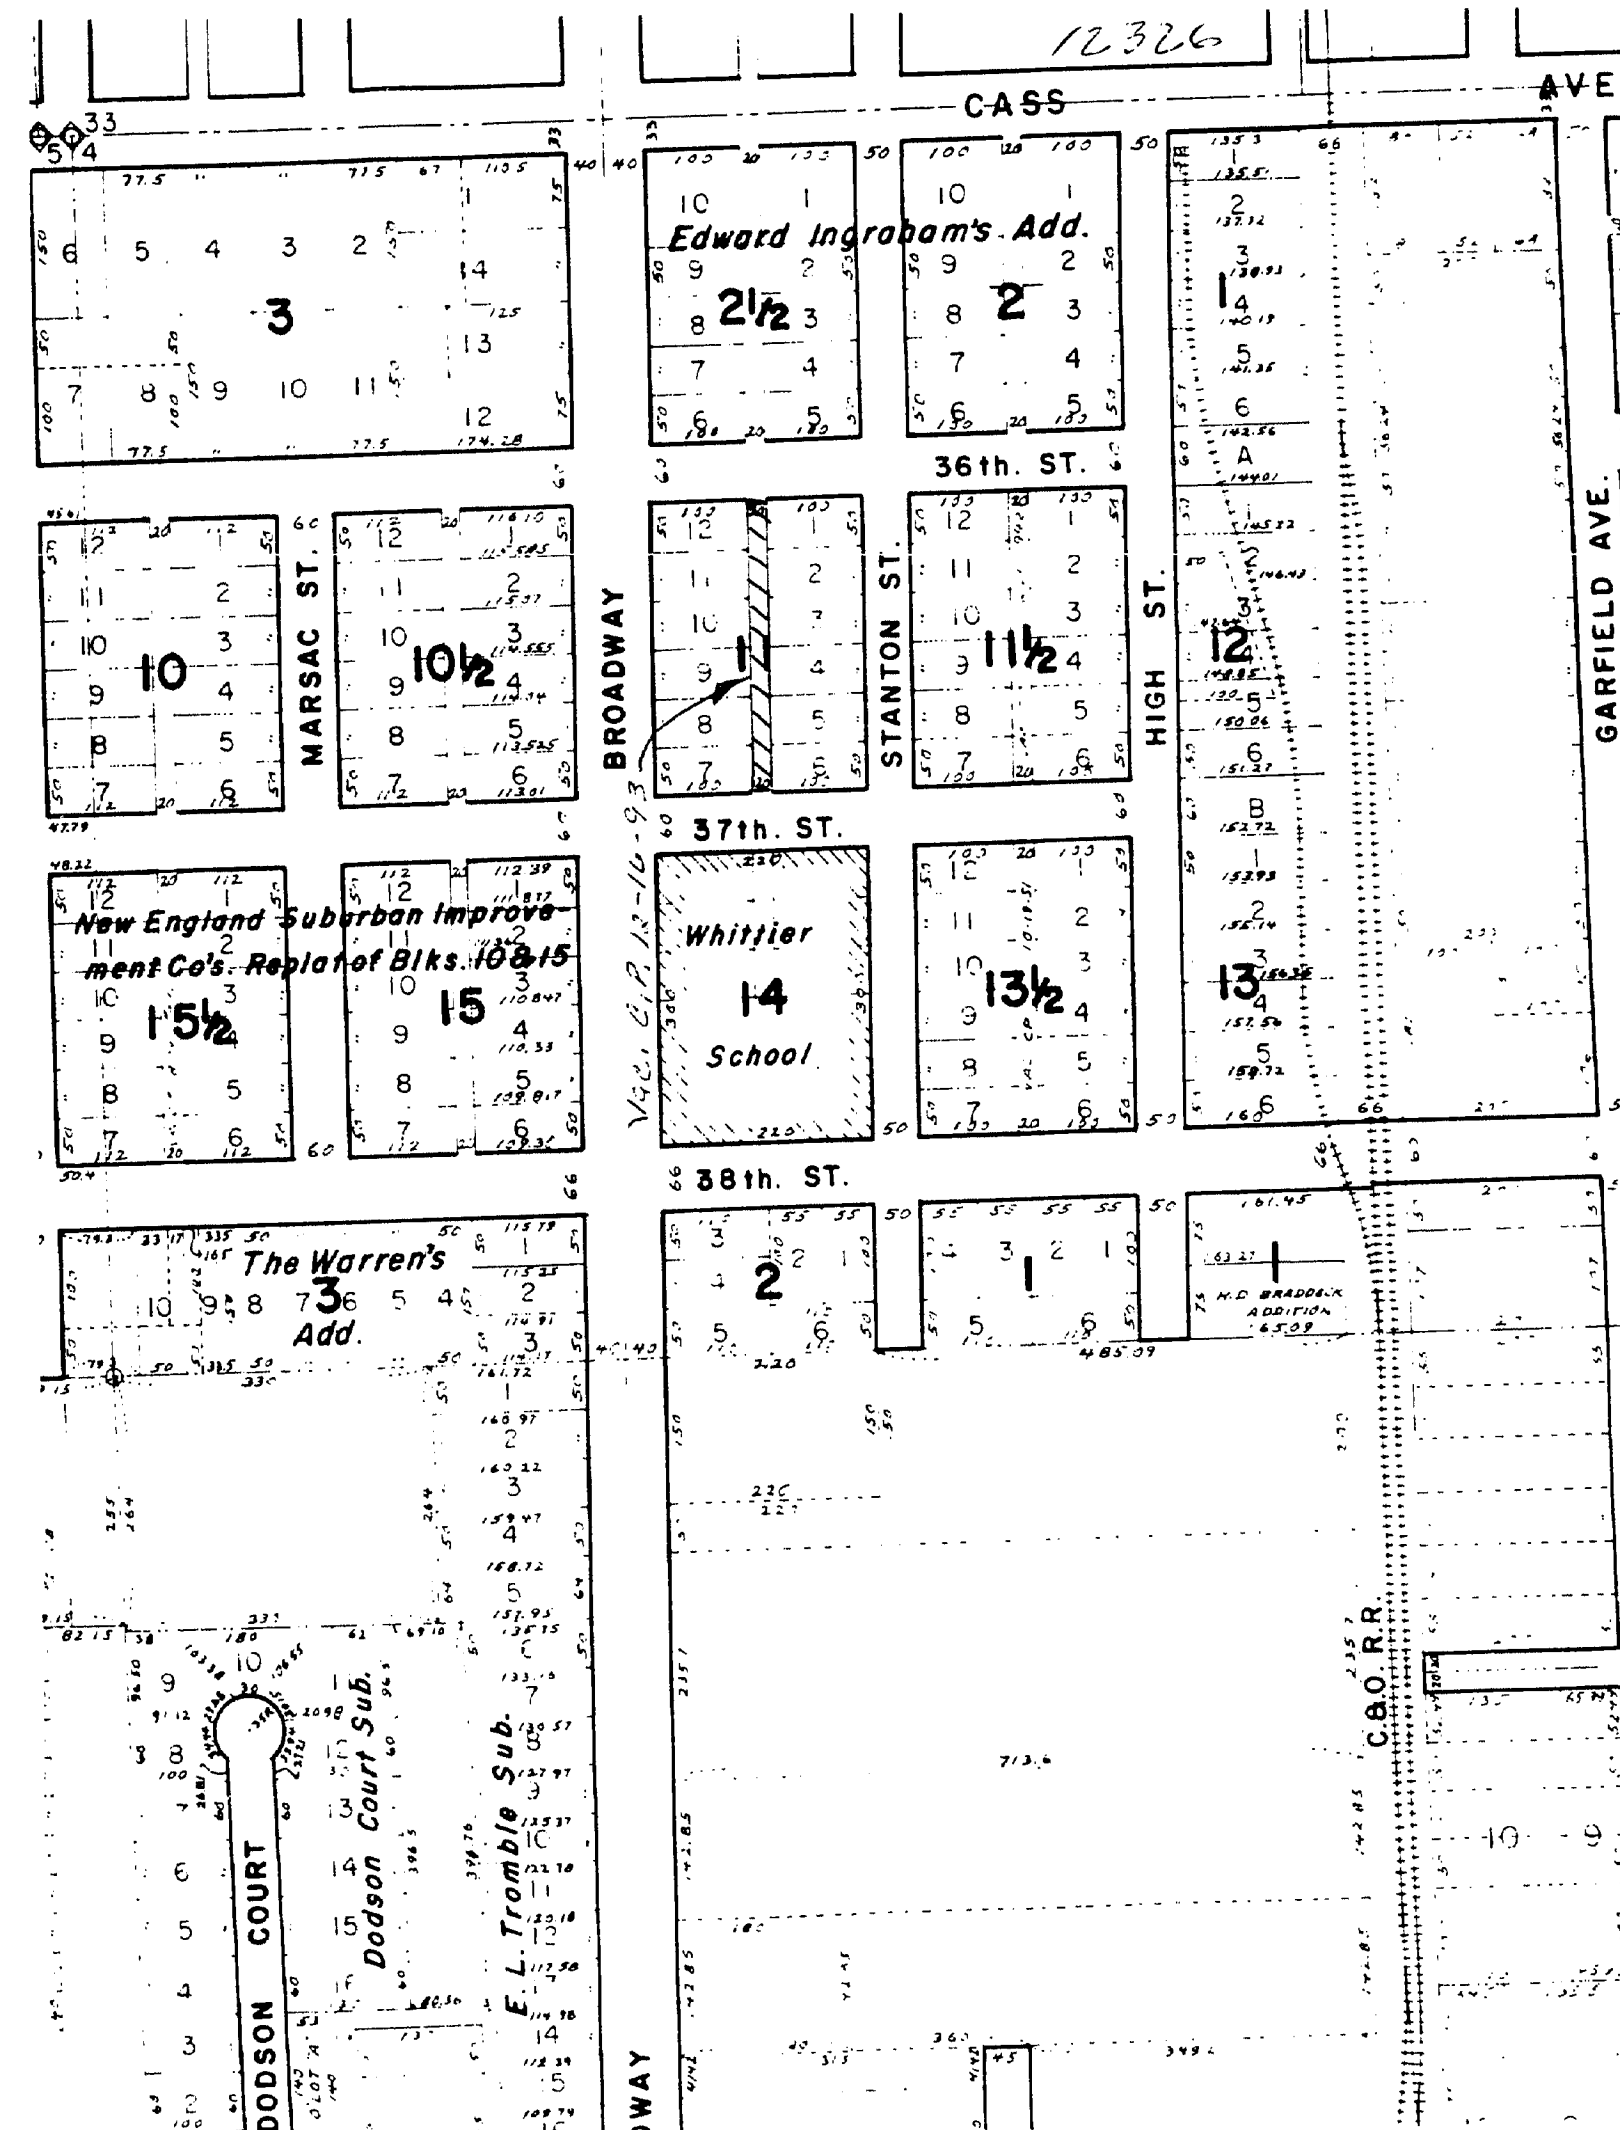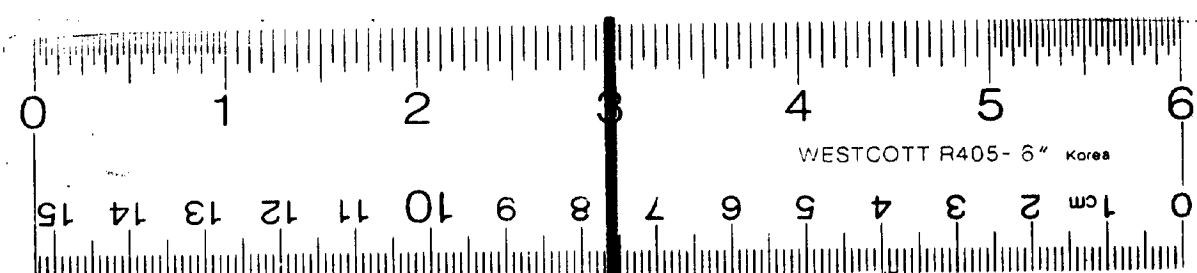

16 X

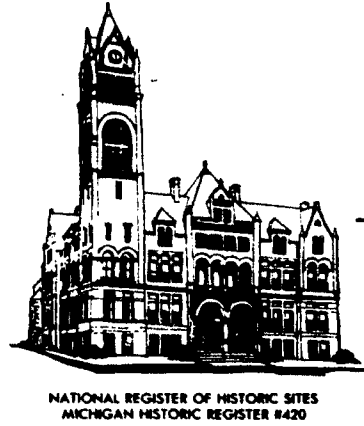

June 28, 1983

Department of Treasury
Bureau of Local Government Services
2nd Floor, Treasury Building
Lansing, Michigan 48922

Gentlemen:

Pursuant to Section 256 of the new Subdivision Act of 267 (Public Act 288), we herewith submit a certified copy of the resolution vacating the north/south alley in the block bounded by 26th, 37th, Webster and Ingraham Streets. This alley is located in the Replat of Edward Ingraham's Addition.

A sketch from the Planning Office which identifies the area affected is also attached.

Sincerely,

CITY OF BAY CITY

Walter Wozniak, Jr.
Walter Wozniak, Jr.
City Clerk

WW:cd

Att.

12326
City of Bay City

301 WASHINGTON AVE.
BAY CITY, MICHIGAN 48706
AREA CODE 517 - 894-8200

CLB-3c

LIBER 938 PAGE 229

CITY OF BAY CITY, MICH.
OFFICE OF CITY CLERK
(AFFIDAVIT)

515080: 03:00:12

12326

STATE OF MICHIGAN
COUNTY OF BAY
CITY OF BAY CITY

I, Walter Wozniak, Jr., Clerk of the City of Bay

City, County and State aforesaid, Do hereby Certify, that I have compared the

annexed excerpt from the regular meeting of the City Commission of the

City of Bay City held August 24, 1981

with the original on file in this office and that it is a true and correct

transcript therefrom and of the whole of such original.

In Witness Whereof, I have hereunto set my hand affixed the
Corporate Seal of the City of Bay City, Mich., this

14th day of June, 1983.

Walter Wozniak, Jr.
Walter Wozniak, Jr., City Clerk

SPECIAL ORDER

Of Commission as a Whole:
Whereas, the Planning Commission held a public hearing to consider vacating the north/south alley in the block bounded by 36th, 37th, Webster and Ingraham, and

Whereas, the Planning Commission recommended that same be closed and vacated, and


Whereas, a resolution was adopted by the City Commission on July 20, 1981, ordering publication of notices and the holding of a hearing, said notices having been published in the Bay City Democrat, the official newspaper of the City of Bay City, on July 20, August 6, 13 and 20, 1981, relative to the aforesaid hearing and certified notices thereof having been mailed to the public utilities and abutting property owners, and

Whereas, a public hearing was held by the City Commission on August 24, 1981, relative to the aforesaid petition for said vacation,

Now, Therefore, Be It Resolved and Ordered, by the City Commission that:

the North/South Alley in the block bounded by 36th, 37th, Webster and Ingraham Streets, be and hereby is closed with utility easements being retained.

Rules Suspended
Commissioner Buda moved that rules be suspended to permit any interested persons in the audience to speak regarding the proposed vacation of the alley. There was no objection. No one appeared.
Commissioner Kienbaum moved adoption of resolution.
Adopted by the following vote —
Yes: Commissioners Sullivan, VanDerwill, Snyder, Gelda, Tarkowski, Winters, Toth, Buda, Kienbaum, 9.
No: None.

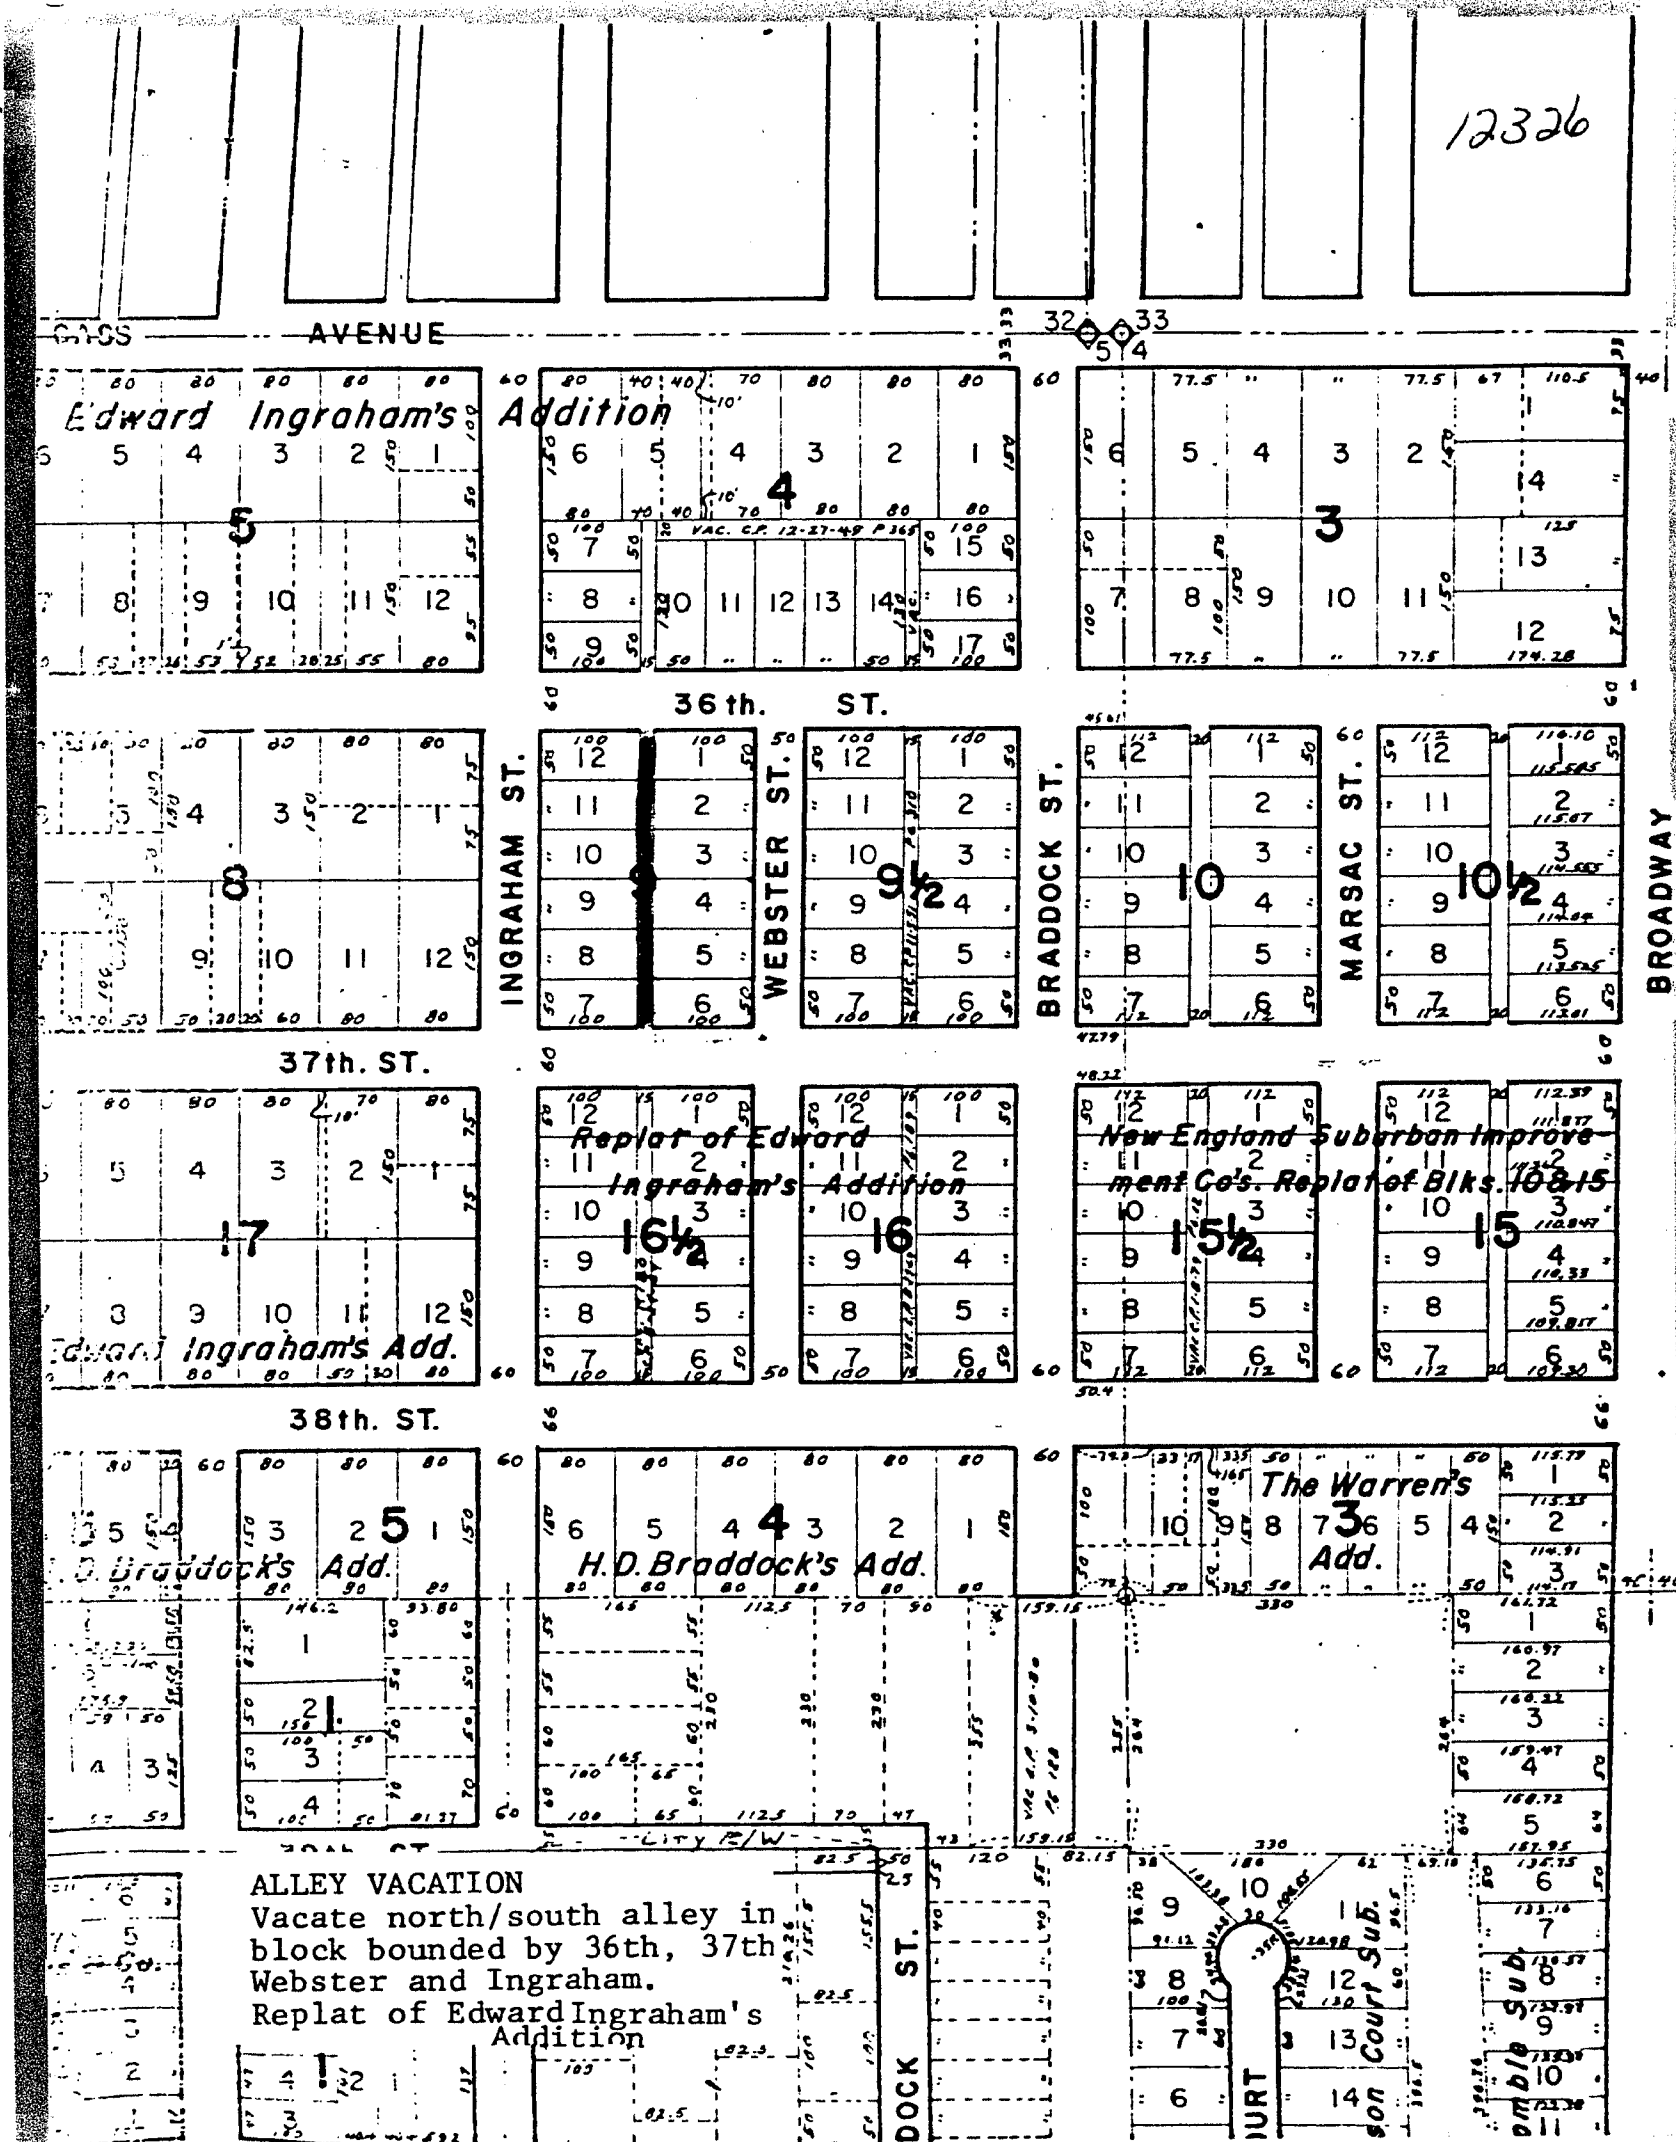



12326

CITY OF BAY CITY
BAY CITY, MICHIGAN 48706
Area Code 517 894-8200

July 30, 1981

Department of Treasury
Bureau of Local Government Services
2nd Floor, Treasury Building
Lansing, Michigan 48922

Gentlemen:

Pursuant to Section 256 of the new Subdivision Act of 267 (Public Act 288), we hereby submit a certified copy of the resolution vacating the two alleys in the triangular block bounded by Litchfield Street on the west, E. Ohio Street on the north, and the Grand Trunk & Western Railroad right-of-way on the east. The alleys are located in Howe's Addition.

A sketch from the Planning Office which identifies the area affected is also herewith attached.

Sincerely,

CITY OF BAY CITY

Walter Wozniak, Jr.
Walter Wozniak, Jr.
City Clerk

WW:ve

enc.



XX.2

CL83c

CITY OF BAY CITY, MICH.
OFFICE OF CITY CLERK
(AFFIDAVIT)

LIBER 907 PAGE 684

STATE OF MICHIGAN
COUNTY OF BAY
CITY OF BAY CITY

I, Walter Wozniak, Jr. Clerk of the City of Bay

City, County and State aforesaid, Do hereby Certify, that I have compared the annexed excerpt from the regular meeting of the City Commission of Bay City held July 6, 1981

with the original on file in this office and that it is a true and correct transcript therefrom and of the whole of such original.

SPECIAL ORDER
Of Commission as a Whole:
Whereas, the Planning Commission held a public hearing to consider vacating the two alleys in the triangular block bounded by Litchfield Street on the west, East Ohio Street on the north, and the Grand Trunk & Western Railroad right-of-way on the east, and

Whereas, the Planning Commission recommended that same be closed and vacated, and

Whereas, a resolution was adopted by the City Commission on June 1, 1981, ordering publication of notices and the holding of a public hearing, said notices having been published in the Bay City Democrat, the official newspaper of the City of Bay City, on June 11, 18, 25 and July 2, 1981, relative to the aforesaid hearing and certified notices thereof having been mailed to the public utilities and abutting property owners, and

Whereas, a public hearing was held by the City Commission on July 6, 1981, relative to the aforesaid petition for said vacation.

Now, Therefore, Be It Resolved and Ordered, by the City Commission that:

the two alleys in the triangular block bounded by Litchfield Street on the west, East Ohio Street on the north, and the Grand Trunk & Western Railroad right-of-way on the east

In Witness Whereof, I have hereunto set my hand affixed the

Corporate Seal of the City of Bay City, Mich., this

14th day of July 19 81

Walter Wozniak, Jr.
City Clerk

be and hereby are closed with utility easements being retained.

Rules Suspended

Commissioner Buda moved to suspend the rules and public hearing be held to permit any interested persons in the audience to speak regarding the proposed alley closings. There was no objection. No one appeared.


Commissioner Buda moved adoption of resolution.

Adopted by the following vote —
Yes: Commissioners Sullivan, Vanderwill, Snyder, Gelda, Winters, Toth, Buda, Kienbaum, &
No: None.



1981 JUL 15 AM 9:07

RECORDED

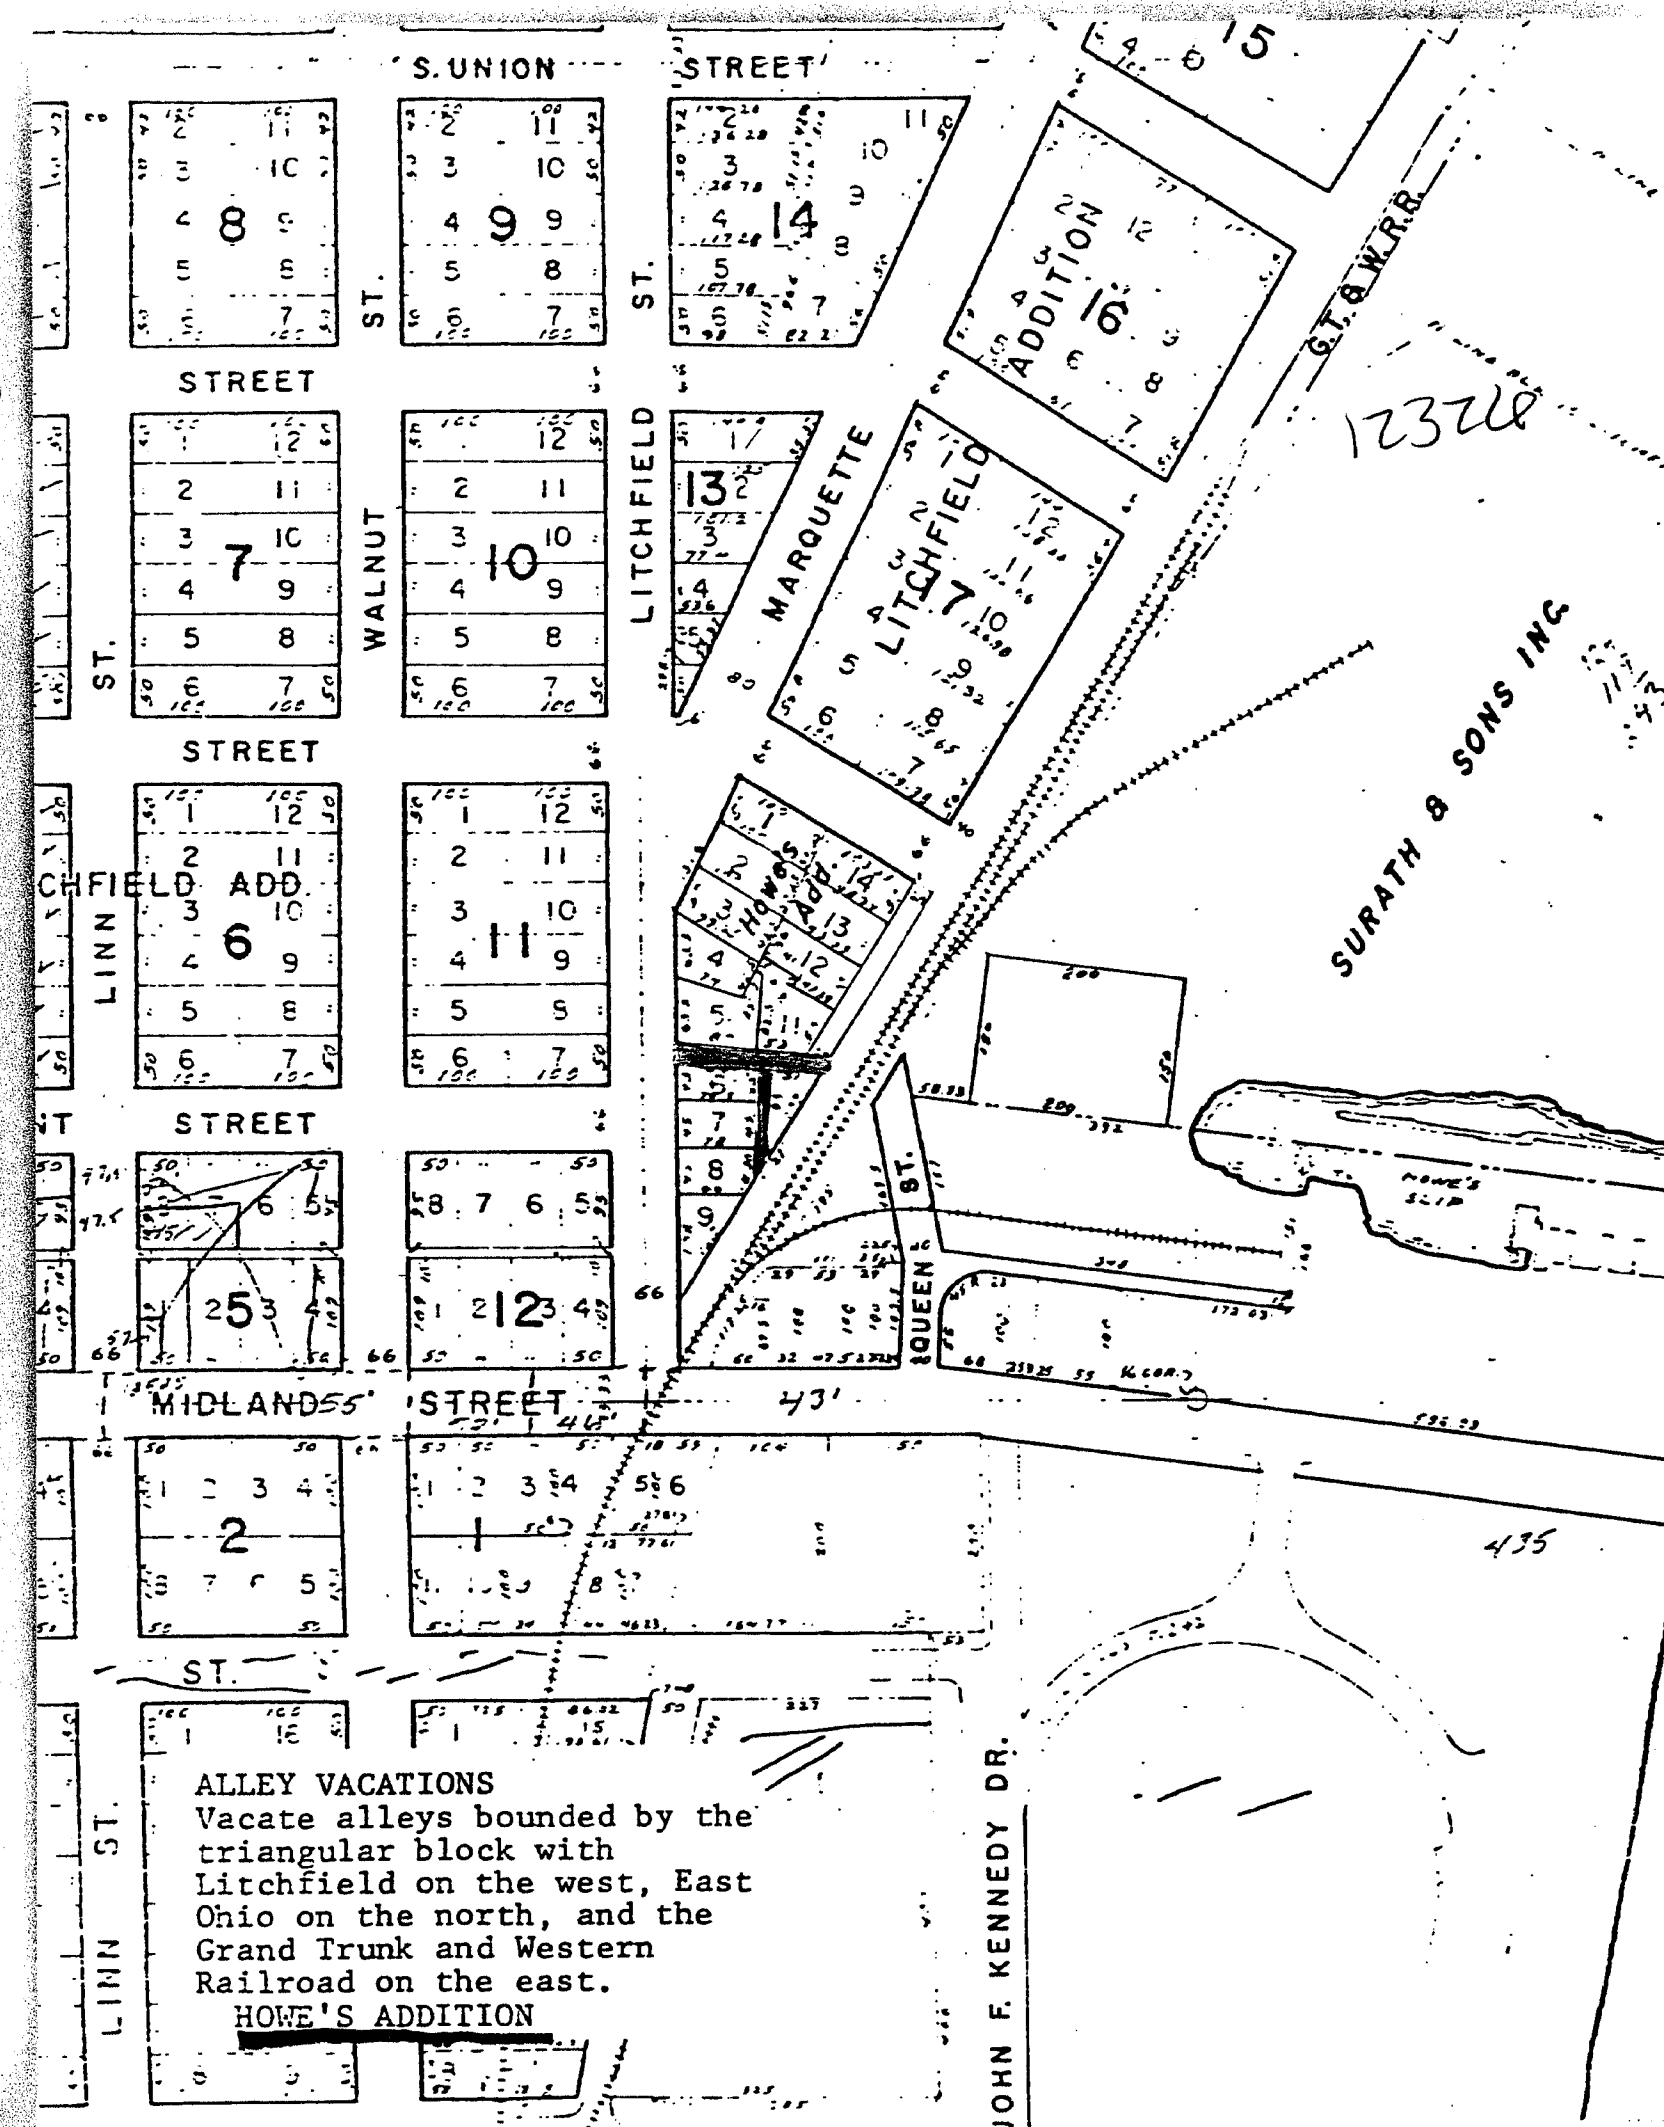

CITY OF BAY CITY, MICH.
OFFICE OF CITY CLERK

(AFFIDAVIT)

CL8-3c

STATE OF MICHIGAN

COUNTY OF BAY
CITY OF BAY CITY

1969 AUG - 6 PM 11:15

M. Mearns
CLERK OF DEEDS
BAY COUNTY, MICH.I, Walter Wozniak, Jr., Clerk of the City of BayCity, County and State aforesaid, Do hereby Certify, that I have compared the
annexed excerpt from the Regular Meeting of the City Commission held July 28,
1969with the original on file in this office and that it is a true and correct
transcript therefrom and of the whole of such original.In Witness Whereof, I have hereunto set my hand affixed the
Corporate Seal of the City of Bay City, Mich., this6th day of August 19 69Walter Wozniak Jr.

City Clerk

H. D. Braddock's Addition

SPECIAL ORDERS

Of Commission as a Whole:

Whereas, John W. Hoffman and one (1) other on May 26, 1969, petitioned this commission to close Polk Street, south 150 feet from 38th Street, as set forth in said petition;

And Whereas, the planning commission recommended that same be closed and vacated;

And Whereas, it appears that the closing and vacating thereof would constitute an improvement and advantage to both the city and the adjacent property owners;

And Whereas, a resolution was adopted by the city commission on June 23, 1969, ordering publication of notices and holding of a hearing; said notices having been published in the Bay City Times, a newspaper of general circulation in Bay City, on June 29, July 6, 13 and 20, 1969, relative to the aforesaid hearing; and certified notice thereof having been

mailed to the railroads and public utilities and to the abutting property owners;


And Whereas, a public hearing was held by the city commission on July 28, 1969, relative to the aforesaid petition for said vacation;

Now, Therefore, Be It Resolved and Ordered, by the City Commission that Polk Street, south 150 feet from 38th Street, be and the same is hereby closed and vacated, with the city reserving unto itself a 20 foot easement (10 feet on both sides of present centerline of street) for public utility purposes and under condition that no structures, including fences and garages be constructed within the area of the easement.

RULES SUSPENDED

Commissioner Laskowski moved that rules be suspended to hear Mr. Hoffman and any other persons interested in the street closing. Adopted. Mr. Hoffman stated that a tree is located on Polk Street in the area to be closed and he requested that removal of the tree be considered. He said that it was not determined whether the tree is on private or City property. Referred to the Director of Community Development.

Commissioner Laskowski moved for adoption of resolution. Adopted unanimously.

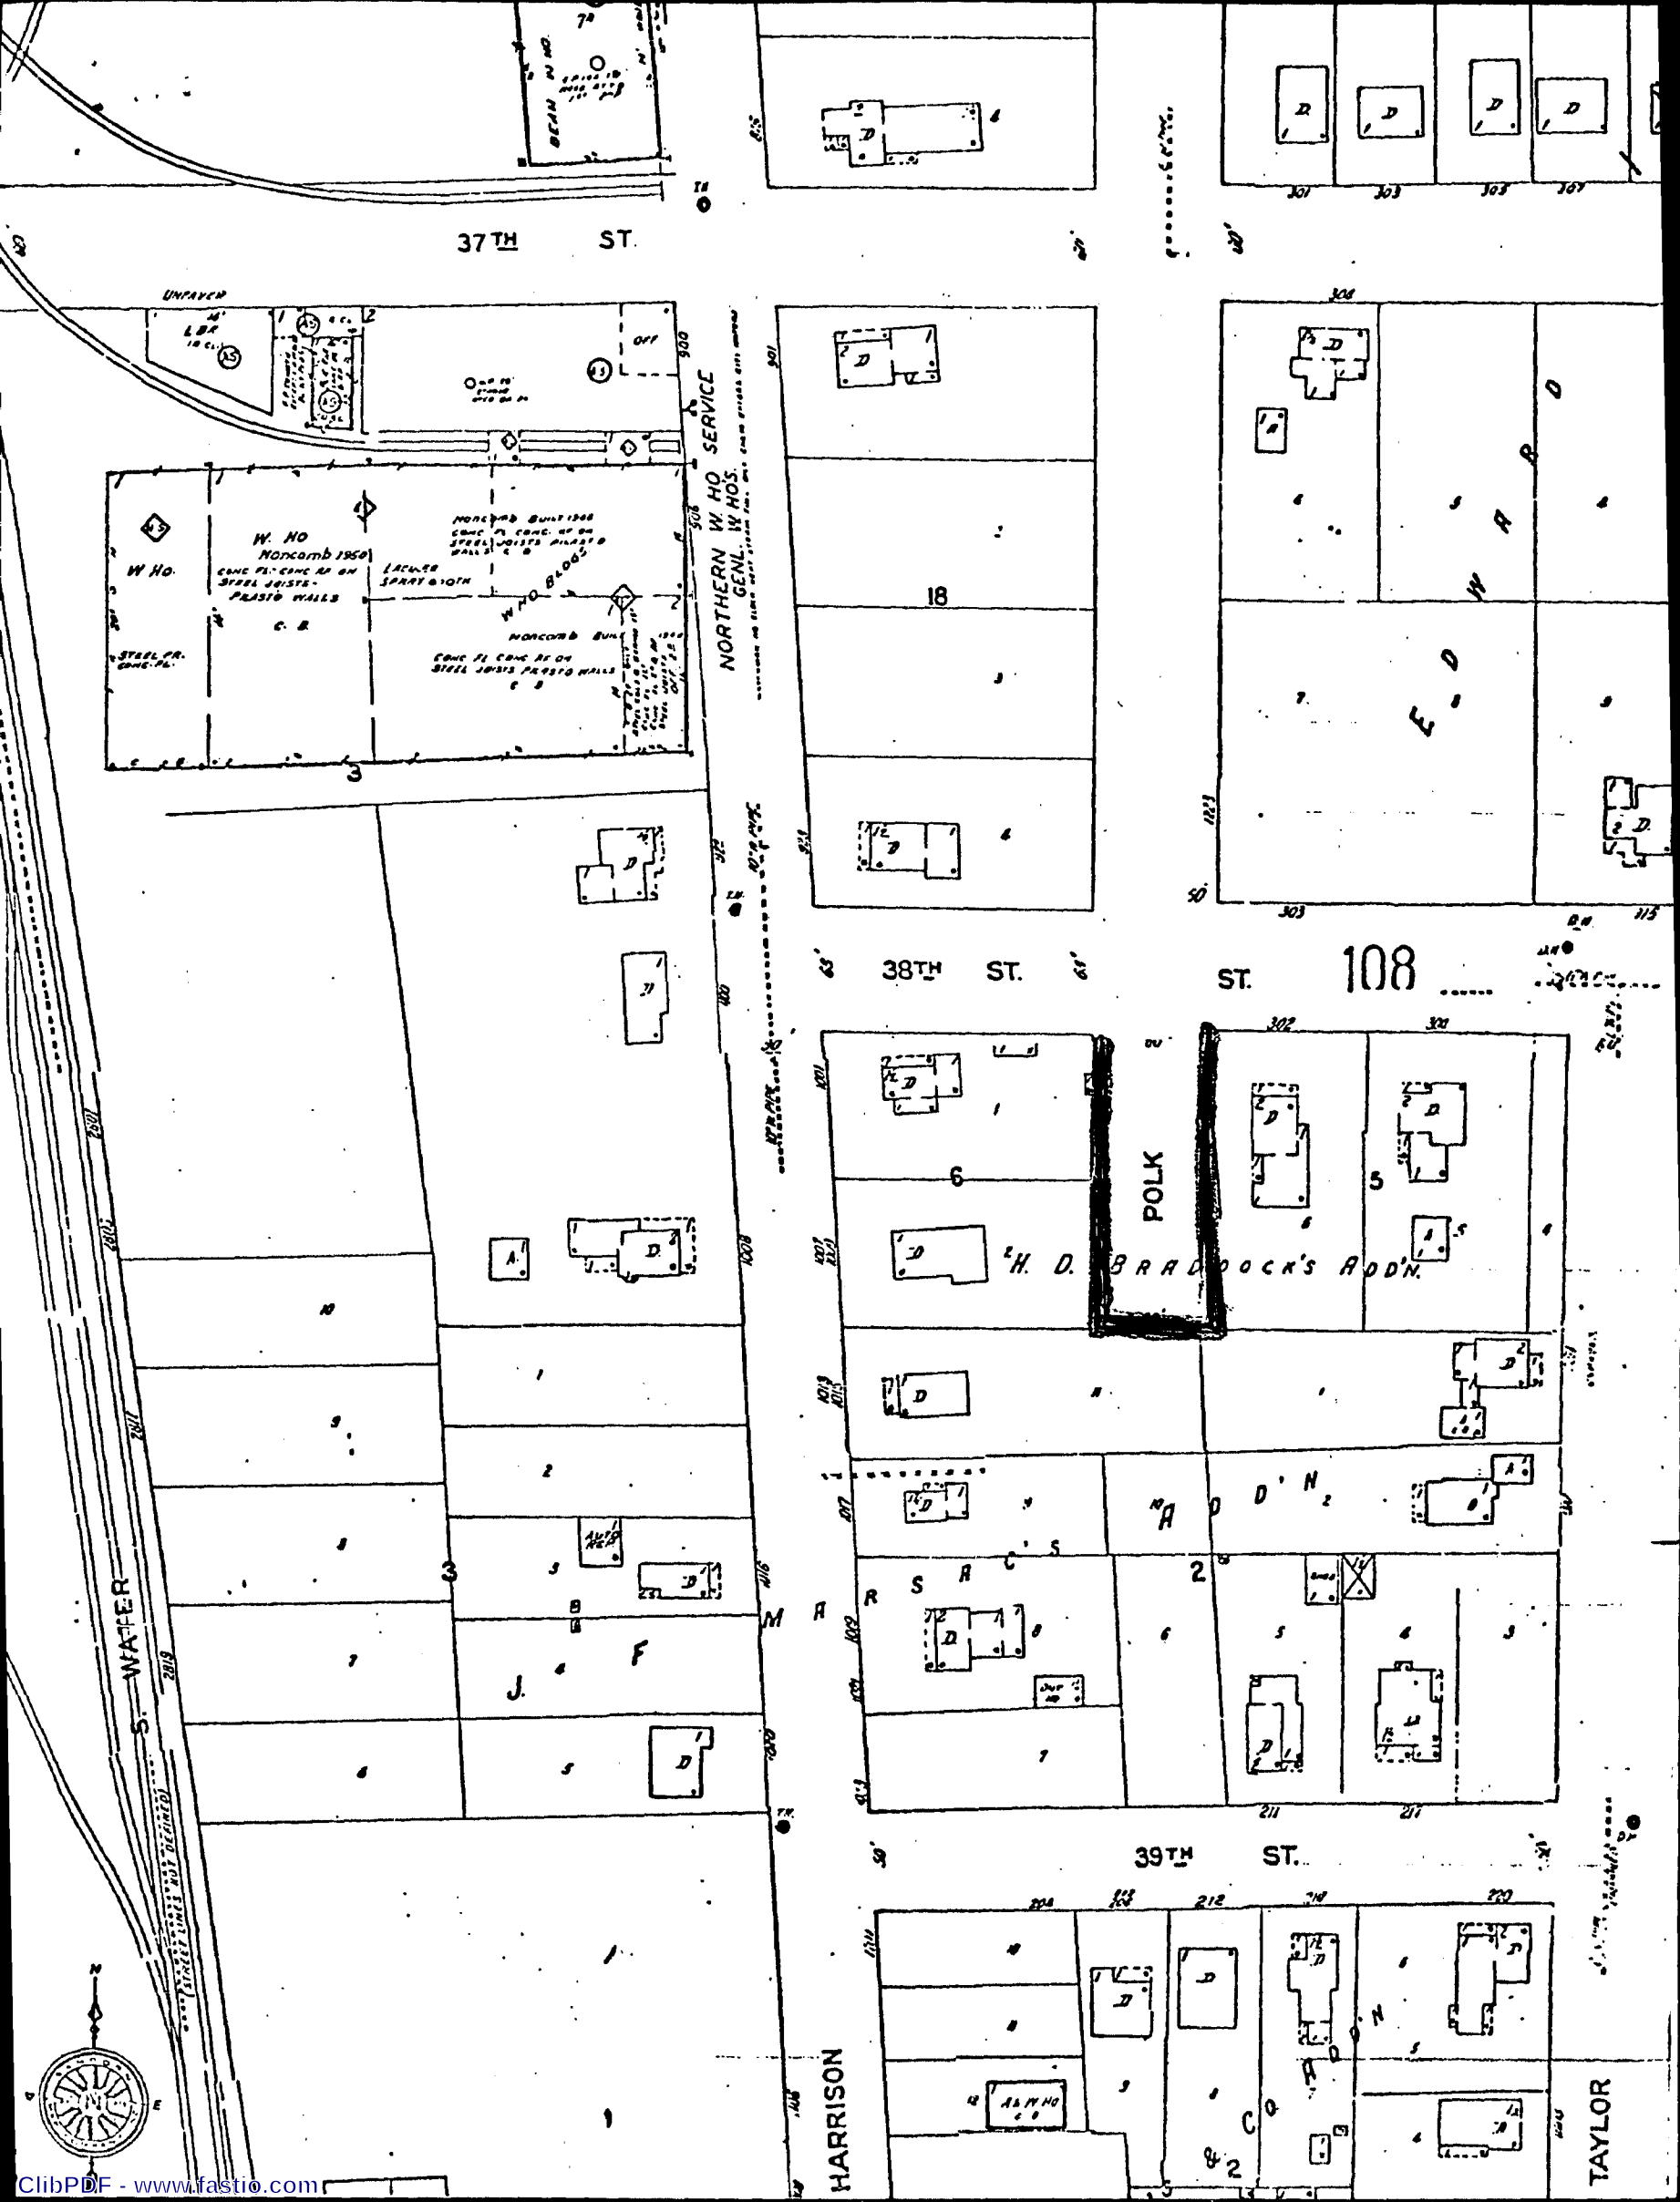

37TH ST.

NORTHERN W HO SERVICE
GENL. W HOS.

38TH ST.

ST.

108

POLK

H. D. BRADDOCK'S ADDN.

39TH ST.

HARRISON

TAYLOR



STATE OF MICHIGAN
COUNTY OF BAY
CITY OF BAY CITY

James H. Gates
Clerk of the City of Bay

City, County and State aforesaid, Do hereby Certify, that I have compared the
original of the foregoing plat, and that it is a true and correct
transcript thereof and of the whole of such original.

Witness my hand and official seal this 18th day of October, 1964.

James H. Gates
Clerk of the City of Bay

Notary Public for the State of Michigan

My Commission Expires 12-31-65

Notary Public for the State of Michigan

My Commission Expires 12-31-65

STATE OF MICHIGAN
COUNTY OF BAY
Office of Register of Deeds

I, ERWIN M. NEARING, Register of Deeds
for said County, do hereby certify that I have carefully compared the
attached copy of a DEED with the
original record of the same in this office, in Liber 533 of
DEEDS on page 553, and that it is a true and
correct transcript of such record, and of the whole thereof.
Witness my hand and official seal this 21
day of OCTOBER, A. D. 19 64

Erwin M. Nearing
Register of Deeds

January 8, 1965

James H. Gates
City Clerk
Bay City, Michigan


RESOLUTION TO VACATE ALLEY, EDWARD INGRAM'S ADDITION
TO THE VILLAGE OF PORTSMOUTH, CITY OF BAY CITY, BAY
COUNTY, ADOPTED SEPTEMBER 28, 1964

In order to put our records, it will be necessary
that we have a sketch showing its location.

ALLISON GRICH
Acting Auditor General

By Amy Van Driessen

AVD/va

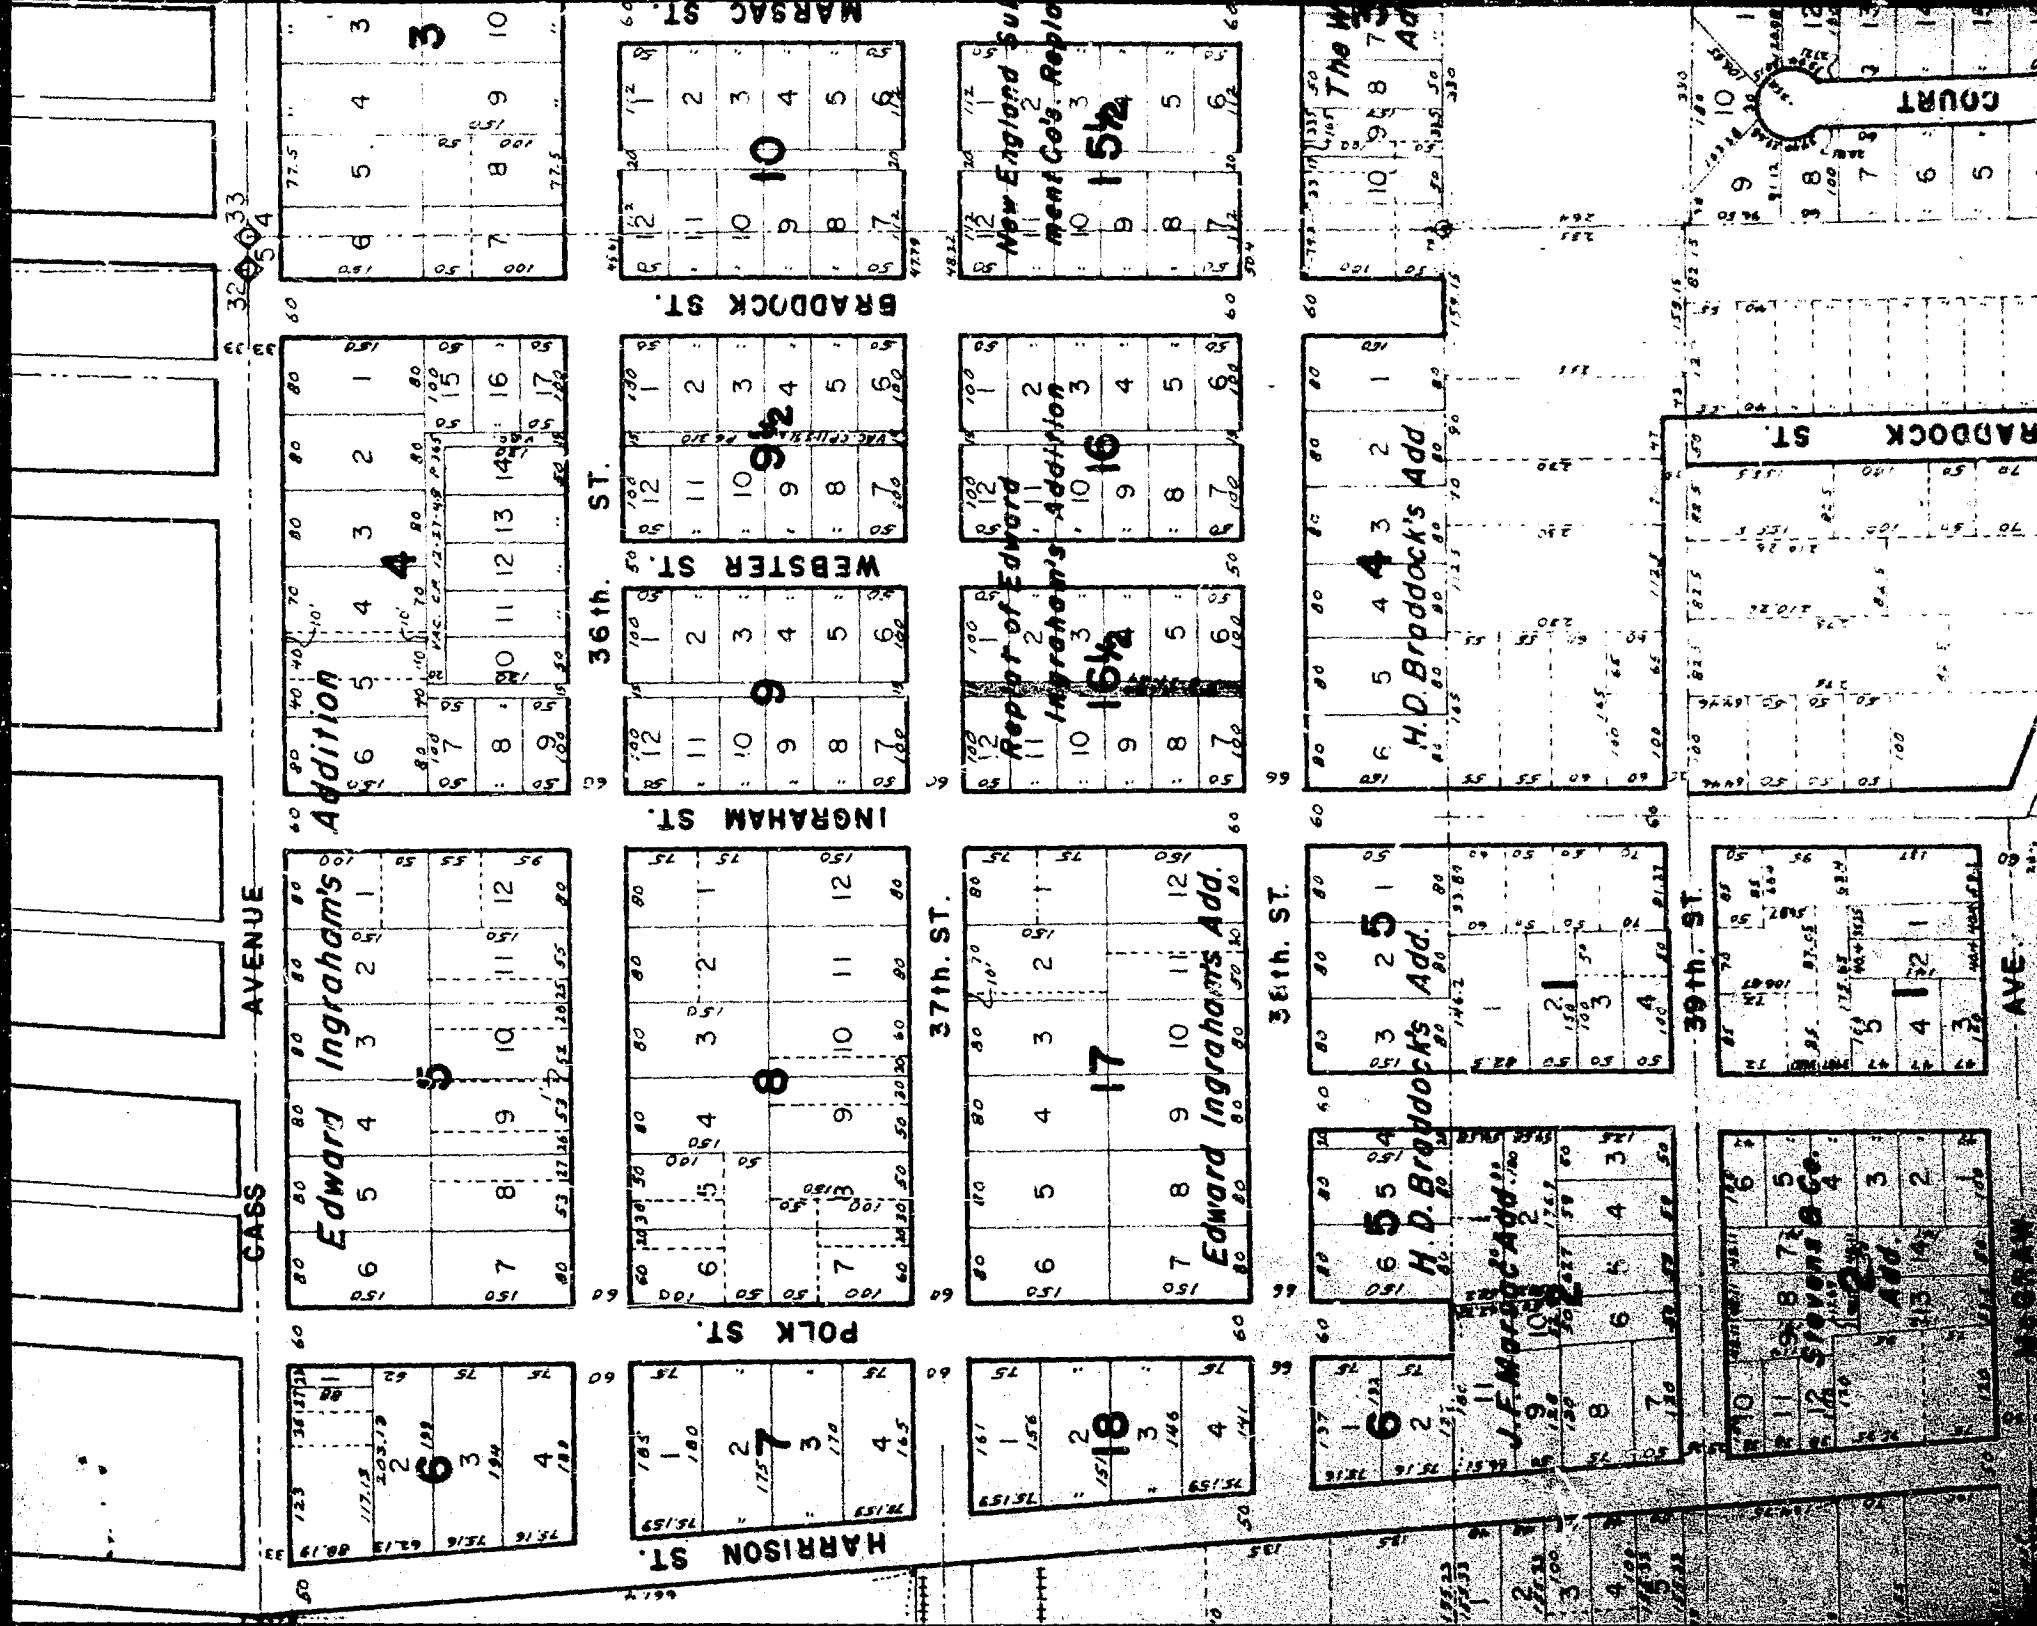

12324

CITY OF BAY CITY
BAY CITY, MICHIGAN 48706
Area Code 517 893.7511

May 5, 1980

Department of Treasury
Bureau of Local Government Services
2nd Floor, Treasury Building
Lansing, Michigan 48922

Gentlemen:

Pursuant to Section 256 of the new Subdivision Act of 267 (Public Act 288), we hereby submit a certified copy of the resolution vacating Braddock Street beginning at a point 170 ft. south of 38th Street to 39th Street. The street is located in H.D. Braddock's Addition.

A sketch from the Planning Office which identifies the area affected is also herewith attached.

Please be advised that we are supplying this documentation as information only as the street was never dedicated.

Yours very truly,
CITY OF BAY CITY
Walter Wozniak, Jr.
City Clerk
W:ve
enc.

CLB-3c

55-2228727: 0300-12324

CITY OF BAY CITY, MICH.
OFFICE OF CITY CLERK
(AFFIDAVIT)

STATE OF MICHIGAN
COUNTY OF BAY
CITY OF BAY CITY

I, Walter Wozniak, Jr., Clerk of the City of Bay City, County and State aforesaid, Do hereby Certify, that I have compared the annexed excerpt from the regular meeting of the City Commission held on April 14, 1980 with the original on file in this office and that it is a true and correct transcript therefrom and of the whole of such original.


In Witness Whereof, I have hereunto set my hand affixed the Corporate Seal of the City of Bay City, Mich., this 18th day of April 1980

Walter Wozniak, Jr.
City Clerk

Rules Suspended
Commissioner Kienbaum moved that rules be suspended to permit any interested persons in the audience to speak regarding the proposed street closing. There was no objection. No one appeared.
County Winters moved adoption of resolution.
Adopted by the following vote —
Yes, Commissioners Sullivan, VanDerwall, Snyder, Gielda, Tarkewski, Winters, Tush, Buda, Kienbaum, 9.
No, None.

SPECIAL ORDER
Of Commission as a Whole:
Whereas, the Planning Commission held a public hearing to consider vacating:
Braddock Street beginning at a point 170 ft. south of 38th Street to 39th Street
Whereas, the Planning Commission recommended that same be closed and vacated, and
Whereas, a Resolution was adopted by the City Commission on December 3rd, 1979, ordering publication of notices and the holding of a hearing, and notices published in the Bay City Democrat, the official newspaper of the City of Bay City, on March 20, 1980, March 27, 1980, April 3, 1980, and April 10, 1980, relative to the aforesaid hearing and certified notices thereof having been mailed to the public utilities and abutting property owners, and
Whereas, a public hearing was held by the City Commission on April 14, 1980, relative to the aforesaid petition for said vacation.
Now, Therefore, Be It Resolved And Ordered, by the City Commission that:
Braddock Street beginning at a point 170 ft. south of 38th Street to the north right-of-way line of 39th Street, if extended, be, and hereby is closed with utility easements being retained.

RECORDED
MAY 22 PM 3 09

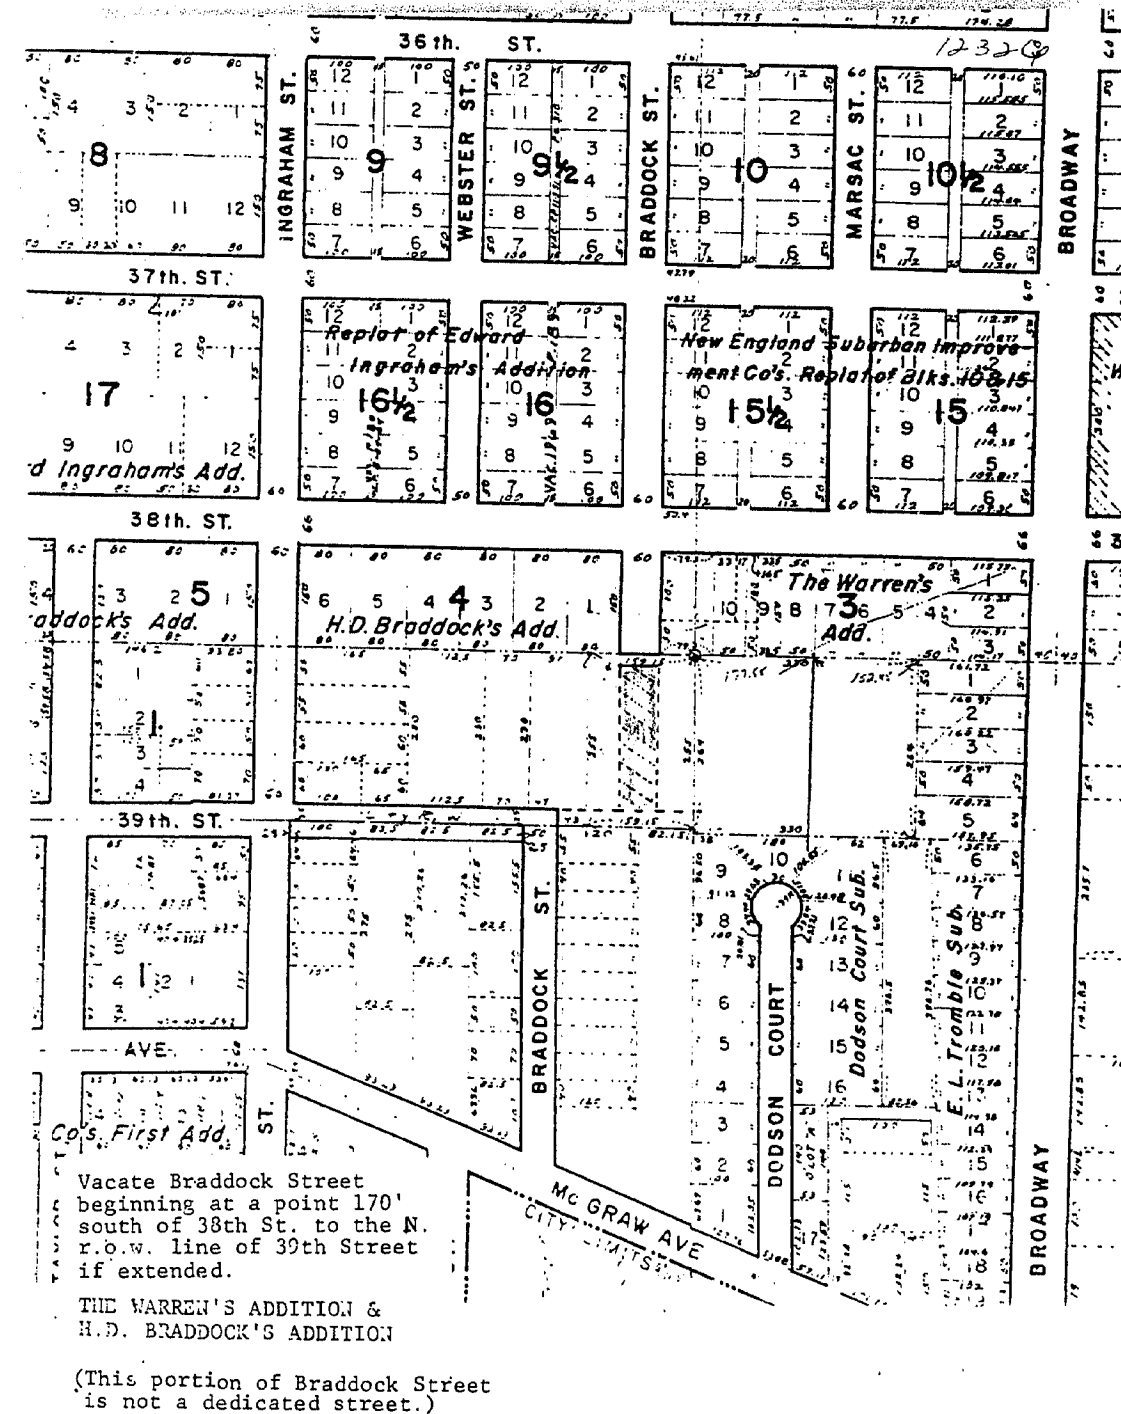

PLAT - F.W.WHEELER'S & CO'S THIRD ADDITION TO WEST BAY CITY
AND BAY CITY

In re petition)
of the West Bay City Sugar
Company A corporation
to have a portion
of plat vacated

C C Journal Liber J Page 612
File 8006
June 7-1899

ORDERED: That Blocks one, two, three, four, five, six, seven, and all of Block Eight, excepting lots one, two, three, four in said Block Five in F.C.Wheelers Third Addition to West Bay City be and the same is hereby vacated together with the Streets and alleys as laid out on said Plat between said Blocks so vacated-Description-Commencing at a point in the South line of Prairie Avenue, North 65 degrees and 10' degrees East 634.50 feet from the $\frac{1}{4}$ Section post of Range 5 East running thence North 73degrees 30' E along the South line of said Prairie Avenue, 1126 feet, Thence South parallel to the East line of Lot 3, of Section 15, aforesaid 205 feet, Thence North 80 degrees 30' East 146'10 feet, to the West line of the undivided Middle Third Part of said Lot 3, Thence South along said West line 291 feet to the right of way of C.S. & M R.R. Thence southwesterly along the right of way 1336 feet more or less to the West line of the plat of F.W.Wheeler's Third Addition Thence Northerly and parallel to the West line of said Lot 3-675.6 feet, to the Place or point of beginning-All of said land being in Section 15, T 14, N Range 5 E. in the County of Bay, State of Michigan.

Curts & Taylor
Plat Examiners

Vol 176- Page 14291

PLAT - EDWARD INGRAHAM'S ADDITION TO VILLAGE OF PORTSMOUTH CITY OF BAY CITY.


In re application)
of Chas G. Ingraham)
and Isabel J.)
Webster to vacate)
a part of the Plat)

C C Journal
Liber F Page 314
April 15-1884

ORDERED: That portion of the plat of Edward Ingraham's Addition to the Village of Portsmouth now a part of Bay City, Bay County, State of Michigan, according to the recorded plat of said Addition, of record in the office of the Register of Deeds of said Bay County hereinafter described be and the same is hereby VACATED. to wit:
Entire Block 1-2-11-12-13- Entire Block 14 Except Lots 7-8-9 of said Block 14
Entire Block 9, Entire Block 16, and Lots 7-8-9-10-11-12 of Block 4-It is further ordered that 10th Street as laid out and designated as said Plat of Edward Ingrahams, Addition also known as Stanton Street be and the same is hereby vacated.

Curts & Taylor
Plat Examiners

Vol 149- Page 12326

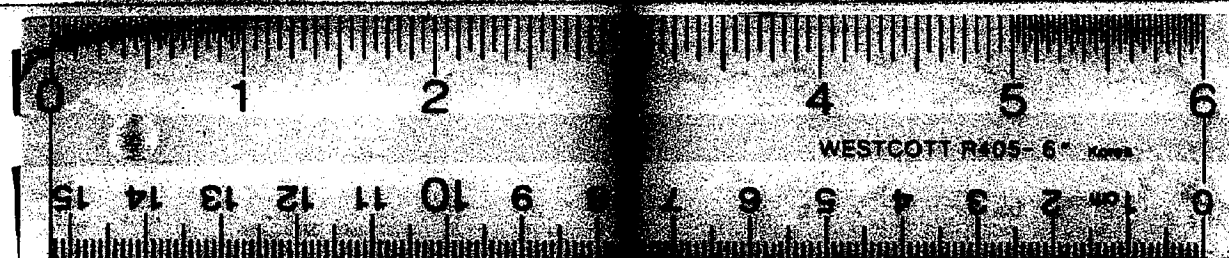

16 X