

Plat of the Village of
ATTANTAN
Montmorency County Michigan
Scale 500 feet to 1 inch Nov 17 30 E

3	25	35	45	
---	----	----	----	----	----	----	----	----	-----	-----	------	------	--

[illegible]


Day of June

acknowledged the hand to be from
M. M. Mason

16th day of July A.D. 1883
E. W. Wood

Alton, B. 3rd
Clark, and Van Rapt.

✓ PLAT--- VILLAGE OF ATLANTA

C C March 19-1895
C C J Page 97

In the matter of the petition)
of George J Crawford, Joseph
Remington, William J Croffron,
and Lewis A Irwin, to alter
and correct the Metes and boundaries
of the village Plat of the village
of Atlanta

Therefore on motion of James Francis, Attorney
for Petitioners, and after listening to all parties making objections thereto,
it is ordered, adjudged and determined, and I do hereby order, adjudge and de-
termine that the corrections and alterations in the boundaries of said village
of Atlanta as prayed for in the petition, be made in accordance with the terms
of said petition to wit;

That said boundaries as described in the original
platting of said village of Atlanta described as follows;


Beginning at a point, 515 feet due south of the center
of section 12 of T 30 N R 2 E, Thence west 1300 feet, Thence south 1412 feet-
Thence east 137 feet, Thence north 200 feet-Thence East 275 feet- Thence north
1112 feet- Thence west 353 feet-to place of beginning-to correctly read as
follows;

Beginning at a point 463 feet due south of the center
of section 12 T 30 N R 2 E Thence west 1163 6/10 feet to the north west corner
of the village -Thence south 28degrees 29 " west 1394 feet to the south west
corner of said village-Thence south 88 degrees 15' East 1378 feet- Thence north
28degrees 22" East 300 feet-Thence south 88 degrees 15 ' East 275 feet-
Thence north 28degrees 22 ' East 1094 feet to the north east corner of said
village-Thence north 88 degrees 15 ' west 489 4/10 feet to the place of be-
ginning and the same is hereby changed.

R J Kelly
Circuit Judge

Curtis & Taylor
Plat Examiners

Vol- 149- Page- 12333-

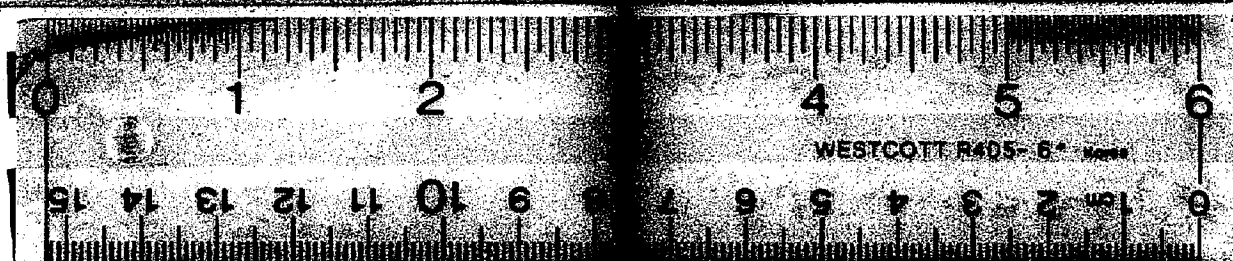

16 X