


of the **GEO. CLARK ESTATE SUB'N**

ECORCE, WAYNE CO. MICH. —

... ECORCE,

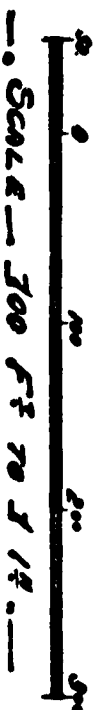

the presence of

Joseph F. Hughes
Edward H. Decker
Robert D. Cummings
Elizabeth A. Cummings


State of Michigan }
County of Wayne } ss.


RECEIVED
IN AUDITOR'S OFFICE,

May 16, 1904


1 This instrument was received for record this 20
 2 day of 1807, at
 3 o'clock P. M. and recorded in Liber, 1807, at
 4 of deeds, on page 27, as proper certificate Whereas
 5 furnished in compliance with Sect. 186, of Beaufort
 6 Bill No. 193 File 212, Act of 1890,

Sincerely,


[illegible]

Subⁿ of part of Lot 4

of the
GEO. CLARK ESTATE SUB^Y

Sec's 20 and 21 (T.3.5.F.11E) - ..

ECORCE,
WAYNE CO. MICH.

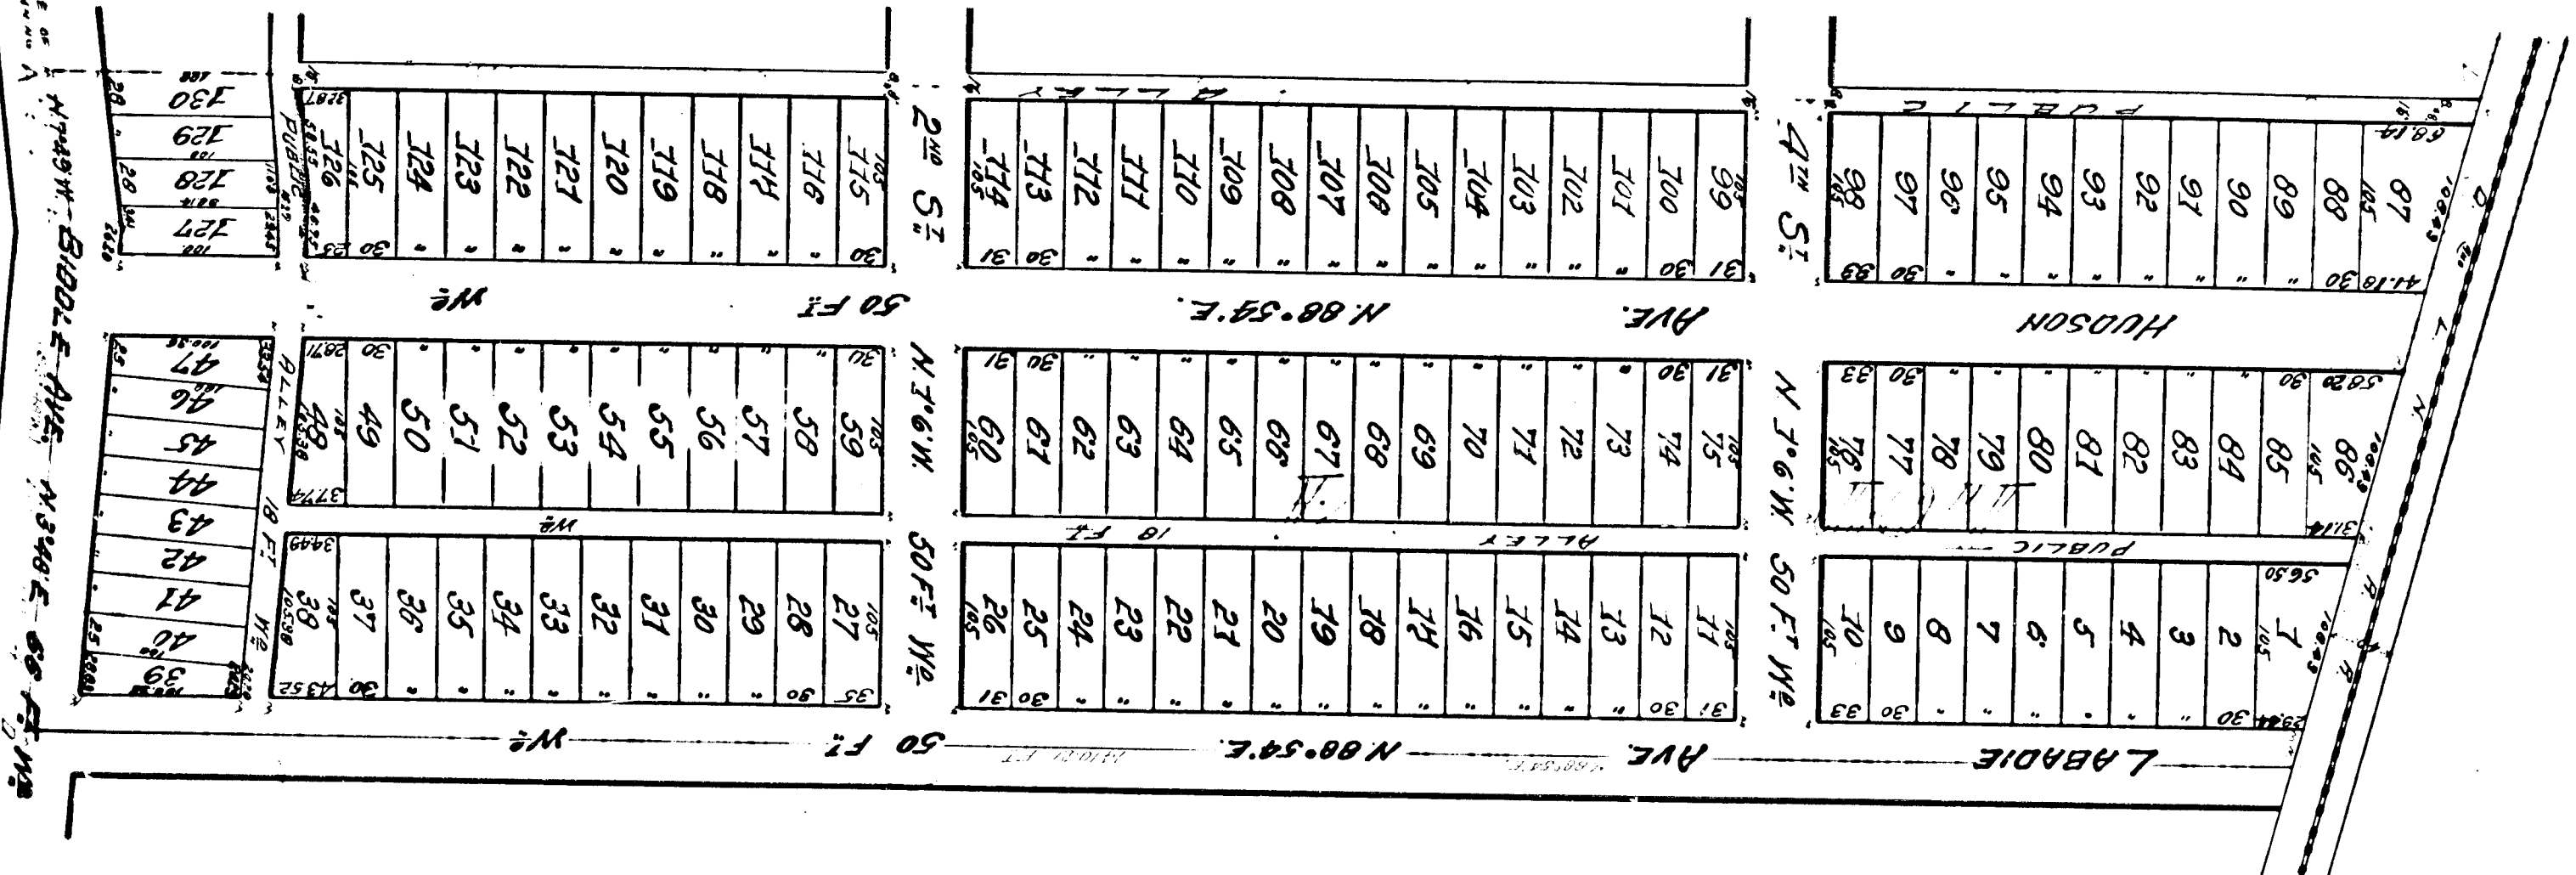

The presence of
Edward M. Prince
William O. Tipton

State of Michigan }
County of Ingham } ss.



State of Michigan }
County of Wayne } s.s.





RECEIVED
IN AUDITOR'S OFFICE,
March 16, 1904






RECORDED & INDEXED
CLERK OF DISTRICT COURT
JAN 26 1908

FILED HERE NO. 6-76-69

REGISTER OF DEEDS OFFICE } ss.
WAYNE COUNTY.

This instrument was received for record this
day of..... 1907 at
o'clock P.M. and recorded in Liber.....
of Record, on page..... as proper certificate was
forthwith in compliance with Sect 185, of Statute
Bill No. 199 Filed 212, Act of 1903.

[Signature]
Register of Deeds.

The following is a description of the land surveyed in the file 6:
Beginning at N. 1st the landward corner of Lot 4 of the "San Clark Cattle" on Dec 20th 1821 73.57 11 E. thence, by a bearing of "Middleton" and running thence S 88° 54' W along the dividing line of said lot 107940 feet to the boundary line of the "Beckwith & Co's Northern Railroad" 15th thence N. 13° 31' E. along said line of said railroad 159205 feet to a point C, thence N 88° 54' E. parallel with the dividing line of Lot 4 of said 107940 feet to the "starting line of 0th 1st Lot 42", thence S 30° 18' W along the leading line of said Lot 4 33030 feet to a point E, thence S 79° 42' E. 8741 feet to the place of beginning.


STATE OF MICHIGAN
County of Wayne,
City of Wyandotte

I, STANLEY RATYNSKI, City Clerk of the City of Wyandotte, in said

county and state, do hereby certify that the annexed is a true copy
of a resolution adopted by the City Council of the said City of Wyandotte,

dated, on the 14th day of May A.D. 1964

That I have compared the same with the original resolution on file in
my office, and that said copy is a full, true and correct transcript
therefrom and of the whole of said resolution.

In Witness Whereof I have hereunto set my
Hand and have caused the corporate seal
of the City of Wyandotte to be hereunto
affixed, this 5th day of May A.D. 1964.

Stanley Ratynski
City Clerk

WHEREAS, due notice has been given of the hearing on
objections to said vacation; and

WHEREAS, said hearing having taken place in accordance
with such notice, and no objections having been offered, and this
Council still being of the opinion that said vacation is
advisable; now, therefore,

BE IT RESOLVED that the above described eighteen (18)
foot wide and sixteen (16) foot wide parcels of land shall be and
the same are hereby respectively declared VACATED, DISCONTINUED
AND ABOLISHED as public alleys reserving to the City of Wyandotte,
a Municipal Corporation of the State of Michigan, its successors
and assigns forever and in perpetuity from the date hereof,
the respective right-of-way easements over, across, and within the
rights-of-way of the above described eighteen (18) foot wide and
sixteen (16) foot wide parcels of land for the purpose of constructing,
operating, maintaining and repairing existing and future public
utilities, sewers and drains; and that said City of Wyandotte, its
employees, agents, successors, assigns and lessees shall at all times
have free ingress to and egress from said respective eighteen (18)
foot wide and sixteen (16) foot wide parcels of land to construct,
operate, maintain and repair said existing and future utility lines
of every nature, and sewers and drains, as may be reasonable and
proper in that behalf.

I move the adoption of the foregoing resolution.

Councilman Sam Palamara

Supported by Councilman Stanley Groat

YEAS	COUNCILMEN	NAYS
☒	Clack	
☒	Groat	
☒	McCauley	
☒	Palamara	
☒	Smith	
☒	Sullivan	

ABSENT: None

RESOLUTION

Wyandotte, Michigan
May 4, 1964

RESOLUTION by Councilman Sam Palamara

At a regular session of the City Council of the City of
Wyandotte.

RESOLVED BY THE CITY COUNCIL OF THE CITY OF WYANDOTTE.

WHEREAS, this Council by resolution has deemed it advisable
and necessary for the health, welfare, comfort and safety of the
people of the City of Wyandotte, to vacate, discontinue, and
abolish the hereinafter described lands in the City of Wyandotte,
County of Wayne, State of Michigan, as public alleys, more
particularly described as:

That part of the (18) eighteen foot wide alley
adjoining lots 127 to 130 inclusive, Hudson's
Sub'n. of part of lot 4 of the George Clark Estate
Subdivision, Sec. 20 and 21, Town 3 South, Range
11 East, Ecorse Township (now the City of Wyandotte),
Wayne County, Michigan (Recorded in Liber 22,
Page 23, Wayne County Records), more particularly
described as follows: Beginning at the southwest
corner of lot 130 of said subdivision; thence
North 70°49'00" West 60.62 ft.; thence North 10°
23'40" West 52.79 ft.; thence along the south side
of Hudson Avenue (50 ft. wide) North 88°54'00"
West 10.92 ft.; thence south 10°10'0" East 105.0 ft.
to the Southeast corner of lot 126; thence southeasterly
to the point of beginning;

The (16) sixteen foot wide alley between Clark Street
and Hudson Avenue, from Second Street to the alley
West of Biddle Avenue, more particularly described as
the alley lying North of and abutting part of lot 8 and
all of lots 9 to 22 inclusive, "The Albail Subdivision"
of a part of a tract of land belonging to the Estate
of George Clark deceased, east of the D. L. & M. R. R.,
and west of Biddle Avenue, also lying South of and
abutting lots 115 to 126 inclusive, Hudson's Sub'n.
of part of lot 4 of the Geo. Clark Estate Sub'n.,
Sections 20 and 21, Town 3 South, Range 11 East,
Ecorse Township (now the City of Wyandotte), Wayne
County, Michigan.

and

July 7, 1964

Stanley Ratynski
City Clerk
Wyandotte, Mich.

RESOLUTION TO VACATE TWO PUBLIC ALLEYS IN THE CITY OF WYANDOTTE,
ADOPTED MAY 4, 1964

"...That part of the eighteen foot wide alley adjoining
lots 127 to 130 inclusive, Hudson's Subdivision of part of
lot 4 of the George Clark Estate Subdivision."

"...The sixteen foot wide alley between Clark Street and
Hudson Avenue, from Second Street to the alley west of
Biddle Avenue."

In order to post our records, it will be necessary that we
have a sketch showing their location.

BILLIE S. FARNUM
Auditor General

By
Richard E. Lomax

File
Jla



STATE OF MICHIGAN,
County of Wayne,
City of Wyandotte

I, STANLEY RATYNSKI, City Clerk of the City of Wyandotte, in said

county and state, do hereby certify that the annexed is a true copy
of a resolution adopted by the City Council of the said City of Wyandotte,
date, on the 14th day of May AD 1964

That I have compared the same with the original resolution on file in
my office, and that said copy is a full, true and correct transcript
therefrom and of the whole of said resolution.

In Witness Whereof I have hereunto set my
Hand and have caused the corporate seal
of the City of Wyandotte to be hereunto
affixed, this 5th day of May AD 1964.

Stanley Ratynski
City Clerk.

WHEREAS, due notice has been given of the hearing on
objections to said vacation; and

WHEREAS, said hearing having taken place in accordance
with such notice, and no objections having been offered, and this
Council still being of the opinion that said vacation is
advisable; now, therefore,

BE IT RESOLVED that the above described eighteen (18)
foot wide and sixteen (16) foot wide parcels of land shall be and
the same are hereby respectively declared VACATED, DISCONTINUED
AND ABOLISHED as public alleys reserving to the City of Wyandotte,
a Municipal Corporation of the State of Michigan, its successors
and assigns forever and in perpetuity from the date hereof,
the respective right-of-way easements over, across, and within the
rights-of-way of the above described eighteen (18) foot wide and
sixteen (16) foot wide parcels of land for the purpose of constructing,
operating, maintaining and repairing existing and future public
utilities, sewers and drains; and that said City of Wyandotte, its
employees, agents, successors, assigns and lessees shall at all times
have free ingress to and egress from said respective eighteen (18)
foot wide and sixteen (16) foot wide parcels of land to construct,
operate, maintain and repair said existing and future utility lines
of every nature, and sewers and drains, as may be reasonable and
proper in that behalf.

I move the adoption of the foregoing resolution.

Councilman Sam Palamara

Supported by Councilman Stanley Groat

YEAS	COUNCILMEN	NAYS
☒	Clark	
☒	Groat	
☒	McCauley	
☒	Palamara	
☒	Smith	
☒	Sullivan	
	ABSENT:	None

RESOLUTION

Wyandotte, Michigan
May 4, 1964

RESOLUTION by Councilman Sam Palamara
At a regular session of the City Council of the City of
Wyandotte.

RESOLVED BY THE CITY COUNCIL OF THE CITY OF WYANDOTTE.

WHEREAS, this Council by resolution has deemed it advisable
and necessary for the health, welfare, comfort and safety of the
people of the City of Wyandotte, to vacate, discontinue, and
abolish the hereinafter described lands in the City of Wyandotte,
County of Wayne, State of Michigan, as public alleys, more
particularly described as:

That part of the (18) eighteen foot wide alley
adjoining lots 127 to 130 inclusive, Hudson's
Sub'n. of part of Lot 4 of the George Clark Estate
Subdivision, Sec. 20 and 21, Town 3 South, Range
11 East, Ecorse Township (now the City of Wyandotte),
Wayne County, Michigan (Recorded in Liber 22,
Page 23, Wayne County Records), more particularly
described as follows: Beginning at the southwest
corner of Lot 130 of said subdivision; thence
North 79°49'00" West 60.62 ft.; thence North 10°
23' 40" West 52.79 ft.; thence along the south side
of Hudson Avenue (50 ft. wide) North 88°54'00"
West 10.92 ft.; thence south 19°10' East 105.0 ft.
to the southeast corner of Lot 126; thence southeasterly
to the point of beginning;

The (16) sixteen foot wide alley between Clark Street
and Hudson Avenue, from Second Street to the alley
West of Biddle Avenue, more particularly described as
the alley lying North of and abutting part of Lot 8 and
all of Lots 9 to 22 inclusive, "The Alkali Subdivision"
of a part of a tract of land belonging to the Estate
of George Clark deceased, east of the D. L. & N. R. R.,
and west of Biddle Avenue, also lying South of and
abutting Lots 115 to 126 inclusive, Hudson's Sub'n.
of part of Lot 4 of the Geo. Clark Estate Sub'n.,
Sections 20 and 21, Town 3 South, Range 11 East,
Ecorse Township (now the City of Wyandotte), Wayne
County, Michigan.

and

July 7, 1964

Stanley Ratynski
City Clerk
Wyandotte, Mich.

RESOLUTION TO VACATE TWO PUBLIC ALLEYS IN THE CITY OF WYANDOTTE,
ADOPTED MAY 4, 1964

"...That part of the eighteen foot wide alley adjoining
lots 127 to 130 inclusive, Hudson's Subdivision of part of
Lot 4 of the George Clark Estate Subdivision."

"...The sixteen foot wide alley between Clark Street and
Hudson Avenue, from Second Street to the alley west of
Biddle Avenue."

In order to post our records, it will be necessary that we
have a sketch showing their location.

BILLIE S. FARMUM
Auditor General

By
Richard E. Lomax

File
jla

CERTIFICATE

I, Stanley Ratynski, City Clerk of the City of Wyandotte, Michigan, do hereby certify that on May 4, 1964, the City Council of the City of Wyandotte, adopted a Resolution, a certified copy of which is attached hereto, vacating two public alleys in the City of Wyandotte, County of Wayne, State of Michigan, said alleys being more particularly described as:

That part of the (16) sixteen foot wide alley adjoining lots 127 to 130 inclusive, Hudson's Sub'n of part of Lot 4 of the George Clark Estate Subdivision, Sec. 20 and 21, Town 3 South, Range 11 East, Ecorse Township (now the City of Wyandotte), Wayne County, Michigan, (Recorded in Liber 22, Page 23, Wayne County Records), more particularly described as follows: Beginning at the southwest corner of Lot 130 of said subdivision; thence North 79°49'00" West 60.62 ft.; thence North 10°23'40" West 52.79 ft.; thence along the south side of Hudson Avenue (50 ft. wide) North 88°54'00" West 10.92 ft.; thence south 1°6'0" East 105.0 ft. to the southeast corner of Lot 126; thence southeasterly to the point of beginning;

The (16) sixteen foot wide alley between Clark Street and Hudson Avenue, from Second Street to the alley west of Biddle Avenue, more particularly described as the alley lying North of and abutting part of Lot 8 and all of lots 9 to 22 inclusive, "The Albani Subdivision" of a part of a tract of land belonging to the Estate of George Clark deceased, east of the D. L. & M. R. R., and west of Biddle Avenue, also lying South of and abutting lots 115 to 126 inclusive, Hudson's Sub'n of part of Lot 4 of the Geo. Clark Estate Sub'n, Sections 20 and 21, Town 3 South, Range 11 East, Ecorse Township (now the City of Wyandotte), Wayne County, Michigan.

I do further certify that the name or names of any plat, subdivision or addition in said City affected by such Resolution are as follows:

Hudson's Subdivision of part of Lot 4 of the George Clark Estate Subdivision, Sections 20 and 21, Town 3 South, Range 11 East, Ecorse, Wayne County, Michigan, according to the plat thereof as recorded in Liber 22, Page 23 of Plats, WayneCounty Records;

The Albani Subdivision of part of a tract of land belonging to the Estate of George Clark, deceased, East of the Detroit, Lima and Northern Railroad, and west of Biddle Avenue, according to the plat thereof as recorded in Liber 22 of Plats, at page 22, said Wayne County Records.

Dated: May 5, 1964.

Stanley Ratynski
Stanley Ratynski
City Clerk

STATE OF MICHIGAN)
COUNTY OF WAYNE) ss.

On this Sunday of May, 1964, before me, a Notary Public in and for said County, personally came Stanley Ratynski, known to me to be the person described in and who executed the foregoing certificate, and being by me first duly sworn, did depose and say that he is the duly elected City Clerk of the City of Wyandotte, Michigan, and that the foregoing certificate is true of his own knowledge, and acknowledged that he executed the same for the intents and purposes therein set forth.

Stanley Ratynski
Notary Public, Wayne County, Michigan
My commission expires: May 19-1966

City of Wyandotte
Michigan

JAMES DEBANA, Mayor

OFFICIALS
STANLEY RATYNSKI, City Clerk
LOUIS E. BROHL, JR., City Treasurer
ERNEST B. CITY JARROLD, City Assessor
A. LOUIS GINGRAS, City Attorney

May 5, 1964

COUNCILMEN
CLIFFORD E. CLARK
STANLEY GROUT
JOHN E. MCGAULEY
SAM A. PALANARA
BERNARD C. SMITH
WILLIAM BULLIVAN

The Honorable Billie S. Parnum
State of Michigan Auditor General,
The Capitol,
Lansing, Michigan

Dear Sir:

We are enclosing one Certificate and one certified copy of a Resolution concerning the vacating of two public alleys in the City of Wyandotte, County of Wayne, State of Michigan, to wit:

That part of the (16) sixteen foot wide alley adjoining lots 127 to 130 inclusive, Hudson's Subdivision of part of Lot 4 of the George Clark Estate Subdivision (complete description in the enclosed Certificate and Resolution)

and

The (16) sixteen foot wide alley between Clark Street and Hudson Avenue, from Second Street to the alley west of Biddle Avenue (complete description in the enclosed Certificate and Resolution.)

Thank you.

Sincerely yours,
Stanley Ratynski
Stanley Ratynski
City Clerk

AUDITOR GENERAL DEPARTMENT
RECEIVED
MAY 6 1964
LANSING, MICHIGAN

SR:st

CERTIFICATE

I, Stanley Ratynski, City Clerk of the City of Wyandotte, Michigan, do hereby certify that on May 4, 1964, the City Council of the City of Wyandotte, adopted a Resolution, a certified copy of which is attached hereto, vacating two public alleys in the City of Wyandotte, County of Wayne, State of Michigan, said alleys being more particularly described as:

That part of the (18) eighteen foot wide alley adjoining lots 127 to 130 inclusive, Hudson's Sub'n of part of Lot 4 of the George Clark Estate Subdivision, Sec. 20 and 21, Town 3 South, Range 11 East, Ecorse Township (now the City of Wyandotte), Wayne County, Michigan, (Recorded in Liber 22, Page 23, Wayne County Records), more particularly described as follows: Beginning at the Southwest corner of Lot 130 of said subdivision; thence North 79°49'00" West 60.62 ft.; thence North 10°23'40" West 52.79 ft.; thence along the south side of Hudson Avenue (50 ft. wide) North 88°54'00" West 10.92 ft.; thence south 1°6'0" East 105.0 ft. to the southeast corner of Lot 126; thence southeasterly to the point of beginning;

The (16) sixteen foot wide alley between Clark Street and Hudson Avenue, from Second Street to the alley West of Biddle Avenue, more particularly described as the alley lying North of and abutting part of Lot 8 and all of lots 9 to 22 inclusive, "The Alkali Subdivision" of a part of a tract of land belonging to the Estate of George Clark deceased, east of the D. L. & W. R. R., and west of Biddle Avenue, also lying South of and abutting lots 115 to 126 inclusive, Hudson's Sub'n of part of Lot 4 of the Geo. Clark Estate Sub'n, Sections 20 and 21, Town 3 South, Range 11 East, Ecorse Township (now the City of Wyandotte), Wayne County, Michigan.

I do further certify that the name or names of any plat, subdivision or addition in said City affected by such Resolution are as follows:

Hudson's Subdivision of part of Lot 4 of the George Clark Estate Subdivision, Sections 20 and 21, Town 3 South, Range 11 East, Ecorse, Wayne County, Michigan, according to the plat thereof as recorded in Liber 22, Page 23 of Plats, WayneCounty Records;

The Alkali Subdivision of part of a tract of land belonging to the Estate of George Clark, deceased, East of the Detroit, Lima and Northern Railroad, and west of Biddle Avenue, according to the plat thereof as recorded in Liber 22 of Plats, at page 22, said Wayne County Records.

Dated: May 5, 1964.

Stanley Ratynski
Stanley Ratynski
City Clerk

STATE OF MICHIGAN) ss.
COUNTY OF WAYNE)

On this Sunday of May, 1964, before me, a Notary Public in and for said County, personally came Stanley Ratynski, known to me to be the person described in and who executed the foregoing certificate, and being by me first duly sworn, did depose and say that he is the duly elected City Clerk of the City of Wyandotte, Michigan, and that the foregoing certificate is true of his own knowledge, and acknowledged that he executed the same for the intents and purposes therein set forth.

Stanley Ratynski
Notary Public, Wayne County, Michigan
My commission expires: May 19-1966

City of Wyandotte
Michigan

JAMES DEAN, Mayor

OFFICIALS
STANLEY RATYNSKI
CITY CLERK
LOUIS E. BROTH
CITY TREASURER
ERNEST B. SCHULTZ
CITY ATTORNEY
A. LOUIS GINGRAS
CITY ATTORNEY

May 5, 1964

COUNCILMEN
CLIFFORD E. CLARK
STANLEY GONIN
JOHN E. MCKELLY
EDNA B. MCKELLY
BERNARD C. SMITH
WILLIAM SULLIVAN

The Honorable Billie S. Farnum
State of Michigan Auditor General,
The Capitol,
Lansing, Michigan

Dear Sir:

We are enclosing one Certificate and one certified copy of a Resolution concerning the vacating of two public alleys in the City of Wyandotte, County of Wayne, State of Michigan, to wit:

That part of the (18) eighteen foot wide alley adjoining lots 127 to 130 inclusive, Hudson's Subdivision of part of Lot 4 of the George Clark Estate Subdivision (complete description in the enclosed Certificate and Resolution)

and



The (16) sixteen foot wide alley between Clark Street and Hudson Avenue, from Second Street to the alley west of Biddle Avenue (complete description in the enclosed Certificate and Resolution.)

Thank you.

Sincerely yours,
Stanley Ratynski
Stanley Ratynski
City Clerk

SR: sr

AUDITOR GENERAL DEPARTMENT
RECEIVED
MAY 6 1964
LANSING, MICHIGAN

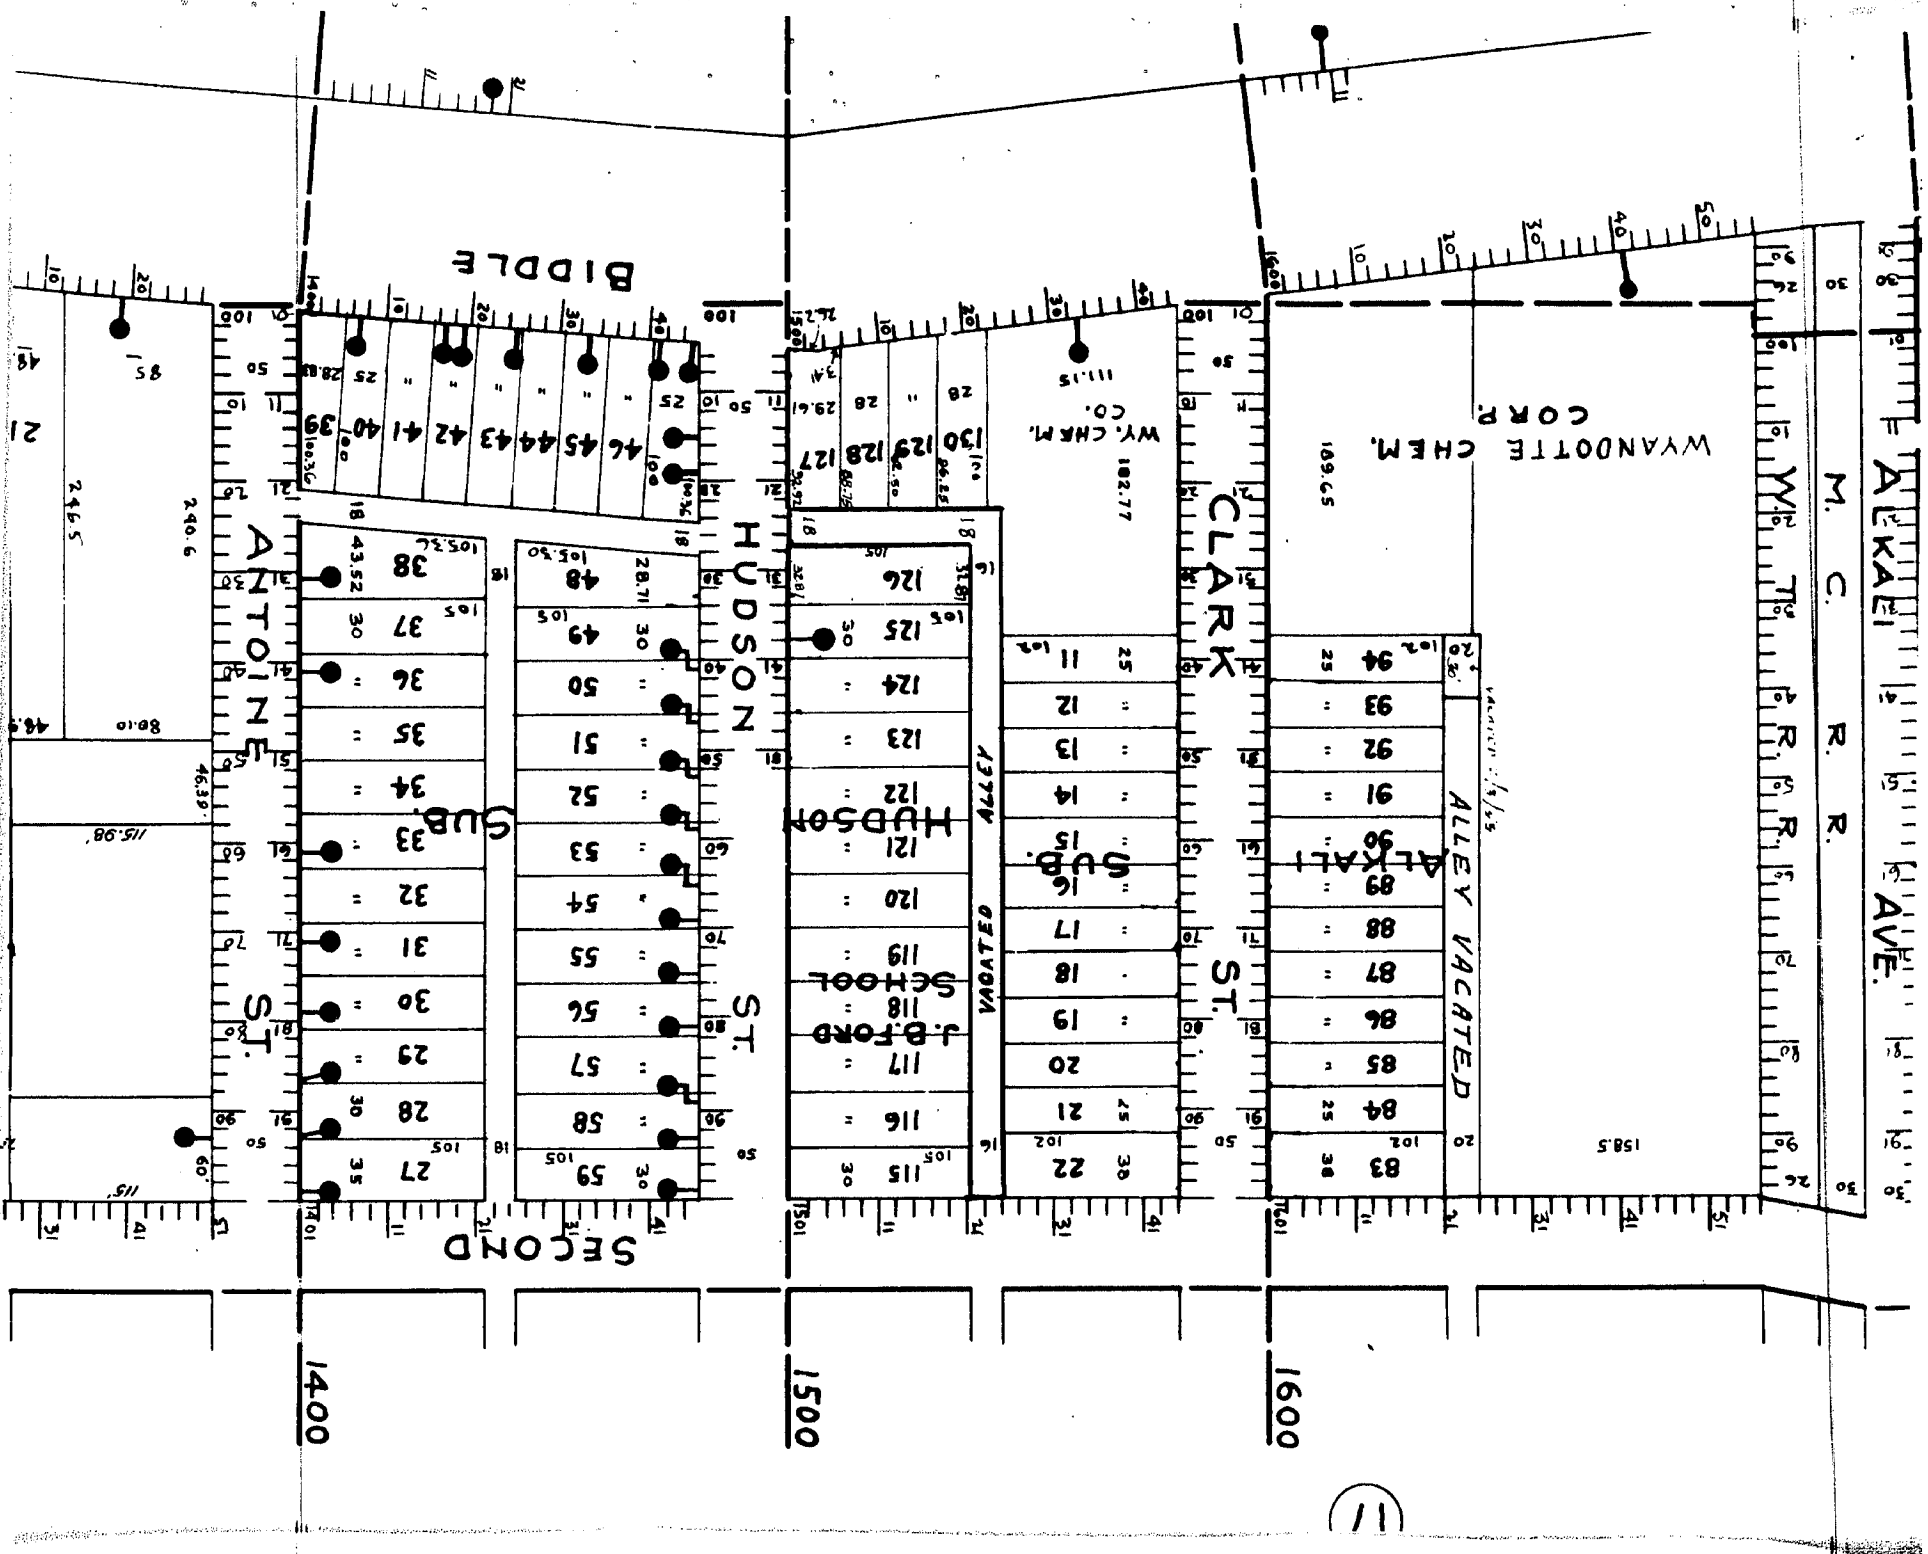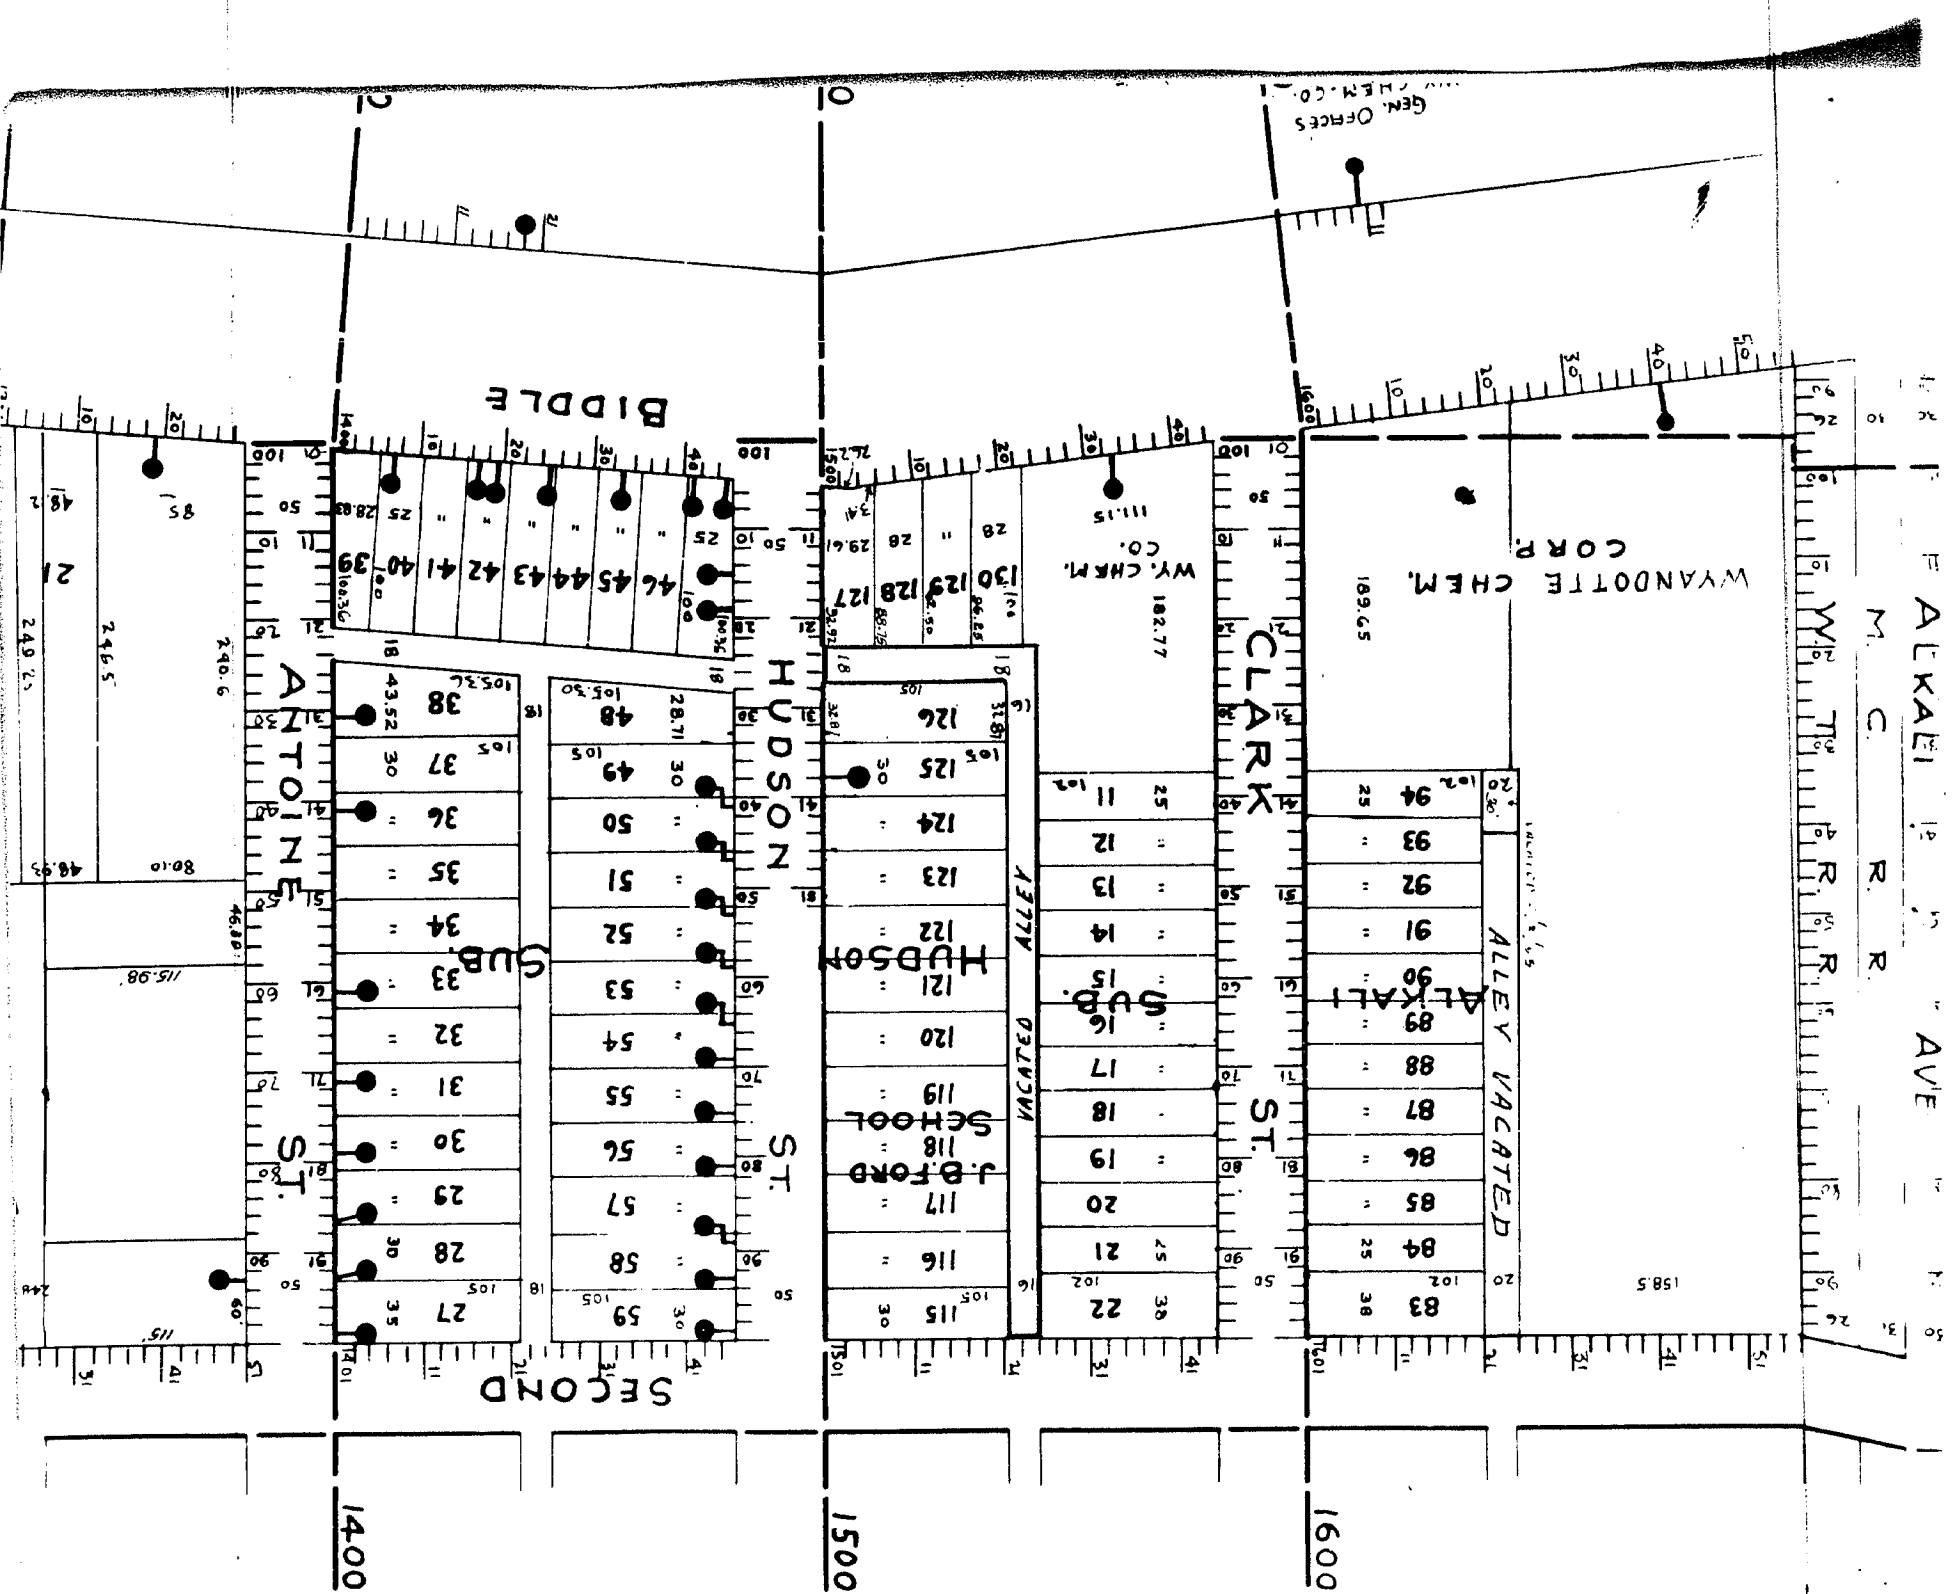

STATE OF MICHIGAN
OFFICE OF
BILLIE S. FARNUM
AUDITOR GENERAL
LANSING

WILLIAM A. BURGESS
Deputy

AUDITOR GENERAL DEPARTMENT
RECEIVED
JUL 14 1964
LANSING, MICHIGAN

July 7, 1964

Stanley Ralynski
City Clerk
Wyandotte, Mich.

RESOLUTION TO VACATE TWO PUBLIC ALLEYS IN THE CITY OF WYANDOTTE,
ADOPTED MAY 4, 1964

"...That part of the eighteen foot wide alley adjoining
lots 127 to 130 inclusive, Hudson's Subdivision of part of
lot 4 of the George Clark Estate Subdivision."

"...The sixteen foot wide alley between Clark Street and
Hudson Avenue, from Second Street to the alley west of
Biddle Avenue."

In order to post our records, it will be necessary that we
have a sketch showing their location.

BILLIE S. FARNUM
Auditor General



By *Richard E. Lomax*
Richard E. Lomax

File
jla
July 13, 1964





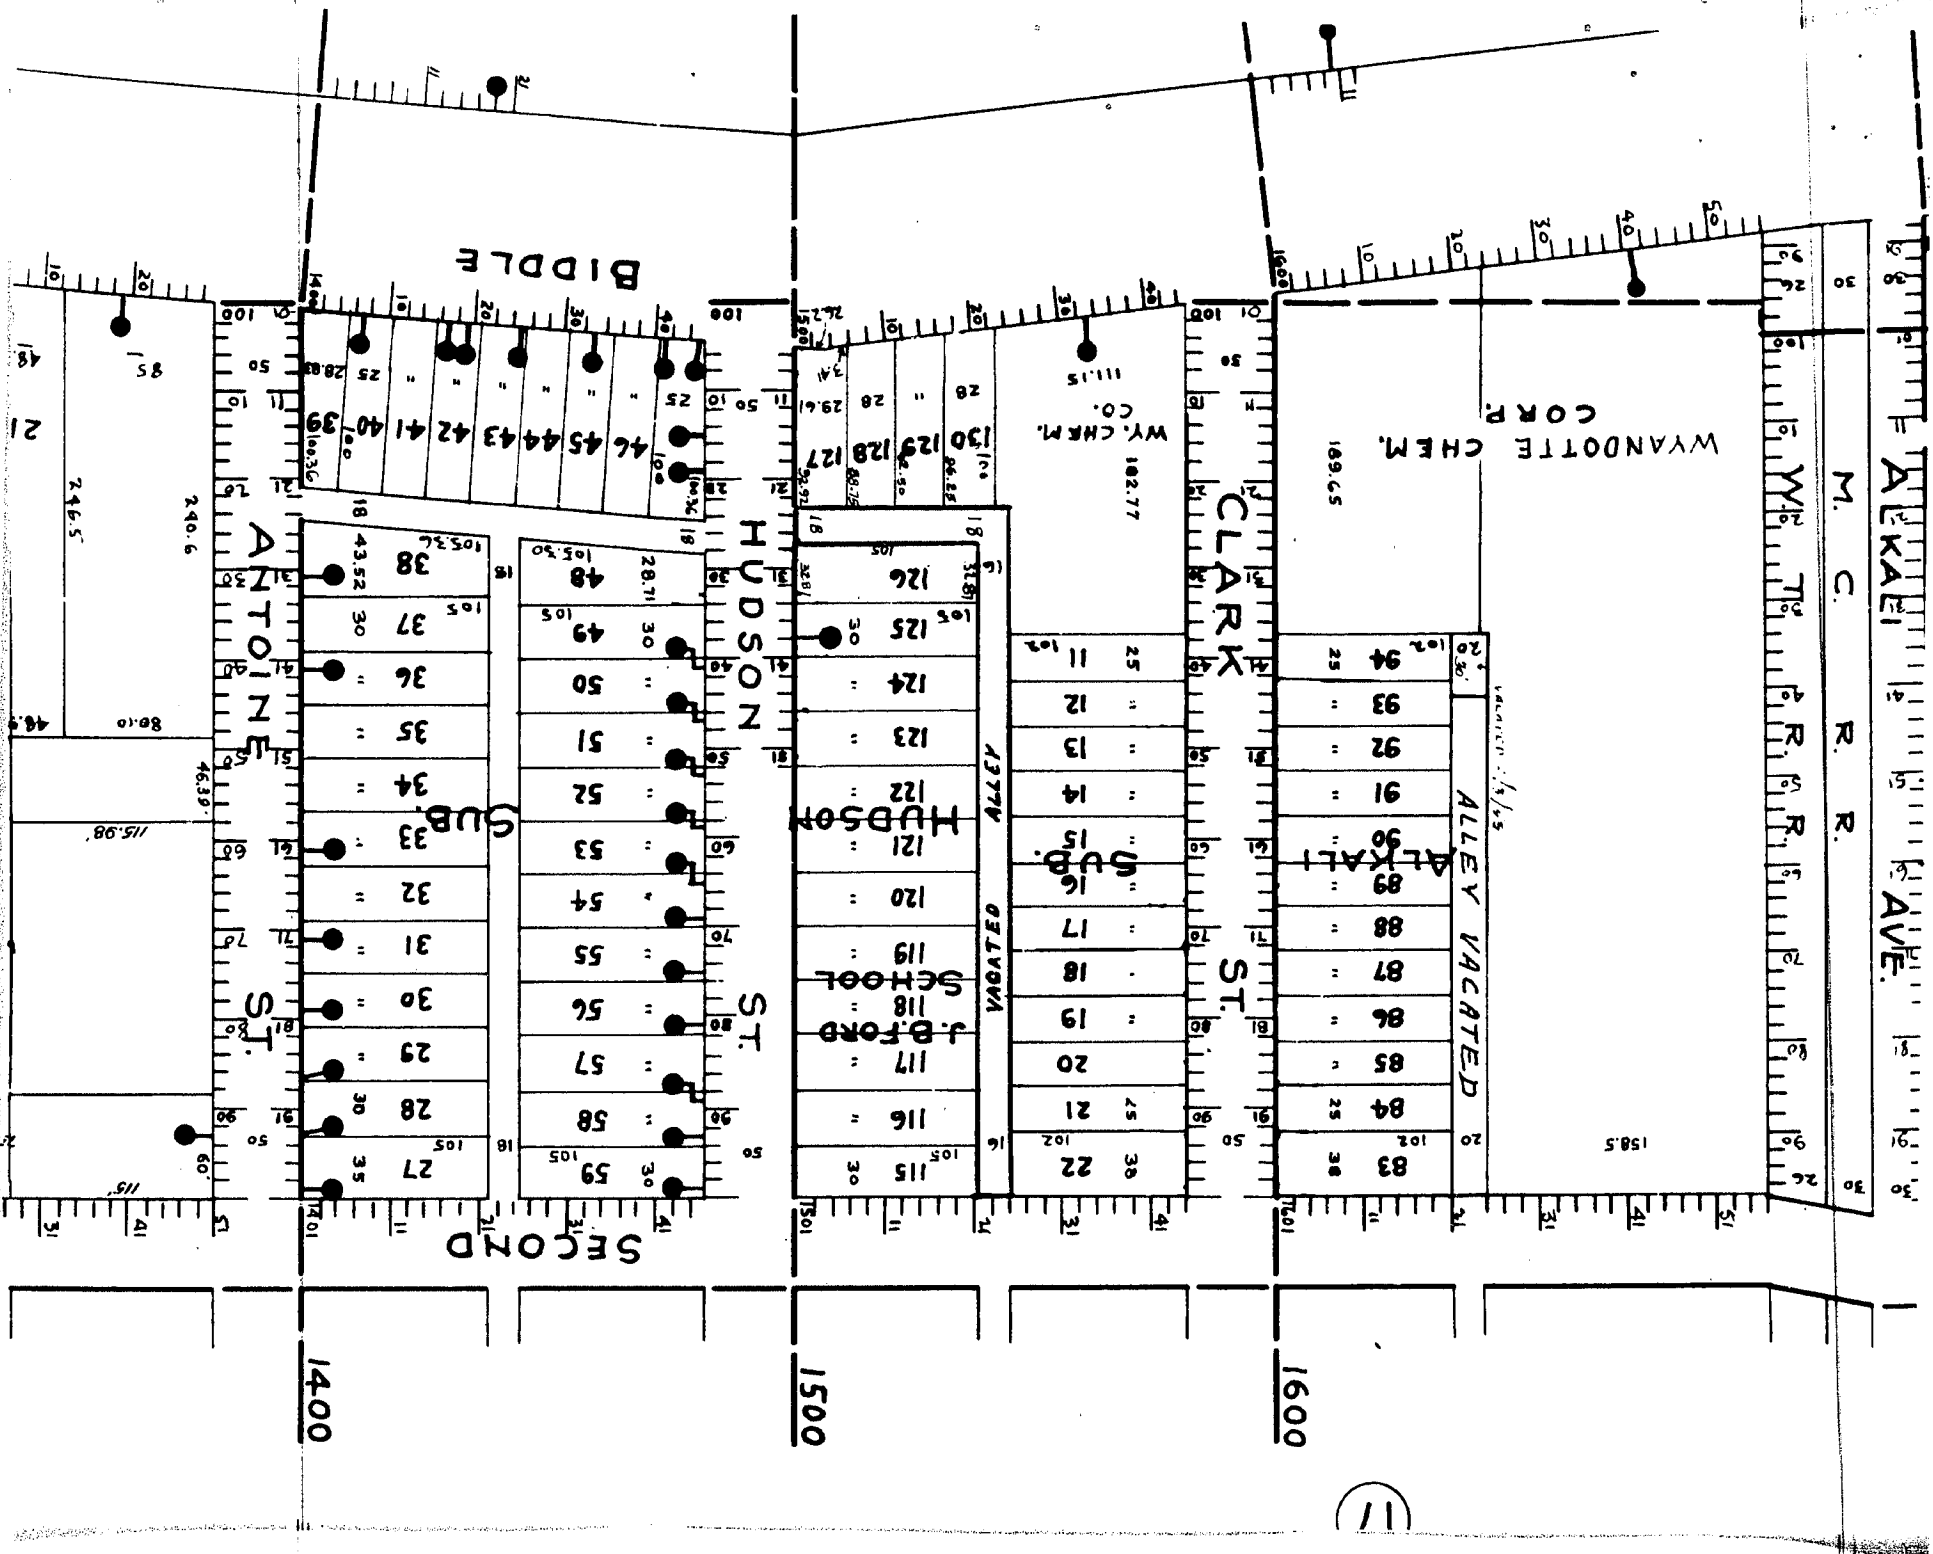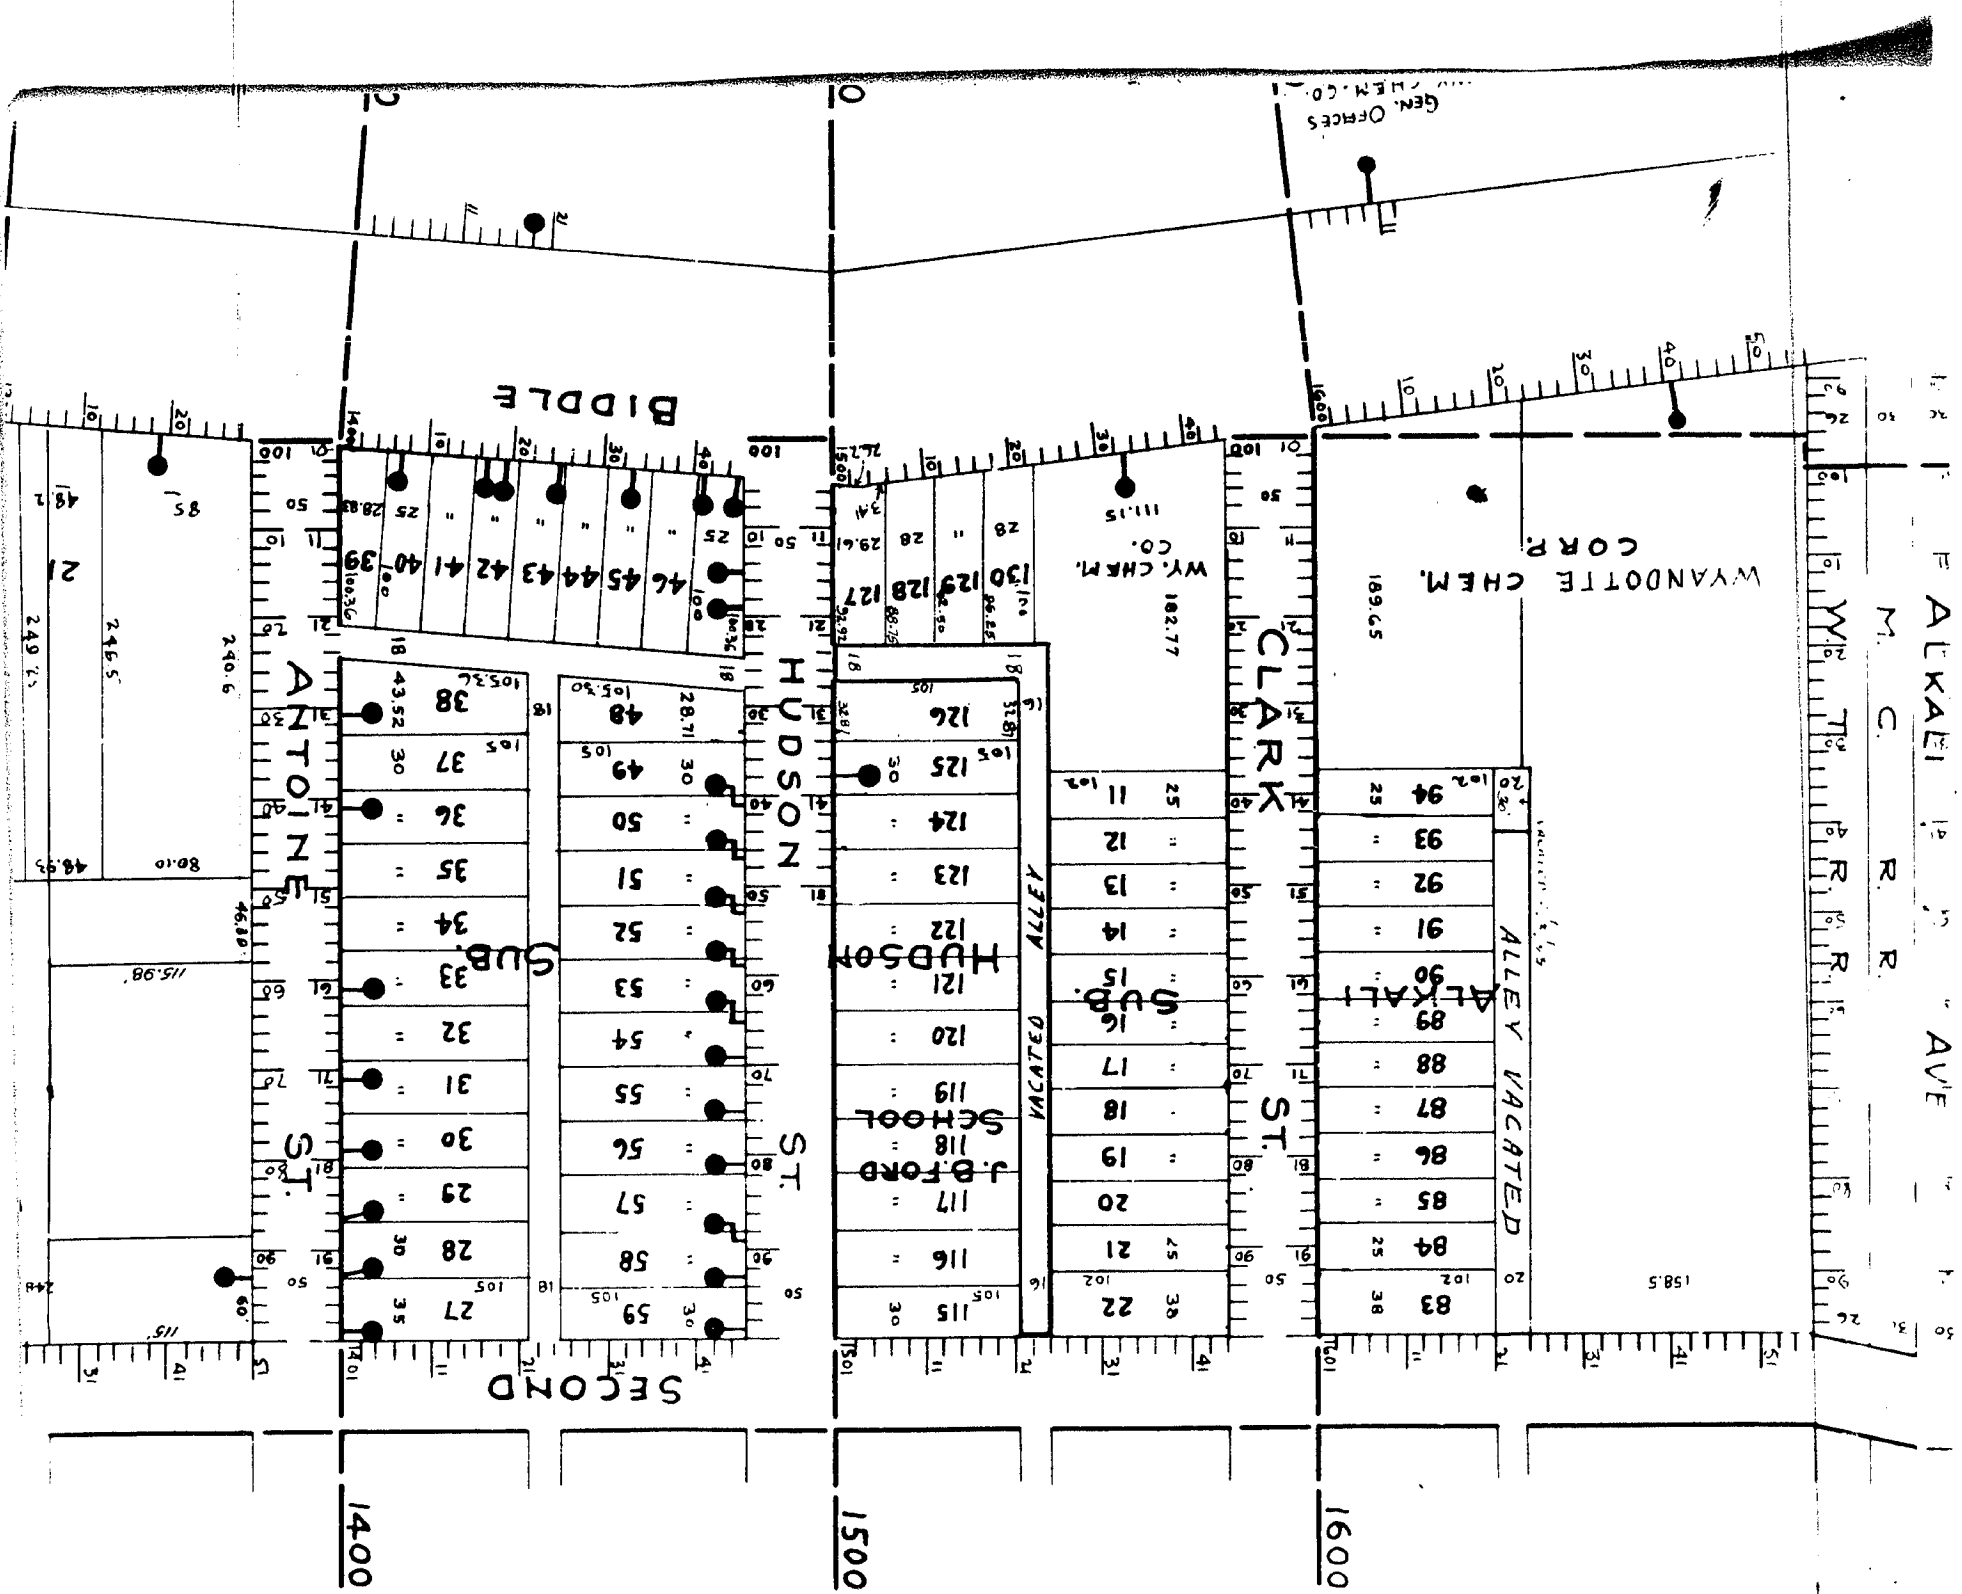

STATE OF MICHIGAN
OFFICE OF
BILLIE S. FARNUM
AUDITOR GENERAL
LANSING

WILLIAM A. BURGESS
Deputy

AUDITOR GENERAL DEPARTMENT
RECEIVED
JUL 14 1964
LANSING, MICHIGAN

July 7, 1964

Stanley Ratynski
City Clerk
Wyandotte, Mich.

RESOLUTION TO VACATE TWO PUBLIC ALLEYS IN THE CITY OF WYANDOTTE,
ADOPTED MAY 4, 1964

"...That part of the eighteen foot wide alley adjoining
lots 127 to 130 inclusive, Hudson's Subdivision of part of
Lot 4 of the George Clark Estate Subdivision."

"...The sixteen foot wide alley between Clark Street and
Hudson Avenue, from Second Street to the alley west of
Biddle Avenue."

In order to post our records, it will be necessary that we
have a sketch showing their location.

BILLIE S. FARNUM
Auditor General

By *Richard E. Lomax*
Richard E. Lomax

July 13, 1964

File
jla

Dear Mr. Smith:

*We enclose the
sketches that you have requested.*

*Sincerely,
Stanley Ratynski
City Clerk*



MICHIGAN
WATER
WORKS
AND
SEWER
DEPARTMENT