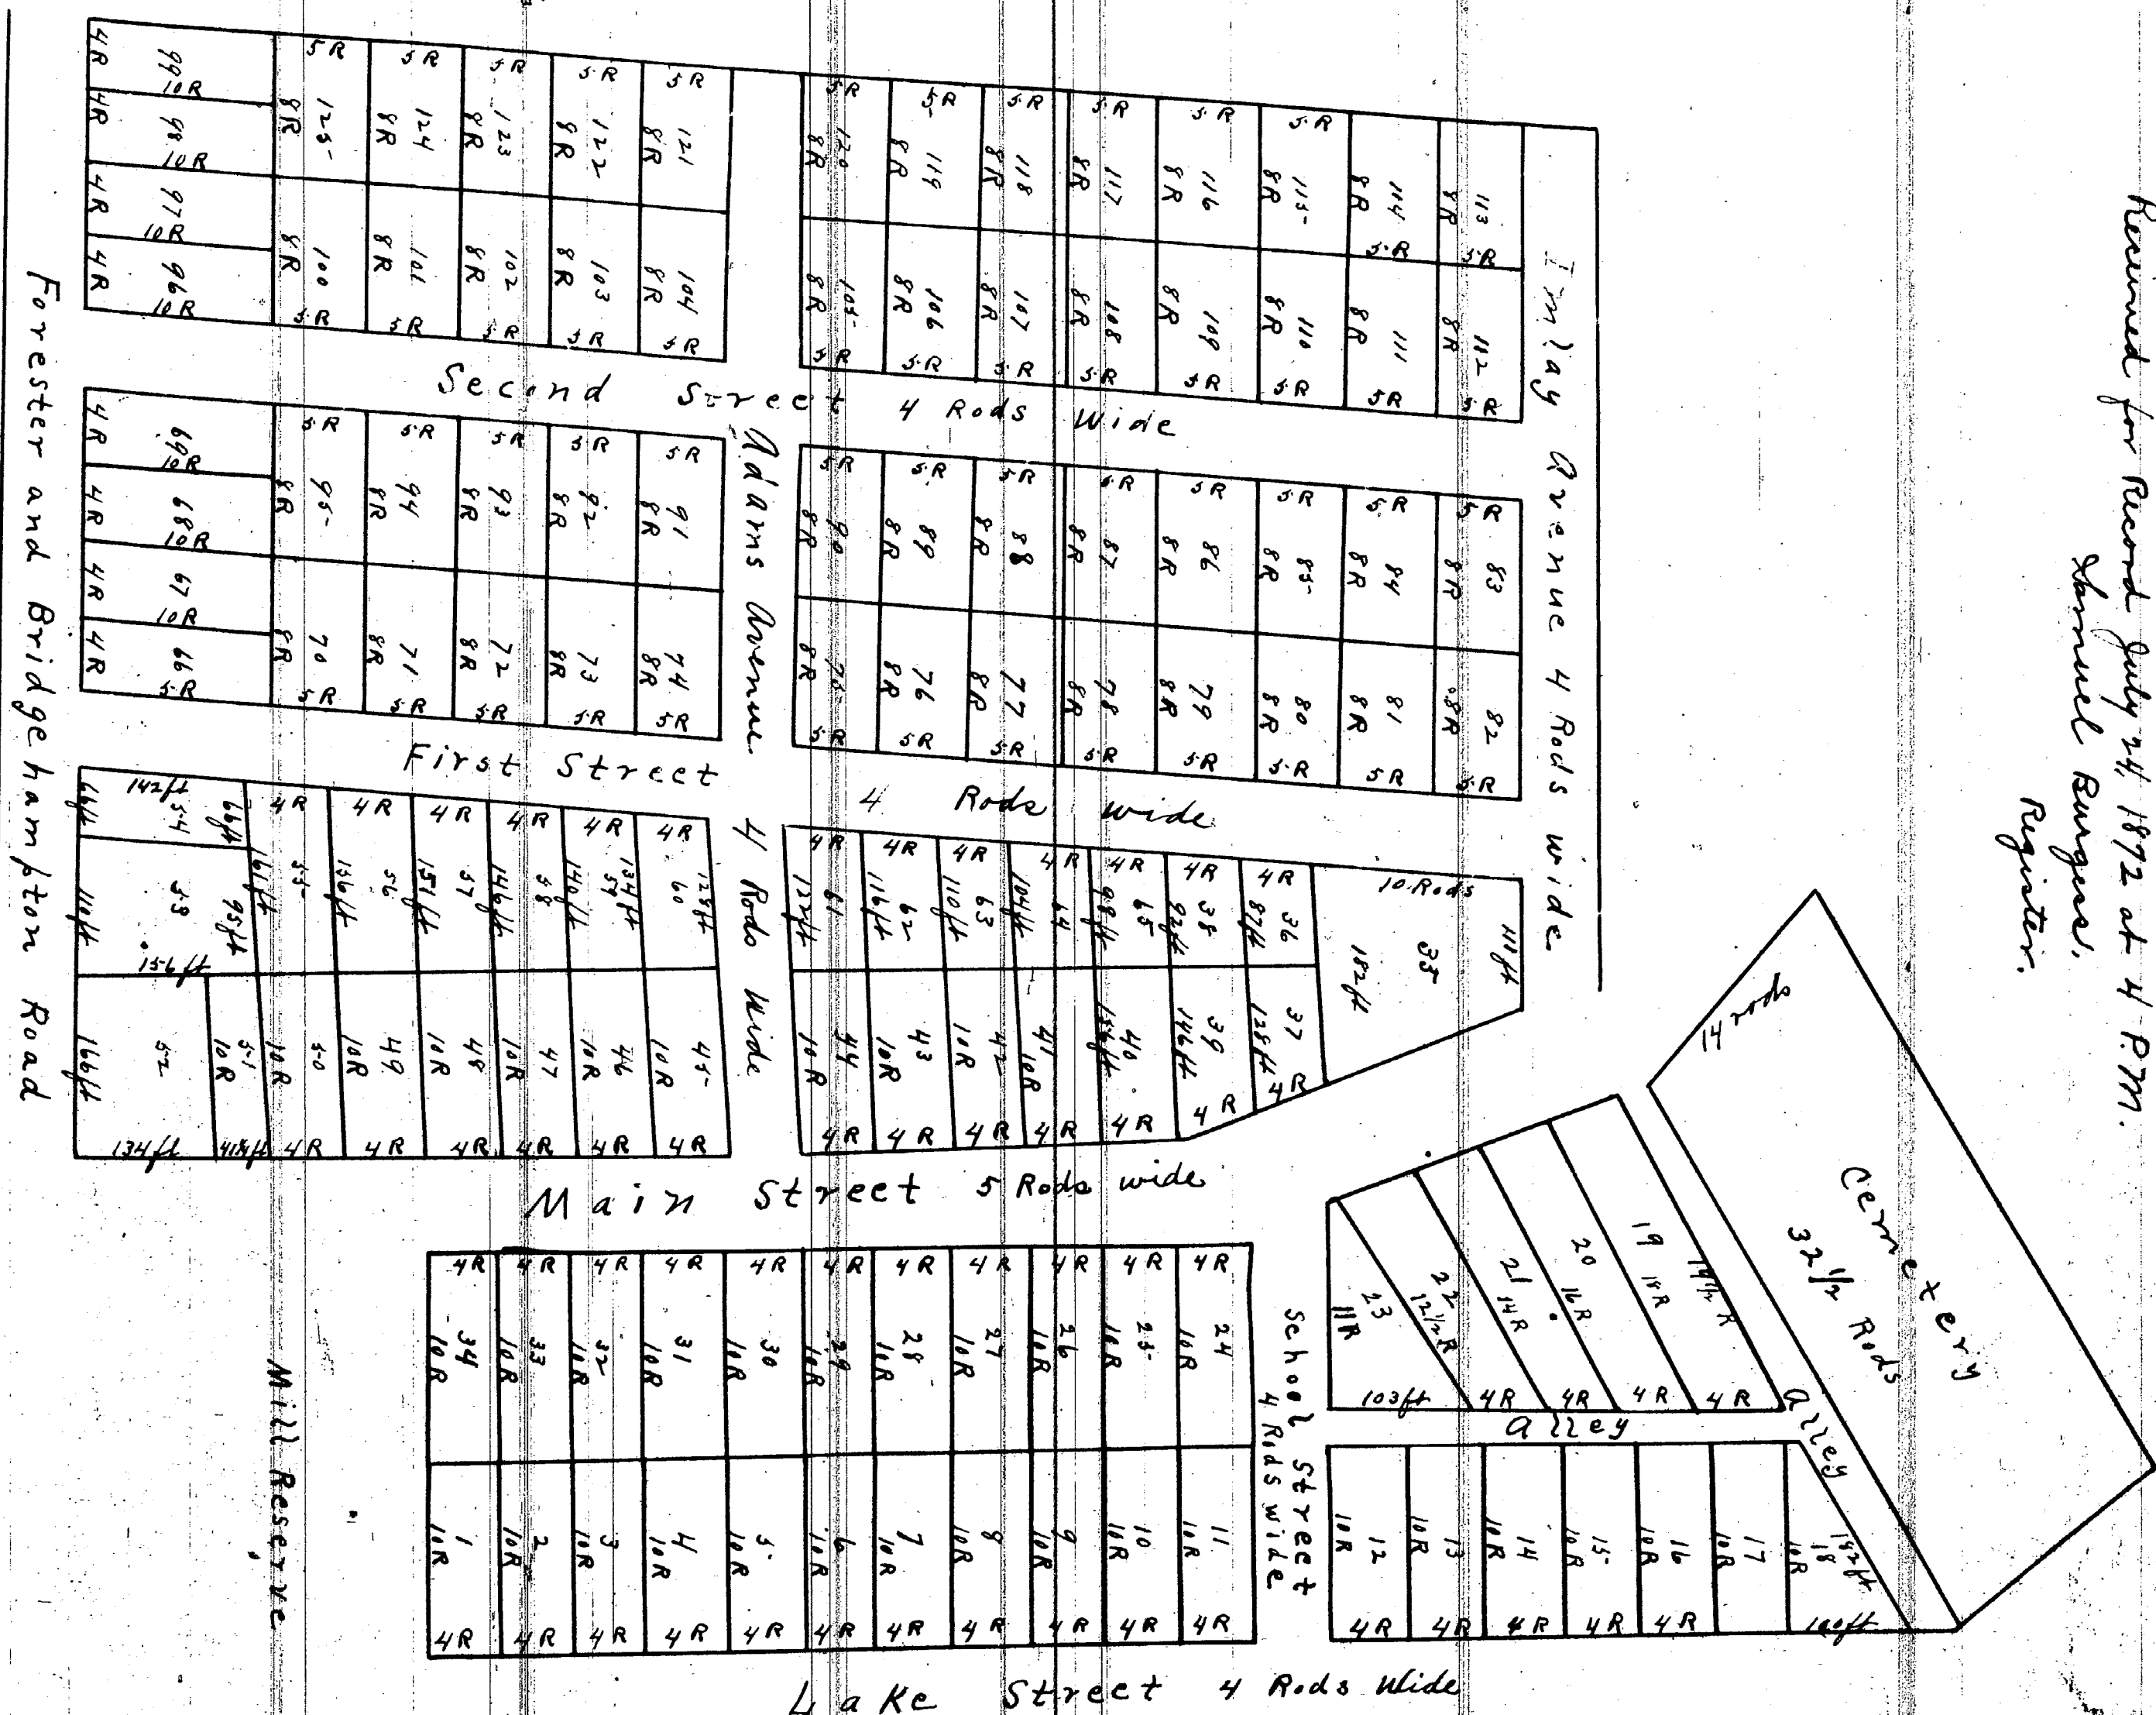


Village of Forester


Samuel Burgess,
Register.

Plat of the Village of Forester, Sanilac County, Michigan, being composed of part of the North fractional half of Section 26 (11) in Township Twelve (12) North Range 16 East.

Be it remembered that we James B. Kelley and Alice W. Kelley of Albany, New York and Edward Smith and Frank Smith of Forester, Sanilac County, Michigan, who are the proprietors of the land described in the foregoing plat do hereby acknowledge the said plat as our free act and deed. And further by their private grant, give and dedicate to the Public the former the Street and alleys in said Plat laid out and designated as such according to the plan and map and as shown on the plan and map whenever the same may be discontinued by law. First and Second Streets and Adams Avenue and Smiley Avenue are not to be opened only as far and fast as lot and sold thereon. In witness whereof we have hereunto set our hands and seals the first day of July A.D. 1892.

James B. Kelley, Set by Edward Smith his Atty.
 Alice W. Kelley, Set by Edward Smith her Atty.
 Edward Smith, Set by Frank Smith Set

In presence of Samuel Burgess, Chief of Police, State of Michigan. On this 1st day of July A.D. 1892 before me a Notary Public of Sanilac County personally came Edward Smith, Attorney in fact for James B. Kelley and Alice W. Kelley his wife. Edward Smith for himself and stated his wife to me known to be the person described in and who executed the foregoing instrument and acknowledged the same to be their free act and deed.

Samuel Burgess
Notary Public

Shooby certify that this plat is a correct copy of the plat now on record in the Register of Deeds office being made under the supervision of the Auditor General by tracing the plat on record and affixing thereto a copy of the dedication and certification.

Dated this 12th day of Sept. 1911.
 John Robinson
 Clerk and Sen. Regt.

Scale 1/8 inch to a Rod

L 485-P589 (12476)
6/20/91

RESOLUTION

May 22, 1991

Copy of a resolution adopted by the Board of County Road Commissioners of Sanilac County, Michigan under the date of May 22, 1991:

A petition was received from property owners requesting the abandonment of a portion of Lake Street in the Village of Forester. The portion of Lake Street mentioned in the request was viewed by the Road Commissioners, Engineer-Manager and Secretary of the Board.

Motion by Commissioner Cudney seconded by Commissioner Alexander to absolutely abandon, discontinue and relinquish that portion of Lake Street as shown on the plat of the Village of Forester as recorded in liber of town plats, pp. 38 and 39 Sanilac County Records lying northerly of a line beginning at a point on the boundary of Lake Street, Lot 12 of said plat which is 45 feet north of the southeast corner of Lot 12 and thence easterly perpendicular to the east line of Lot 12 across Lake Street to the easterly side of Lake Street and that portion of Lake Street currently occupying an easement on Lots 15 to 21 granted to and recorded in Liber 52, page 555, Sanilac County Records and the alley shown on the plat of the Village of Forester as recorded in Liber of town plats, pp. 38 and 39, Sanilac County Records, north of and adjacent to Lots 18 and 19 of said plat and between the west side of Lake Street and M-25 as shown on said plat pursuant to PA 283 of 1909, Chapter IV. and MCLA and MSA 9, 118. Motion carried.

CERTIFICATION:

I, Dale Wheeler, Secretary of the Board of the Board of County Road Commissioners of Sanilac County, Michigan do hereby certify that the foregoing is a true and correct copy of a resolution adopted by the Board of County Road Commissioners of Sanilac County at a regular meeting held on the 22nd day of May, 1991 and said resolution duly appears upon the minutes of said meeting.

IN WITNESS WHEREOF I have hereunto subscribed my name as Secretary of said Board this 22nd day of May, 1991.

Dale Wheeler
Dale Wheeler
Secretary of the Board

LIBER 485 PAGE 773 (12476)
TOWNSHIP OF FORESTER
SANILAC COUNTY, MICHIGAN

RESOLUTION NO.91-001

VACATION OF A PLATTED ALLEY
Plat of the Village of Forester

RECEIVED FOR RECORD

91 JUL -2 AM 9:21

LIBER NO. 485 PAGE NO. 773
EDWIN LEE
REGISTER OF DEEDS
SANILAC CO. MICHIGAN

At a special meeting of the Forester Township Board, held at the Township Hall at 2470 N. Lakeshore Road, in Forester Michigan, on the 8th day of April, 1991, at 8:00 p.m., the following Resolution was presented:

Pursuant to that certain Settlement Agreement by and between the Township of Forester ("Forester") and William H. Moir and Leah A. Moir, husband and wife, and William E. Clugston and Janet M. Clugston, husband and wife, ("Moir-Clugston"), the following preamble and resolution were considered:

WHEREAS:

The efficacy and legality of Resolution 88 1 of the Township (May, 1988) has been disputed and it appears that no part of the alley in the Plat of the Village as recorded in Liber of Town Plats, L. 1, pp. 38 and 39 abutting Lots 18 and 19 thereof, is within 25 meters of Lake Huron.

NOW, THEREFORE IT IS RESOLVED THAT:

For purposes and intents of the Settlement Agreement, that part of Resolution 88 1 of the Township Board should be considered null and void and rescinded insofar as it provides any length of the alley vacated and provides for exclusive use of said alley as a part of the Cemetery operated by the Township.

IT IS FURTHER RESOLVED THAT:

The Board reaffirms its vacation of the alley abutting Lots 18 and 19 as shown on the Plat of Forester Township recorded in Liber 1, pp. 38 and 39, Town Plats, Sanilac County, Michigan, and amends said Resolution to read as follows:

"NOW THEREFORE, IT IS RESOLVED THAT:

A. The alley lying between the Cemetery and Lots 18 and 19 of the Plat of the Village of Forester, Section 10, Forester Township, Sanilac County, as recorded in the Town Plats of said County, L. 1, pp. 38 and 39 is hereby absolutely vacated it being understood that this amended Resolution vests title in said alley in the owners of said lots 18 and 19.

B. This resolution shall be filed with the Sanilac County Register of Deeds within 30 days after passage and a copy shall be sent to the State Treasurer."

Motion by: Joseph Shanks Second by: Orville Hoyer
Yeas: Shanks, O. Hoyer, Foss, Reid
Nays: None
Absent: Charles Hoyer

Dated: 4-8-91


Clarence H. Reid
Clarence H. Reid, Supervisor

Attest and Certification:

I, Maxine Foss, Clerk of the Township of Forester, hereby certify that the aforementioned constitutes a true and complete copy of a Resolution adopted by the Forester Township Board, County of Sanilac, State of Michigan, at a Special meeting held on the 8th day of April, 1991 and that public notice of said meeting was given pursuant to and in full compliance with Act No. 267, Public Acts of Michigan, 1976.

Dated: April 8, 1991

Maxine Foss
Maxine Foss, Clerk, Forester Township

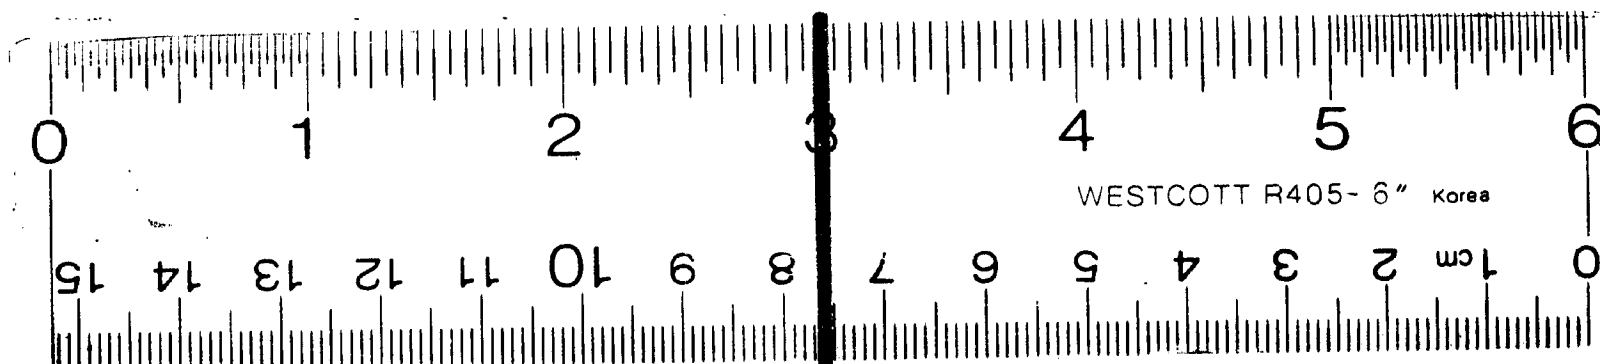

12 X

12476
FEB 14 1994

2-2-94

MICH. DEPT. COM.
SUB-DIV CONTROL UNIT
PO. 30004
LANSING MI 48909

DEAR MR. DYER,

ATTACHED FOR RECORDING PURPOSES ARE
COPIES OF A LETTER FROM ANTHONY SYKORA,
ATTORNEY AT LAW, TO THE MICH. DEPT. OF
TREASURY, IN ACCORDANCE WITH THE MICH. STATUTES
FOR SOME REASON THEY NEVER REACHED YOUR
OFFICE. I AM HEREWITH ENCLOSED FOR YOUR
USE, THE TREASURY LETTER AND THE THREE
REFERENCED RESOLUTIONS, AS TO MAINTAIN AN
UPDATED RECORD IN LANSING.

THANK YOU,

William Clugston

BOARD OF COUNTY RESOLUTIONS L 485 P 589
FORESTER TOWNSHIP RESOLUTION 91-001 L 485 P 773
FORESTER TOWNSHIP RESOLUTION 91-002 L 485 P 774

RE: RECORDING SANILAC COUNTY ROAD COMMISSION RESOLUTION
AND FORESTER TOWNSHIP RESOLUTIONS 91-001 & 91-002.

Dear Sir/Madam:

Enclosed please find copies of 1) Sanilac County Road Commission Resolution,
2) Forester Township Resolution # 91-001 (Vacation of a Platted Alley) and
3) Forester Township Resolution # 91-002 (Vacation of a Platted Street).
Kindly file in the usual manner.

If you have any questions regarding this matter please contact the office.
Sincerely,

Rita M. Gutch

Rita M. Gutch
Legal Secretary to J. Anthony Sykora - 615 NORTH ELM ST.
Attorney for Forester Township SANDLAC MI. 48971

Enclosures

12476
RESOLUTION
LIBER 485 PAGE 589

May 22, 1991

Copy of a resolution adopted by the Board of County Road
Commissioners of Sanilac County, Michigan under the date of May
22, 1991:

A petition was received from property owners
requesting the abandonment of a portion of
Lake Street in the Village of Forester. The
portion of Lake Street mentioned in the
request was viewed by the Road Commissioners,
Engineer-Manager and Secretary of the Board.

Motion by Commissioner Cudney seconded by
Commissioner Alexander to absolutely abandon,
discontinue and relinquish that portion of
Lake Street as shown on the plat of the
Village of Forester as recorded in Liber of
Town Plats, pp. 38 and 39 Sanilac County
Records lying northerly of a line beginning at
a point on the boundary of Lake Street, Lot
12 of said plat which is 45 feet north of the
southeast corner of Lot 12 and thence easterly
perpendicular to the east line of Lot 12
across Lake Street to the easterly side of
Lake Street and that portion of Lake Street
currently occupying an easement on Lots 15 to
21 granted to and recorded in Liber 52, page
555, Sanilac County Records and the alley
shown on the plat of the Village of Forester
39, Sanilac County Records, north of and
adjacent to Lots 18 and 19 of said plat and
between the west side of Lake Street and M-25
as shown on said plat pursuant to PA 283 of
1985, Chapter IV, and MCLA and MSA 9, 118.
Motion carried.

CERTIFICATION:

I, Dale Wheeler, Secretary of the Board of the Board of County
Road Commissioners of Sanilac County, Michigan do hereby certify
that the foregoing is a true and correct copy of a resolution
adopted by the Board of County Road Commissioners of Sanilac
County at a regular meeting held on the 22nd day of May, 1991 and
said resolution duly appears upon the minutes of said meeting.

IN WITNESS WHEREOF I have hereunto subscribed my name as
Secretary of said Board this 22nd day of May, 1991.

Dale Wheeler
Secretary of the Board

12476
LIBER 485 PAGE 773
TOWNSHIP OF FORESTER
SANILAC COUNTY, MICHIGAN

RESOLUTION NO. 91-001

VACATION OF A PLATTED ALLEY
Plat of the Village of Forester

At a special meeting of the Forester Township Board, held at the Township Hall at
2470 N. Lakeshore Road, in Forester Michigan, on the 8th day of April, 1991, at 8:00
p.m., the following Resolution was presented:

Pursuant to that certain Settlement Agreement by and between the Township of
Forester ("Forester") and William H. Moir and Leah A. Moir, husband and wife, and
William E. Clugston and Janet M. Clugston, husband and wife, ("Moir-Clugston"), the
following preamble and resolution were considered:

WHEREAS:

The efficacy and legality of Resolution 88 1 of the Township (May, 1988) has
been disputed and it appears that no part of the alley in the Plat of the Village as
recorded in Liber of Town Plats, L. 1, pp. 38 and 39 abutting Lots 18 and 19 thereof,
is within 25 meters of Lake Huron.

NOW, THEREFORE IT IS RESOLVED THAT:

For purposes and intents of the Settlement Agreement, that part of Resolution
88 1 of the Township Board should be considered null and void and rescinded
insofar as it provides any length of the alley vacated and provides for exclusive use
of said alley as a part of the Cemetery operated by the Township.

IT IS FURTHER RESOLVED THAT:

The Board reaffirms its vacation of the alley abutting Lots 18 and 19 as shown
on the Plat of Forester Township recorded in Liber 1, pp. 38 and 39, Town Plats,
Sanilac County, Michigan, and amends said Resolution to read as follows:

"NOW THEREFORE, IT IS RESOLVED THAT:

A. The alley lying between the Cemetery and Lots 18 and 19 of the Plat
of the Village of Forester, Section 10, Forester Township, Sanilac County, as recorded
in the Town Plat of said County, L. 1, pp. 38 and 39 is hereby absolutely vacated it
being understood that this amended Resolution vests title in said alley in the owners
of said lots 18 and 19.

B. This resolution shall be filed with the Sanilac County Register of Deeds
within 30 days after passage and a copy shall be sent to the State Treasurer."

Motion by: Joseph Starks
Starks, O. Hopper, Pres. Reid
Nays: None
Absent: Charles Hopper

Second by: Orville Hopper

Dated: 4-8-91

Clarence H. Reid
Clarence H. Reid, Supervisor

Attest and Certification:

I, Maxine Foss, Clerk of the Township of Forester, hereby certify that the
aforementioned constitutes a true and complete copy of a Resolution adopted by the
Forester Township Board, County of Sanilac, State of Michigan, at a Special meeting
held on the 8th day of April, 1991 and that public notice of said meeting was given
pursuant to and in full compliance with Act No. 267, Public Acts of Michigan, 1976.

Dated: April 8, 1991

Maxine Foss
Maxine Foss, Clerk, Forester Township

12476
LIBER 485 PAGE 774
TOWNSHIP OF FORESTER
SANILAC COUNTY, MICHIGAN

RESOLUTION NO. 91-002

VACATION OF A PLATTED STREET
Plat of the Village of Forester

At a special meeting of the Forester Township Board, held at the Township Hall at
2470 N. Lakeshore Road, in Forester Michigan, on the 8th day of April, 1991, at 8:00
p.m., the following Resolution was presented:

WHEREAS:

The Township oversees the property described as that portion of Lake Street
as shown on the Plat of the Village of Forester as recorded in Liber 1, pp. 38 and 39
Town Plats, Sanilac County, Michigan and lying Northerly of a line perpendicular to
the Westerly line of said Lake Street (being the Easterly line of Lot 12 of said Plat)
and extending to the Easterly line of Lake Street, said line to begin 45 feet North of
the intersection of the Northerly line of School Street and the Westerly line of Lake
Street (being the Southeast Corner of said Lot 12), and

This street is not a State Highway, and
This Board has determined that it is advisable and in the best interest of the
Township that this street be vacated.

NOW THEREFORE, IT IS RESOLVED THAT:

The portion of Lake Street as shown on the Plat of the Village of
Forester as recorded in Liber 1, pp. 38 and 39 Town Plats, Sanilac County, Michigan
and lying Northerly of a line perpendicular to the Westerly line of said Lake Street
(being the Easterly line of lot 12 of said Plat) and extending to the Easterly line of Lake
Street, said line to begin 45 feet North of the intersection of the Northerly line of
School Street and the Westerly line of Lake Street (being the Southeast corner of
said lot 12) is hereby vacated to the abutting landowners.

Motion by: Joseph Starks
Starks, O. Hopper, Pres. Reid
Nays: None
Absent: Charles Hopper

Second by: Orville Hopper
Nays: None
Abstain: None

Dated: 4-8-91

Clarence H. Reid
Clarence H. Reid

Attest and Certification:


I, Maxine Foss, Clerk of the Township of Forester, hereby certify that the
aforementioned constitutes a true and complete copy of a Resolution adopted by the
Forester Township Board, County of Sanilac, State of Michigan, at a Special meeting
held on the 8th day of April, 1991 and that public notice of said meeting was given
pursuant to and in full compliance with Act No. 267, Public Acts of Michigan, 1976.

Dated: April 8, 1991

Maxine Foss
Maxine Foss, Clerk, Forester Township

91 JUL -2 AM 9:21

LIBER NO. 485 PAGE NO. 774
ESTHER LEE
REGISTER OF DEEDS
SANILAC COUNTY, MICHIGAN

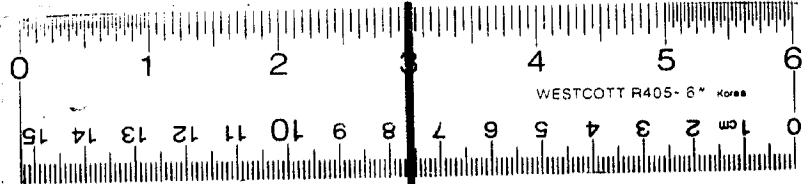

24 X

LIBER 485 PAGE 774
TOWNSHIP OF FORESTER
SANILAC COUNTY, MICHIGAN

RESOLUTION NO. 91-002

VACATION OF A PLATTED STREET
Plat of the Village of Forester

At a special meeting of the Forester Township Board, held at the Township Hall at 2470 N. Lakeshore Road, in Forester Michigan, on the 8th day of April, 1991, at 8:00 p.m., the following Resolution was presented:

WHEREAS:

The Township oversees the property described as that portion of Lake Street as shown on the Plat of the Village of Forester as recorded in Liber 1, pp. 38 and 39 Town Plats, Sanilac County, Michigan and lying Northerly of a line perpendicular to the Westerly line of said Lake Street (being Easterly line of Lot 12 of said Plat) and extending to the Easterly line of Lake Street, said line to begin 45 feet North of the intersection of the Northerly line of School Street and the Westerly line of Lake Street (being the Southeast Corner of said Lot 12), and

This street is not a State Highway, and
This Board has determined that it is advisable and in the best interest of the Township that this street be vacated.

NOW THEREFORE, IT IS RESOLVED THAT,

The portion of Lake Street as shown on the Plat of the Village of Forester as recorded in Liber 1, pp. 38 and 39 Town Plats, Sanilac County, Michigan and lying Northerly of a line perpendicular to the Westerly line of said Lake Street (being Easterly line of lot 12 of said Plat) and extending to the Easterly line of Lake Street, said line to begin 45 feet North of the intersection of the Northerly line of School Street and the Westerly line of Lake Street (being the Southeast corner of said lot 12) is hereby vacated to the abutting landowners.

Motion by: Joseph Shanks
Yeas: Shanks, O. Hooper, Ross, Reid
Absent: Charles Hooper
Second by: Orville Hooper
Yeas: None
Abstain: None

Dated: 4-8-91

Clarence H. Reid
Clarence H. Reid

Attest and Certification:

I, Maxine Foss, Clerk of the Township of Forester, hereby certify that the aforementioned constitutes a true and complete copy of a Resolution adopted by the Forester Township Board, County of Sanilac, State of Michigan, at a Special meeting held on the 8th day of April, 1991 and that public notice of said meeting was given pursuant to and in full compliance with Act No. 267, Public Acts of Michigan, 1976.

Dated: April 8, 1991

Maxine Foss
Maxine Foss, Clerk, Forester Township

91 JUL -2 AM 9:21

LIBER NO. 485 PAGE NO. 774
REGISTER OF DEEDS
SANILAC CO. MICHIGAN

LIBER 485 PAGE 589
TOWNSHIP OF FORESTER
SANILAC COUNTY, MICHIGAN

RESOLUTION

May 22, 1991

Copy of a resolution adopted by the Board of County Road Commissioners of Sanilac County, Michigan under the date of May 22, 1991:

A petition was received from property owners requesting the abandonment of a portion of Lake Street in the Village of Forester. The portion of Lake Street mentioned in the request was viewed by the Road Commissioners, Engineer-Manager and Secretary of the Board.

Motion by Commissioner Cudney seconded by Commissioner Alexander to absolutely abandon, discontinue and relinquish that portion of Lake Street as shown on the plat of the Village of Forester as recorded in Liber of Town Plats, pp. 38 and 39 Sanilac County Records lying northerly of a line beginning at a point on the boundary of Lake Street, Lot 12 of said plat which is 45 feet north of the southeast corner of Lot 12 and thence easterly perpendicular to the east line of Lot 12 across Lake Street to the easterly side of Lake Street and that portion of Lake Street currently occupying an easement on Lots 15 to 21 granted to and recorded in Liber 52, page 555, Sanilac County Records and the alley shown on the plat of the Village of Forester as recorded in Liber of town plats, pp. 38 and 39, Sanilac County Records, north of and adjacent to Lots 12 and 19 of said plat and between the west side of Lake Street and U-25 as shown on said plat pursuant to PA 283 of 1909, Chapter IV. and MCLA and MSA 9, 118. Motion carried.

CERTIFICATION:

I, Dale Wheeler, Secretary of the Board of County Road Commissioners of Sanilac County, Michigan do hereby certify that the foregoing is a true and correct copy of a resolution adopted by the Board of County Road Commissioners of Sanilac County at a regular meeting held on the 22nd day of May, 1991 and said resolution duly appears upon the minutes of said meeting.

IN WITNESS WHEREOF I have hereunto subscribed my name as Secretary of said Board this 22nd day of May, 1991.

Dale Wheeler
Secretary of the Board

Office of J. Anthony Sykora

Attorney at Law
Six North Elk Street
Sandusky, Michigan 48471
Tx (313) 648-4414
Fx (313) 648-3403

FEB - 7 1994

Maynard Dyer
State of Michigan
Department of Commerce
Subdivision Control
116 West Allegan
P.O. Box 30004
Lansing, MI 48909

Friday,
February 4, 1994

Re: Sanilac County Road Commission Resolution and
Forester Township Resolutions 91-001 & 91-002

Dear Mr. Dyer:

On July 17, 1991, our office forwarded to the Michigan Department of Treasury correspondence with enclosures of the Sanilac County Road Commission Resolution, Forester Township Resolution #91-001 and Forester Township Resolution #91-002. It has come to our attention that we should forward a copy of these documents directly to you for your records and, therefore, we enclose same herewith.

If you have any questions regarding the enclosures, please do not hesitate to contact our office.

Thank you for your attention in this regard.

Very truly yours,

Marjorie S. Potter
Marjorie S. Potter
Secretary to J. Anthony Sykora

Enclosures

J. Anthony Sykora

ATTORNEY AT LAW
SIX NORTH ELK STREET
SANDUSKY, MI 48471
(313) 648-3403

July 17, 1991

Michigan Department of Treasury
Treasury Building
Walnut & Allegan Street
Lansing, MI 48922

RE: RECORDING SANILAC COUNTY ROAD COMMISSION RESOLUTION
AND FORESTER TOWNSHIP RESOLUTIONS 91-001 & 91-002

Dear Sir/Madam:

Enclosed please find copies of 1) Sanilac County Road Commission Resolution, 2) Forester Township Resolution # 91-001 (Vacation of a Platted Alley) and 3) Forester Township Resolution # 91-002 (Vacation of a Platted Street). Kindly file in the usual manner.

If you have any questions regarding this matter please contact the office.

Sincerely,

Rita M. Gutch

Legal Secretary to J. Anthony Sykora
Attorney for Forester Township

Enclosures

LIBER 403 PAGE 114
TOWNSHIP OF FORESTER
SANILAC COUNTY, MICHIGAN

RESOLUTION NO. 91-002

VACATION OF A PLATTED STREET
Plat of the Village of Forester

At a special meeting of the Forester Township Board, held at the Township Hall at 2470 N. Lakeshore Road, in Forester Michigan, on the 8th day of April, 1991, at 8:00 p.m., the following Resolution was presented:

WHEREAS:

The Township oversees the property described as that portion of Lake Street as shown on the Plat of the Village of Forester as recorded in Liber 1, pp. 38 and 39 Town Plats, Sanilac County, Michigan and lying Northerly of a line perpendicular to the Westerly line of said Lake Street (being Easterly line of Lot 12 of said Plat) and extending to the Easterly line of Lake Street, said line to begin 45 feet North of the intersection of the Northerly line of School Street and the Westerly line of Lake Street (being the Southeast Corner of said Lot 12), and

This street is not a State Highway, and
This Board has determined that it is advisable and in the best interest of the Township that this street be vacated.

NOW THEREFORE, IT IS RESOLVED THAT,

The portion of Lake Street as shown on the Plat of the Village of Forester as recorded in Liber 1, pp. 38 and 39 Town Plats, Sanilac County, Michigan and lying Northerly of a line perpendicular to the Westerly line of said Lake Street (being Easterly line of lot 12 of said Plat) and extending to the Easterly line of Lake Street, said line to begin 45 feet North of the intersection of the Northerly line of School Street and the Westerly line of Lake Street (being the Southeast corner of said lot 12) is hereby vacated to the abutting landowners.

Motion by: Joseph Shanks
Yeas: Shanks, O. Hooper, Ross, Reid
Absent: Charles Hooper
Second by: Orville Hooper
Yeas: None
Abstain: None

Dated: 4-8-91

Clarence H. Reid
Clarence H. Reid

Attest and Certification:


I, Maxine Foss, Clerk of the Township of Forester, hereby certify that the aforementioned constitutes a true and complete copy of a Resolution adopted by the Forester Township Board, County of Sanilac, State of Michigan, at a Special meeting held on the 8th day of April, 1991 and that public notice of said meeting was given pursuant to and in full compliance with Act No. 267, Public Acts of Michigan, 1976.

Dated: April 8, 1991

Maxine Foss
Maxine Foss, Clerk, Forester Township

91 JUL -2 AM 9:21

LIBER NO. 485 PAGE NO. 114
REGISTER OF DEEDS
SANILAC CO. MICHIGAN

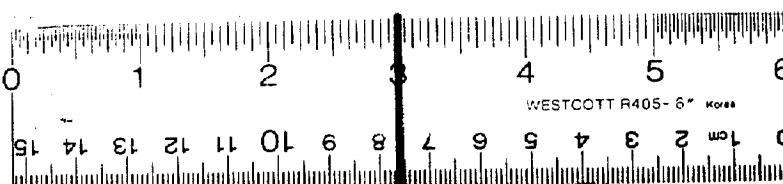

J. Anthony Sykora
ATTORNEY AT LAW
514 NORTH ELK STREET
SANDUSKY, MI 49471
(517) 668-3403

June 3, 1988

Mr. Robert A. Bowman
Michigan State Treasurer
Treasury Building
Lansing, MI 48922

RE: Forester Township, Sanilac County, Michigan

Mr. Bowman:

Pursuant to the statute, enclosed please find a copy of the Vacation of a Platted Alley Resolution adopted by the Forester Township Board on May 17, 1988.


If you have any questions, do not hesitate to contact this office.

Very truly yours,

J. Anthony Sykora
J. Anthony Sykora

/dsp

Enclosure

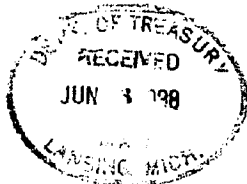

TOWNSHIP OF FORESTER
SANILAC COUNTY, MICHIGAN
RESOLUTION #88
VACATION OF A PLATTED ALLEY
PLAT OF THE VILLAGE OF FORESTER

At a regular/special meeting of the Forester Township Board, held at the Township Hall at 2470 N. Lakeshore Road, in Forester, Michigan, on the 17th day of May, 1988, at 8:00 o'clock P.M., the following resolution was presented:

WHEREAS:

1. The Township oversees the Cemetery located and described in the Plat of the Village of Forester as recorded in Liber of Town Plats, Pages 38 and 39, Sanilac County Register of Deeds (Resolution Exhibit A).
2. The Cemetery premises as platted are being utilized to the maximum and the Township is in need of more space.
3. It has been determined that the alley that runs east and west between the subject Cemetery and lots 18 and 19 in the Plat is part of the platted subdivision dedicated to the use of the public for no other purpose but to accommodate pedestrian and vehicular traffic and further, portions thereof are not within 75 feet (25 meters) of a lake or stream and does not therefore require an order of the Sanilac County Circuit Court pursuant to the provisions of MSA 26.43(2)(55a).
4. This alley is not a state highway, and
5. This Board has determined that it is advisable and in the best interests of the public that this alley be absolutely vacated for the use of the Cemetery.

NOW, THEREFORE, IT IS RESOLVED THAT:

- A. That the portion of the alley, not within 75 feet (25 meters) of a lake or stream, lying between the Cemetery and Lots 18 and 19 of the Plat of the Village of Forester, Section 10, Forester Township, Sanilac County, Michigan is hereby absolutely vacated to the use of the Cemetery.
- B. This resolution shall be filed with the Sanilac County Register of Deeds within 30 days after passage and a copy shall be sent to the State Treasurer.

Motion by: Maxine Foss

Second by: Clarence H. Reid


Yeas: 5
Nays: 0
Absent: 0

Dated: May 17, 1988

Clarence H. Reid, Supervisor

I hereby certify that the foregoing constitutes a true and complete copy of a resolution adopted by the Forester Township Board, County of Sanilac, State of Michigan, at a regular/special meeting held on the 17th day of May, 1988, and that public notice of said meeting was given pursuant to and in full compliance with Act No. 267, Public Acts of Michigan, 1976.

Maxine Foss, Clerk

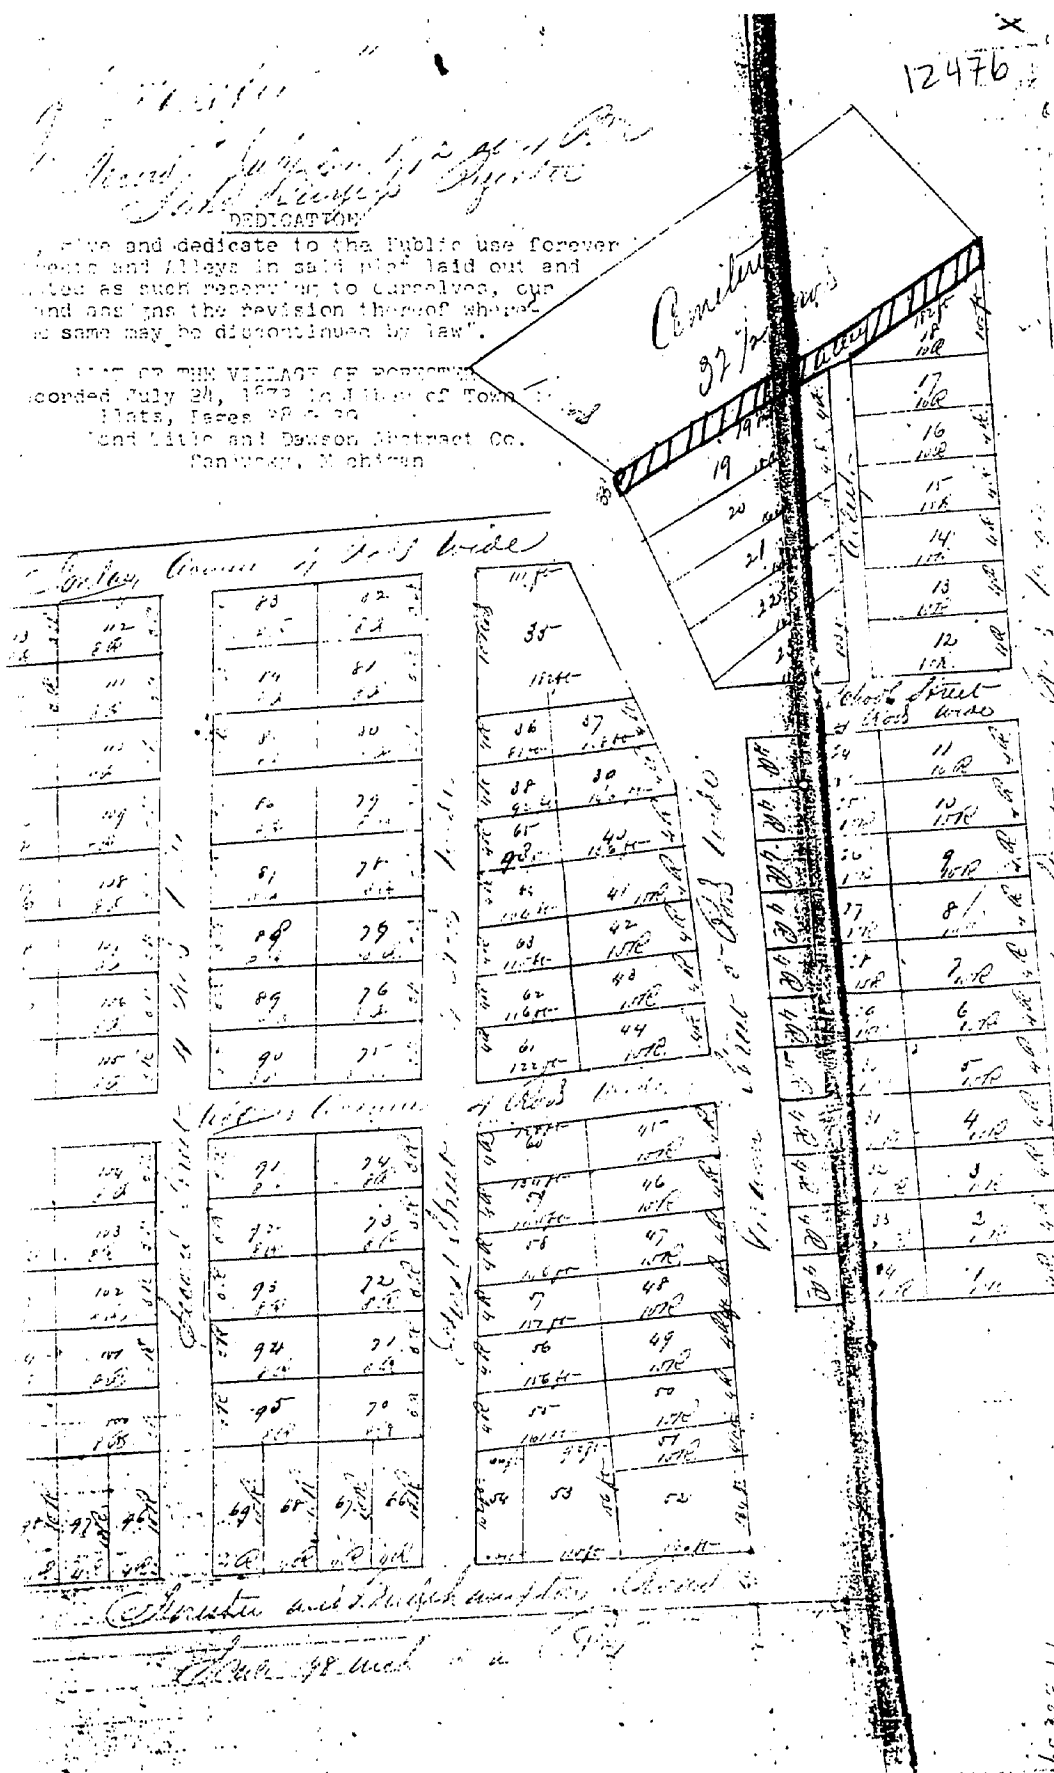

PLAT VILLAGE OF FORESTER

CC April 20-1887
C C J Liber C page 84


In the matter of the petition
of Edward Smith to vacate
certain streets and Avenues
in the Village Plat.

ORDERED: That those streets and Avenues, now existing
in said Village of Forester and shown by the plat thereof, on file in the
office of the Register of Deeds of said County known as First Street,
Second Street, Adams Avenue, and May Avenue, be and the same are hereby
vacated.

Watson Beach
Circuit Judge

Vol. 150-Page-12476 ✓

Curtis & Taylor
Plat Examiners

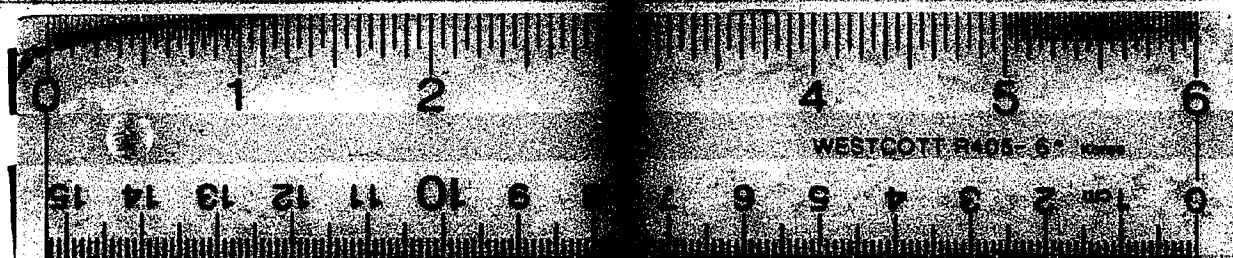

16 X