

MAP  
OF


# C.T. BRENNER'S SECOND ADDITION

TO THE  
CITY OF SAGINAW  
MICHIGAN

SCALE 100 FT TO THE INCH

11984

12486

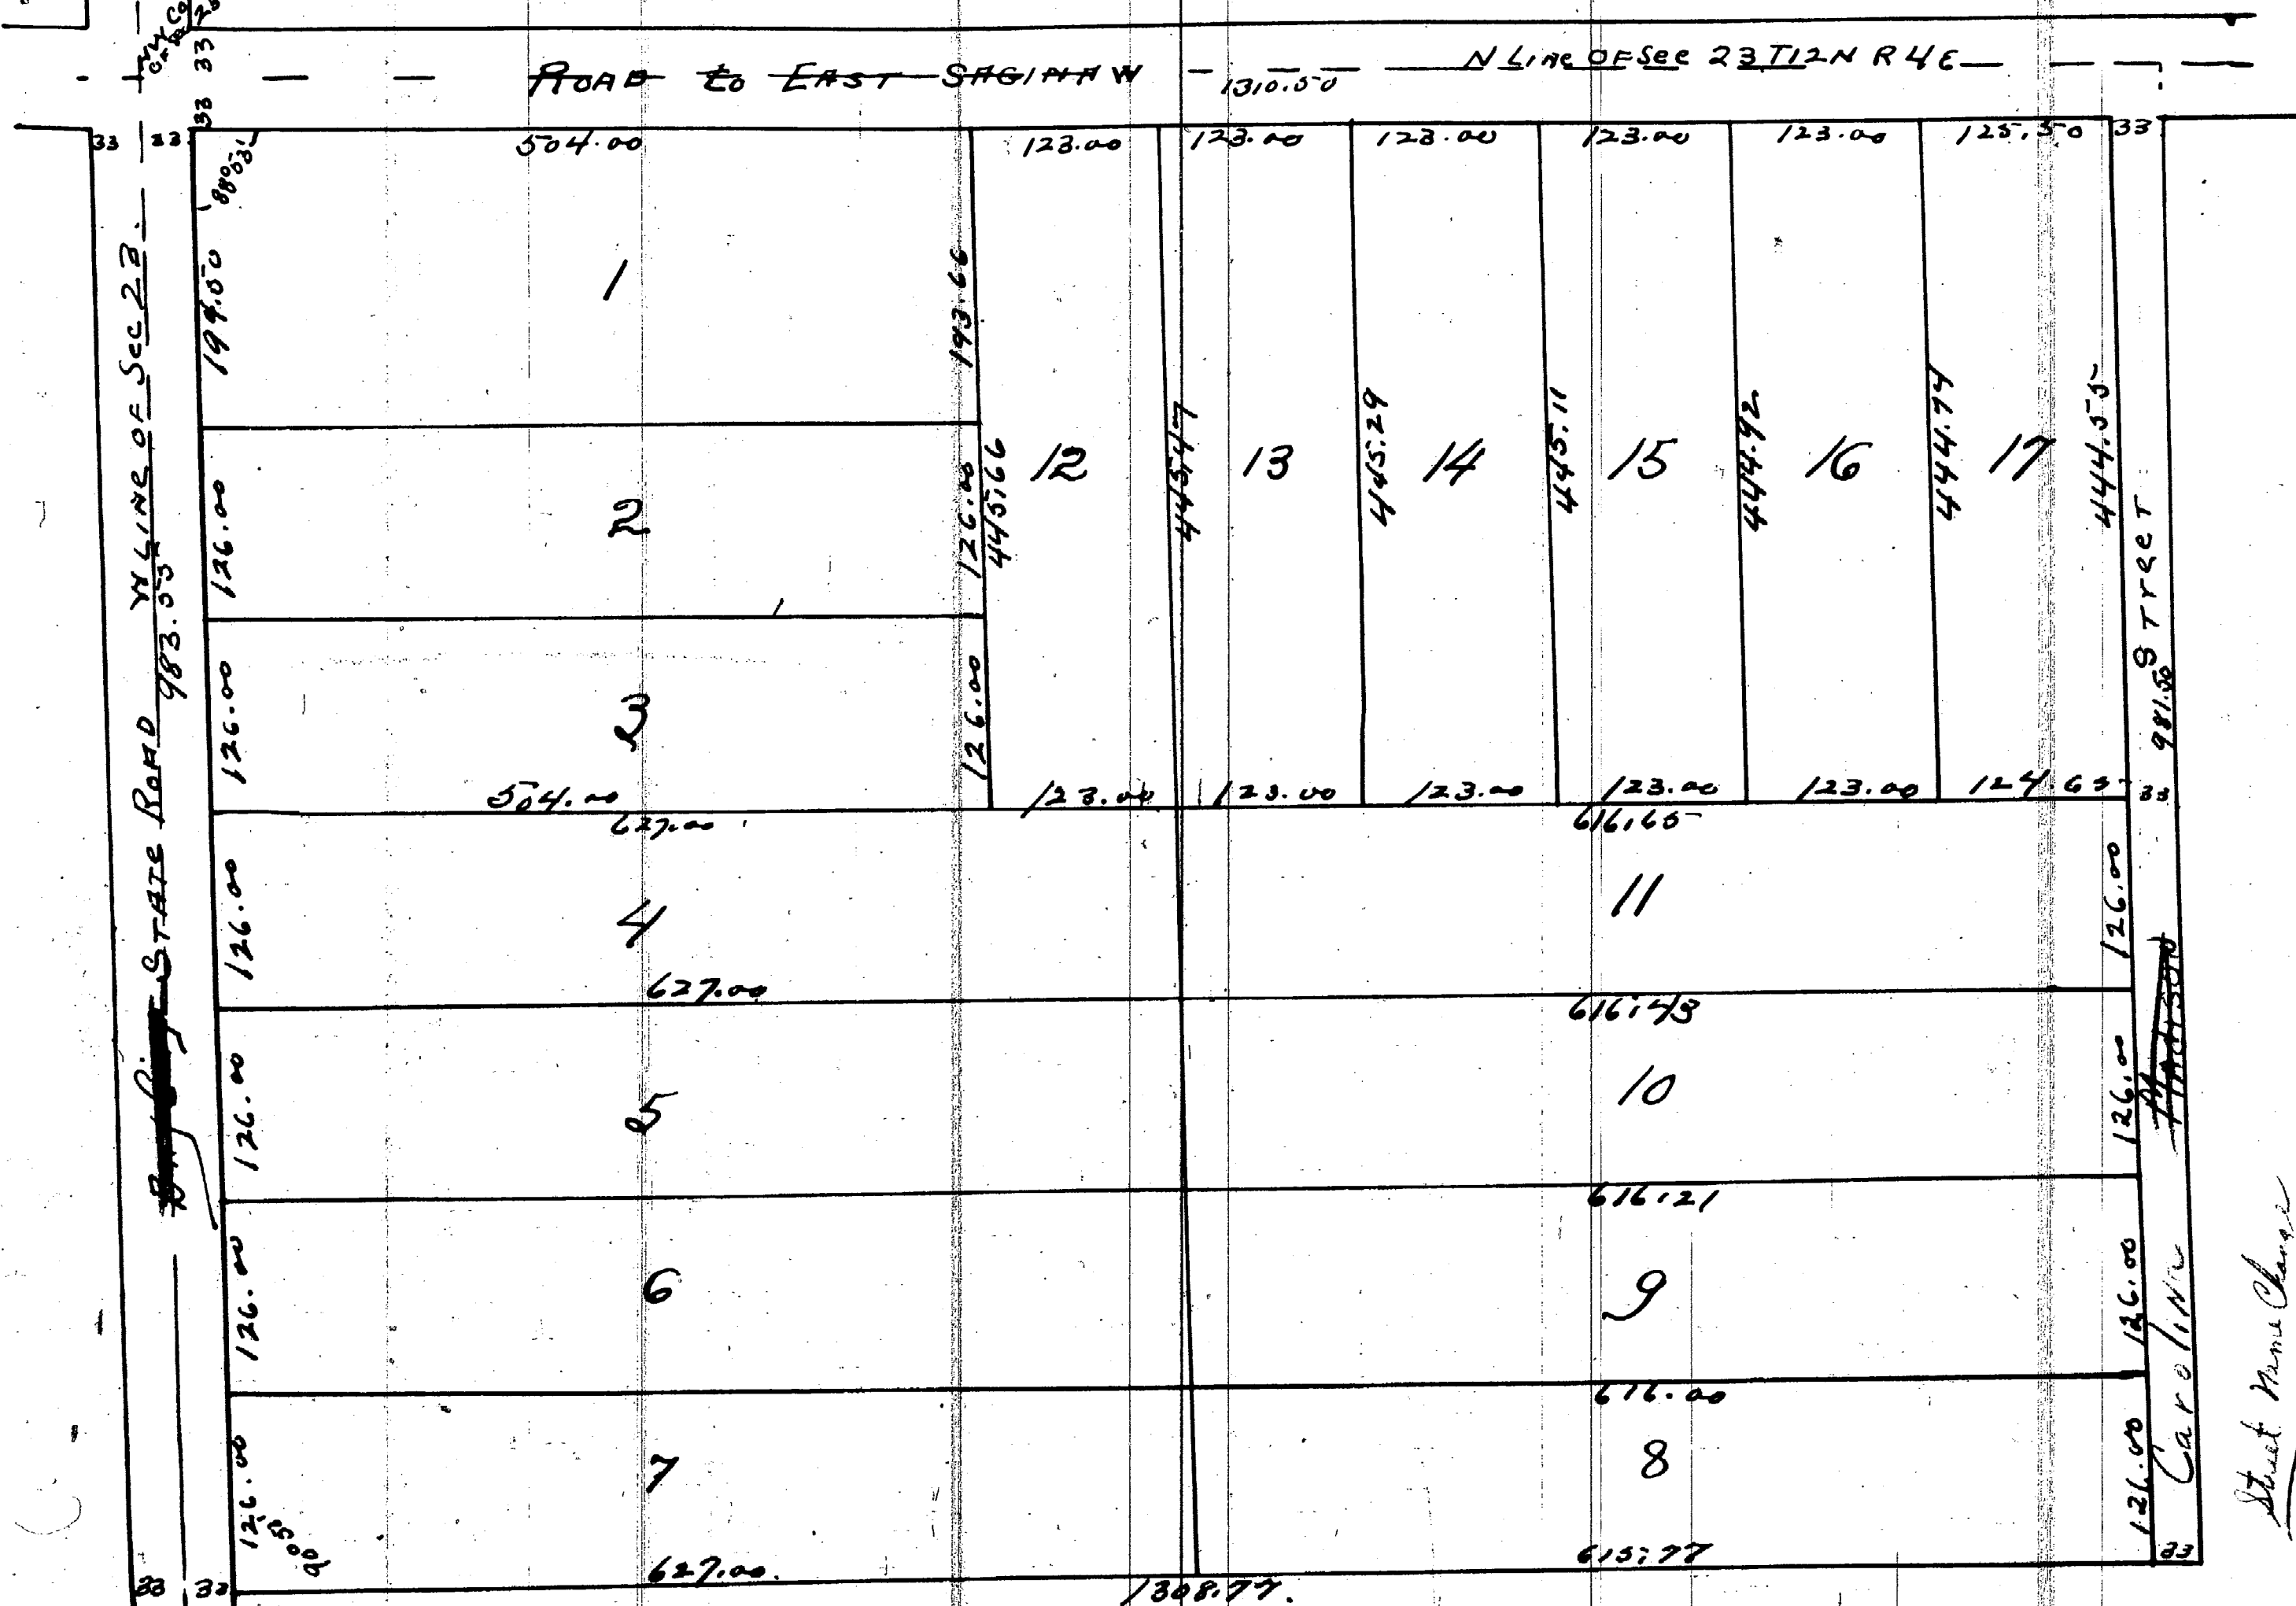

Street Name Change  
City of Saginaw  
Nov. 3, 1954  
708-58

I know all men in these presents that the land represented by the above map is divided as the N 3/4 of the NW 1/4 of the NW 1/4 of Sec. 23, T12 N R 4 E. That said land is owned by Charles T. Brenner of the City of Saginaw, County of Saginaw, State of Michigan. That said map is now created by the said Charles T. Brenner, as proprietor and by Harrison Cary as surveyor for said Charles T. Brenner, as of an act to provide for recording, first recording town plats and for vacating the same in certain cases and the act amendatory thereto and for the purpose of placing the same recorded. C.T. Brenner created addition to the City of Saginaw, Michigan. The size of lot and width of streets are given on said map by feet and hundredth of a foot. The intention whereof we have been set on hand and seals this 27th day of June A.D. 1872

Charles T. Brenner (LS)  
Harrison Cary (LS)

Edwin J. Saunders  
Gregory Adams

State of Michigan } ss On this 27th day of June, A.D. 1872 before me a Notary Public,  
Saginaw County } I & my said County personally appeared the above named Charles T. Brenner and  
Harrison Cary to me known to be the persons who created the above and  
who have acknowledged the creation of the same for the purpose therein  
expressed.

Registered for record June 27, 1872  
at 10 AM and recorded in Liber 76.  
J. H. Stevens Register

I hereby certify that this Plat is a correct copy of the Plat now on record in the Register of Deeds office, being made under the supervision of the Auditor General by tracing the plat on record and affixing thereto a carefully compared copy of the dedication and certificate dated this 15th day of June 1911

Ray C. Warner  
Clerk, and Sec. Clert.