


MAP OF P. HAZEN'S ADDITION TO TAWAS CITY

COMPRISING THE NW 1/4 OF THE NE 1/4 OF SEC 30 T 22 N R 8 E
JOS CO COUNTY MICHIGAN
SCALE 200 FT TO ONE INCH

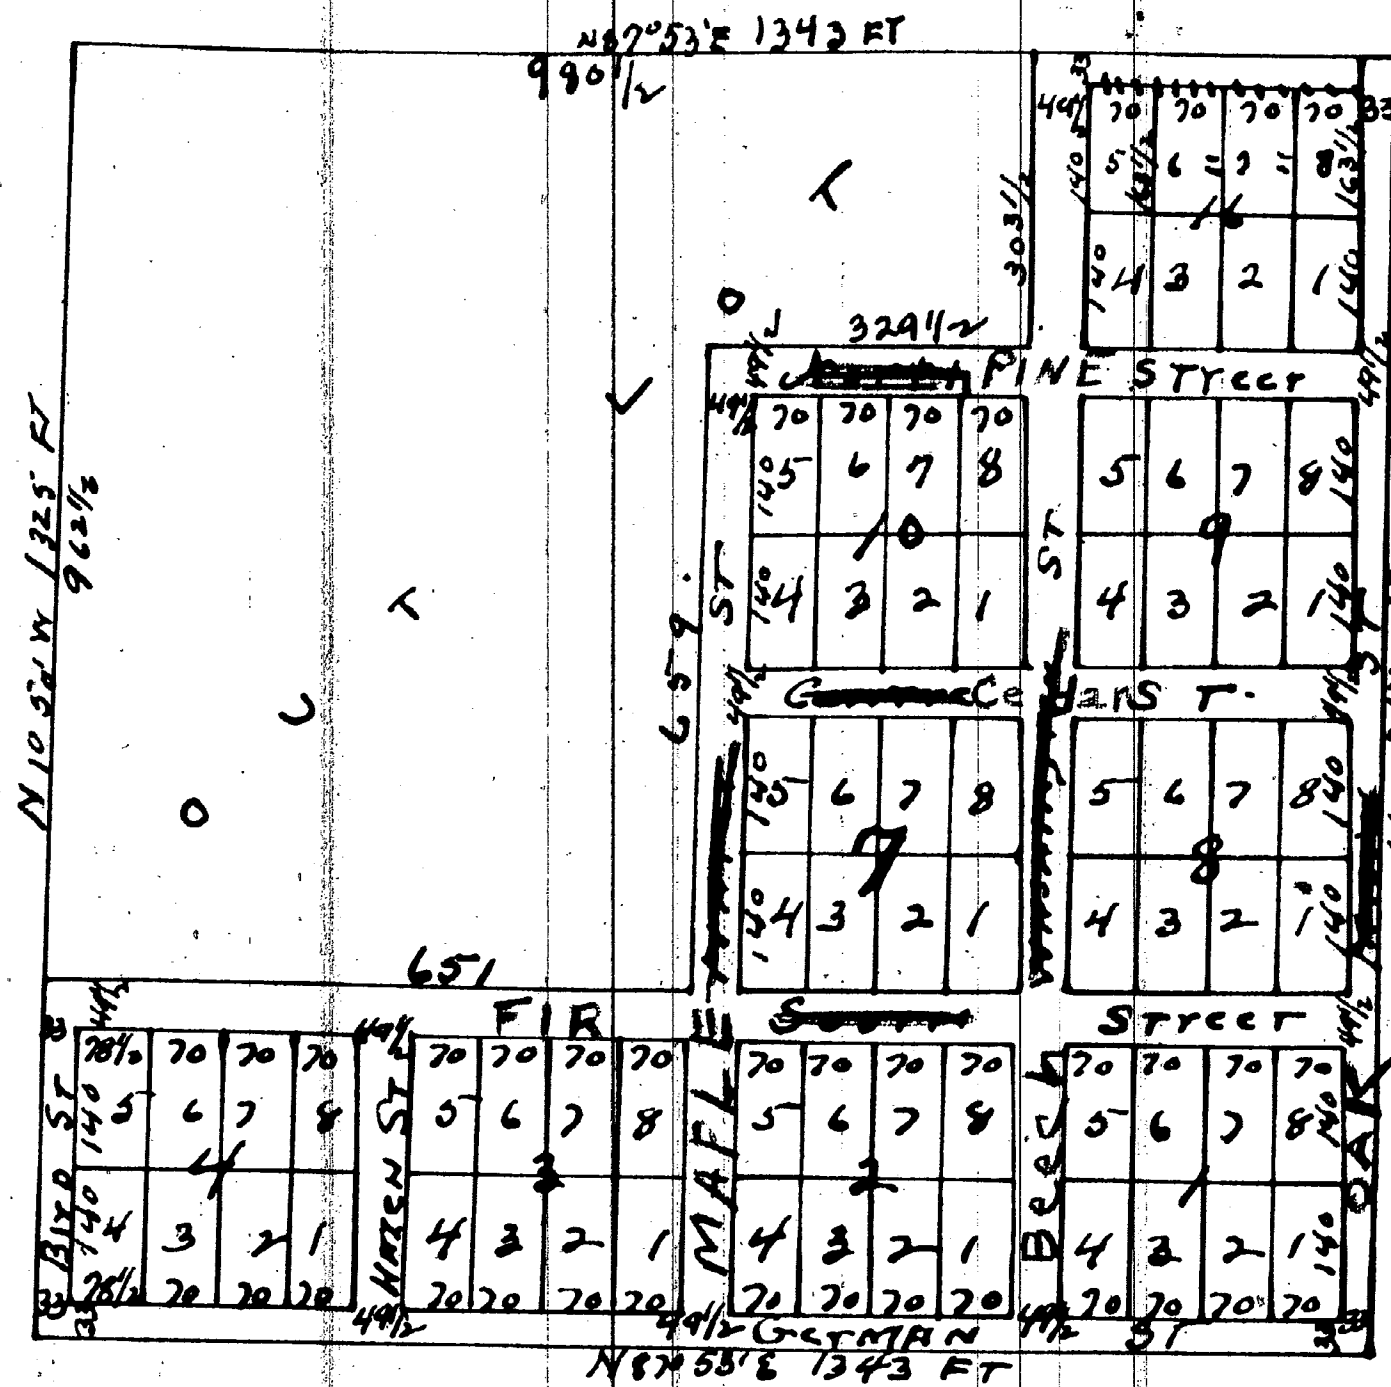

ST N. E. Chg.
 COMMON COUNCIL
 2-21-1955
 150-55

I know all men by their presents that the land laid out or plotted on the above map is owned by P. Hazen of Tawas City, Jones Co. Mich. that the said map or plat is now situated by the said P. Hazen as proprietor and C. H. Heavensworth of East Tawas as surveyor in accordance with the provisions of an act to provide for recording town plats and for creating the same in certain cases and the acts amendatory thereto and for the purpose of being recorded as P. Hazen's addition to Tawas City. The size of the lots and width of the streets are given as said map in feet. Block 16 runs up to the north line of this 40 acres. No street between Block 16 & the north line. Our witness taking me have presents set our hands and seals this 16th day of May 1870.

the presence of J. O. Whittemore } as to P. Hazen.
 James H. Cogshall }
 Otto Pinner } as to C. H. Heavensworth.
 Geo. Schmidt }

P. Hazen (L.S.)
 C. H. Heavensworth (L.S.)

State of Michigan } On this 17th day of May 1870 before me a Judge of the probate
 County of Tawas } Court for said County Elmer C. H. Heavensworth appearing as one of
 the persons who executed the above plat and acknowledged the execution thereof
 and of the foregoing instrument to be his free act and deed for the uses
 and purposes therein set forth in accordance with the acts therein cited
 without any fraud and the seal of said probate Court this 17th day of May
 1870. Otto Pinner. Judge of Probate (Seal)

State of Michigan } On this 23rd day of May 1870 before me
 County of Tawas } a Notary Public in and for said County personally
 appeared Philander Hazen proprietor of the lands embraced in the
 above Plat one of the persons who executed the above Plat
 and acknowledged the execution thereof of the foregoing instrument
 to be his free act and deed for the uses and purposes therein
 set forth and in accordance with the act therein cited.
 James H. Cogshall. Notary Public

Register of Deeds } Received for record May 24 1870 at Tawas Mich.
 Tawas County } S. O. Whittemore. Register

I hereby certify that this Plat is a correct copy of the Plat
 now on record in the Register of Deeds office, being made
 under the supervision of the Auditor General by tracing the
 Plat on record and affixing thereto a carefully compared copy
 of the dedication and certificates.

Dated this 31st day of Aug 1911
 Ray C. Warner.
 Clerk, Aud. Gen. Dept.