


LEWIS AND CROFOOT'S SUBDIVISION ON 1/4 SEC. 32 OF THE 10000 ACRE TRACT IN GREENFIELD T.18.R.12E. WAYNE COUNTY MICHIGAN

Description of the land platted


I hereby certify that the plat herein delineated is a correct one, and that permanent monuments consisting of oak stakes, (except where iron is marked) have been planted at points marked thereon as thereon shown, at all angles in the boundaries of the land platted, and at all intersections of streets or streets and alleys.

A. H. Willmarth
Sur.

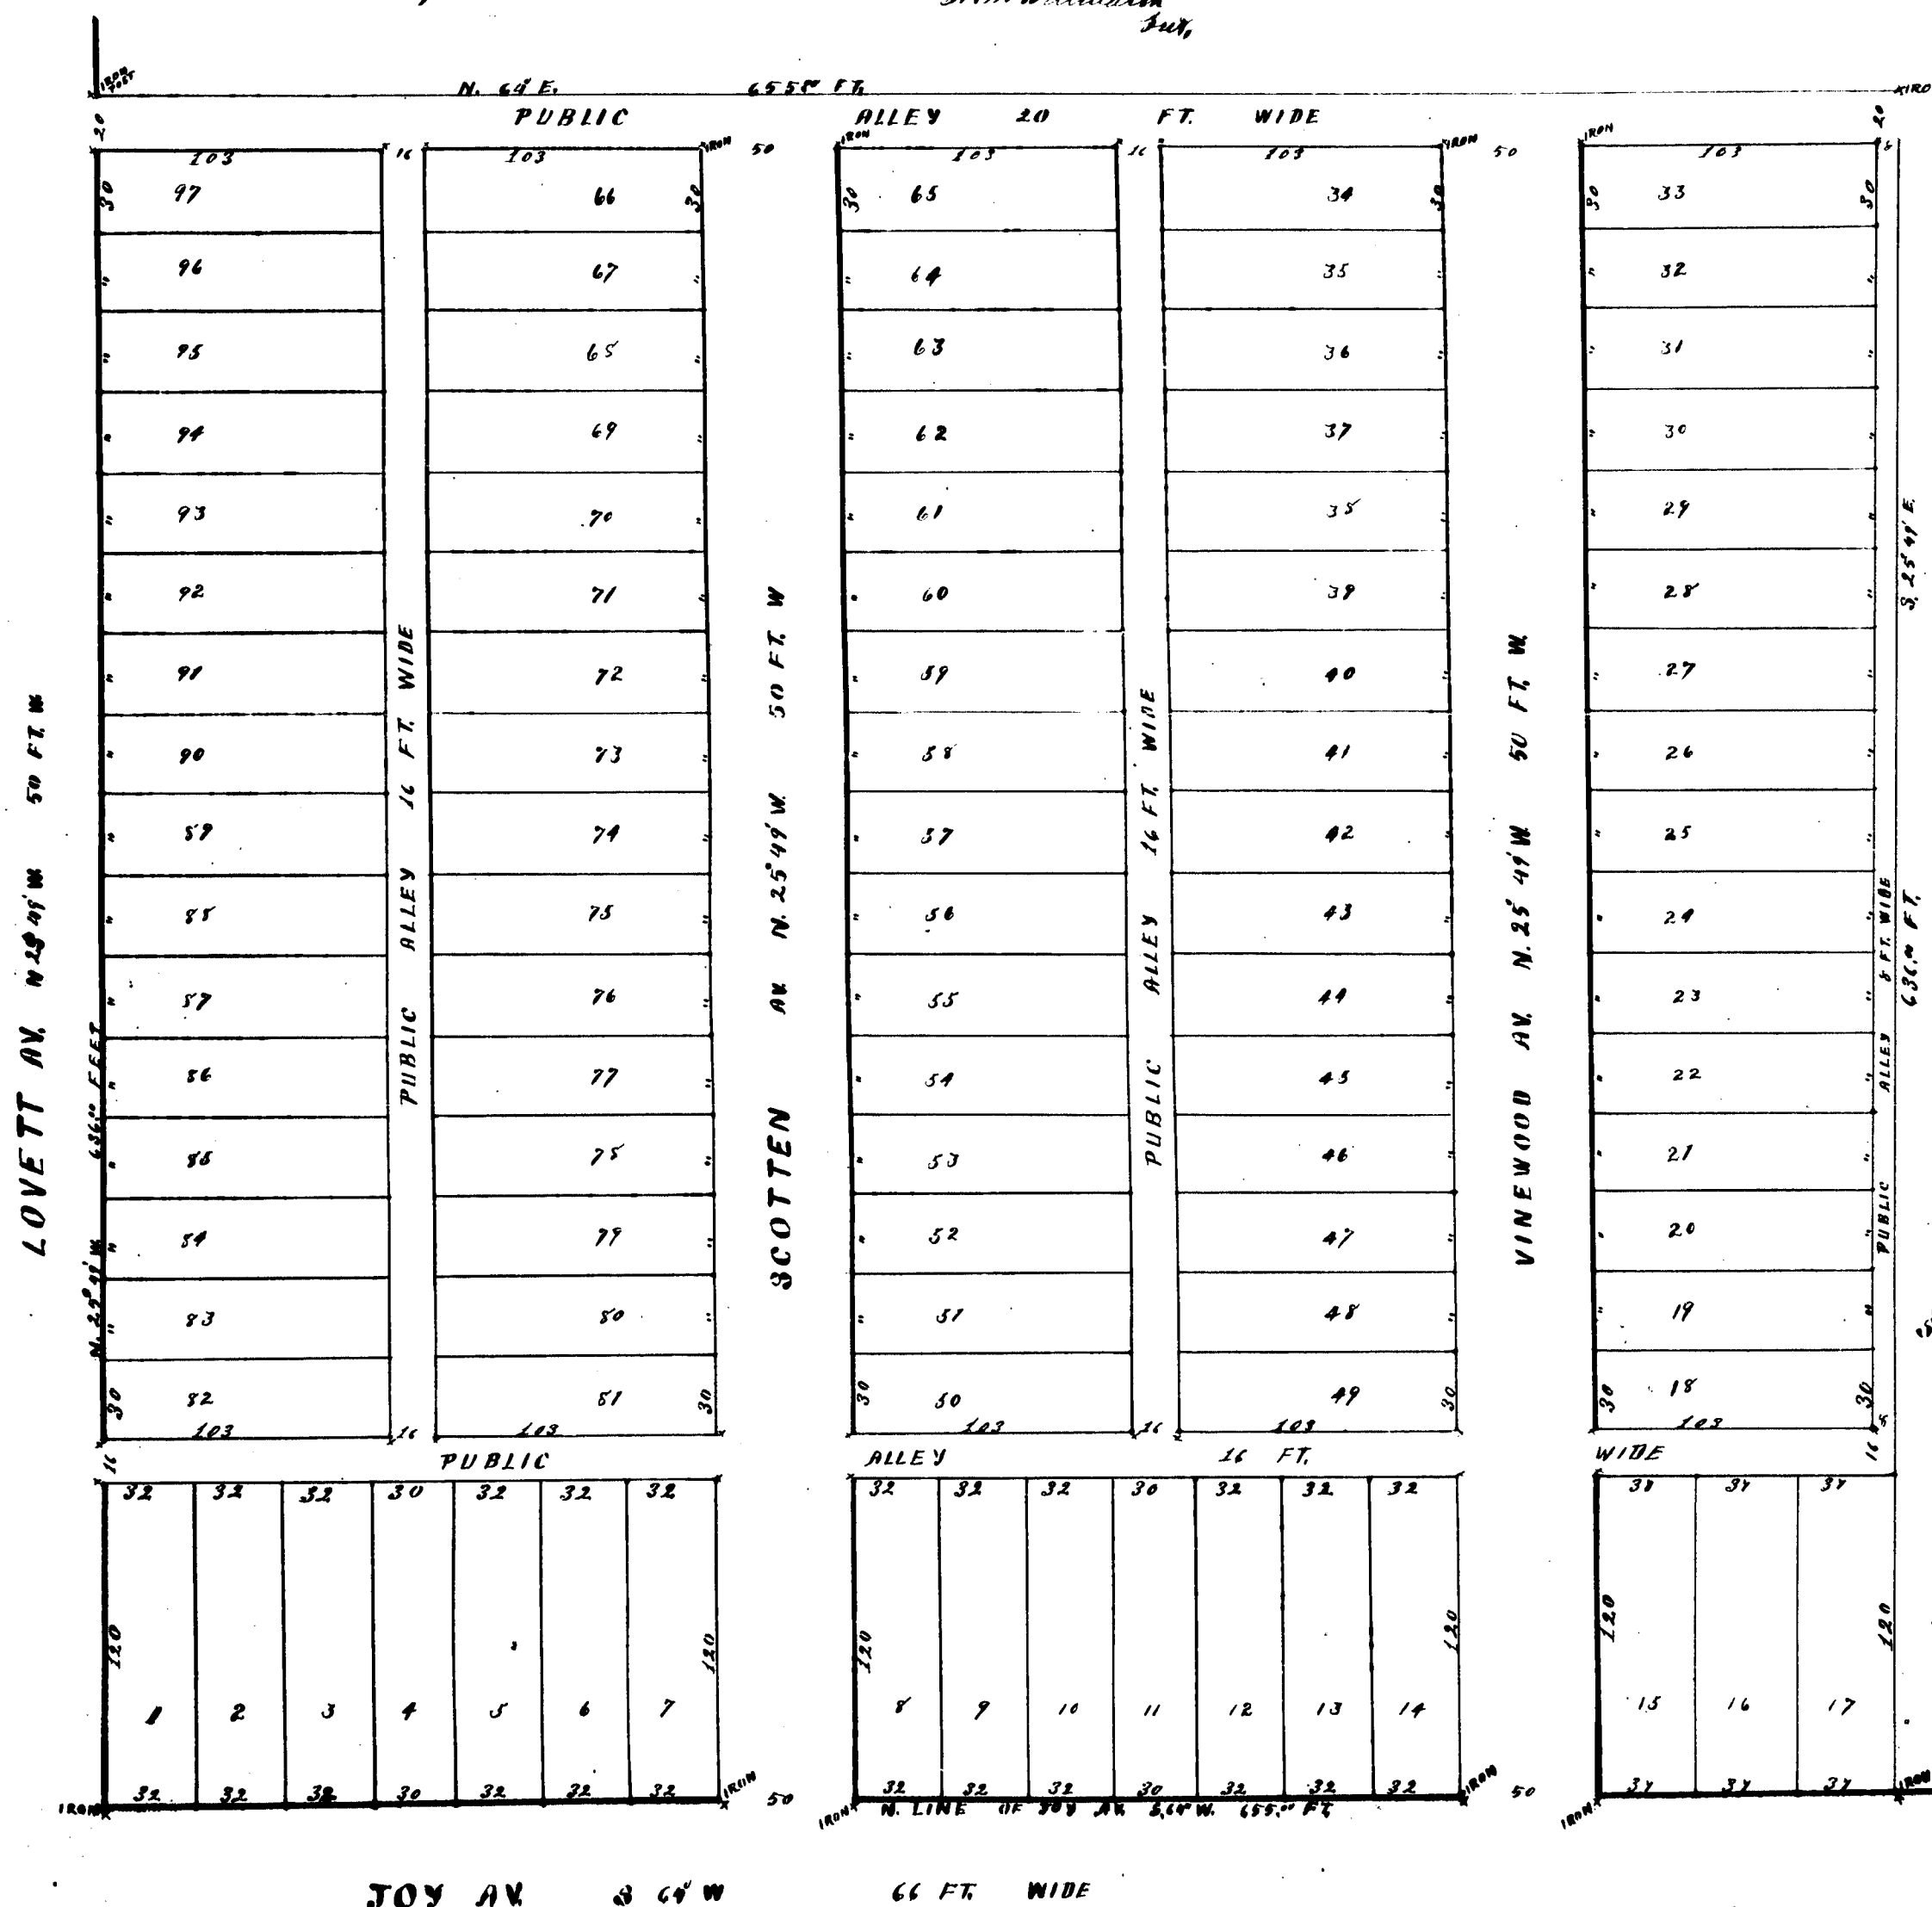

Know All Men by these presents, that we David C. Lewis and Harriet C. Lewis his wife, and Charles M. Crofoot, (single) of Pontiac, Oakland County, Michigan, have caused the land embraced in the annexed plat to be surveyed, laid out and platted, to be known as Lewis and Crofoot's Subdivision on quarter section 32 of the ten thousand acre tract in Greenfield, T. 18. R. 12. E. Wayne County, Michigan, and that the streets and alleys as shown on said plat are hereby dedicated to the use of the public.

Signed and sealed in presence of } David C. Lewis
B. J. Greer } Harriet C. Lewis
Ada F. Hubbard } Charles M. Crofoot

I State of Michigan } ss.
County of Oakland } On this 29th day of April A.D. 1902.
Before me the subscriber a Notary Public in and for said County, personally appeared the above named David C. Lewis and Harriet C. Lewis his wife and Charles M. Crofoot, known to me to be the persons who executed the above dedication and acknowledged the same to be their free act and deed.

Ada F. Hubbard
Notary Public.

Examined and Approved, May 3, 1902.
John F. Wilkinson,
Deputy Auditor General.

I State of Michigan } ss.
County of Wayne } We W. S. Ireland Deputy Register of Deeds, and A. H. Willmarth, Surveyor, hereby certify that we have each carefully compared this copy with the original plat of Lewis and Crofoot's Subdivision, and that it is an exact copy thereof and of the whole of such original map or plat.

W. S. Ireland Deputy Register of Deeds
A. H. Willmarth Surveyor

I State of Michigan } ss.
County of Wayne } We W. S. Ireland Deputy Register of Deeds, and A. H. Willmarth Surveyor, hereby certify that we have each carefully compared the annexed copy with the plat of Lewis and Crofoot's Subdivision now of record in the office of said Register of Deeds, and that it is a true transcript therefrom and of the whole of such record.

W. S. Ireland Deputy Register of Deeds
A. H. Willmarth Surveyor

REGISTER OF DEEDS OFFICE } ss.
WAYNE COUNTY,
The instrument was received for record this 7th day of May 1902 at 10 o'clock A. M. and recorded in Liber. 22 of Deeds, on page 16, as proper certificate was furnished in compliance with Sect. 185, of Senate Bill No. 190 File 212, Act of 1898.


RECEIVED AND FILED
IN AUDITOR GENERAL'S OFFICE

June 30 1902

1256

SHEPARD AND MORSE, S ADDITION TO PLYMOUTH VILLAGE

ON THE NW 1/4 OF SEC. 35 IN T. 38 N. E. WAYNE COUNTY MICHIGAN

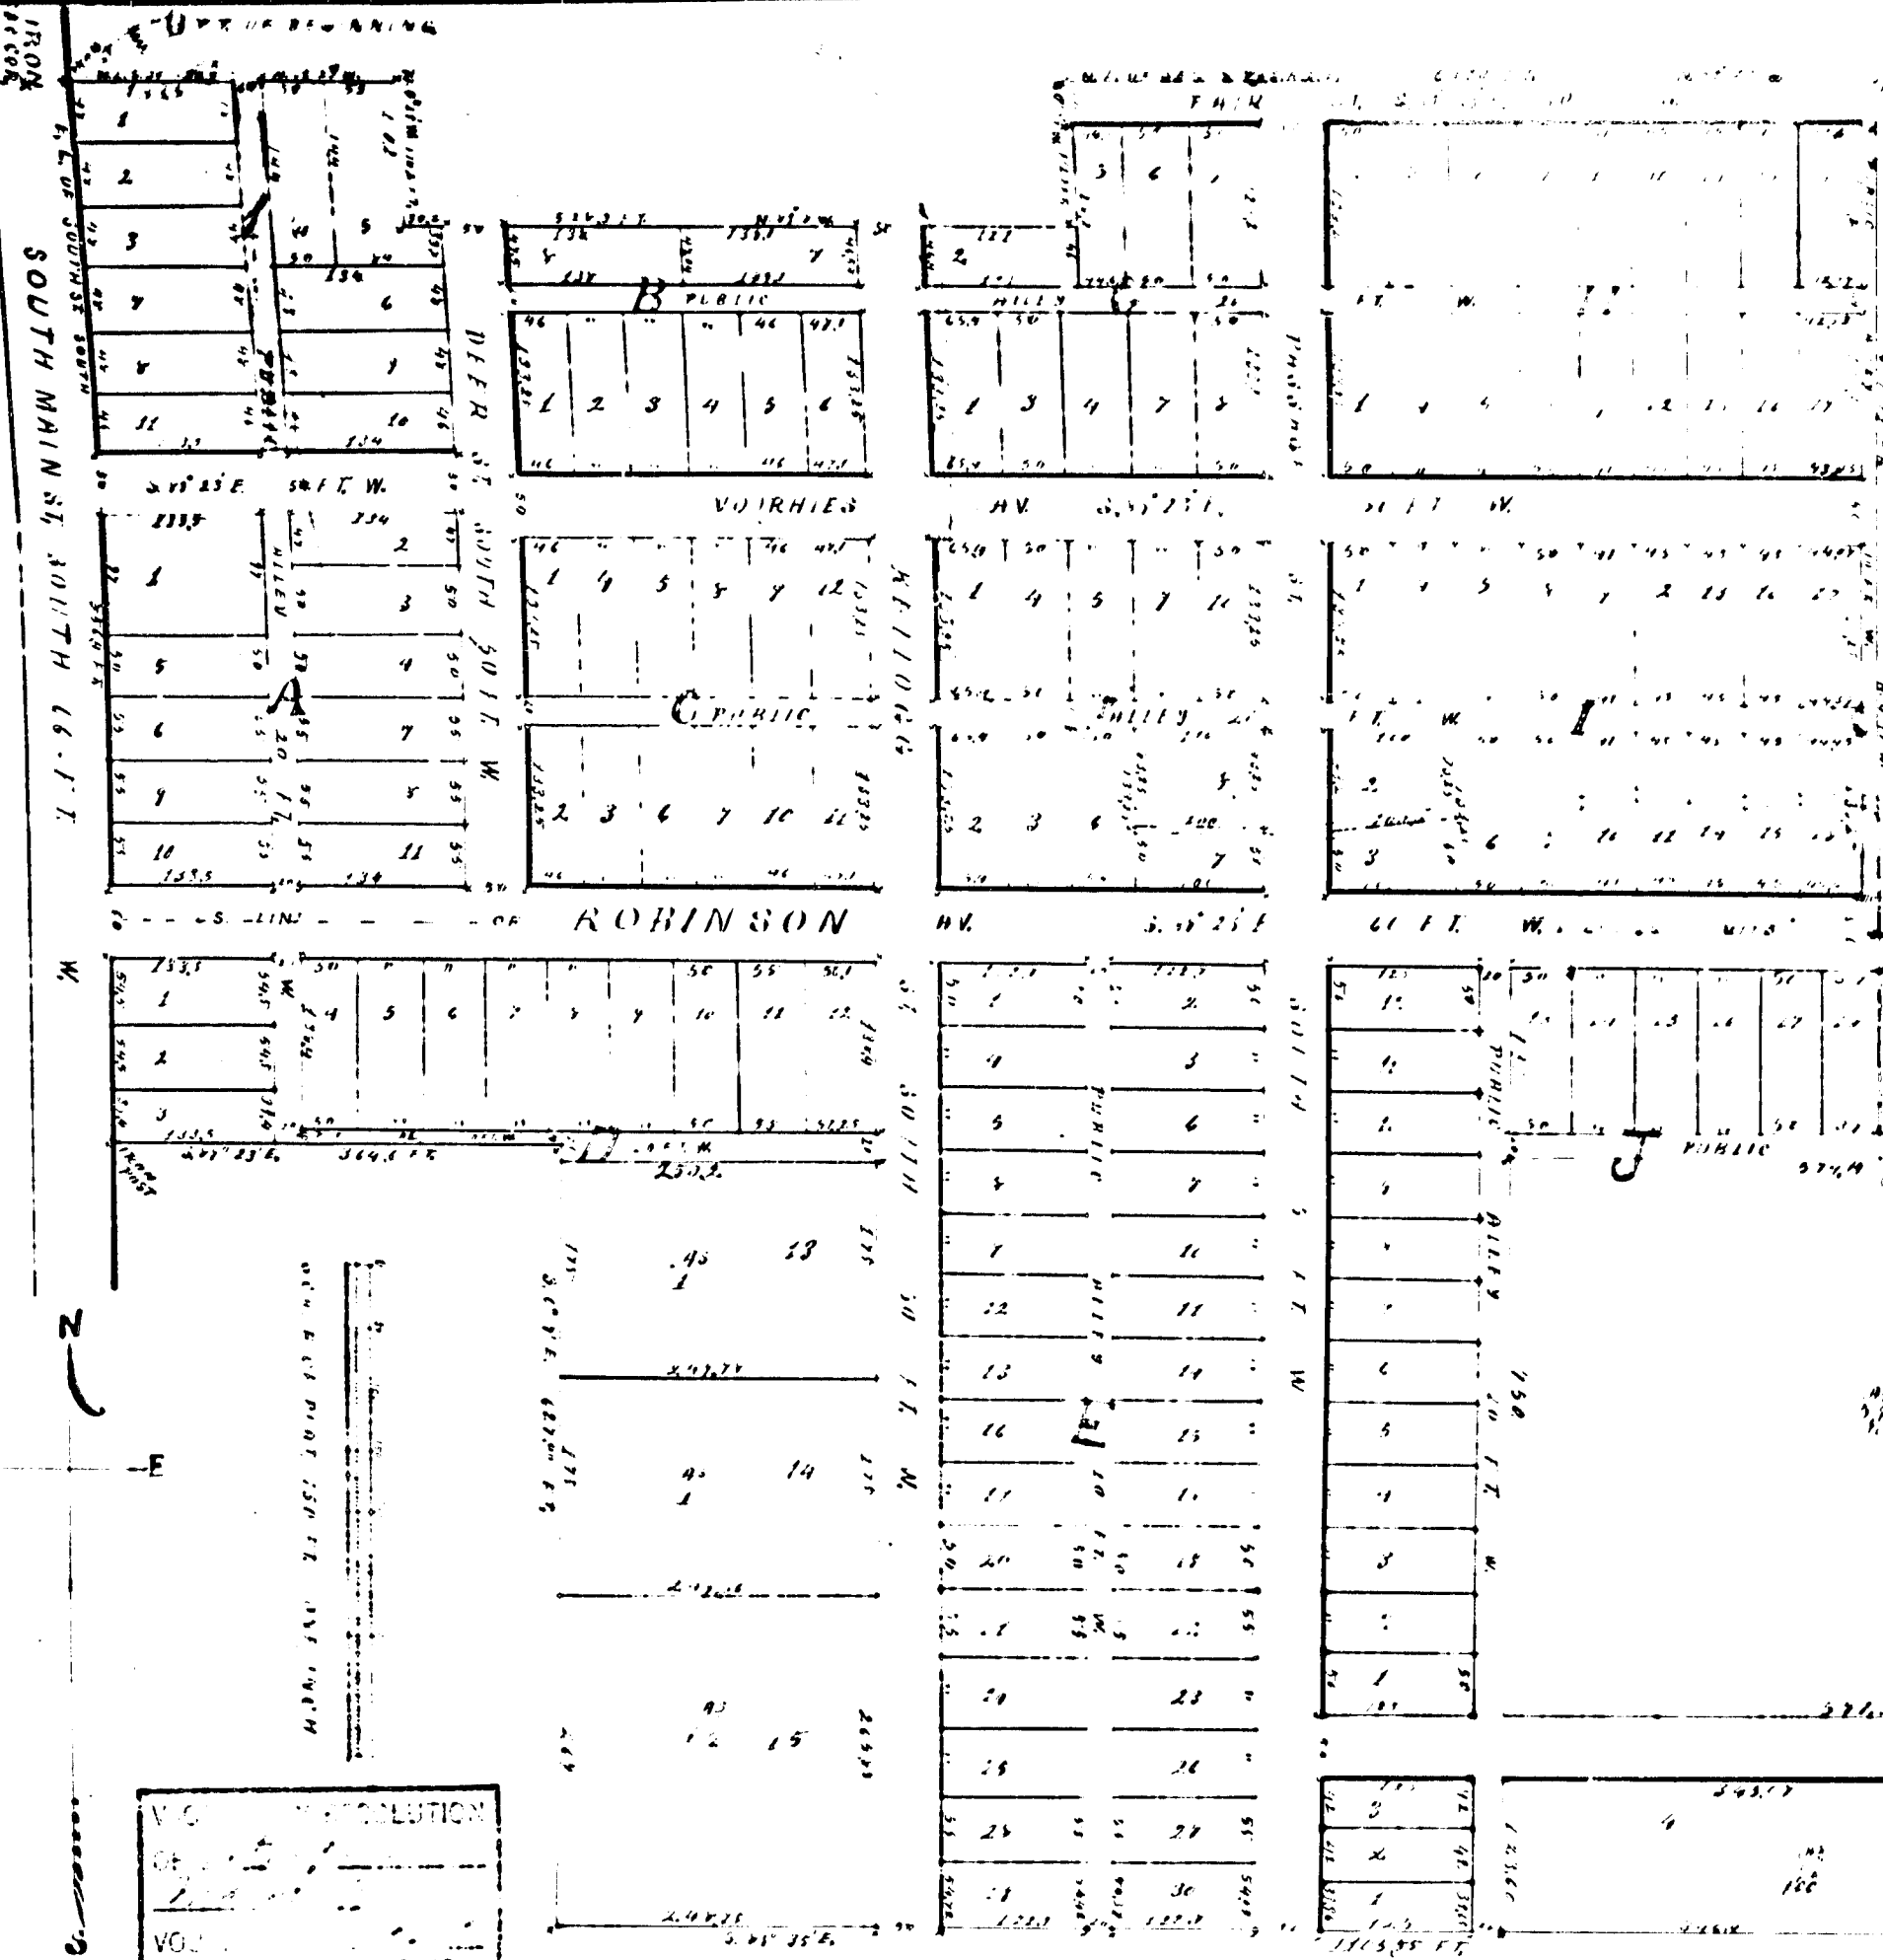



ORDER of VACATION: By order of Circuit Court all of this plat is hereby vacated except parcels A, B, C, D and E. Said parcels are noted on blue print copy, filed on opposite page. Said copy is a new plat of the land included in the vacated portion of the plat January 20, 1921.
Filed August 13, 1921 Voucher No. 330, 1921

Examined and Approved
May 24, 1902
John W. Thompson
County Auditor General

State of Michigan
County of Wayne


REGISTER OF DEEDS OFFICE } ss.
WAYNE COUNTY,
This instrument was received for record this 20th day of January, 1921, at 10 o'clock A. M. and recorded in Liber 2, page 1257, on page 1257, as proper certificate was furnished in compliance with Sec. 135, of Sena Bill No. 100 File 272, Act of 1906.

1257







State of Michigan
County of Wayne


R. H. King, Register of Deeds

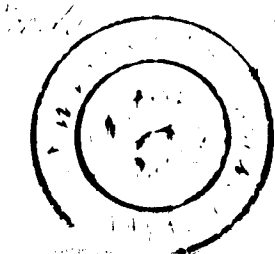



RECEIVED AND FILED,
IN AUDITOR GENERAL'S OFFICE,
JANUARY 30 1921
Auditor General

State of Michigan
County of Wayne


S. W. L. Carter, Auditor General

(25206)