

OF THE VILLAG, E OF

STRENGTH

COMPRISING THE EAST FRACT¹/2 HALF OF SECT

Nº 29 TOWN 14 N OF R.5 E MICHIGAN

DH. FITZHUGH PROPRIETOR

SURVEYED AND DRAWN
By
MERCERT DUNBAR
PART. ONE

BAYCITY

1867

Scale down to an inch





[illegible]

Wm. H. Fitzhugh & Co.

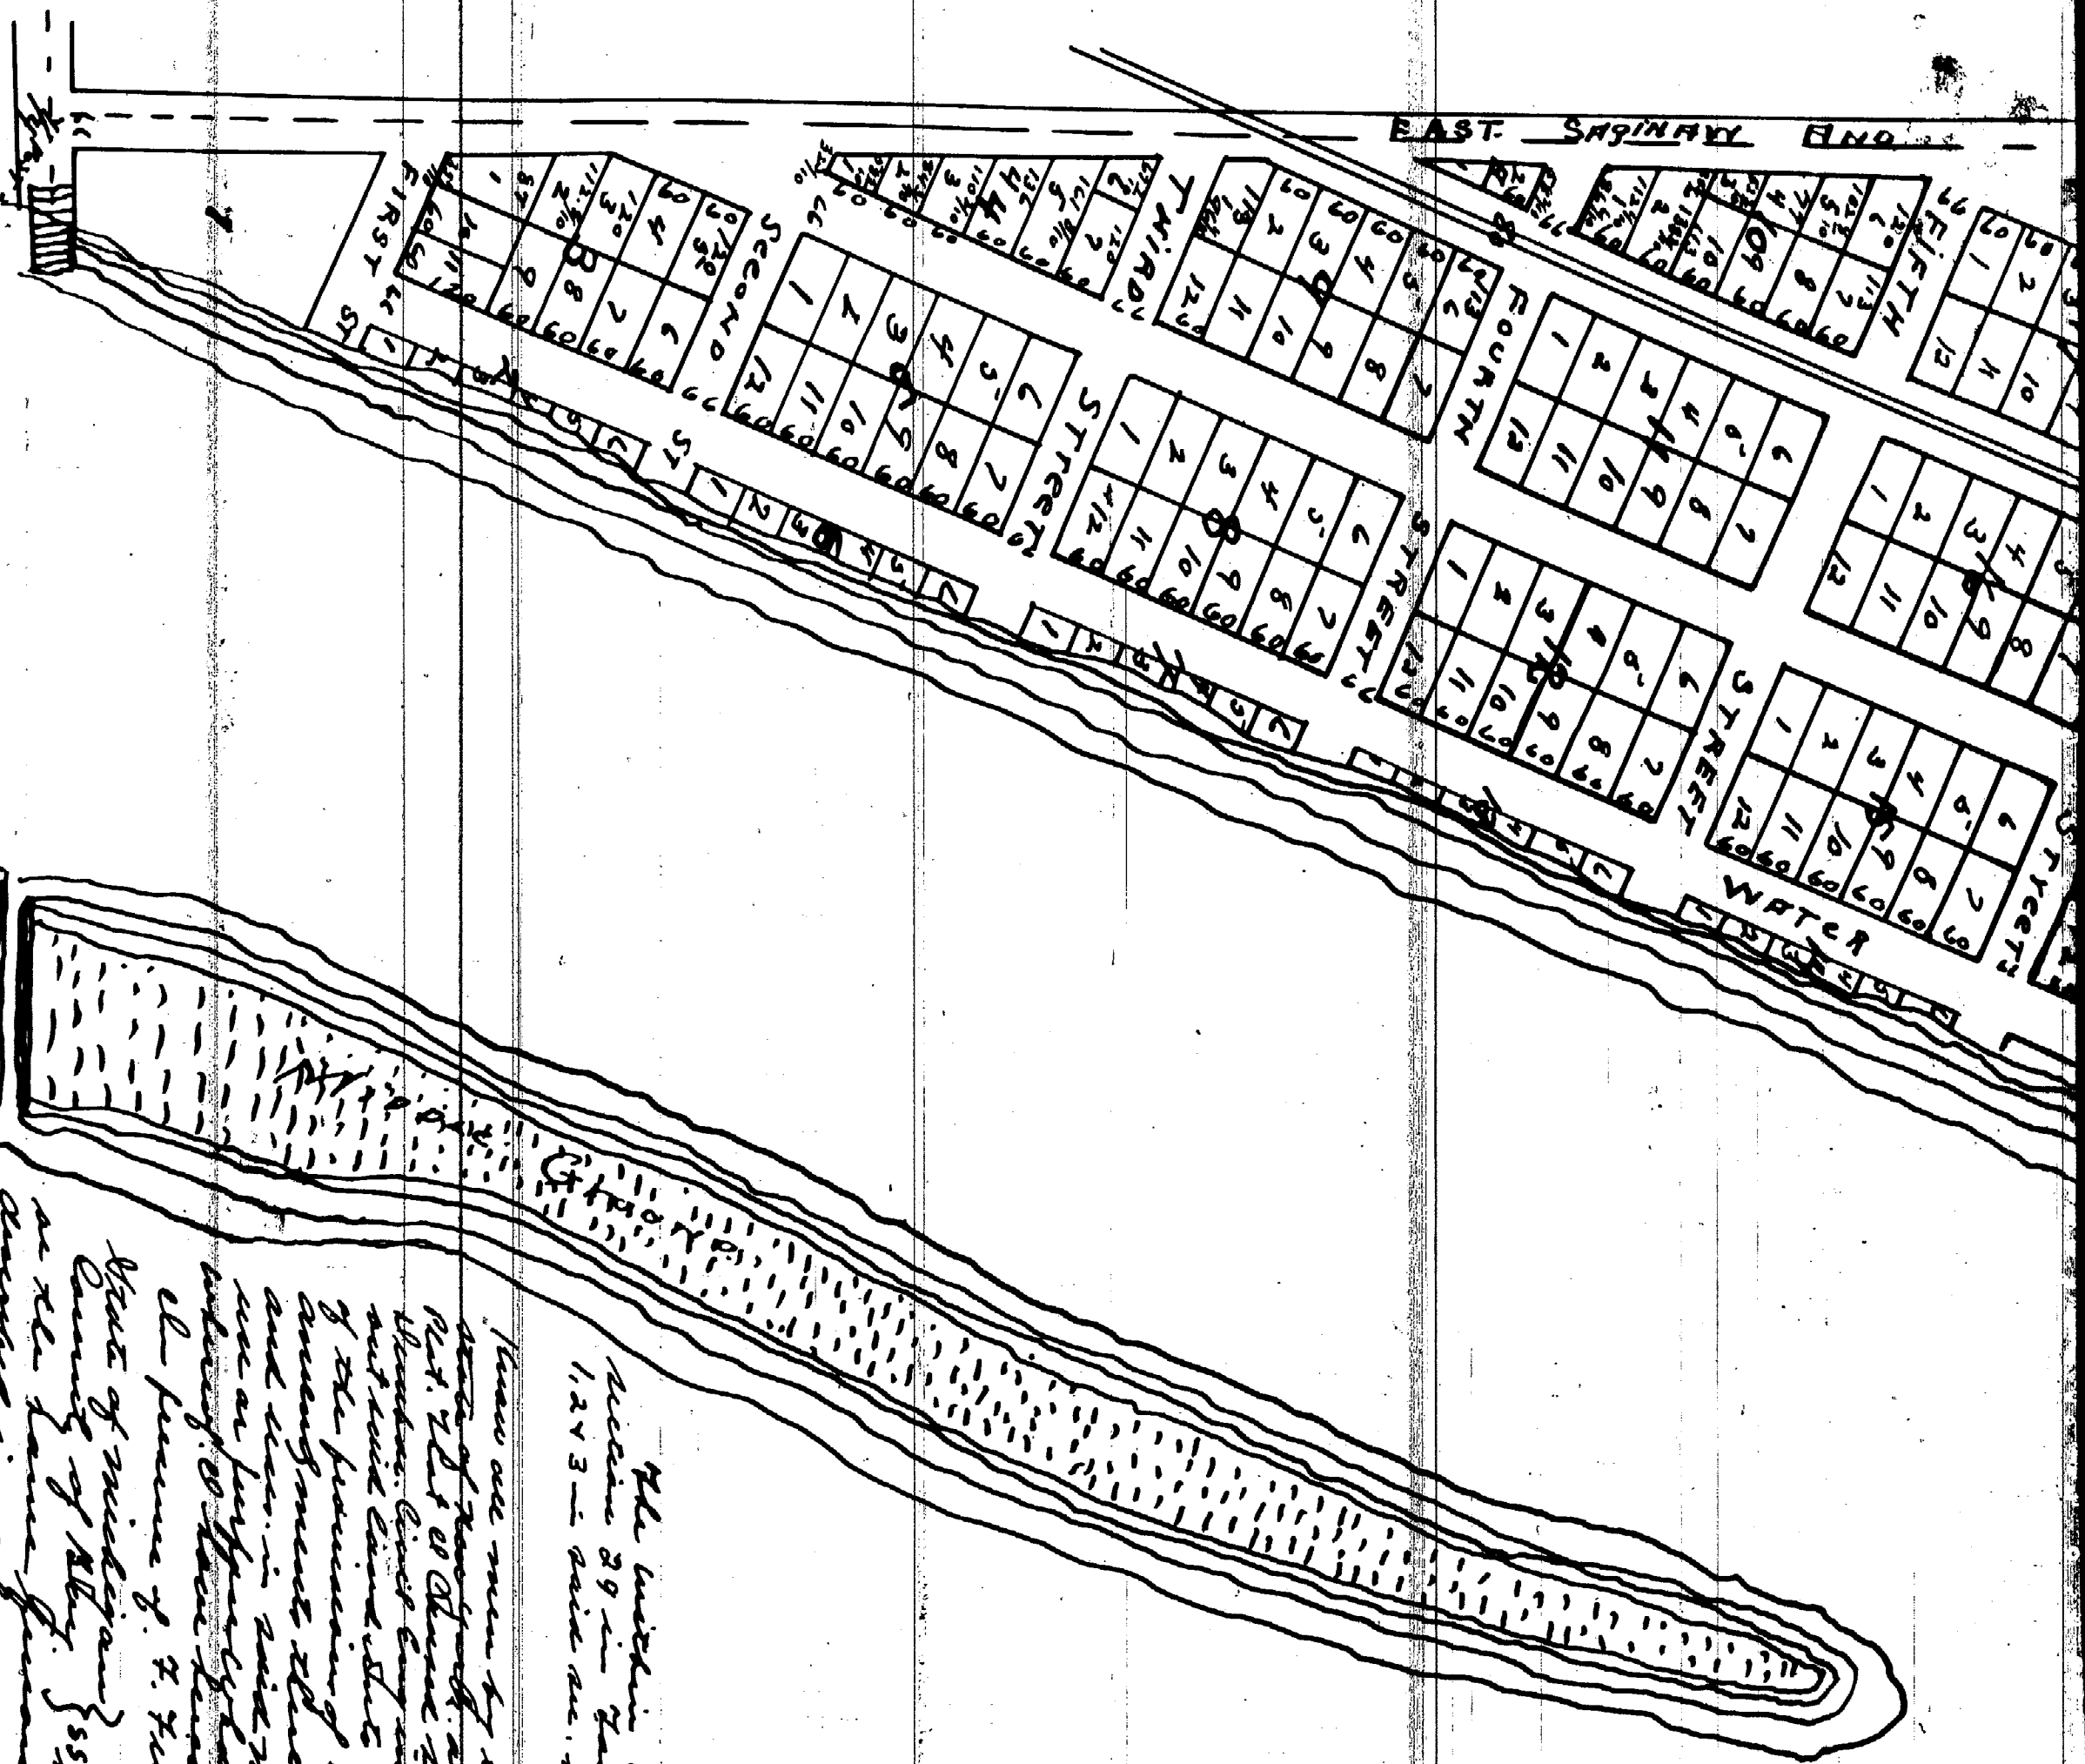[illegible]



July 6, 1983

Department of Treasury
Bureau of Local Government Services
2nd Floor, Treasury Building
Lansing, Michigan 48922

Gentlemen:

Pursuant to Section 256 of the new Subdivision Act of 267 (Public Act 288), we herewith submit a certified copy of the resolution certifying the vacation of Crump Street between Henry Street and the west right-of-way line of the Grand Trunk and Western Railroad. This section of street is located in the Village of Salzburg.

A sketch from the Planning Office which identifies the area affected is also attached.

Sincerely,

CITY OF BAY CITY

Walter Wozniak, Jr.
Walter Wozniak, Jr.
City Clerk

WW:cd

Att.

12612
12608
City of Bay City

301 WASHINGTON AVE.
BAY CITY, MICHIGAN 48706
AREA CODE 517 - 894-8200

CL8-3c

12612
12608
LIBER 939 PAGE 413
CITY OF BAY CITY, MICH.
OFFICE OF CITY CLERK
(AFFIDAVIT)

STATE OF MICHIGAN
COUNTY OF BAY
CITY OF BAY CITY

I, Walter Wozniak, Jr., Clerk of the City of Bay City, County and State aforesaid, Do hereby Certify, that I have compared the annexed excerpt from the regular meeting of the City Commission of the City of Bay City held June 21, 1982

with the original on file in this office and that it is a true and correct transcript therefrom and of the whole of such original.

In Witness Whereof, I have hereunto set my hand affixed the Corporate Seal of the City of Bay City, Mich., this

14th day of June 19 83


Walter Wozniak, Jr.
Walter Wozniak, Jr., City Clerk



Of the City Planner:
Whereas, the City Commission on July 7, 1980, vacated Crump Street between Henry Street and the west right-of-way line of the Grand Trunk and Western Railroad, and
Whereas, said vacation resolution contained a condition that the vacation not become final until it is certified that John F. Kennedy Drive will be constructed to South Henry Street, and
Whereas, said road extension is now under construction, and
Whereas, traffic will be using this road on or before August 1, 1982.
It is Hereby Certified that the July 7, 1980, condition has been met with Crump Street to be vacated as of August 1, 1982. Received.

1983 JUN 28 PM 3:41
REGISTER OF DEEDS
BAY COUNTY, MICHIGAN
Walter Wozniak, Jr.

RECORDED

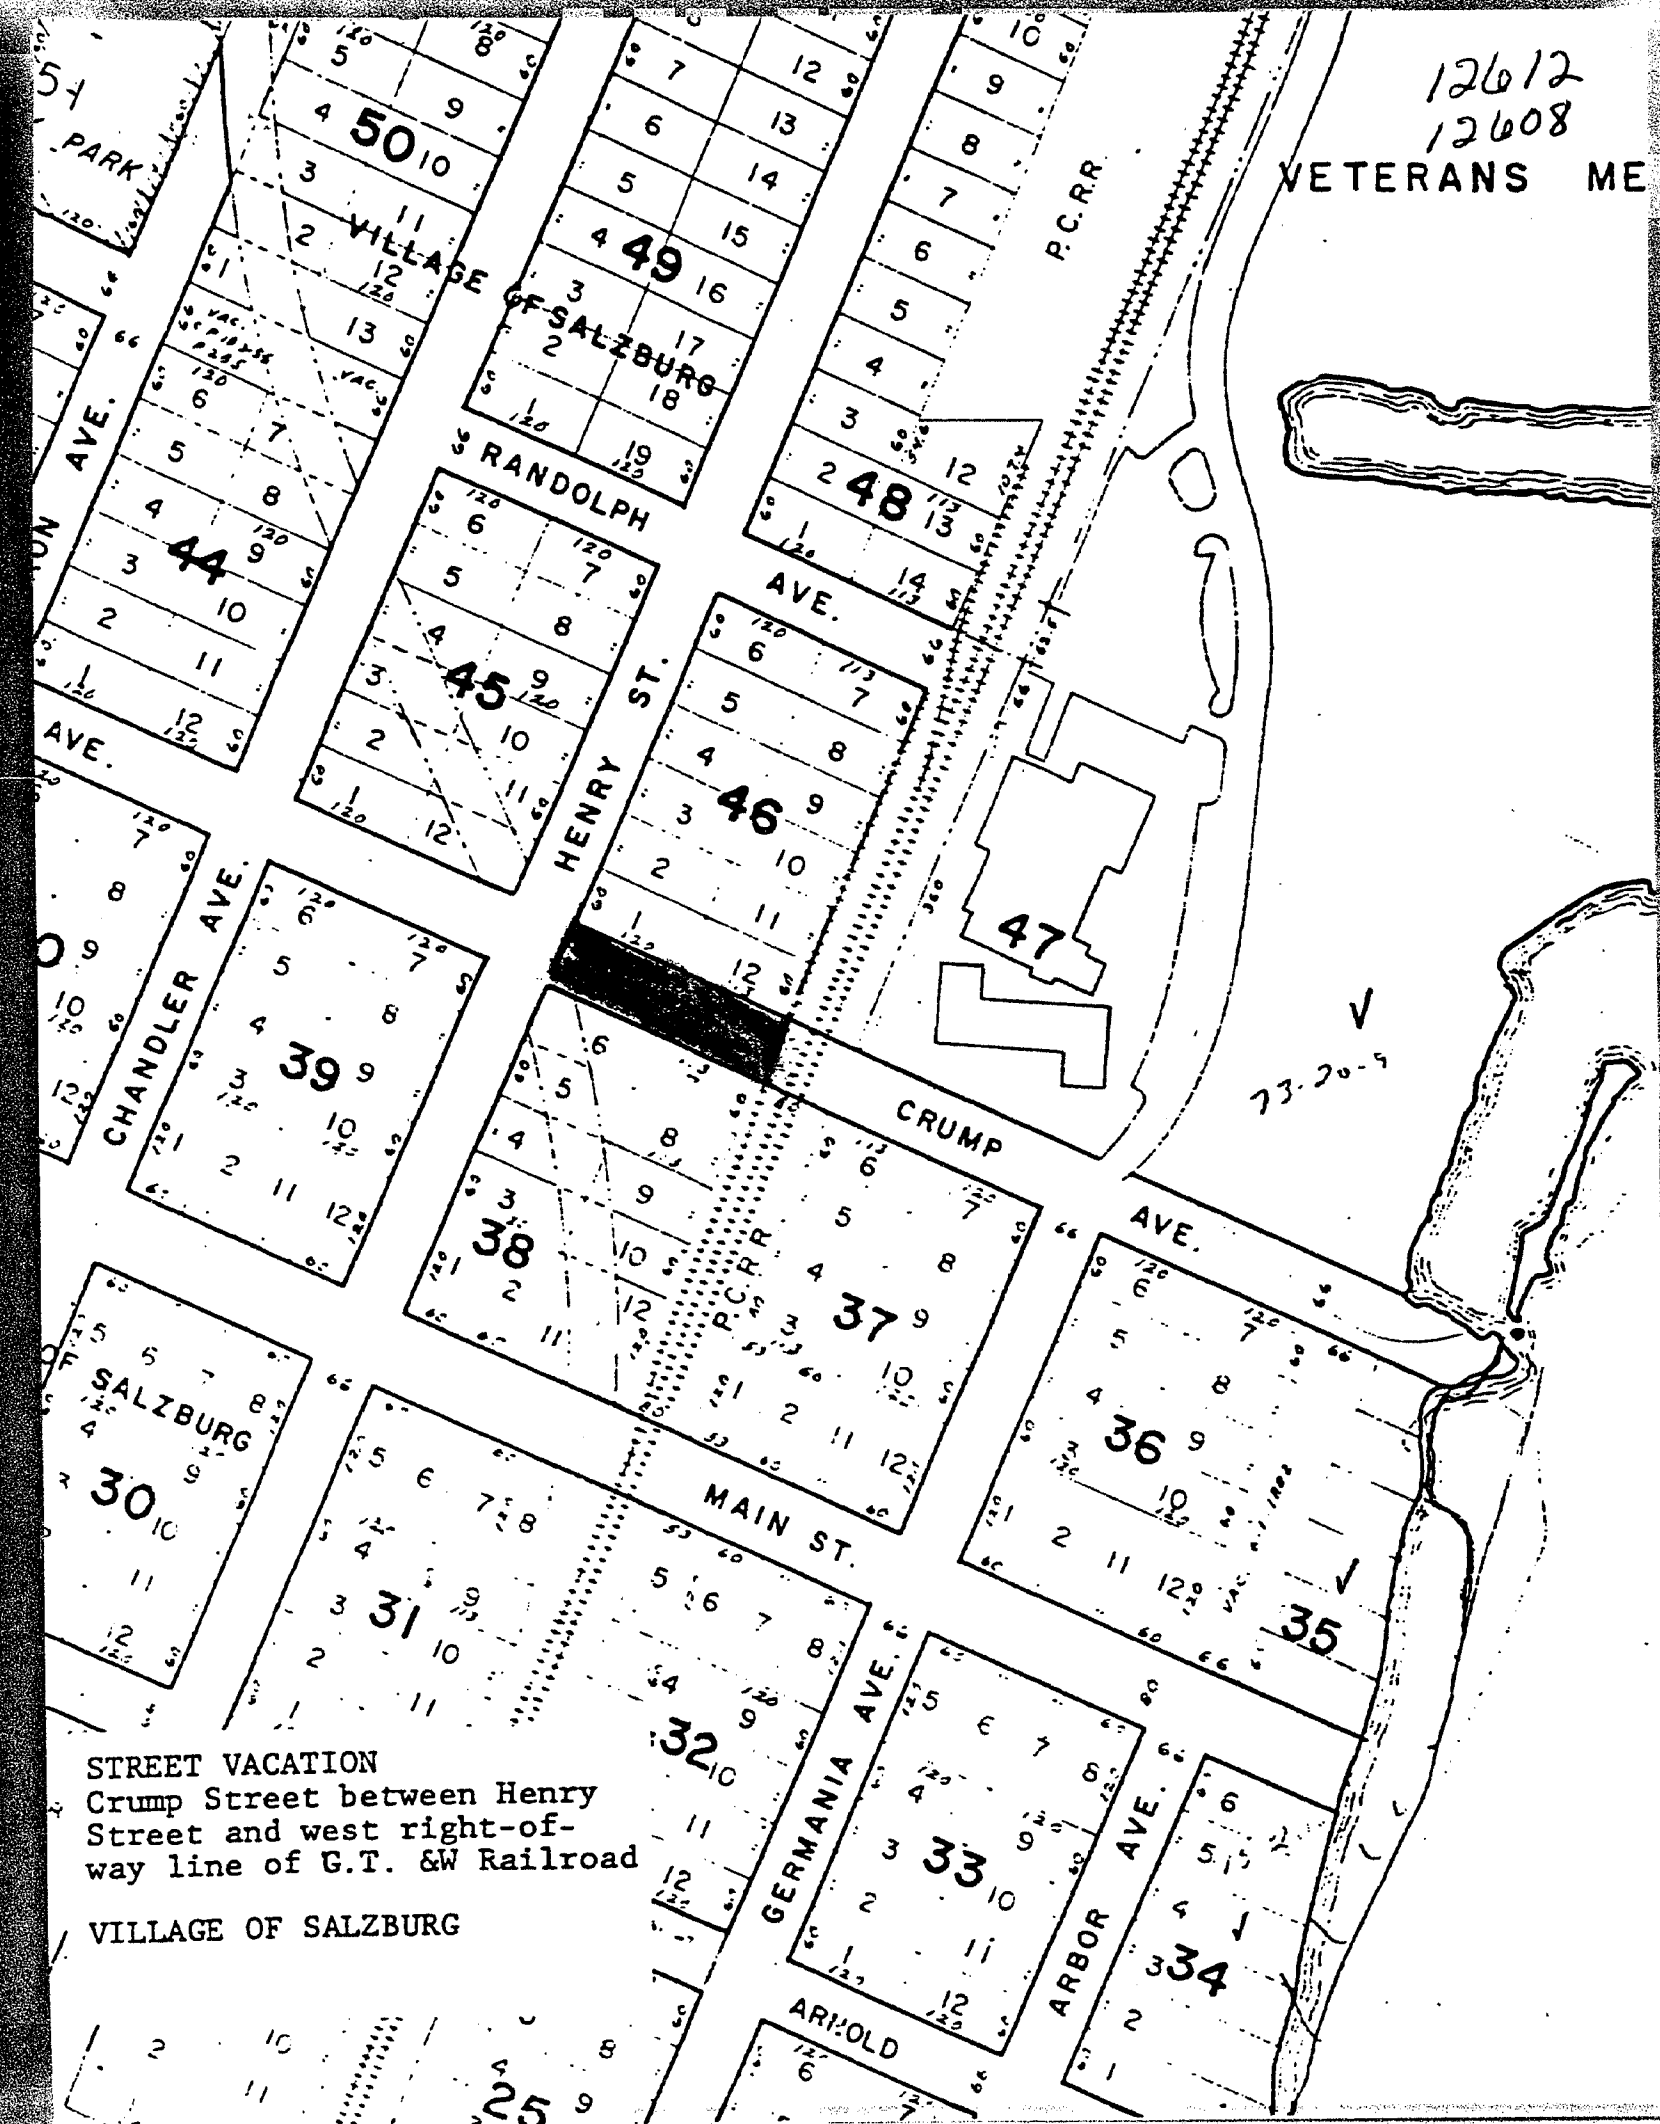



12612
12608
City of Bay City

301 WASHINGTON AVE.
BAY CITY, MICHIGAN 48706
AREA CODE 517 - 894-8200

June 28, 1983

Department of Treasury
Bureau of Local Government Services
2nd Floor, Treasury Building
Lansing, Michigan 48922

Gentlemen:

Pursuant to Section 256 of the new Subdivision Act of 267 (Public Act 288), we herewith submit a certified copy of the resolution vacating Crump Street between the east right-of-way line of Grand Trunk Western Railroad and the west right-of-way line of Germania Avenue. This section of street is located in the Village of Salzburg.

A sketch from the Planning Office which identifies the area affected is also attached.

Sincerely,

CITY OF BAY CITY

Walter Wozniak, Jr.
Walter Wozniak, Jr.
City Clerk

WW:cd

Att.

CLB-3c

LIBER 938 PAGE 230
CITY OF BAY CITY, MICH.
OFFICE OF CITY CLERK
(AFFIDAVIT)

5415080 03.00

12612
12608

STATE OF MICHIGAN

COUNTY OF BAY
CITY OF BAY CITY

I, Walter Wozniak, Jr., Clerk of the City of Bay City, County and State aforesaid, Do hereby Certify, that I have compared the annexed excerpt from the regular meeting of the City Commission of the City of Bay City held September 20, 1982

with the original on file in this office and that it is a true and correct transcript therefrom and of the whole of such original.

In Witness Whereof, I have hereunto set my hand affixed the Corporate Seal of the City of Bay City, Mich., this

14th day of June 19 83

Walter Wozniak, Jr.
Walter Wozniak, Jr., City Clerk

SPECIAL ORDER
Of Commission as a Whole:

Whereas, the Planning Commission held a public hearing to consider vacating Crump Street between the west right-of-way line of the Grand Trunk Western Railroad and the west right-of-way line of Germania Avenue, and

Whereas, the Planning Commission recommended that same be closed and vacated, and

Whereas, a resolution was adopted by the City Commission on August 9, 1982, ordering publication of notices and the holding of a hearing, said notices having been published in the Bay City Democrat, the official newspaper of the City of Bay City, on August 19, 26, and September 2 and 9, 1982, relative to the aforesaid hearing and certified notices thereof having been mailed to the public utilities and abutting property owners, and

Whereas, a public hearing was held by the City Commission on September 20, 1982, relative to the aforesaid petition for said vacation.

Now, Therefore, Be It Resolved and Ordered, by the City Commission that:

Crump Street between the west right-of-way line of the Grand Trunk Western Railroad and the west right-of-way line of Germania Avenue

be and hereby is closed with utility easements being retained.


Rules Suspended
Commissioner Baird moved to suspend the rules and interested persons in the audience be permitted to speak. There was no objection. No one appeared.

Commissioner Baird moved to amend the resolution to read "between the east right-of-way line of the Grand Trunk Western Railroad" in paragraph one and amend the last paragraph to read "Crump Street between the east right-of-way line of the Grand Trunk Western Railroad" and to approve the resolution to close Crump Street with utility easements being retained as amended. There was no objection to amendments.

Resolution as amended adopted by the following vote —

Yes: Commissioners Sullivan, Vandervill, Mochrie, Ludwig, Laskowski, Martindale, Baird, Sutter, Hartman, 9.

No: None.

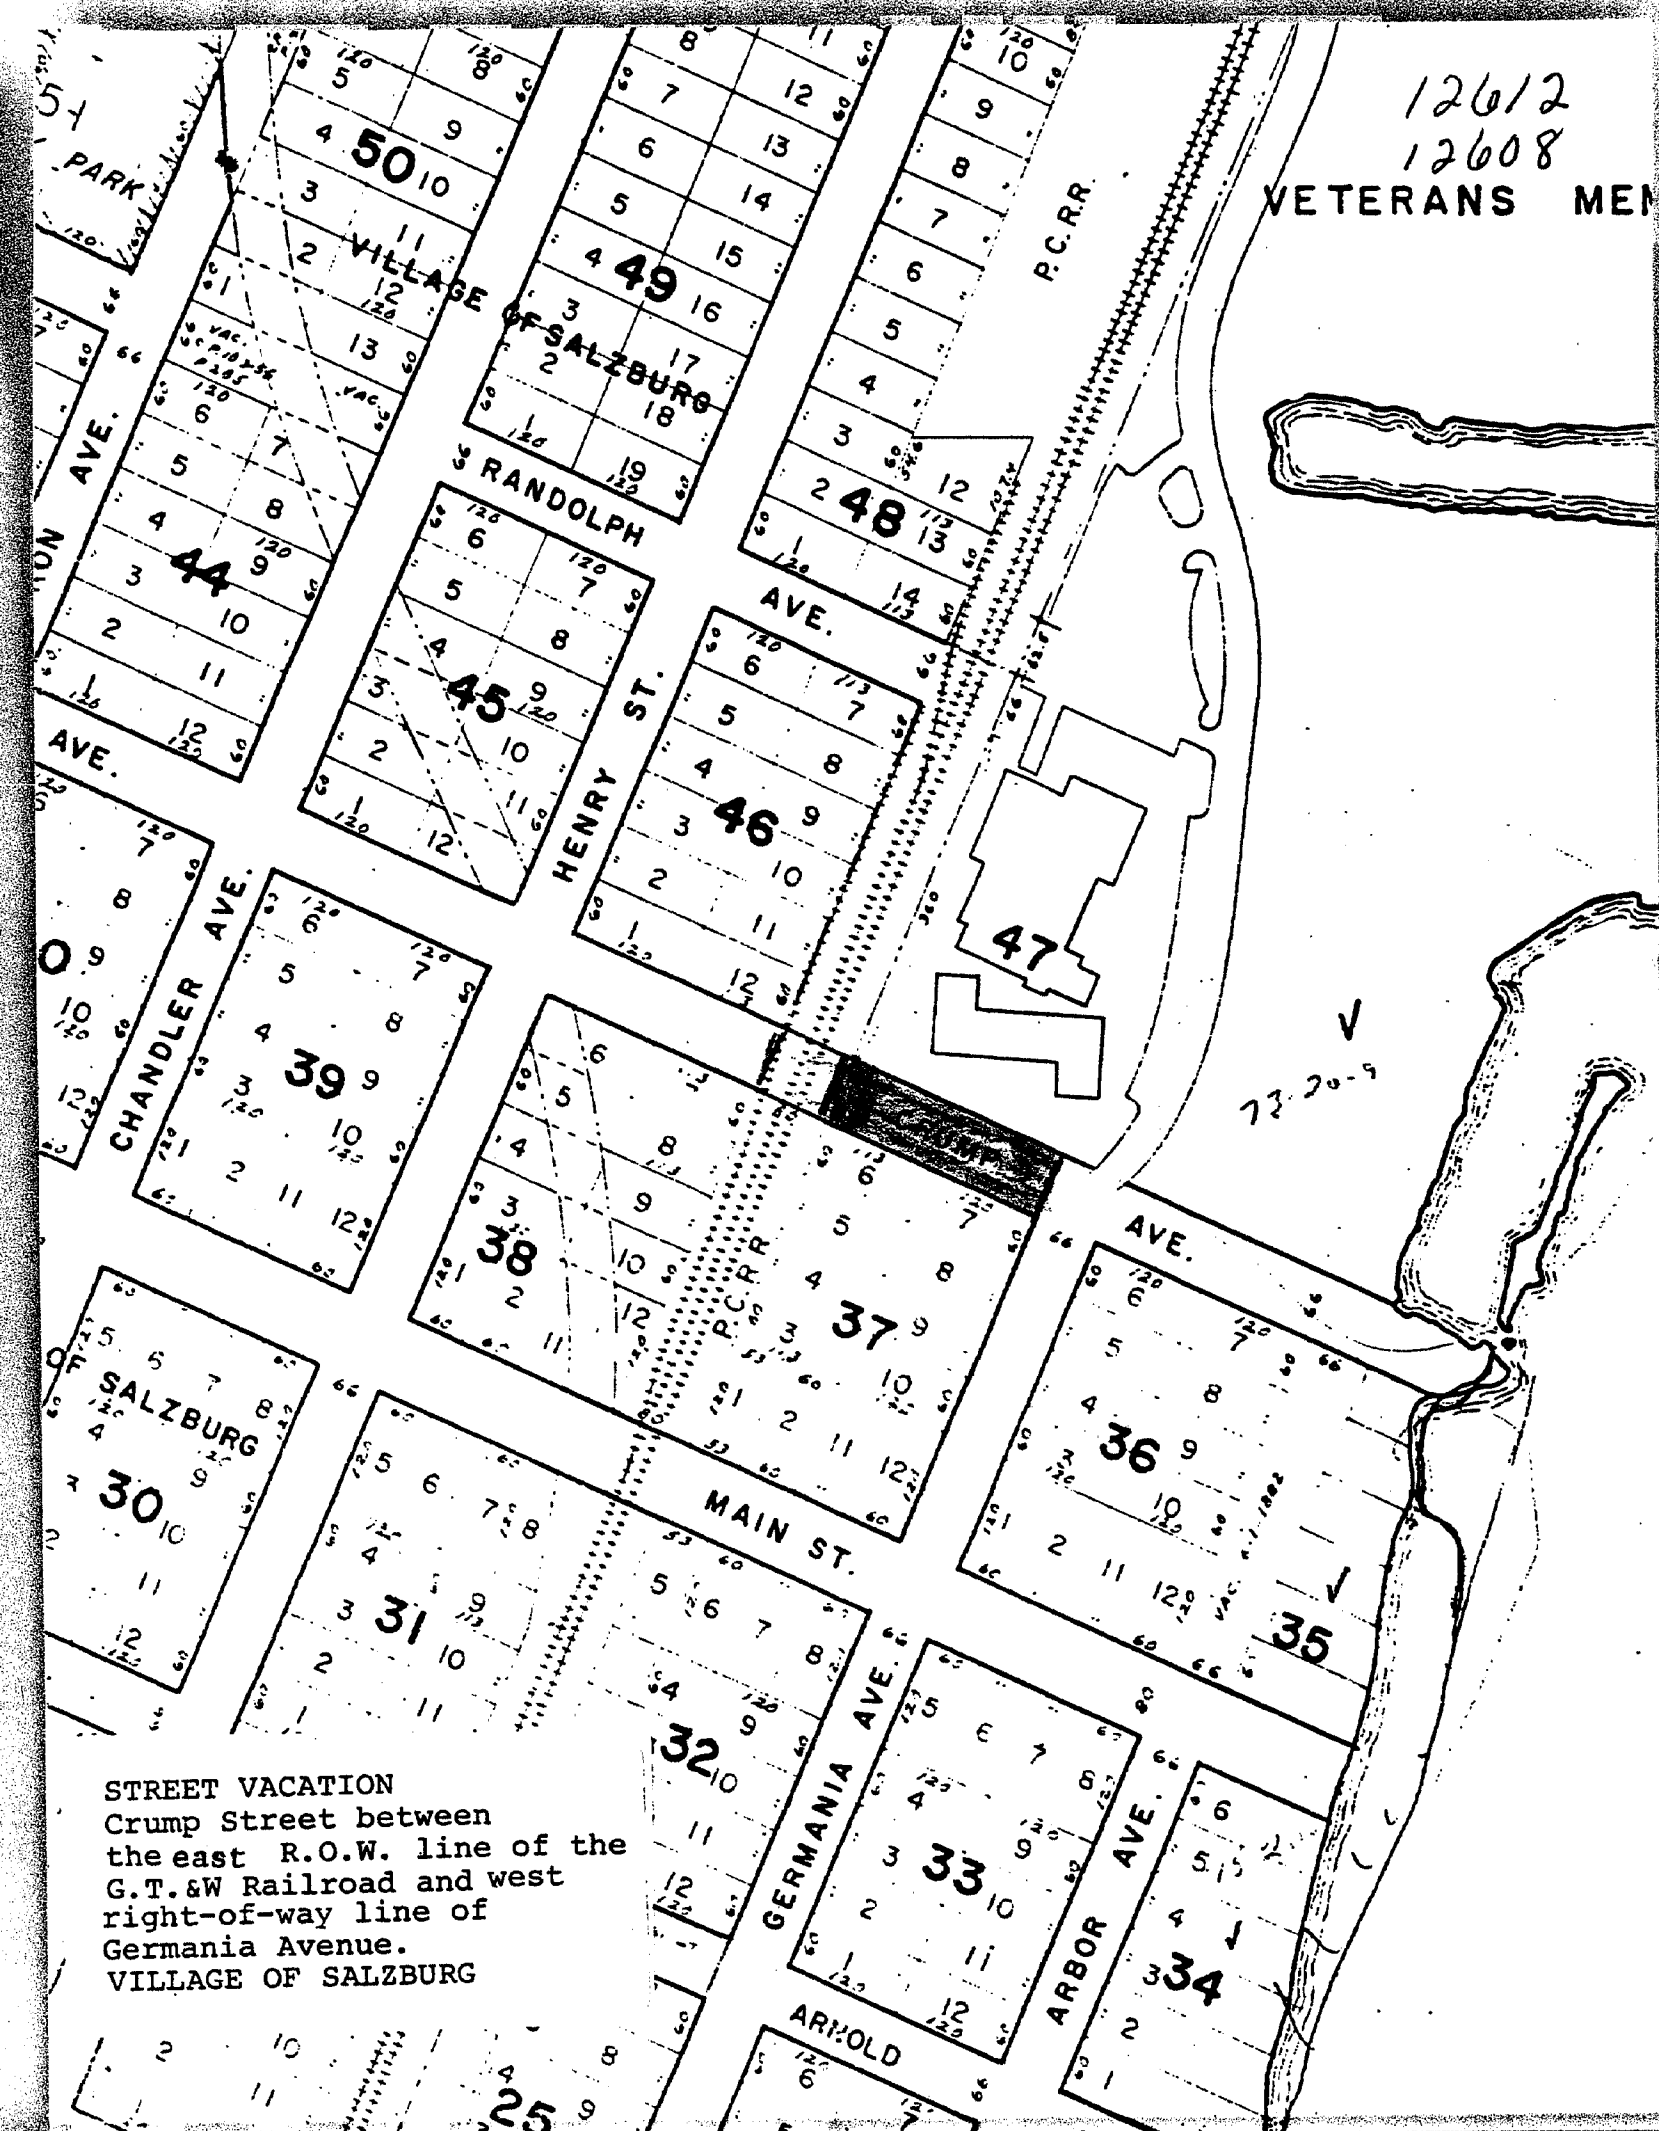



12612
12608
CITY OF BAY CITY
BAY CITY, MICHIGAN 48706
Area Code 517 894-8200

April 19, 1982

Department of Treasury
Bureau of Local Government Services
2nd Floor, Treasury Building
Lansing, Michigan 48922

Gentlemen:

Pursuant to Section 256 of the new Subdivision Act of 267 (Public Act 288), we herewith submit a certified copy of the resolution closing South Arbor Street between East Main Street and East Crump Avenue. The portion of the street is located in the Village of Salzburg.

A sketch from the Planning Office which identifies the area affected is also herewith attached.

Sincerely,

CITY OF BAY CITY

Walter Wozniak, Jr.
Walter Wozniak, Jr.
City Clerk

WW/ems
Enclosures

CL8-3c

12612
12608
MAR 26 PM 12:55
RECEIVED
CITY OF BAY CITY, MICH.
OFFICE OF CITY CLERK
(AFFIDAVIT)

STATE OF MICHIGAN
COUNTY OF BAY
CITY OF BAY CITY

I, Walter Wozniak, Jr. Clerk of the City of Bay
City, County and State aforesaid, Do hereby Certify, that I have compared the
annexed excerpt from the regular meeting of the City Commission of Bay City
held March 8, 1982

with the original on file in this office and that it is a true and correct
transcript therefrom and of the whole of such original.


In Witness Whereof, I have hereunto set my hand affixed the
Corporate Seal of the City of Bay City, Mich., this

25th day of March 19 82

Walter Wozniak, Jr.
City Clerk

SPECIAL ORDER
Of Commission as a Whole:
Whereas, the Planning Commission held a public hearing to consider vacating South Arbor Avenue between East Main Street and East Crump Avenue, and
Whereas, the Planning Commission recommended that same be closed and vacated, and
Whereas, a resolution was adopted by the City Commission on February 1, 1982, ordering publication of notices and the holding of a hearing, said notices having been published in the Bay City Democrat, the official newspaper of the City of Bay City, on February 11, 18, 25 and March 4, 1982, relative to the aforesaid hearing and certified notices thereof having been mailed to the public utilities and abutting property owners, and
Whereas, a public hearing was held by the City Commission on March 8, 1982, relative to the aforesaid vacation.
Now, Therefore, Be It Resolved And Ordered by the City Commission that:
South Arbor Street between East Main Street and East Crump Avenue be and hereby is closed.

PUBLIC HEARING
Commissioner Laskowski moved to suspend the rules to permit any interested persons in the audience to be heard regarding the vacating of South Arbor between East Main Street and East Crump Avenue. There was no objection. No one appeared.
Commissioner Laskowski moved adoption of resolution to vacate the street.
Adopted by the following vote —
Yes, Commissioners Sullivan, Vanderwill, Ludwig, Laskowski, Martindale, Baird, Sutter, Hartman, 8.
No, None.

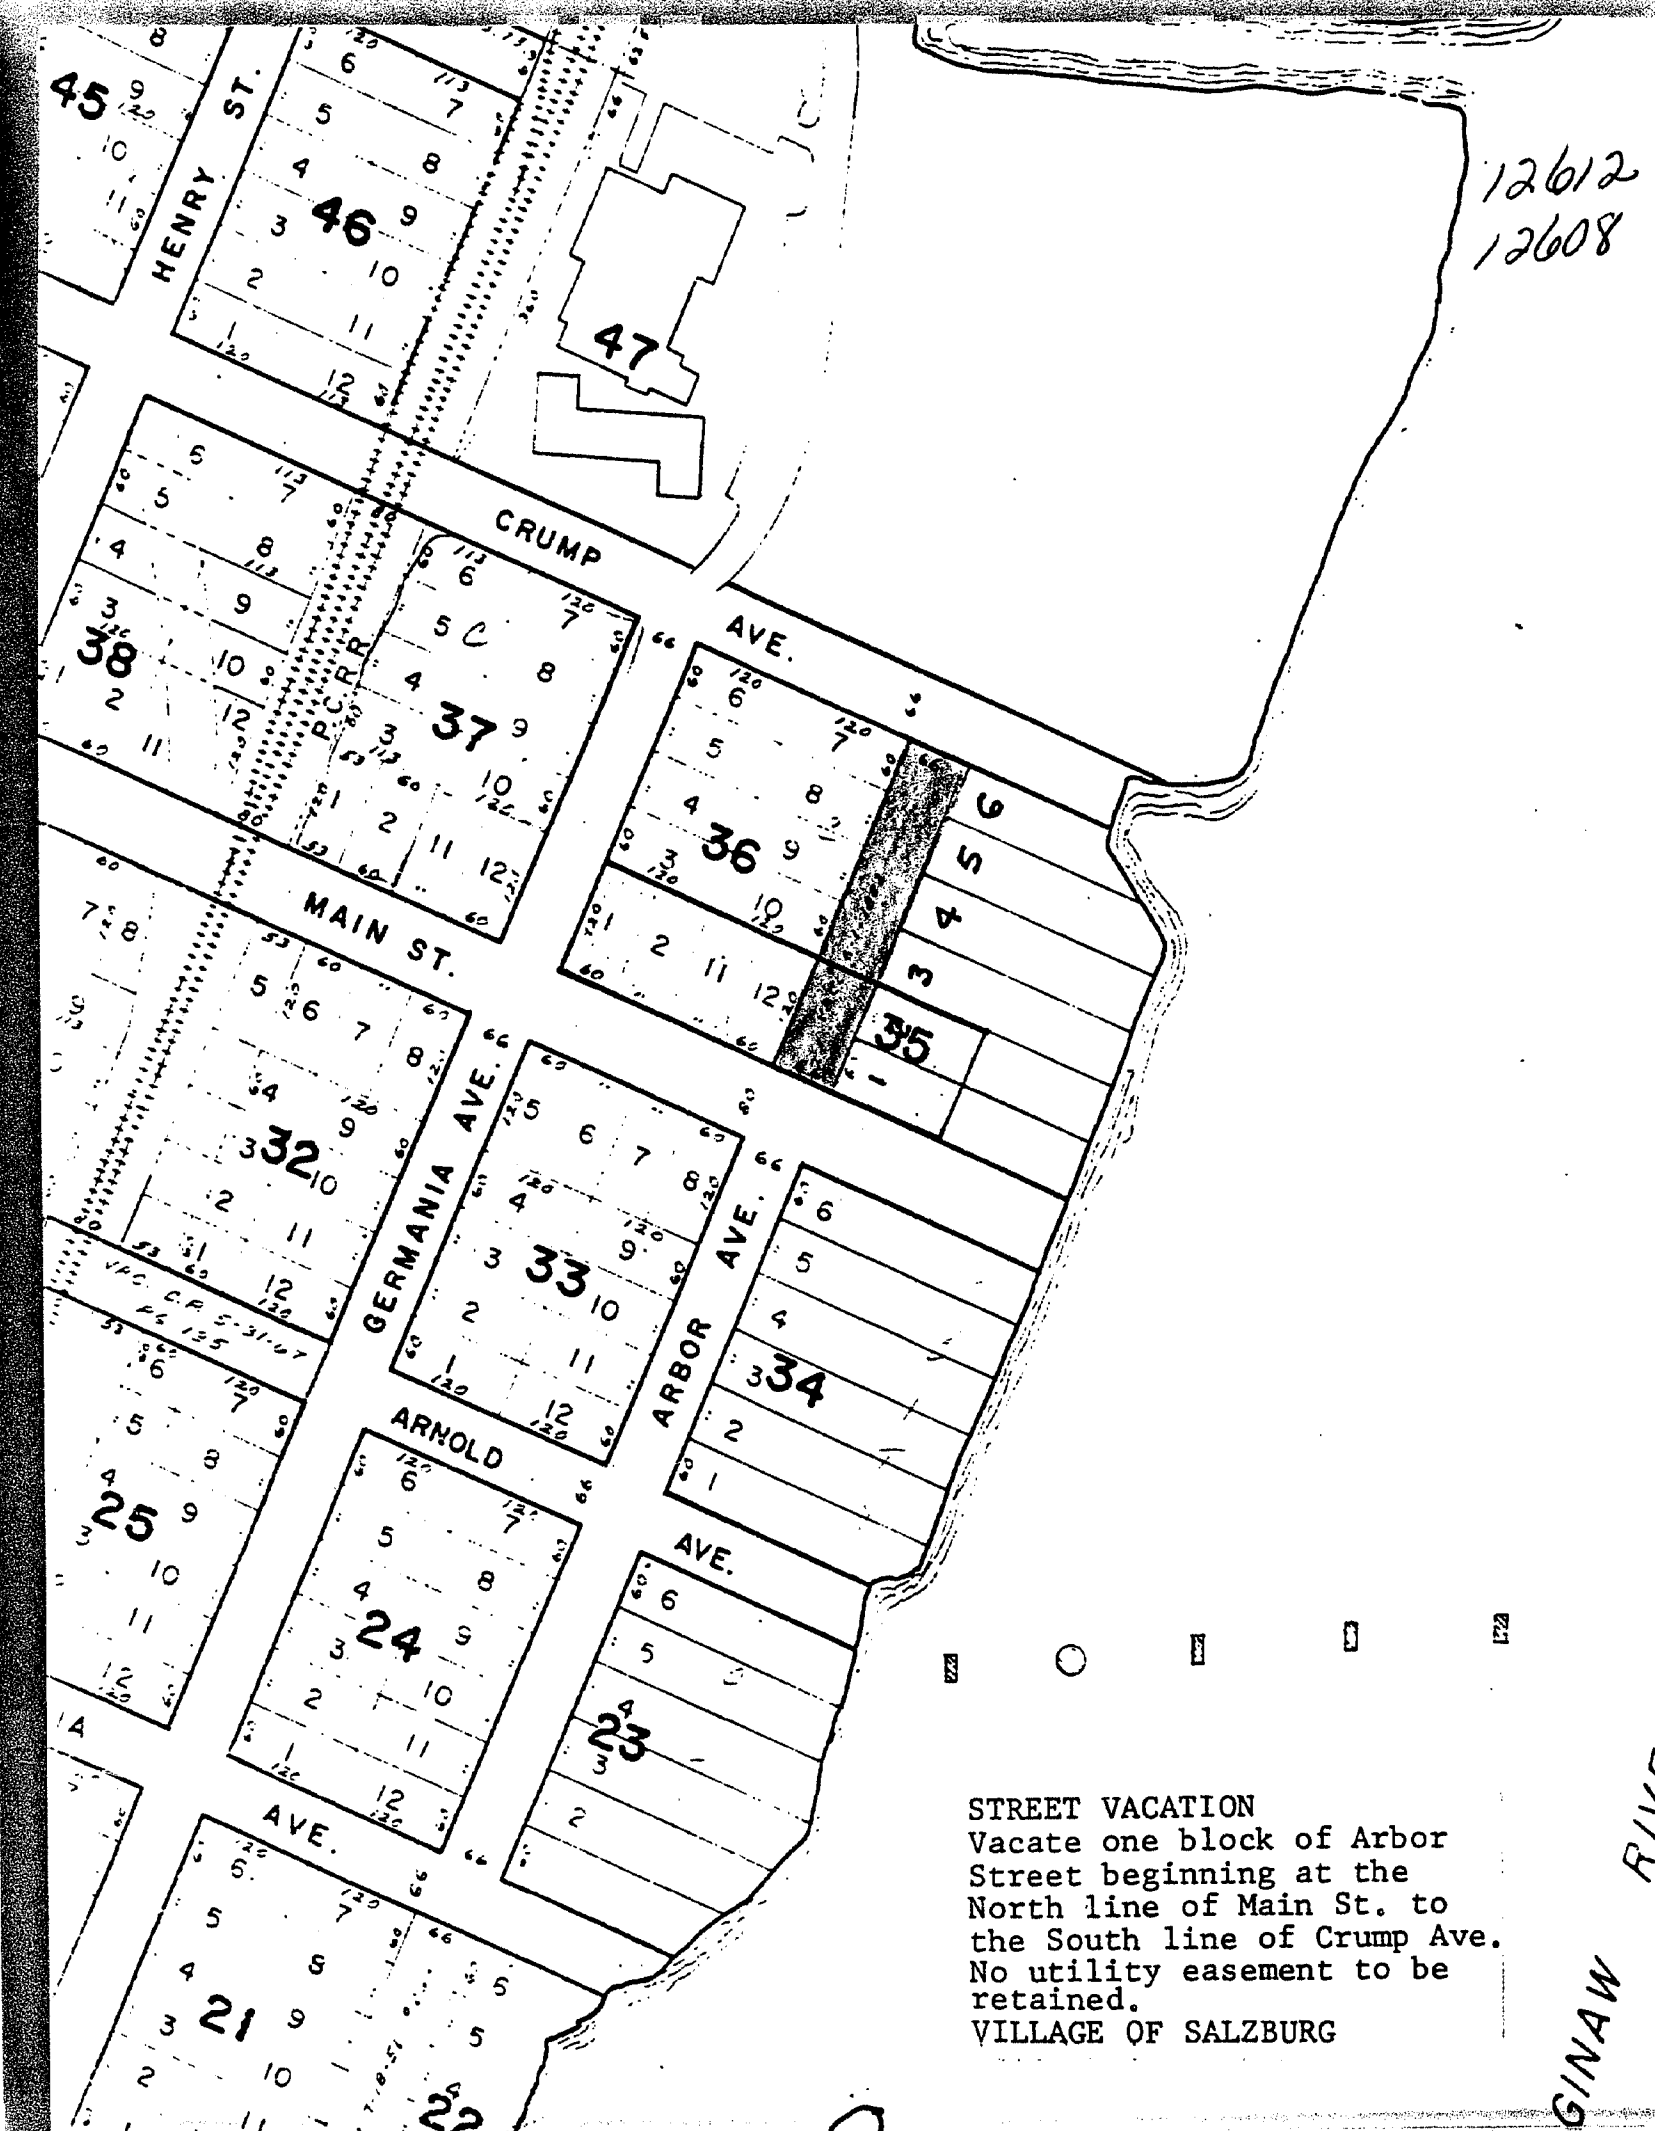



May 31, 1983

Department of Treasury
Bureau of Local Government Services
2nd Floor, Treasury Building
Lansing, Michigan 48922

Gentlemen:

Pursuant to Section 256 of the new Subdivision Act of 267 (Public Act 288), we herewith submit a certified copy of the resolution vacating Crump Street between the east right-of-way line of Germania Street and the Saginaw River. This street is located in the Village of Salzburg.

A sketch from the Planning Office which identifies the area affected is also attached.

Sincerely,

CITY OF BAY CITY

Connie M. Deford
Connie M. Deford
Deputy City Clerk

cd

Enclosures



12612
12608
City of Bay City

301 WASHINGTON AVE.
BAY CITY, MICHIGAN 48706
AREA CODE 517 - 894-8200

CL6-3c

LIBER 934 PAGE 729

12612
12608

CITY OF BAY CITY, MICH.
OFFICE OF CITY CLERK
(AFFIDAVIT)

STATE OF MICHIGAN

COUNTY OF BAY
CITY OF BAY CITY

I, Walter Wozniak, Jr. Clerk of the City of Bay

City, County and State aforesaid, Do hereby Certify, that I have compared the

annexed excerpt from the regular meeting of the City Commission of the

City of Bay City held April 4, 1983


with the original on file in this office and that it is a true and correct transcript therefrom and of the whole of such original.

In Witness Whereof, I have hereunto set my hand affixed the
Corporate Seal of the City of Bay City, Mich., this

13th day of April 19 83

Walter Wozniak, Jr.
Walter Wozniak, Jr., City Clerk

Of City Attorney:-
On November 1, 1982, the Planning Commission recommended that Crump Street between the east r/o/w line of Germania Street and the Saginaw River be vacated for the reasons that the said street was not developed, that the City of Bay City owns all adjacent property and that it was proposed to use the said street as part of Veterans Memorial Park. Inasmuch as all streets leading to a river must be vacated in accordance with state law, the petition for vacation was filed with the Circuit Court for the County of Bay and the Court ordered the said vacation on February 22, 1983.
It is recommended that said Order be referred to the City Clerk to advise all concerned parties and send notifications to the Michigan Department of Treasury pursuant to Section 256 of the new Subdivision Act 267, Public Act 288 of 1967.
Commissioner Laskowski moved adoption of recommendation.
Adopted by the following vote -
Yes: Commissioners Sullivan, Vandervill, Mochrie, Ludwig, Laskowski, Martindale, Baird, Sutter, Hartman, 9
No: None.

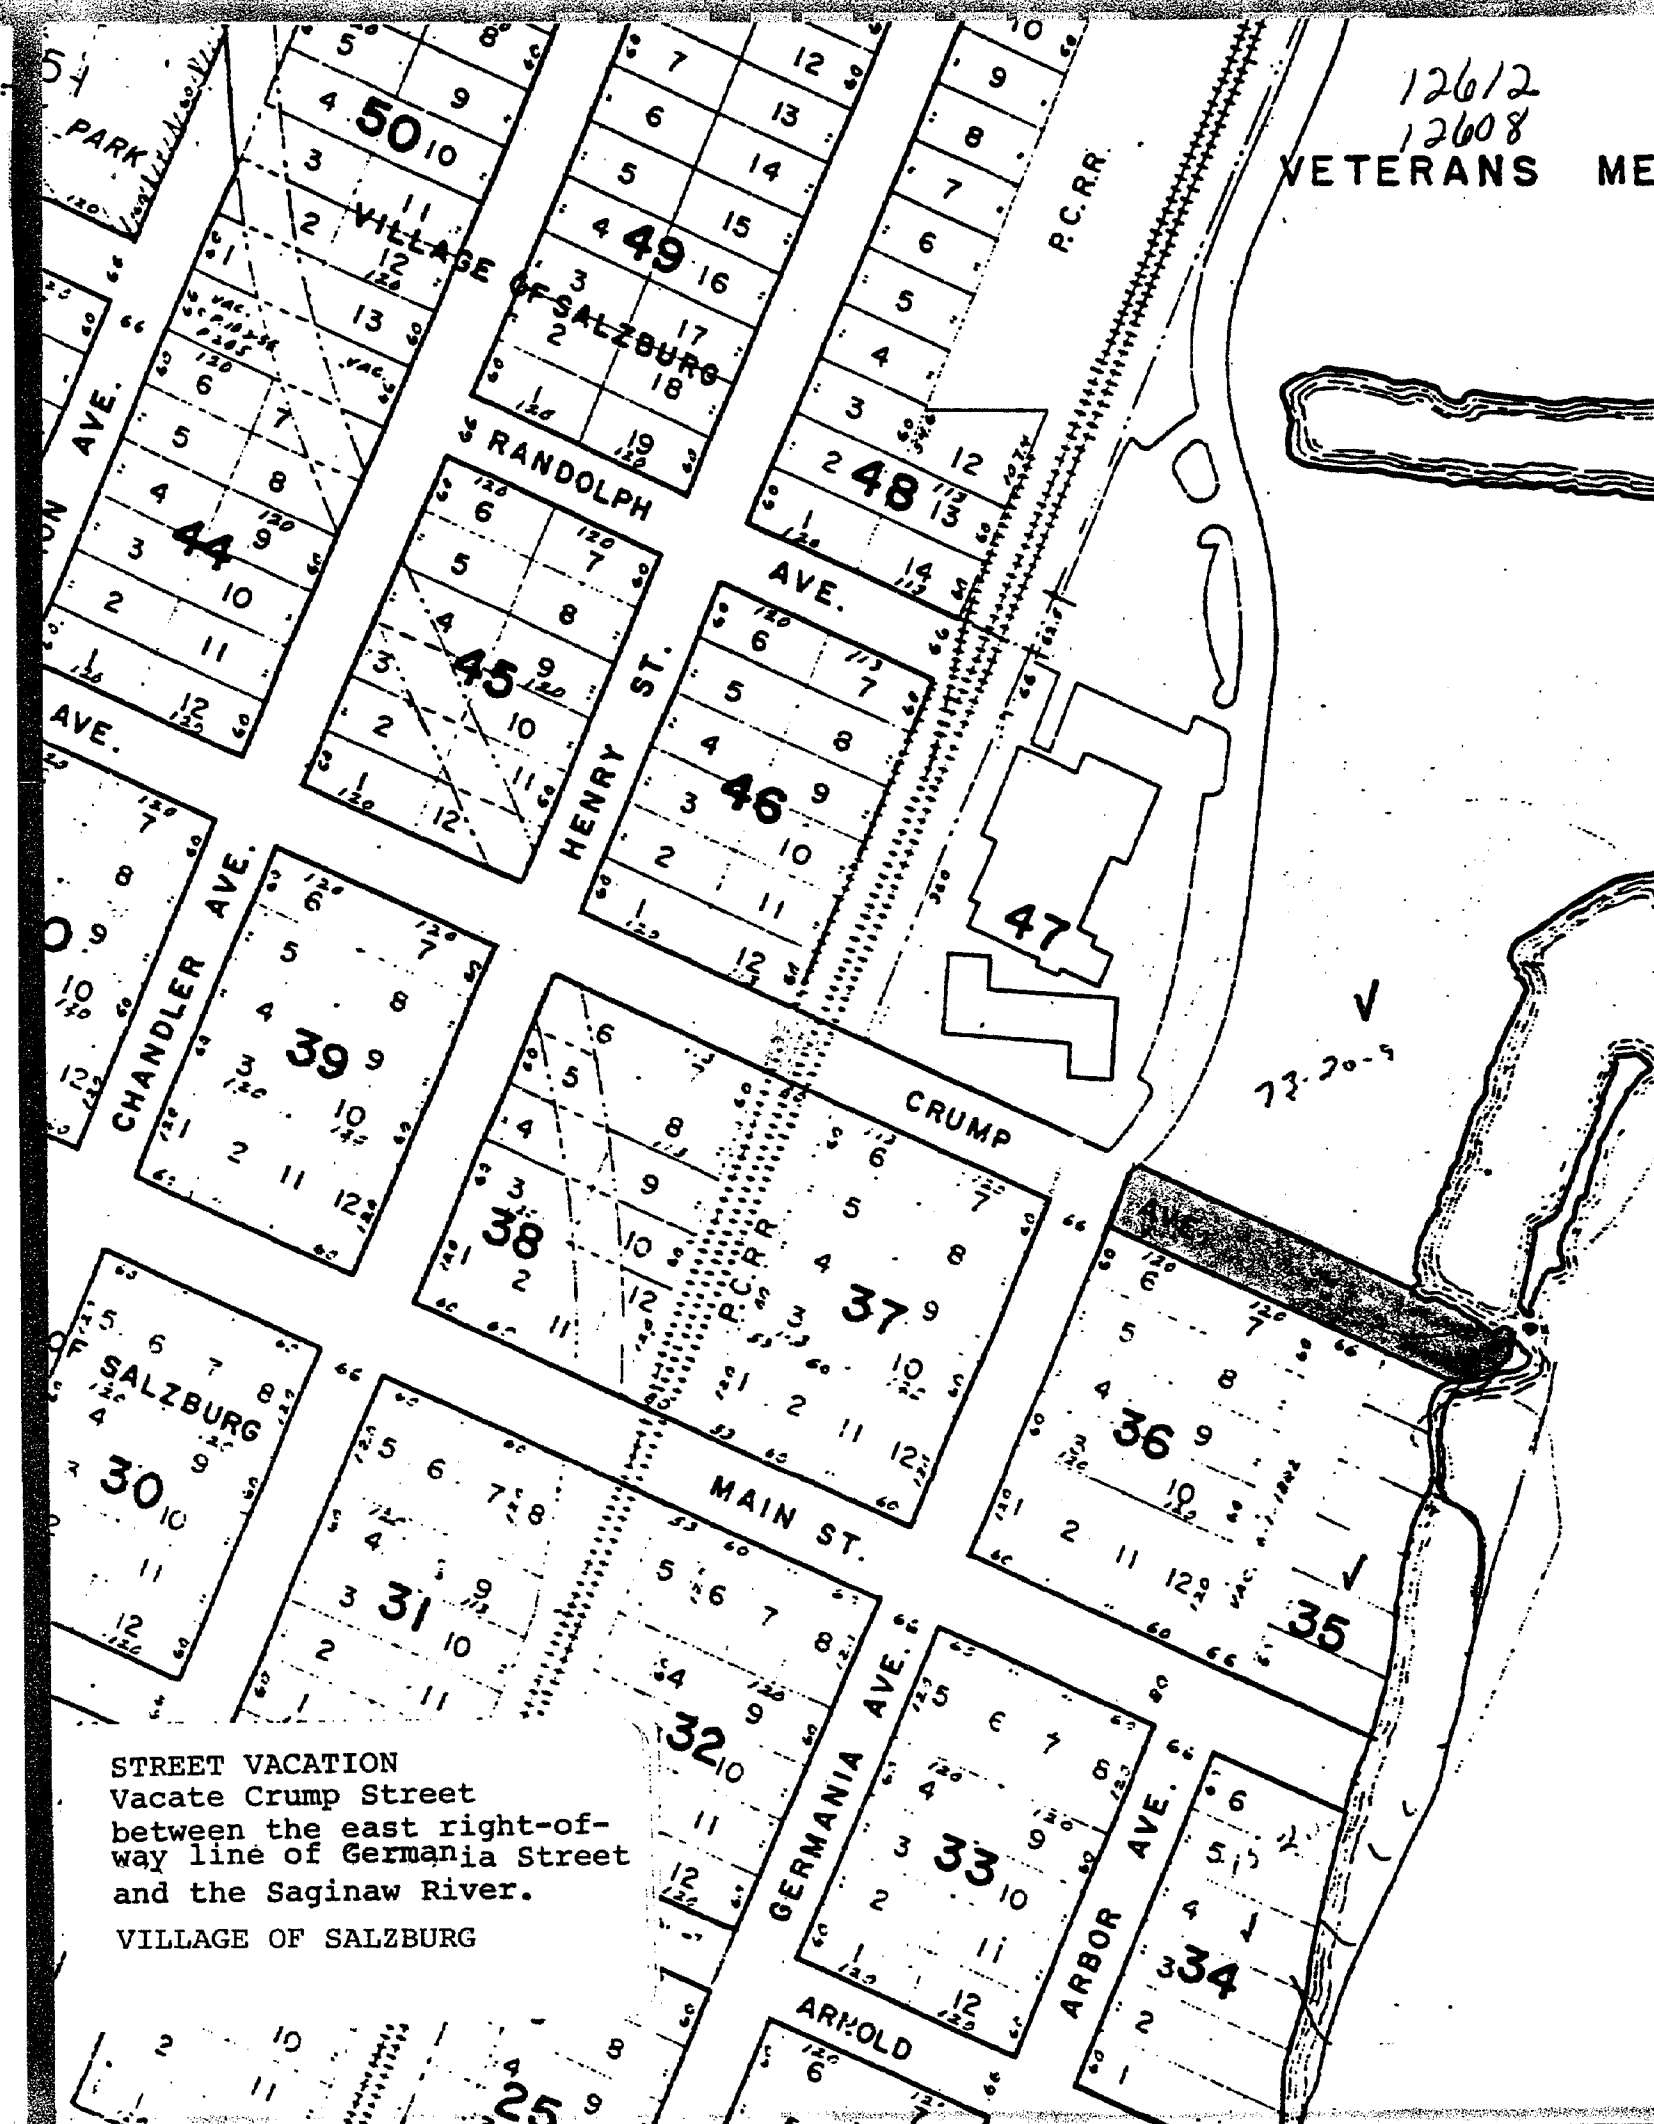



12612
12608

JAN 23 1988

City of Bay City

301 WASHINGTON AVE.
BAY CITY, MICHIGAN 48708
AREA CODE 517 - 894-8200

January 25, 1988

Department of Treasury
Bureau of Local Government Services
Second Floor, Treasury Building
Lansing, MI 48922

Gentlemen:

Pursuant to Section 256 of the New Subdivision Act of 1967, (Public Act 288) we herewith submit a certified copy of the resolution vacating portions of Germania Avenue and Arnold Street.

A sketch from the Planning Office which identifies the area affected is also attached.

Sincerely,

CITY OF BAY CITY

Connie M. Deford
Connie M. Deford
City Clerk

Enclosures

LIBER 1074 PAGE 108

4468A 01/14/88 OTHER 7.1

CITY OF BAY CITY, MICH. OFFICE OF CITY CLERK

(AFFIDAVIT)

12612
12608

STATE OF MICHIGAN

COUNTY OF BAY
CITY OF BAY CITY


I, Connie M. Deford Clerk of the City of
Bay City, County and State aforesaid, Do hereby Certify, that I have
compared the annexed excerpt from the regular meeting of the City
Commission of the City of Bay City held January 4, 1988

with the original on file in my office and that it is a true and
correct transcript therefrom and of the whole of such original.

In Witness Whereof, I have hereunto set my hand affixed the
Corporate Seal of the City of Bay City, Mich., this

12th day of January 19 88

Connie M. Deford
Connie M. Deford City Clerk

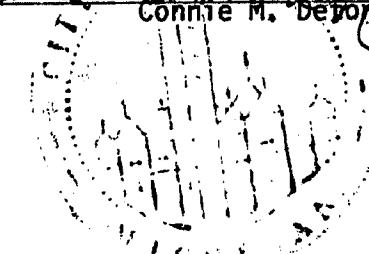

RECORDED

JAN 14 3 30 PM '88

Christine P. DeWitt
REGISTER OF DEEDS
BAY COUNTY, MICHIGAN

SPECIAL ORDER

Of the City Manager and Planning Director:

It is recommended that the following resolution regarding the vacation of portions of Germania Avenue and Arnold Street be approved:

Whereas, the Bay City Planning Commission at its meeting of October 21, 1987 considered the petition of Jim Schaefer to vacate a portion of Germania Avenue and a portion of Arnold Street; said portions more fully described as: beginning at a point on the southeasterly right-of-way for Germania Street at the corner common to Lots 5 and 6, Block 24, of the Plat of the Village of Salzburg, thence northwesterly along the extension of the lot line common to Lots 5 and 6 a distance of eight (8) feet; thence northeasterly parallel with Germania Avenue sixty-six (66) feet; thence southeasterly one hundred twenty-eight (128) feet parallel with Arnold Street; thence southwesterly along the extension of the lot line common to Lot 6 and 7 of said Block 24, a distance of six (6) feet; thence northwesterly one hundred twenty (120) feet along the northeasterly line of said Lot 6; thence southwesterly along the northwesterly line of said Lot 6 a distance of sixty (60) feet to the point of beginning; and

Whereas, Mr. Schaefer owns a house that has been in his family since 1914 at said location, with portions of said house encroaching into the Germania Avenue and Arnold Street rights-of-ways; and,

Whereas, said house has been for sale but because of the encroachments he has been unable to transfer title; and,

Whereas, the vacation of said portions of these two streets will not seriously reduce the adequacy of the rights-of-way for street purposes; and,

Whereas, it is the recommendation of the Bay City Planning Commission to vacate the aforementioned portions of Germania Avenue and Arnold Street with the following five (5) conditions:

- (1) That if any portion of the structure is removed from the encroachment area, it not be rebuilt for any reason.
- (2) When the structure is removed from the vacated right-of-way that the vacation of these portions of Germania and Arnold Street be terminated and right-of-way be returned to the City.
- (3) That all determinations of the encroachment be based on the Certificate of Survey recorded in Liber 1066, Page 724, Bay County Register of Deeds.
- (4) That the City shall not pay to reclaim this vacated property if it should be required for any future City project.

- (5) No additional permanent structure shall be constructed on, over, or under this vacated right-of-way nor shall this vacated right-of-way be used to meet set-back requirements as prescribed by City's Zoning Ordinance. Usual utility easements are also to be retained; and,

Whereas, a resolution was adopted on November 16, 1987 ordering publication of notices and the holding of a hearing, said notices having been published in The Bay City Democrat, the official newspaper of the City of Bay City, on December 10, 17, 24 and 31, 1987 relative to the aforementioned hearings and certified notices thereof having been mailed to the public utilities and abutting property owners; and,

Whereas, a public hearing was held by the City Commission of Bay City on January 4, 1988 relative to the aforesaid request for vacation;

Now, Therefore, Be It Resolved And Ordered by the City Commission that portions of Germania Avenue and Arnold Street are hereby closed and vacated; said portions are more fully described as: beginning at a point on the southeasterly right-of-way for Germania Street at the corner common to Lots 5 and 6, Block 24, of the Plat of the Village of Salzburg, thence northwesterly along the extension of the lot line common to Lots 5 and 6 a distance of eight (8) feet; thence northeasterly parallel with Germania Avenue sixty-six (66) feet; thence southeasterly one hundred twenty-eight (128) feet parallel with Arnold Street; thence southwesterly along the extension of the lot line common to Lot 6 and 7 of said Block 24, a distance of six (6) feet; thence northwesterly one hundred twenty (120) feet along the northeasterly line of said Lot 6; thence southwesterly along the northwesterly line of said Lot 6 a distance of sixty (60) feet to the point of beginning.

Provided, however, that said vacation be approved with the following five (5) conditions:

- (1) That if any portion of the structure is removed from the encroachment area, it not be rebuilt for any reason.
- (2) When the structure is removed from the vacated right-of-way that the vacation of these portions of Germania and Arnold Street be terminated and right-of-way be returned to the City.
- (3) That all determinations of the encroachment be based on the Certificate of Survey recorded in Liber 1066, Page 724, Bay County Register of Deeds.
- (4) That the City shall not pay to reclaim this vacated property if it should be required for any future City project.
- (5) No additional permanent structure

shall be constructed on, over, or under this vacated right-of-way nor shall this vacated right-of-way be used to meet set-back requirements as prescribed by City's Zoning Ordinance.

And, further provided said streets are vacated upon the condition that the title to all gas, electric and communication poles, wires, pipes, conduits, cables, appurtenances and facilities now in, under or over said streets are reserved to and shall remain in the respective owners thereof, together with the Easement and rights to occupy said streets within the rights-of-way thereof for public utility purposes with present and additional facilities and to operate, maintain, repair, replace or remove the same; and, with the condition that no permanent structures be placed in the streets and if fences are constructed that they are to be removed at no expense to the utility companies when they are making repairs or installing lines.


Commissioner LeFevre moved to allow public input regarding the proposed streets vacations. There was no objection. No one came forward.

Commissioner Langin moved adoption of resolution.

Adopted by the following vote —

Yes, Commissioners Bock, Langin, Goss, Lewandowski, Gwizdala, Katt, Hutter, LeFevre, Wachowiak, 9.

No, None.

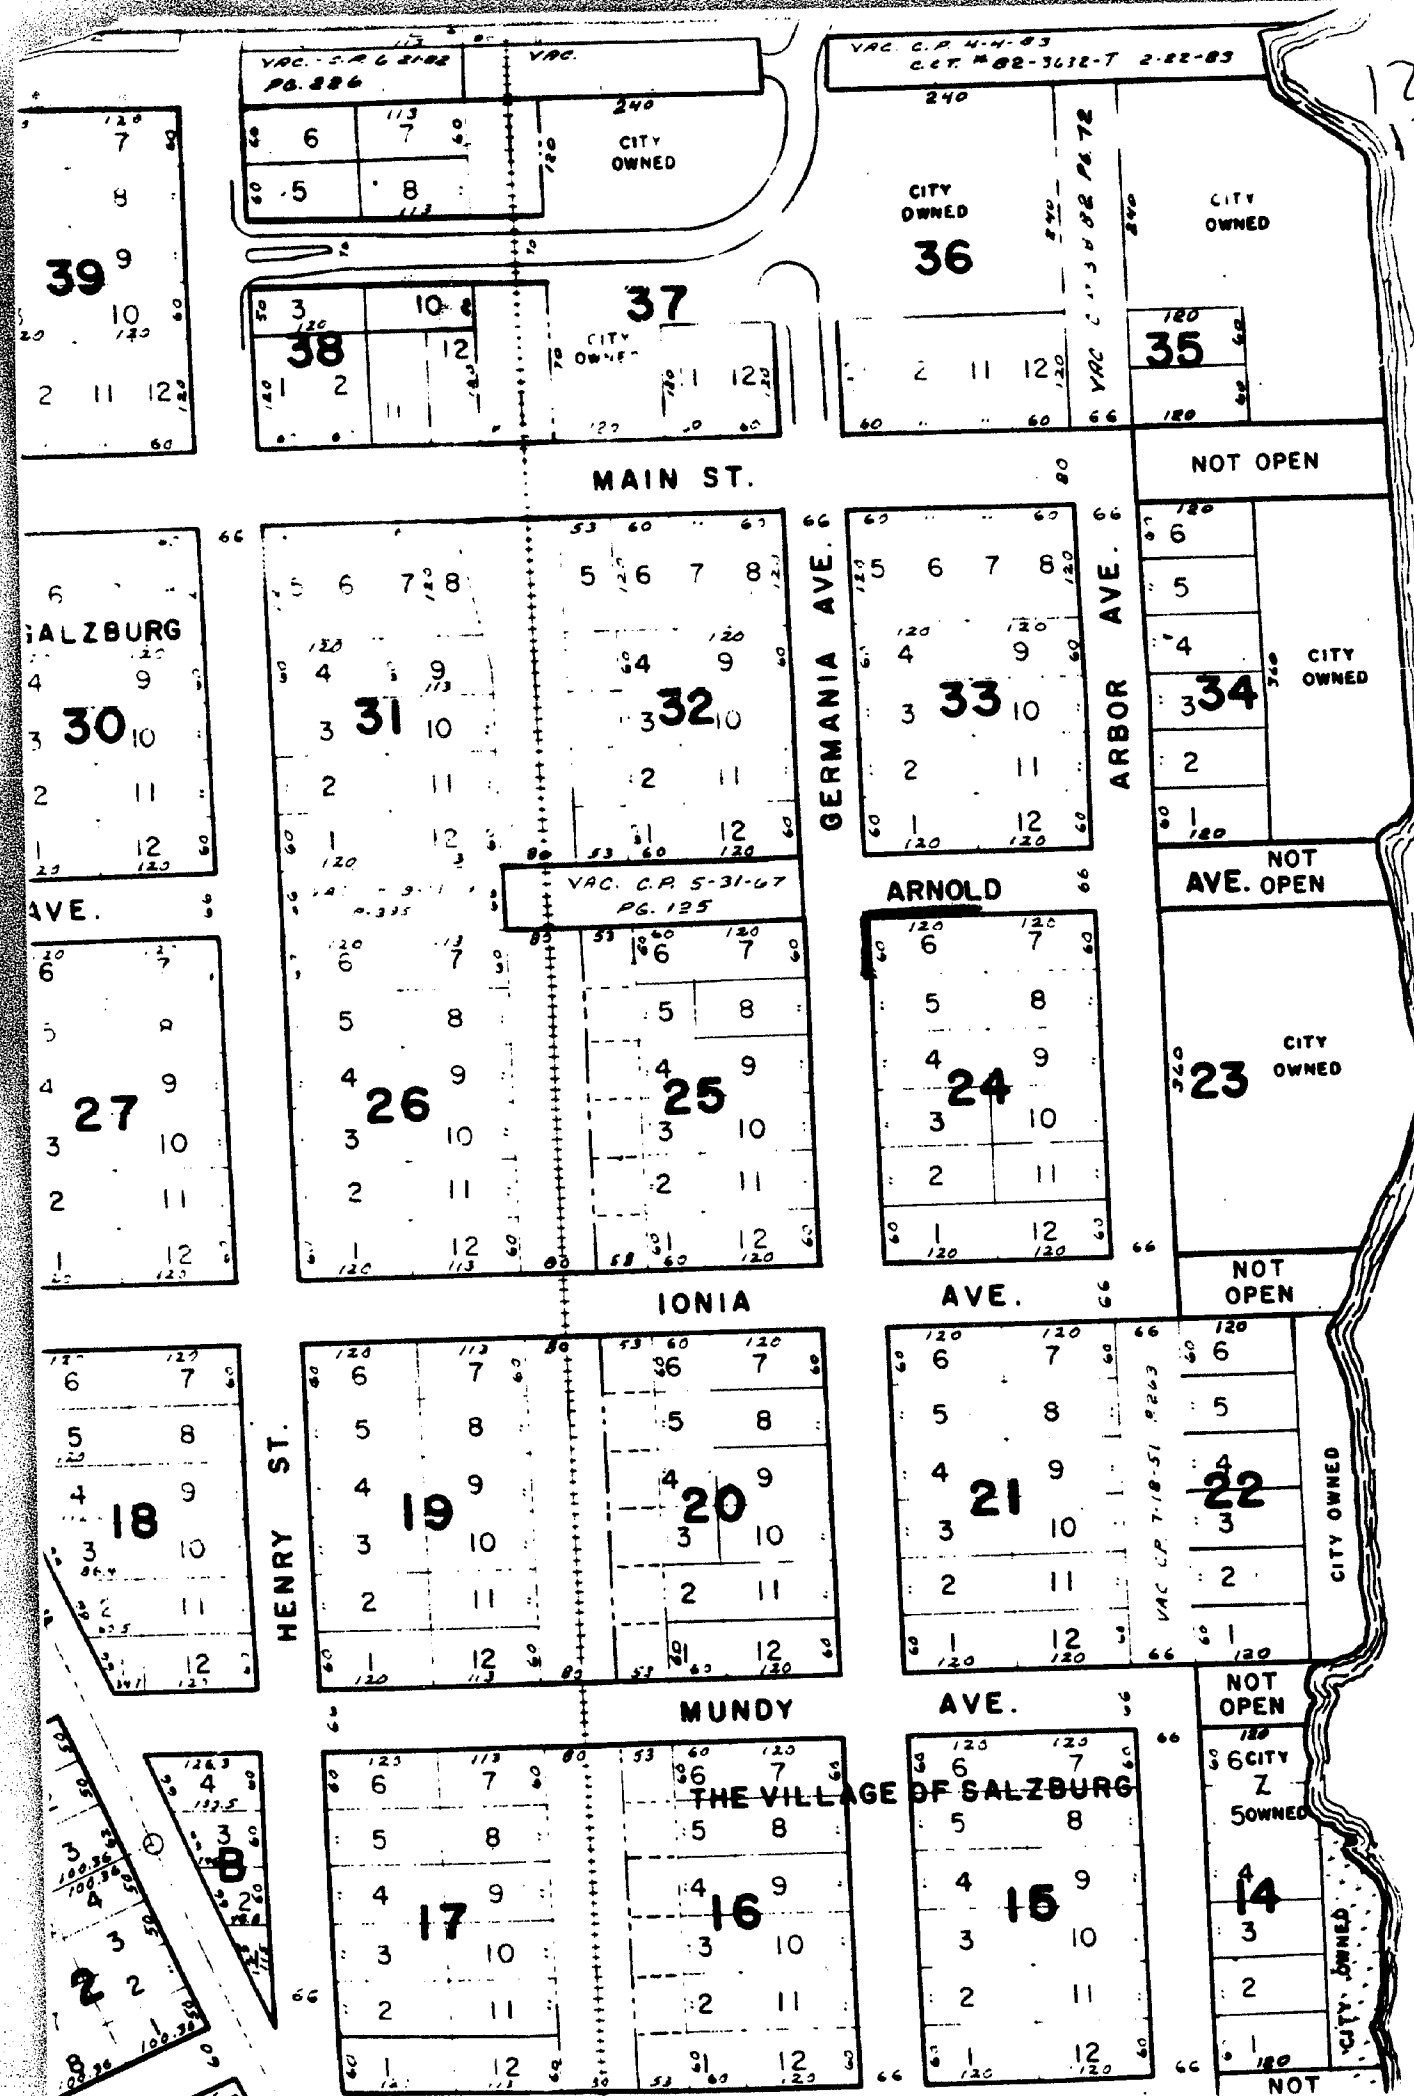



CITY OF BAY CITY

BAY CITY, MICHIGAN 48706

Area Code 517 893.7511

May 7, 1973

Department of Treasury
Bureau of Local Government Services
2nd Floor, Treasury Building
Lansing, Michigan 48922

Bay
12612
12608

Gentlemen:

Pursuant to Section 256 of the new Subdivision Act of 1967 (Public Act 288) we hereby submit a certified copy of the resolution vacating Randolph Street from East line of South Henry Street to the west line of the Penn Central Railroad right of way. Same was recorded with the Register of Deeds.

Attached is also a sketch from the Planning Office, which identifies the area affected.

Yours very truly,

CITY OF BAY CITY

Walter Wozniak, Jr.
Walter Wozniak, Jr.
City Clerk

WW:pc

Enclosures: Affidavit and Sketch

CITY OF BAY CITY, MICH.
OFFICE OF CITY CLERK

(AFFIDAVIT)

1973 MAY -2 PM 1:59

STATE OF MICHIGAN

COUNTY OF BAY
CITY OF BAY CITYErnie M. Meagher
REGISTER OF DEEDS
BAY COUNTY, MICH.I, Walter Wozniak, Jr. Clerk of the City of BayCity, County and State aforesaid, Do hereby Certify, that I have compared the
annexed excerpt from the regular meeting of the Bay City City Commission heldApril 23, 1973with the original on file in this office and that it is a true and correct
transcript therefrom and of the whole of such original.In Witness Whereof, I have hereunto set my hand affixed the
Corporate Seal of the City of Bay City, Mich., this2nd day of May 19 73Walter Wozniak Jr.
City Clerk

SPECIAL ORDER

Of Commission as a Whole:

Whereas, A. G. Kirchhoff and Fred Riffelmacher on March 12, 1973, petitioned this commission to vacate Randolph Street from the East line of South Henry Street to the West line of the Penn Central Railroad right of way, as set forth in said petition, and

Whereas, the Planning Commission recommended that same be closed and vacated, and

Whereas, it appears that the closing and vacating thereof would constitute an improvement and advantage to both the city and the adjacent property owners, and

Whereas, a resolution was adopted by the city commission on March 26, 1973 ordering publication of notices and holding of a hearing, said notices having been published in the Bay City Democrat, the official newspaper of the City of Bay City, on March 29, April 5, 12, and

19, 1973, relative to the aforesaid hearing and certified notice thereof having been mailed to the railroads and public utilities and to the abutting property owners, and

Whereas, a public hearing was held by the city commission on April 23, 1973, relative to the aforesaid petition for said vacation,

Now, Therefore, Be It Resolved and Ordered, by the city commission that Randolph Street from East line of South Henry Street to the west line of the Penn Central Railroad right of way be and the same is hereby closed and vacated with the city reserving unto itself a utility easement on the south 24 feet of the street right of way and on condition that no permanent structures be constructed within the area and further that any fences erected be removed at the owner's expense if and when ordered by the city.

RULES SUSPENDED

Commissioner Meagher moved that rules be suspended and a public hearing be held and interested persons be allowed to speak. There was no objection. No one appeared.

Commissioner Meagher moved for adoption of the resolution.

Adopted unanimously.



FISHER AVE.

12612
12608

CITY PARK

P.C.R.R.

HURON AVE.

VILLAGE OF SALZBURG

RANDOLPH

HENRY ST.

JAS. DAVIDSON SHIPYARD

47

CRUMP

JAS. DAVIDSON SHIPYARD

AVE.

MAIN ST.

NIA AVE.

AVE.

CHANDLER AVE.

ST.

VILLAGE OF SALZBURG

AVE.



CITY OF BAY CITY
BAY CITY, MICHIGAN 48706
Area Code 517 893.7511

August 28, 1980

Department of Treasury
Bureau of Local Government Services
2nd Floor, Treasury Building
Lansing, Michigan 48922

Gentlemen:

Pursuant to Section 256 of the new Subdivision Act of 267 (Public Act 288), we hereby submit a certified copy of the resolution vacating Crump Street between Henry Street and the west right-of-way line of Grand Trunk and Western Railroad. The street is located in the Village of Salzburg.

A sketch from the Planning Office which identifies the area affected is also herewith attached.

Yours very truly,

CITY OF BAY CITY

Walter Wozniak, Jr.
City Clerk

W:ive

Attachments

CLB:3c

LIBER 889 PAGE 577

CITY OF BAY CITY, MICH.
OFFICE OF CITY CLERK
(AFTIDAVIT)

STATE OF MICHIGAN
COUNTY OF BAY
CITY OF BAY CITY

I, Walter Wozniak, Jr., Clerk of the City of Bay

City, County and State aforesaid, Do hereby Certify, that I have compared the annexed excerpt from the regular meeting of the City Commission of Bay City held July 7, 1980

with the original on file in this office and that it is a true and correct transcript therefrom and of the whole of such original.

In Witness Whereof, I have hereunto set my hand and affixed the Corporate Seal of the City of Bay City, Mich., this

22nd day of July, 1980
Walter Wozniak, Jr.
City Clerk

SPECIAL ORDER

Of Commission as a Whole:
Whereas, the Planning Commission held a public hearing to consider vacating:

Crump Street between Henry Street and the west right-of-way line of Grand Trunk and Western Railroad

Whereas, the Planning Commission recommended that same be closed and vacated, and

Whereas, a resolution was adopted by the City Commission on June 2, 1980, ordering publication of notice and the holding of a hearing, said notices being published in the Bay City Democrat, the official newspaper of the City of Bay City, on June 12, 19, 26 and July 3, 1980, relative to the aforesaid hearing and certified notices thereof having been mailed to the public utilities and abutting property owners, and

Whereas, a public hearing was held by the City Commission on July 7, 1980, relative to the aforesaid petition for said vacation;

Now, Therefore, Be It Resolved And Ordered by the City Commission that:
Crump Street between Henry Street and the west right-of-way line of Grand Trunk and Western Railroad

be and hereby is closed with utility easements being retained and with the condition that the vacation not become final until it is certified that John F. Kennedy Drive will be constructed to South Henry Street.

Rules Suspended
Commissioner Toth moved to suspend the rules to permit any interested persons in the audience to speak regarding the proposed vacation. There was no objection.

Mr. John Howard, 202 W. Jenny, inquired as to why Crump Street was to be vacated. He was advised that it has to do with the development of

a new south entrance to the park so that the direct traffic will not be near the pool. Mr. Howard felt that the money is coming out of the taxpayers pockets no matter how you look at it being Federal, State or local monies. It was noted that the majority of the funds for this project came from the D.N.R. and the Kistler Foundation and that the City's General Fund was not tapped. Mr. Howard stated that he is not against park facilities because the City definitely needs parks. He inquired as to the price of the project and was advised that after exchange of land and sale of land in the vicinity somewhere in the area of \$100,000.

Mr. Toth moved adoption of resolution.
Adopted by the following vote —
Yes, Commissioners Sullivan, Vandervell, Snyder, Glenda, Winters, Toth, Bada, Rumbaum, S.
No, None.

