


CHOPES SUBDIVISION
OF PART OF THE EAST 1/2
OF FRACTIONAL SECTION 2,
T. 2 S. R. 11 E.
DETROIT, WAYNE COUNTY, MICHIGAN.

SCALE, 1 INCH=100 FEET.

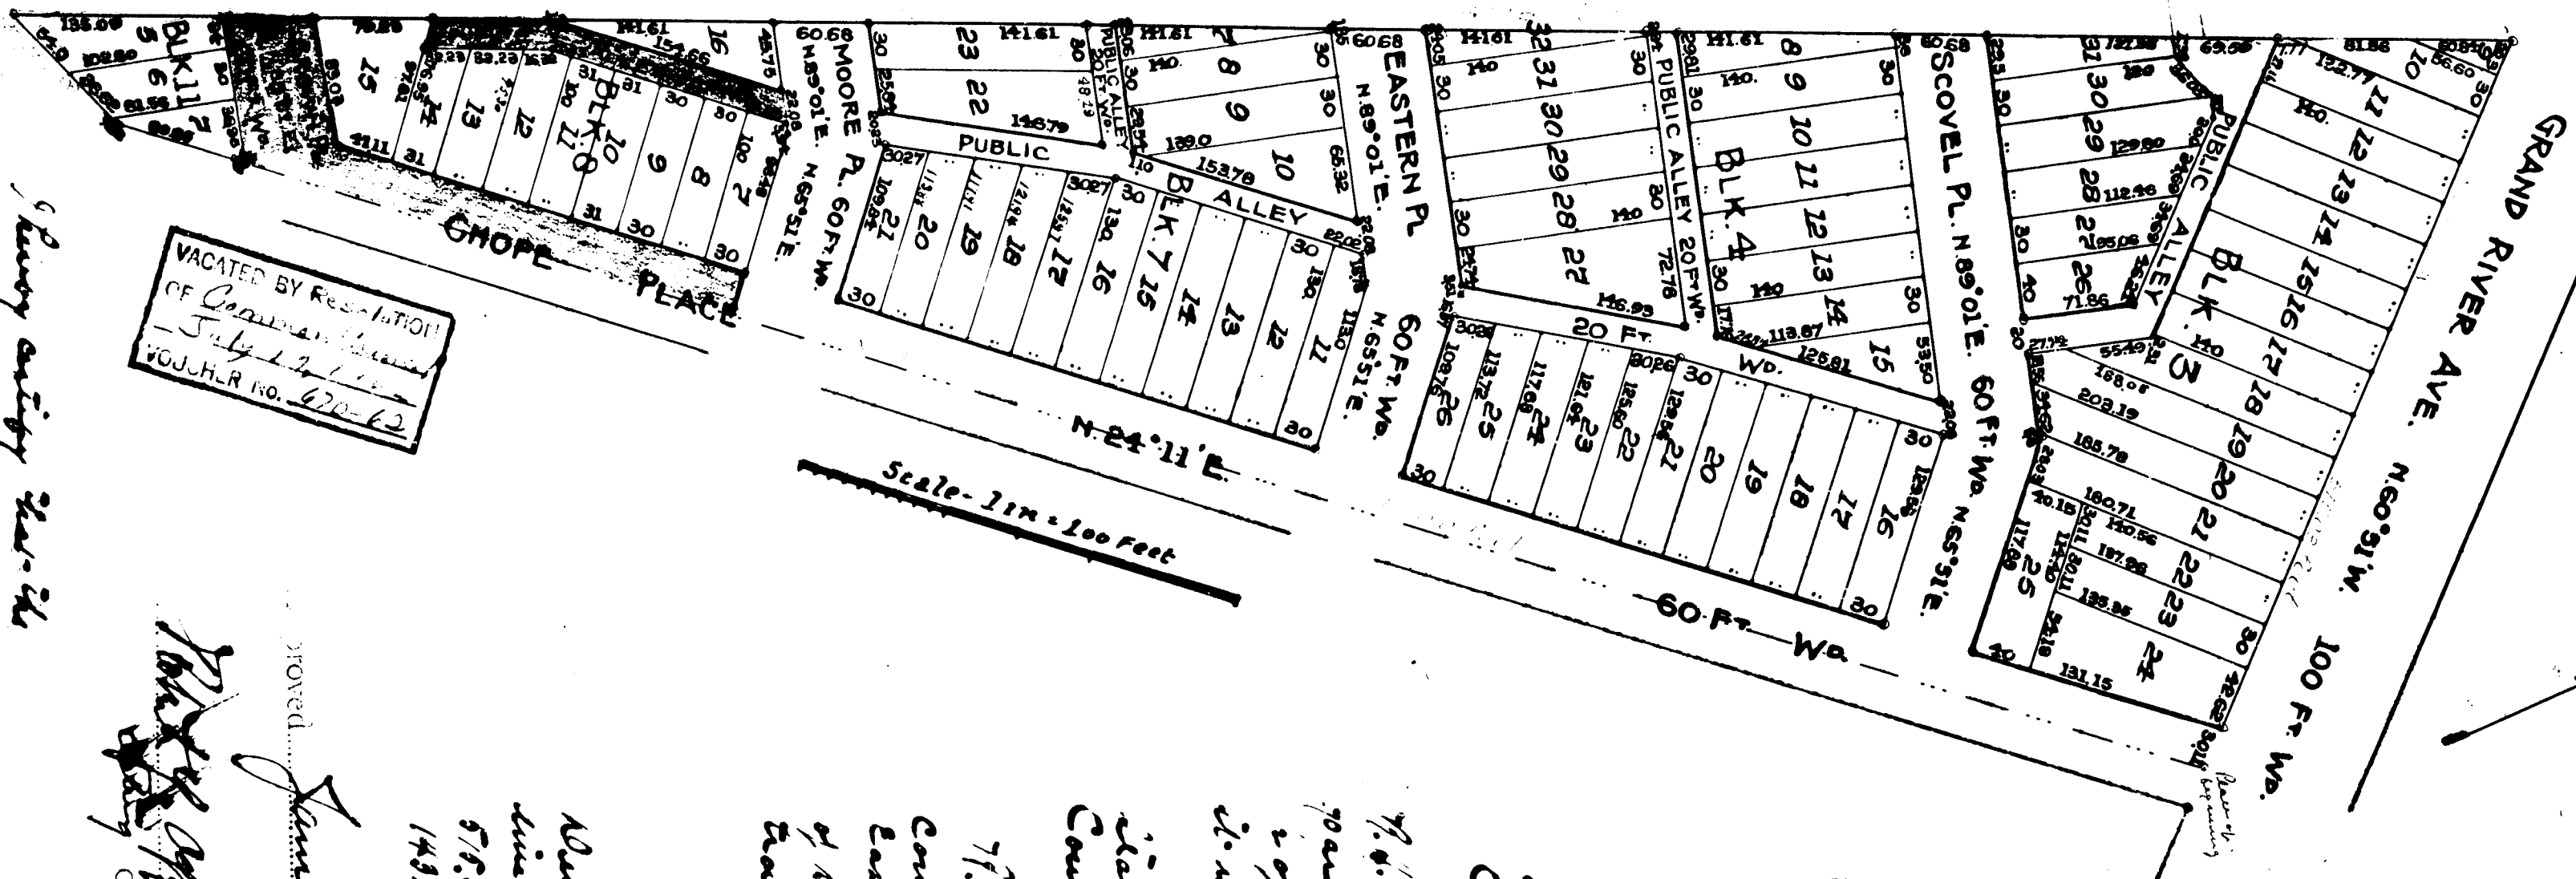

These all were by their parents that were Elizabeth Chopes (widow) Anna Chopes (widow) & Eliza Smith, known as the Chopes & Elizabeth Chopes (the wife) have caused the same to be placed in the above plat to be surveyed, laid out and platted, to be known as the Chopes Subdivision of part of the East 1/2 of fractional Section 2, T. 2 S. R. 11 E. Wayne County Michigan, and that the said plat and survey shown on said plat are hereby associated to the use of the parties. Witness our hands and seal this 8th day of January 1903 in presence of
 Henry & Tera
 C. E. & A. C. C. C.

State of Michigan } ss
 County of Wayne } ss
 On this 8th day of January 1903, before me, a
 Notary Public in and for said County, personally appeared the above named Elizabeth Chopes, Anna Chopes, Eliza Smith, the wives of the said Elizabeth Chopes, the wife, known to me to be the same persons who executed the above association and who acknowledged to have to be their free act and deed
 Elizabeth & Eliza Smith
 Henry & Tera
 Wayne County Michigan
 This day of Jan 8. 1903


Notarization of above plat, Commissioning of the instrument of the entire line of Chopes Place and the boundary line of Grand River County, Thence N 68° 35' W 57.00 feet, Thence S 73° 35' W 16.25 feet, Thence N 28° 59' E 98.50 feet, Thence N 84° 11' E 142.50 feet to the place of beginning.

PROVED
 January 8th 1903
 O. D. Buckley
 Commissioner of Public Works


The Streets on the annexed plat conform to the general plan of the City.
 O. D. Buckley
 City Engineer.

Every survey that is made is correct and that the monument consisting of one stone 1 1/2 in. square and 15 in. long from here in the ground at all angles in the boundaries and at all intervals of survey on without survey, as shown on plat shown.

RECEIVED AND FILED.
 IN AUDITOR GENERAL'S OFFICE,
 January 17th 1903
 O. D. Buckley
 Auditor General

1272

SCALE, 1 INCH = 100 FEET.

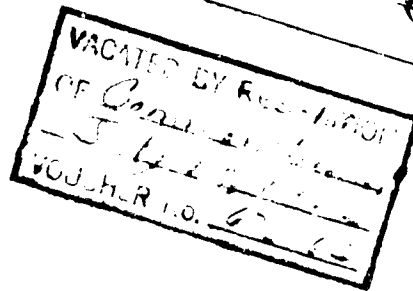










1732.0 feet to the place of beginning.

The Streets on the annexed plat conform to the general plan of the City.

Alfred A. Brown
City Engineer.

Samuel Webb
June 17th 1903

John T. Waldron

RECEIVED AND FILED,
IN AUDITOR GENERAL'S OFFICE,
JULY 17-1903

Done with pleasure
Deputy Auditor General.