

IRON

[illegible]

The figures are line with the word Block indicate the number of the Block
The figures in block in on each lot indicate the no of the lot.
The figures in red ink indicate the dimension of the lot on which they are placed
This plot survey by me August 1865
is located in the west $\frac{1}{2}$ of the $\frac{1}{4}$ of
Section 6 T. 47. N. R. 24. W.

F. D. Clark

I hereby certify that these plates are correct copies of the plate
now on record in the Register of Nevada and that by tracing the
under the supervision of the Auditor General a carefully compared
copy of the dedication and certificate

10) dated Thu. 5th day of June 1911

The annexed is a Map of a subdivision made by me, of that part of the Village of Regansee in the County of Marquette and State of Michigan, which is included in the North West quarter of the South West quarter of section No. 8, Twp. 6" N. Range 10" East. The streets have a course North and South and East and West and are eighty feet wide. The alley shown is eleven feet wide. Erected in presence of M. H. Maynard and J. Clark
J. P. Connelley
Jas. Connelley





12738
Iron Plat

City of Negaunee
County of Marquette, Michigan

Minutes of a Regular Meeting of the City Council of the City of Negaunee, County of Marquette, State of Michigan (the "City"), held on the 14th day of July, 1983, at 7:30 o'clock p.m., Eastern Standard Time.

PRESENT: Councilmen Gerald Corkin, Bruce Saari, Bertil Agnoli, Edward Kinkella, Paul Maino, Lee Searing, Steven Perucco.

ABSENT: Councilmen none

The following Preamble and Resolution were offered by Councilman Perucco and supported by Councilman Maino:

WHEREAS, the Negaunee Downtown Development Authority, a Michigan municipal corporation, has received confirmation of funding for a Downtown Development Project in the City to be located on Iron Street, the eastern boundary of said project being Division Street, and the western boundary of said project being Marquette Street; and,

WHEREAS, it has been made to appear to the City Council that the vacation of portions of Marquette Street will be necessary in order to complete said project as planned; and,

WHEREAS, by Resolution adopted at its Regular Meeting of June 9, 1983, the City Council deemed it advisable to vacate the following described portions of Marquette Street:

The East Sixteen (16) feet of the North Ninety-Nine (99) feet and the West Ten (10) feet of the North Ninety-Nine (99) feet of the existing Marquette Street right-of-way as shown on the Iron Plat of the City of Negaunee, County of Marquette, State of Michigan, on file in the

-2-

office of the Register of Deeds in and for the County of Marquette, State of Michigan,

and did, by said Resolution, schedule a meeting for this date, July 14, 1983, for the purpose of hearing any and all objections to said proposed vacation; and,

WHEREAS, a Notice of this meeting of July 14, 1983, for the purpose of hearing objections to the proposed vacation, was published once each week for four (4) weeks prior to this meeting, as required by the provisions of Section 14.4 of the Charter of the City of Negaunee, and all other requirements of said Section 14.4 of the City Charter have been met;

NOW, THEREFORE, pursuant to the provisions of said Section 14.4 of the Charter of the City of Negaunee, County of Marquette, State of Michigan, BE IT RESOLVED THAT:

1. The City Council of the City of Negaunee, County of Marquette, State of Michigan, deeming it advisable to do so, does hereby vacate the following described portions of Marquette Street:

The East Sixteen (16) feet of the North Ninety-Nine (99) feet and the West Ten (10) feet of the North Ninety-Nine (99) feet of the existing Marquette Street right-of-way as shown on the Iron Plat of the City of Negaunee, County of Marquette, State of Michigan, on file in the office of the Register of Deeds in and for the County of Marquette, State of Michigan.

2. The City Clerk shall cause to be filed with the Register of Deeds in and for the County of Marquette, State of Michigan, a certified copy of this Resolution, and shall further cause additional certified copies to be filed with such additional state or county agencies as may be required by law.

AYES: Councilmen Gerald Corkin, Bruce Saari, Bertil Agnoli, Edward Kinkella, Paul Maino, Lee Searing, Steven Perucco.

NAYS: Councilmen none


-3-

RESOLUTION DECLARED ADOPTED.

Myrtle Dompiere
Myrtle Dompiere, City Clerk

I hereby certify that the foregoing is a true and complete copy of a Resolution adopted by the City Council of the City of Negaunee, County of Marquette, State of Michigan, at a Regular Meeting thereof held on July 14, 1983, and that public notice of said meeting was given pursuant to and in full compliance with the Michigan Open Meetings Act.

Myrtle Dompiere
Myrtle Dompiere, City Clerk

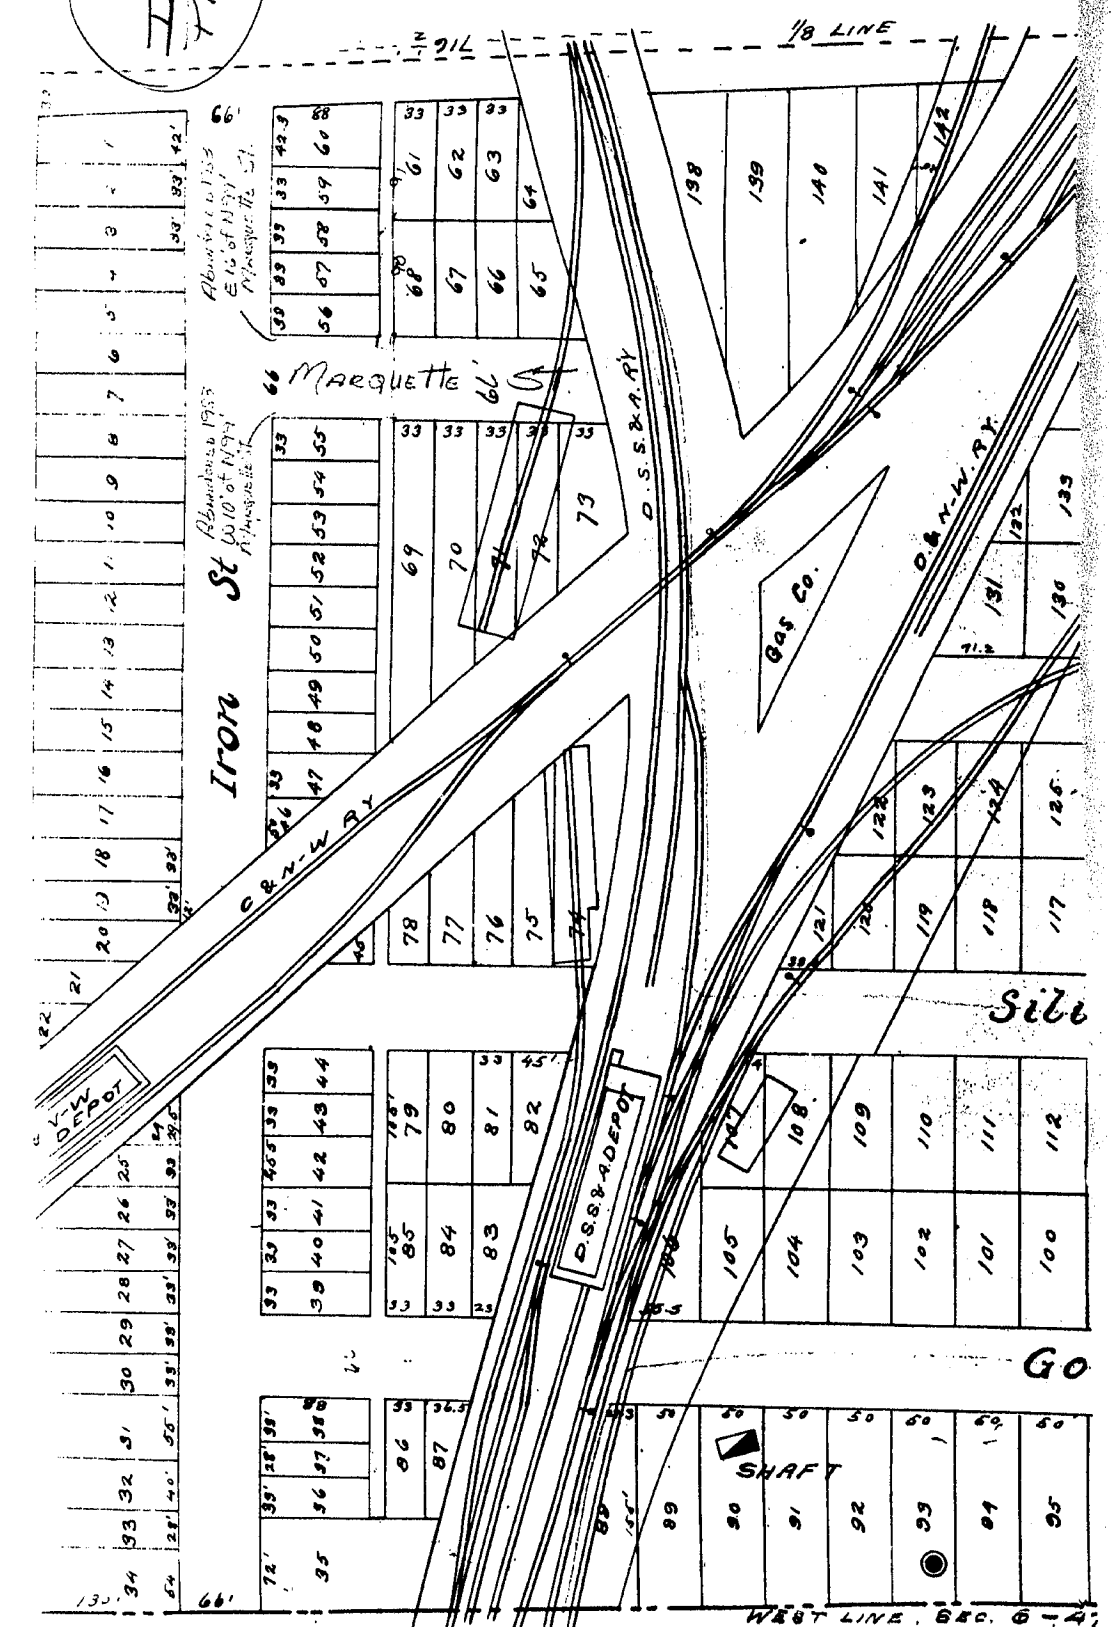

12738
CITY OF NEGAUNEE
MICHIGAN
49866



PHONE (906) 475-7700

February 18, 1985

RECORD OF CERTIFICATION

I hereby certify that the Negaunee City Council at its regular meeting held on February 14, 1985 adopted the following resolution:

PUBLIC HEARING ON THE VACATING OF PROPERTY NEAR THE MALL

Mayor Maino opened the Public Hearing on the proposed vacation. No one spoke on the subject. It was then moved by Council Member Corkin, supported by Council Member Paulson and carried that the following described parcel of land be vacated by the City of Negaunee:

Beginning .53' north and 1.15' east of the northeast corner of Lot 60 Iron Flat, thence south along the east wall of the building to the intersection of the east Lot line of Lot 60 and the east wall of the building, also,

Beginning .53' north and 1.15' east of the northeast corner of Lot 60 Iron Flat, thence westerly along the north wall of the building to the intersection of the north wall of the building and the north Lot line, also

Beginning 1.03' south of the southwest corner of Lot 56 Iron Flat, thence easterly along the south wall of the building to the southeast corner of the building, thence north .04' to the south Lot line.

T. R. McNabb

T. R. McNabb
City Clerk