


A Replat of Blocks
One & Two (1+2) of the
Thirty six acre plat

A true copy of the original received and recorder
This 5 day of December A.D. 1862 at 9 o'clock A.M.
Wm B. Berger Depty. Register

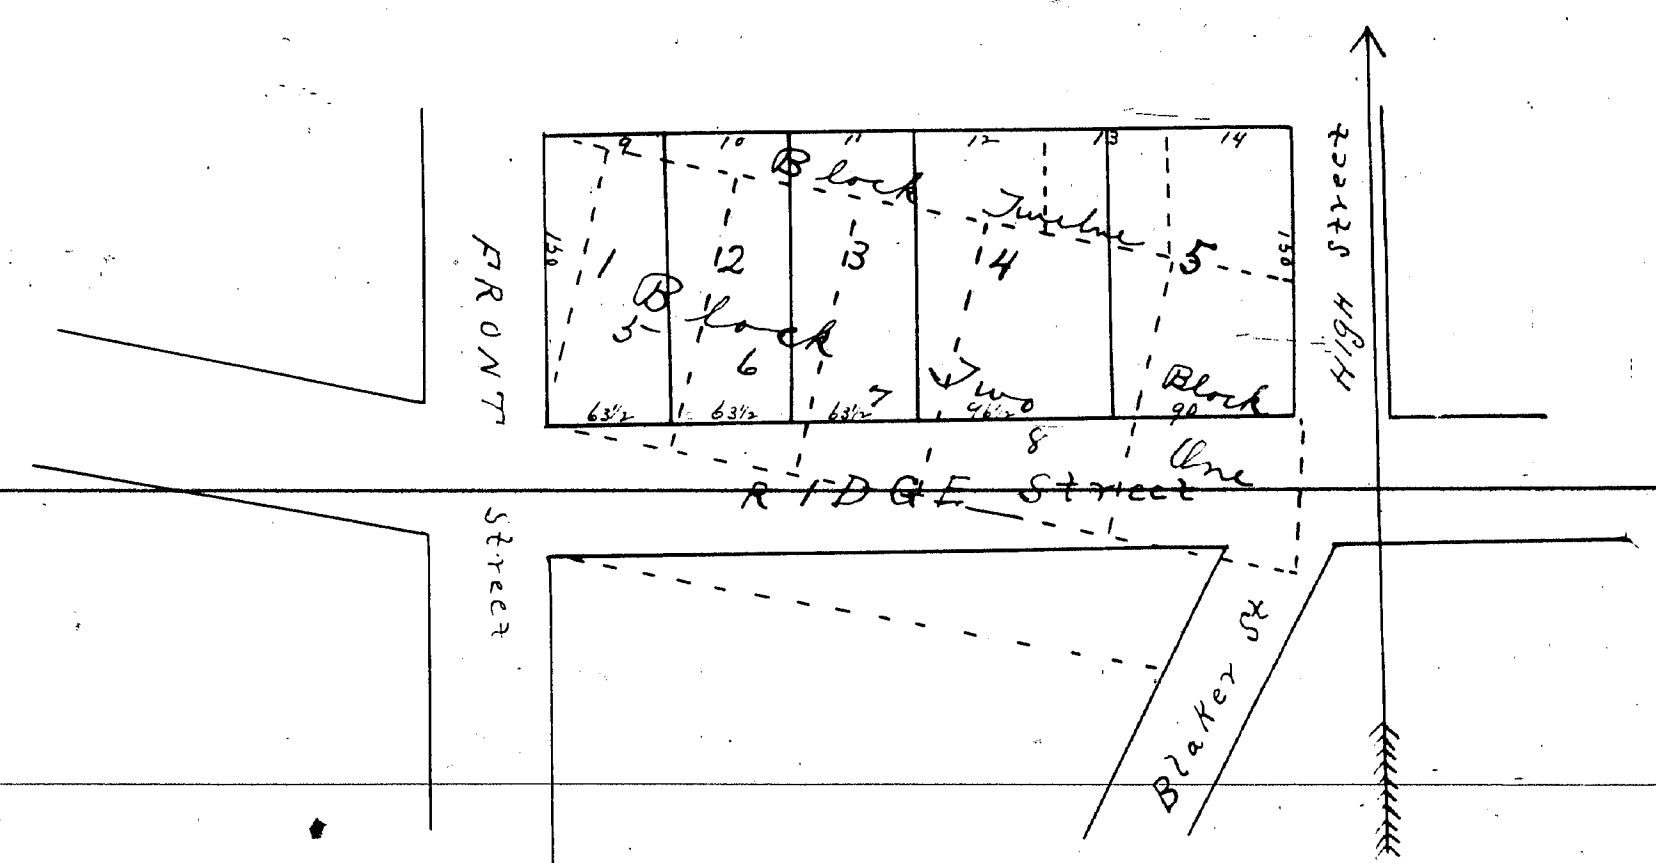

The above plat embraces Blocks One & Two (1+2) of the Thirty six acre Plat (commonly so called) being the subdivision of Lot No Two (2) of Fractional section No Twenty one (21) Town + 8 North of Range 25 West made by the Cleveland Iron Mining Company. John Burt, Charles Johnson and others, a map of which is recorded in the Register of Deeds of Marquette County in Liber 'B' of Deeds on page three (3). The lots known in said 36 acre plat as Lot No one of Block No one. Lots one Two, Three & Four (1, 2, 3+4) of Block No Two (2) have been heretofore replatted by John Burt in his 'Addition to the Village of Marquette' and one in that plat designated as lots Nine (9) Ten (10) Eleven (11) Twelve (12) Thirteen (13) + Fourteen (14) of Block No Twelve. (12) the same are heretofore replatted and made part of this plat. Said plat of John Burt's Addition is recorded in said County in Liber 6 of Deeds on page 445. The courses and direction of struts remain as shown in said John Burt's plat.

The red lines intersecting black lines are the original lines of the 36 acre plat. The red lines coincident and parallel with black lines are original lines of John Burt's Addition. The figures in red are the original numbers of lots in the additions to which the red lines inclose them respectively belong. The lines and figures in black are lines and numbers of lots heretofore laid out. The undersigned proprietors of the land above replatted in taken of their consent thereto have hereunto set their hands and seals the 29th day of July A.D. 1862.

In presence of
M. H. Maynard
Wm B. Berger

James L. Reynolds
John Burt

In presence of
F. Rockwell
Wm H. Fowler

Ellen E. Smith

Executed by the Cleveland Iron Mining Co
in presence of
James Wade Jr.
John M. Lauchlan

The Cleveland Iron Mining Co by
W. J. Gordon Pres.
James L. Mather Secy.

State of Michigan } ss
Marquette County } On this eleventh day of August A.D. 1862 before me a
Notary Public in and for said County personally came John Burt and James L. Reynolds
to me known to be the same persons who executed the foregoing Plat and instrument annexed thereto
and acknowledged the same to be their free act and deed.

M. H. Maynard
Notary Public.

The State of Ohio } ss
Lake County } Painesville August 19 1862 before me J. Rockwell a Notary
Public within and for said County personally appeared Ellen E. Smith a signer and sealer of the
foregoing instrument and acknowledged the signing and sealing of the same as her free act and deed
Given under my hand and seal on the day and year last above written.

Seal

J. Rockwell Notary Public

The State of Ohio } ss
Lake County } I, Christopher Quinn Clerk of the Court of Common
Pleas within and for the County of Lake and State of Ohio do by
these presents certify and make known that J. Rockwell Esquire, before whom the annexed
and foregoing acknowledgment of Ellen E. Smith was taken and who has Transcripts in his
own proper handwriting subscribed his name was at the time of taking the same and
is a Notary Public within and for said County duly commissioned and sworn agreeably to
the laws of the State of Ohio and who is duly authorized to take such acknowledgment and
that the annexed and foregoing instrument is executed and acknowledged agreeably to the
Laws of the State of Ohio.

In testimony whereof I have hereunto
set my hand and affixed the seal of said Court at Painesville in said County the
22 day of August in the year of our Lord One thousand Eight hundred and Sixty two.

Seal

C. Quinn Clerk

The State of Ohio } ss
Cuyahoga County } Be it remembered that on the 12th day of Sept A.D. 1862 before me
the undersigned a Commissioner in for the said State appointed by the Governor of the State of Michigan
to take the acknowledgements & proof of Deeds & instruments of writing under seal to be used &
recorded in said State of Michigan & to administer oath & affirmations & signed Wm J. Gordon President
& James L. Mather Secretary of the Cleveland Iron Mining Co and acknowledged that they had executed the
above instrument as the President & Secretary of the said Company for the uses & purposes therein mentioned
and the said W. J. Gordon & James L. Mather being by me duly sworn, did depose and say that they reside in
Cleveland Ohio that W. J. Gordon is the President & James L. Mather is the Secretary of the Cleveland Iron Mining Co
& that they know the corporate seal of said Co that the seal affixed to the above instrument is
such corporate seal that it was so affixed by order of the Board of Directors of said
Company & that they signed their names thereto by the order as President & Secy of said Company.

I further certify that the persons who made the said acknowledgements are known
to me to be the individuals described & who executed the said instrument.

Seal

James Wade Jr.
Commissioner for the State of Michigan