


11/1/6

Recd per deed October 3rd 1865 at 9 o'clock A.M.
J. P. Storer, Register

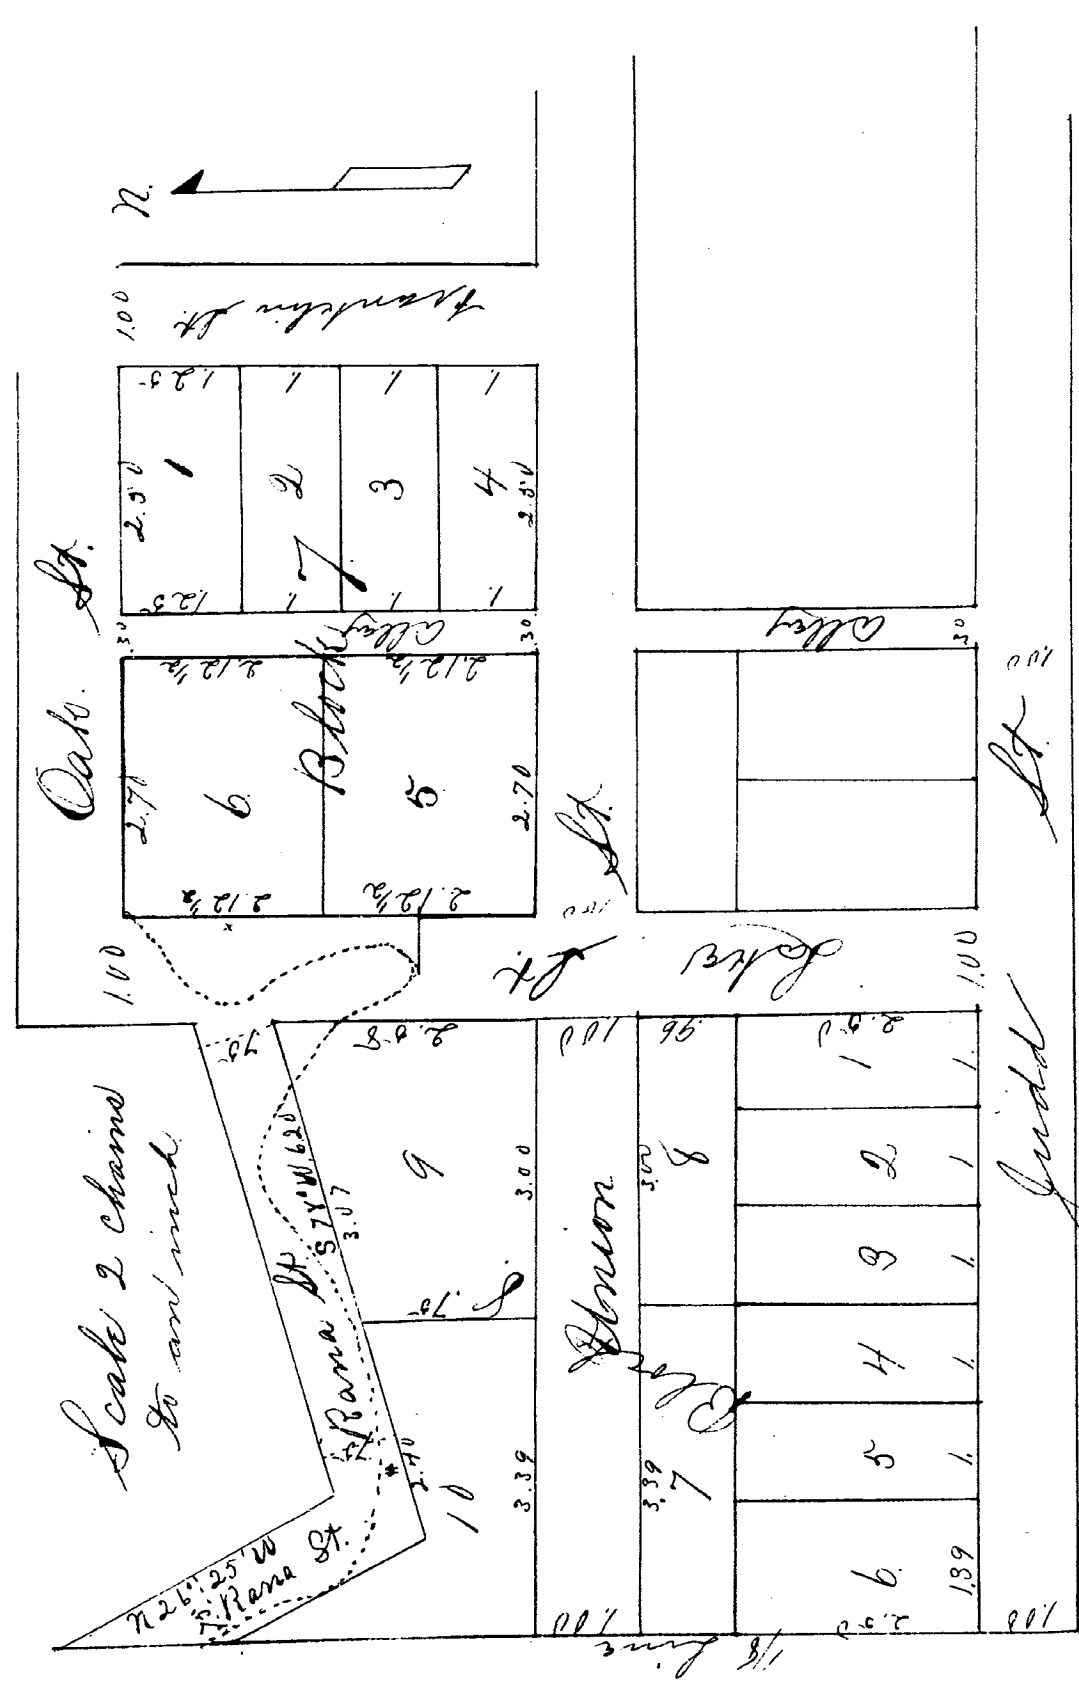

The red lines represent the lines of the lots as originally plotted
Plot of an alteration of lots 5 & 6, Block 7.
And subdivision of Lot 7, Block 8, of
Putnam's Second Addition to Greenville.

STATE OF MICHIGAN, ss **Office of Register of Deeds.**
COUNTY OF MONTCALM.
I, Wm. P. Lunn, Register of Deeds for said County, do hereby certify that the annexed and foregoing copy is a true transcript, compared by me with the original record in my office, of an instrument which was received for record in said office on the 3rd day of October, A. D. 1865, and recorded in Liber P of Deeds on page 438, and that it is a true transcript of the whole of such original record.
Witness my hand and the seal of said office at Stanton, in said County, this 1st day of June, A. D. 1897
Wm. P. Lunn
Register of Deeds.

I, Manning Putnam, proprietor of Lots 5, and 6, of Block 7 of Putnam Addition to Greenville, and of Lot 7 of Block 8 of the same Addition have caused the following alterations of said Lots to be made: First, Lake street is continued broadly across the west end of said lots 5 and 6 to Oak street, as shown on the within plot, said street being 4 rods wide. Second, Union Street is continued westerly through said lot 7 to the 15 line on the west side of said lot, said street being 4 rods wide. Third, A street to the known as "Pana" Street is laid out, as follows: Commencing at a point on the east line of Lake street 2.95 chains north of the south west corner of Block 7, running thence south 78° west 6.20 chains, thence north 26° 35' west until it strikes the west line of the N.E. 1/4 of Sec. 16, T. 9 N. R. 8. 1/2. Said street being three rods wide. Fourth, said Lot 7 is subdivided into 4 lots, to be known as lots 7, 8, 9 & 10 of Block 8. Witness my hand and seal at Greenville, Sept. 23rd, 1868.
Manning Putnam, (L.S.)
I, Edward H. Jones do certify that I have made a survey of the alteration above specified as shown by the plot on the opposite side of this sheet. Witness my hand and seal at Greenville, Sept. 23rd 1868.
Edward H. Jones, (L.S.)
Surveyor.

State of Michigan } ss
County of Montcalm. } In this 23rd day of September, A.D. 1868, personally came before me Manning Putnam and Edward H. Jones to me known to be the persons named in and who executed the foregoing instrument, and acknowledged the execution thereof to be their deed and deed.
Thomas W. Stornes.
Notary Public.

U. S. Rec'd
Stamp 5c
T. W. S.
9/23/68.

PROCEDED AND FILED
ACT 136 LAWS 1895
IN AUDITOR GENERAL'S OFFICE
JUN 3 - 1897 - 189 -

John F. Winimoor
Register of Deeds