


VILLAGE OF MCBRIDES,

D. L. JACOBS,
LUCY A. JACOBS, } Proprietors.

By F. A. PALMER, County Surveyor, 1878.

RECEIVED AND FILED
In Auditor General's Office,
June 11 1878
H. R. Pratt
Dep. Aud. Genl.

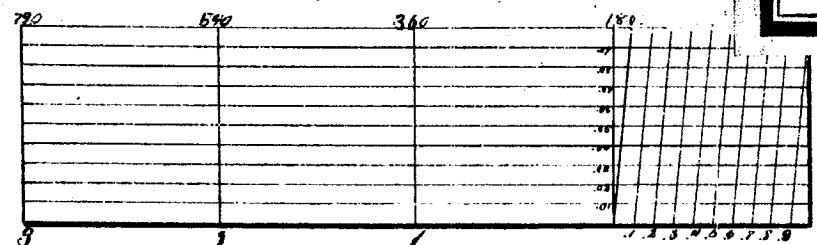

✓ PLAT - - VILLAGE OF MCBRIDE PART VACATED


By 6 C June 15 1891 C C Journal 7 page 13.
It is ordered, and adjudged now here that the following portions of that
portion of said plat, described in said petition, and hereinafter described
to wit: Lot numbered from three to twenty six inclusive Lots numbered from
Thirty five to Fifty five, inclusive and lots numbered from sixty three to
eighty, inclusive be and the same is hereby vacated, the following part of
the streets in said portion of said plat, to wit: 0
✓ all that portion East Atreet running south from the south line of Central
Street, all that portion of Corra Street, running east from the east line of
Earl Street all that portion of Earl Street running south from the south
line of Corra Street, all that portion of Cass Street running west to the
Detroit Lansing, and Northern Railroad from the west line of Earl Street be
vacated.

Aud Gen Dept P 630
Vol 11

Curtis & Taylor
Plat Examiners

Vol 154 - Page 12921 ✓

117

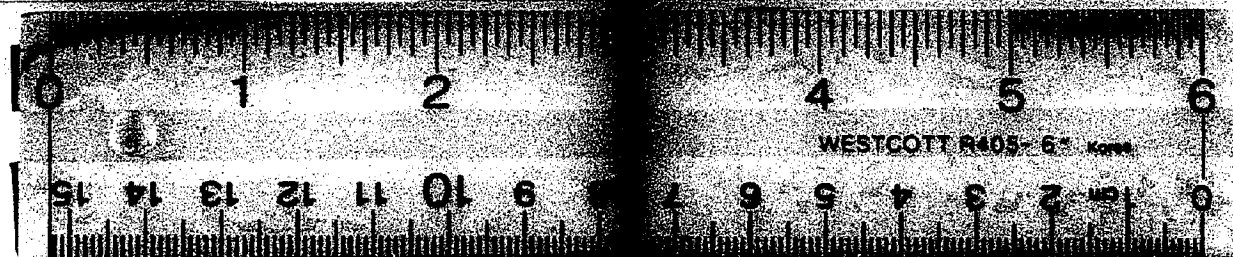

16 X