

PLAT OF PRESTON & CO'S ADDITION TO EDMORE,

MONTCALM COUNTY, MICHIGAN.

C. A. PRESTON, L. MERRIAM, J. H. TUBBS, O. M. BENEDICT, PROPRIETORS.

A de F. GARDNER, Surveyor.

July 1st, 1878.



STREET NAMES
CHANGED BY RESOLUTION
OF VILLAGE COUNCIL
APRIL 1, 1940
VOUCHER No. 382-40

RECEIVED AND FILED

In Auditor General's Office,

August 14, 1878

Dep. Aud. Genl.

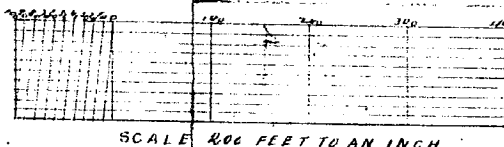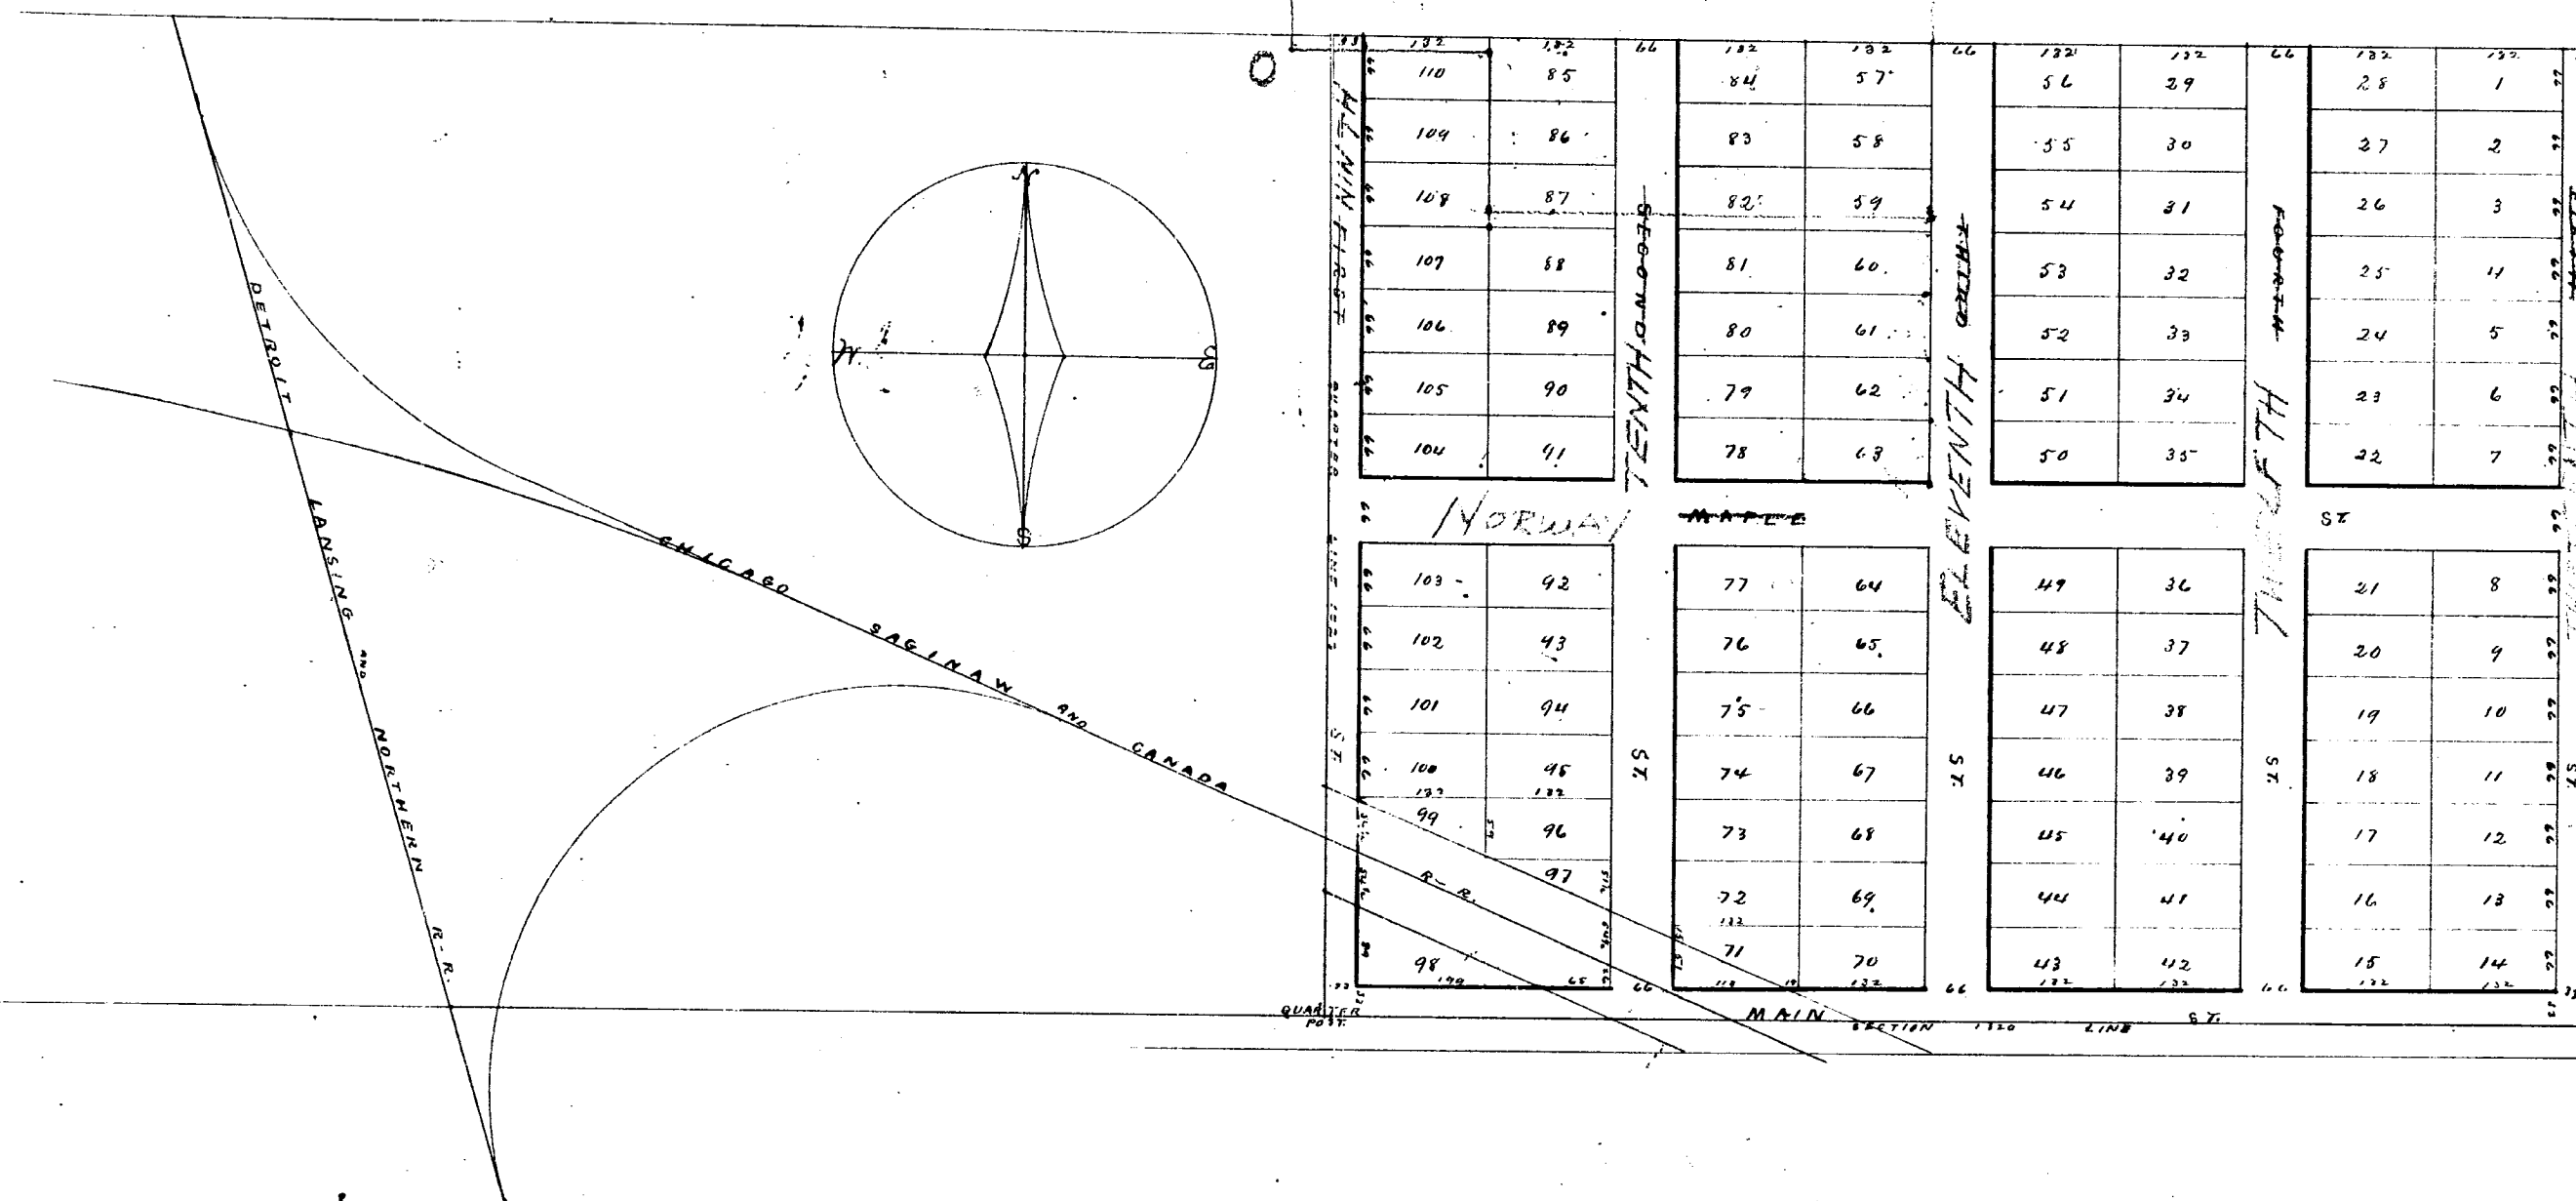

Know All Men by these Presents: —
That Ws, C. A. Preston, L. Merriam, J. H. Tubbs and O. M. Benedict, owners in fee of the following described land, to wit: A piece of land Ten hundred and twenty-three feet in width North and South by Thirteen hundred and twenty feet in length East and West lying in the South West Corner of the South East Quarter of Section number Twenty-one in Township number Twelve North of Range number Six West in the County of Montcalm and State of Michigan, have caused the same to be surveyed under the direction of A de F. Gardner a Civil Engineer and divided into lots and struts as shown by the above plat, the scale of which is two hundred feet to an inch, all streets as thereon designated are hereby dedicated to the use of the public as highways. The same to be known as Preston and Co's Addition to Edmore.
In Witness Whereof We have hereunto set our hands and seals this First day of July in the year one thousand eight hundred and seventy-eight.

In Presence of
H. E. Stromson
E. D. Finch

C. A. Preston (S)
Laurie Merriam (S)
John H. Tubbs (S)
O. M. Benedict (S)
A de F. Gardner (S)

State of Michigan
County of Ionia } On this First day of July
AD 1878 before me, Notary Public in and for said County
personally appeared C. A. Preston, L. Merriam, J. H. Tubbs and
O. M. Benedict to me known to be the persons who executed
the foregoing instrument and acknowledged the same
to be their free act and deed for the uses and purposes therein
mentioned.

Amasa Sessions

Notary Public,

Ionia Co. Mich.

State of Michigan
County of Montcalm } On this Sixth day of August
1878 personally appeared before me, Notary Public for said County,
A de F. Gardner known to me to be the person who executed the
foregoing plat and instrument and acknowledged the same to
be his free act and deed.

E. D. Finch

Notary Public.

Register Office } We E. D. Finch Register of Deeds and A.
Montcalm County } A de F. Gardner above named do hereby
certify that we have carefully compared the above plat with
the original plat of Preston & Co's Addition to Edmore and
that it is an exact duplicate thereof and of the whole of said Plat
dated August 6th 1878.

E. D. Finch Register

A de F. Gardner

Register Office } Received for Record August 6th
Montcalm County } AD 1878 at 2 o'clock P.M. and recorded in Liber
1 of Plats on Page 37.

E. D. Finch

Register Office } We E. D. Finch Register and
Montcalm County } A de F. Gardner above named do hereby certify that
we have carefully compared the above plat and in-
strument with the Record of Preston & Co's Addition to Edmore
and that it is a true transcript thereof and of the whole of such
Record.

E. D. Finch Register

A de F. Gardner