


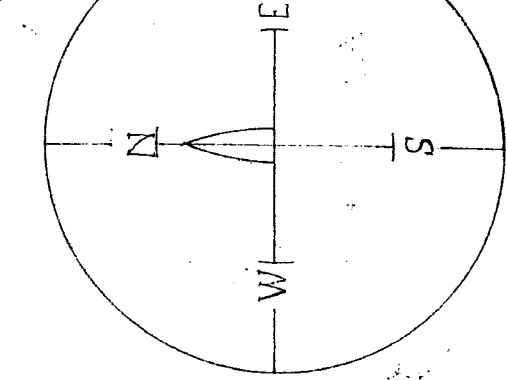

POINT RICHARDS,

Montcalm County, Michigan.

F. A. PALMER,
COUNTY SURVEYOR.

JAMES W. RICHARDS, }
NETTIE D. RICHARDS, } Proprietors.

JUNE, 1881.

STATE OF MICHIGAN, } ss.
County of Montcalm. }
Received for Record this 11th
day of June A. D. 1881
at 2 o'clock P. M. and Recorded in
Liber 1 of Plats
on page 45.

J. N. Strong,
Register of Deeds.

RECEIVED AND FILED
In Auditor General's Office,
June 15, 1881.
H. R. Pratt
Dep. Aud. Genl.

3.71	4.77	6.77	8.77	100.77
------	------	------	------	-------	-------	--------


Each 300 Links per inch - 198 feet

State of Michigan } ss.
County of Montcalm } On this 11th day of June
A.D. 1881 before me a Notary Public in and for
said County of Montcalm personally appeared James W.
Richards and Nettie D. his wife and J. A. Palmer some
known to be the persons described in and who ex-
ecuted the above plat and foregoing instrument
and acknowledged the same to be their free act and
deed and for the uses and purposes therein men-
tioned.

J. N. Strong,
Notary Public.

State of Michigan } ss. W. J. A.
County of Montcalm } Sterns Register of Deeds and J. A.
Palmer Surveyor do hereby certify this
that we have carefully compared this
plat with the original map or Plat with the original
map or Plat of Point Richards
and that the same is an exact
copy thereof and of the whole of such Map
or Plat.
J. N. Strong, Register of Deeds.
W. J. A. Sterns, Surveyor.

State of Michigan } ss. W. J. A. Sterns Register of Deeds and J. A.
County of Montcalm } Palmer Surveyor do hereby certify that we have carefully com-
pared the foregoing copy of said Map or Plat of
Point Richards and that it is a true
and correct copy of the original
Map or Plat of Point Richards.
J. N. Strong, Register of Deeds.
W. J. A. Sterns, Surveyor.

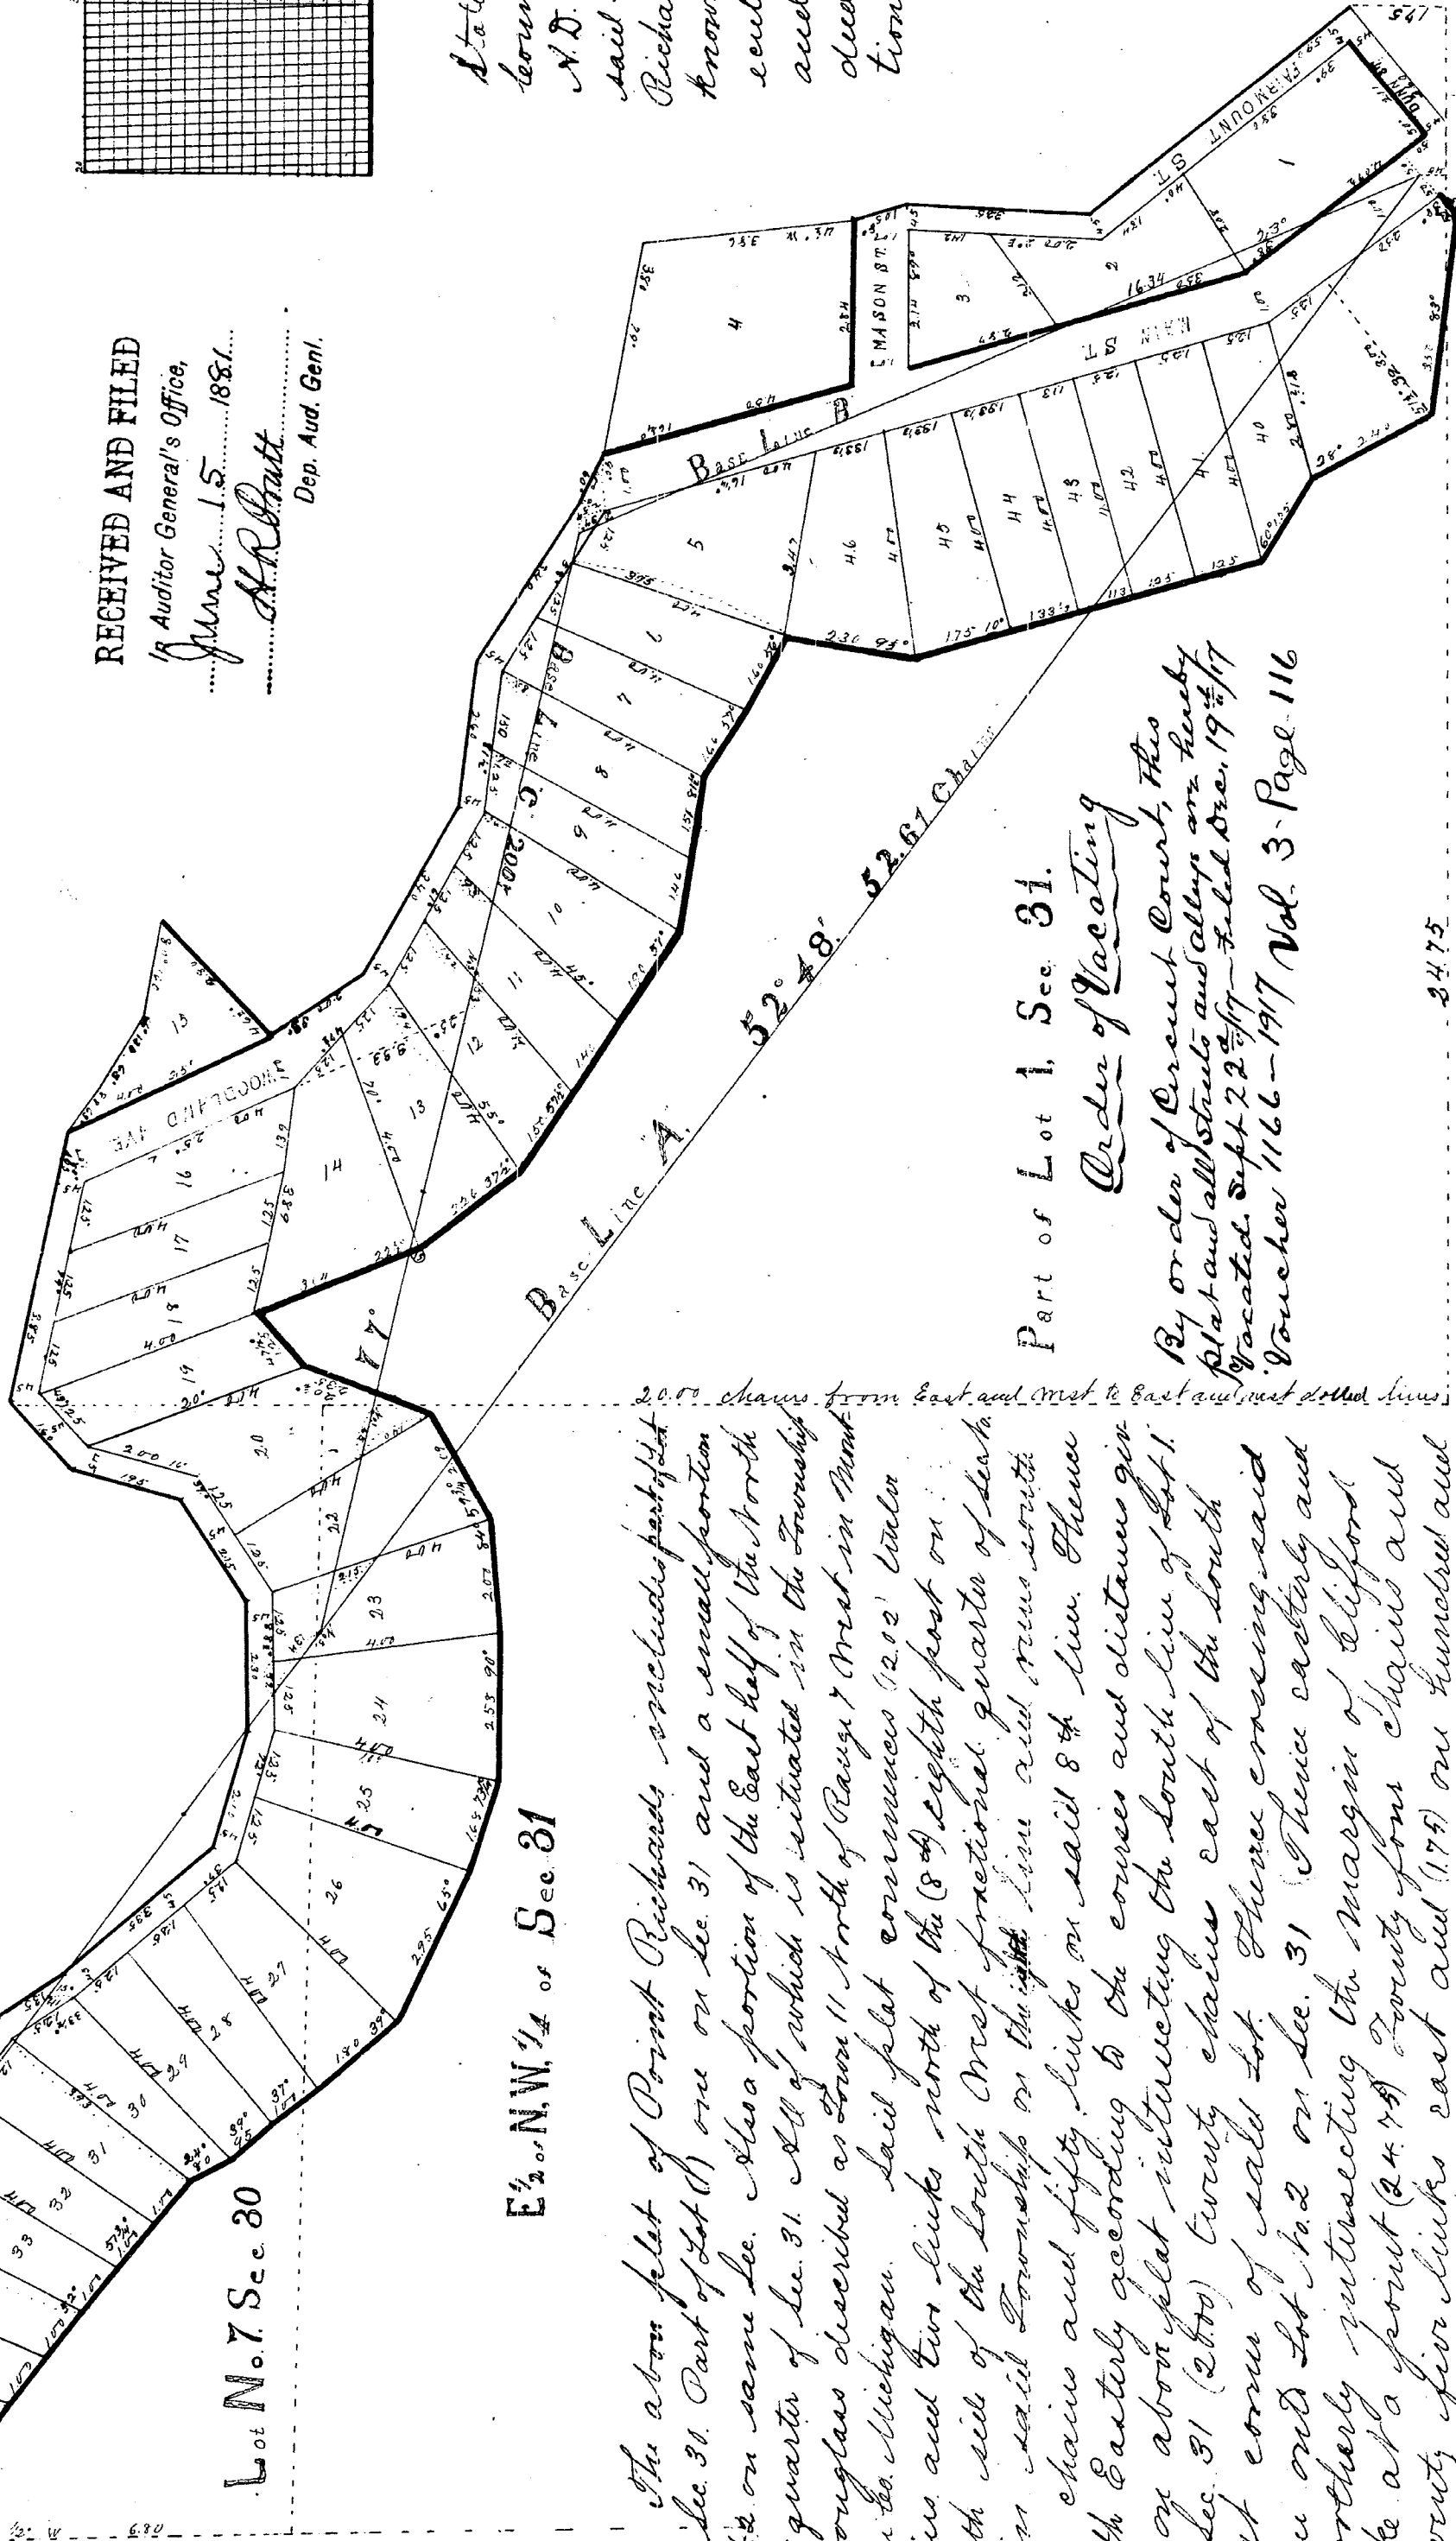

The above plat of Point Richards concludes part of
7 on Sec. 31. Part of Lot 1 on Sec. 31 and a small portion
of Lot 2 on same Sec. 31. Also a portion of the East half of the North
West quarter of Sec. 31. All of which is situated in the Township
of Douglas described as Town 11 North of Range 7 West in Mont-
calm Co. Michigan. Said plat commences 1200' under
chains and two links north of the (84) eighth foot on
south side of the North West fractional quarter of Sec. 31
30 in said Township on the right line and runs south
five chains and fifty links on said 8th line. Thence
South Easterly according to the courses and distances given
on an above plat intersecting the North line of Lot 1
on Sec. 31 (2470) twenty chains east of the South
West corner of said Lot. Thence easterly and
line on Lot No. 2 on Sec. 31. Thence easterly and
northerly intersecting the margin of Cliffs
Lake at a point (2470) twenty four chains and
seventy four links east and (175) one hundred and
seventy five links north of the south most corner
of Lot No. 1 Sec. 31. Thence Northerly and westerly a-
long the margin of the Lake according to the courses
and distances given on above plat to the east-
ing point. Stakes are set on the Base Line at in-
tervals of four chains. On Base line 8" they are run
and from the most end of Woodland Am. On Base line
6" they are numbered from the most end and all are in-
dicated by dots on the respective line.
The scale of the above plat is 300 links per inch.
All streets designated on this plat are hereby dedicated
to the use of the public as Highways forever.

In witness whereof James W. Richards and
Nettie D. his wife proprietors of the above
plat and J. A. Palmer the Surveyor
who reads the same have hereunto set
their hands and seals this eleventh day
of June A.D. 1881.
J. N. Strong,
J. A. Palmer,
J. W. Richards.

Notary Public
J. N. Strong
J. A. Palmer
J. W. Richards

PLAT -- VILLAGE OF CUSTER PART VACATED

By C C February 1 1882 C C Journal No 6, Page 33

It is ordered that all that portion of the Village Plat of Custer in the Township of Day Montcalm County, Michigan, described as follows viz: Commencing at the north west corner of said village, of Custer and running thence east on the quarter line to the center of First Street to its intersection with C Street thence west on the line of said C Street to its intersection with Second Street thence south on the line of said Second Street, to its intersection with Main Street thence east on the line of said Main Street to its intersection with First Street, thence south on the line of said First Street to its boundary line of said Village of Custer, according to the plat thereof thence west on said boundary line to its intersection, with Fourth Street thence north on the line of said Fourth Street to the place of beginning be vacated set aside and made null and void, and that all subdivision of the same into Lots Blocks Streets and alleys be cancelled vacated set aside and held for naught;
And Gen Dep Vol

Curtis & Taylor
Plat Examiners

Vol-154- Page-12920-

PLAT ----- CHURCH'S ADDITION TO GREENVILLE.
SLAGHT'S ADDITION TO GREENVILLE.

In the matter of the petition of Oscar C. Miller and Charles M. Miller for vacating a portion of Church's Addition to Greenville and certain portions of Slaughter's Addition to Greenville.

Oct. 16, 1905.

Frank D. M. Davies,
Circuit Judge.

Voucher 505. ---- 1914.

ORDERED that all that part of Church's Addition to Greenville (including Ave. A. and B. and such portions of Congress and north Franklin Streets) lying south and west of the right of way of the T. S. & M. R. Also Lots 6 to 10 incl. of Block 4 and Block 7 south of the right of way of the T. S. & M. R. and Lot 1 of Block 3, all of Slaughter's Addition, be vacated.

Vol. 154 Page 12917


PLAT POINT RICHARDS, IN DOUGLASS TOWNSHIP.

In the matter of the petition of Charles L. Spaulding and Walter S. Spaulding to vacate said plat.

Voucher No. 1166--1917.

ORDERED that said plat be vacated.
Dec. 3, 1917. Howard Wiest,
Circuit Judge.

Vol. 154 page 12931

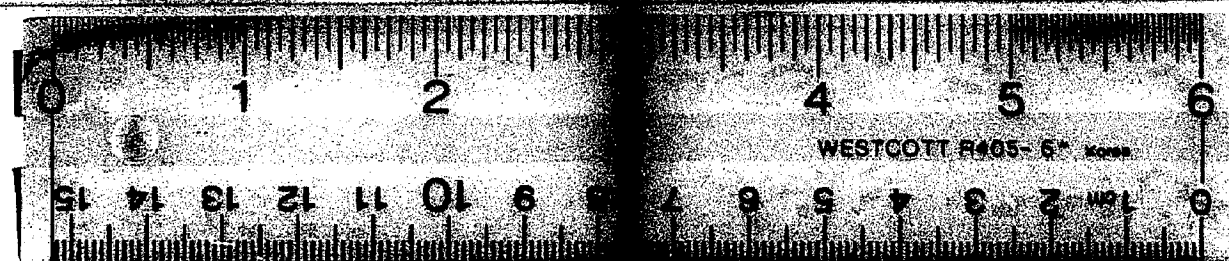

16 X