


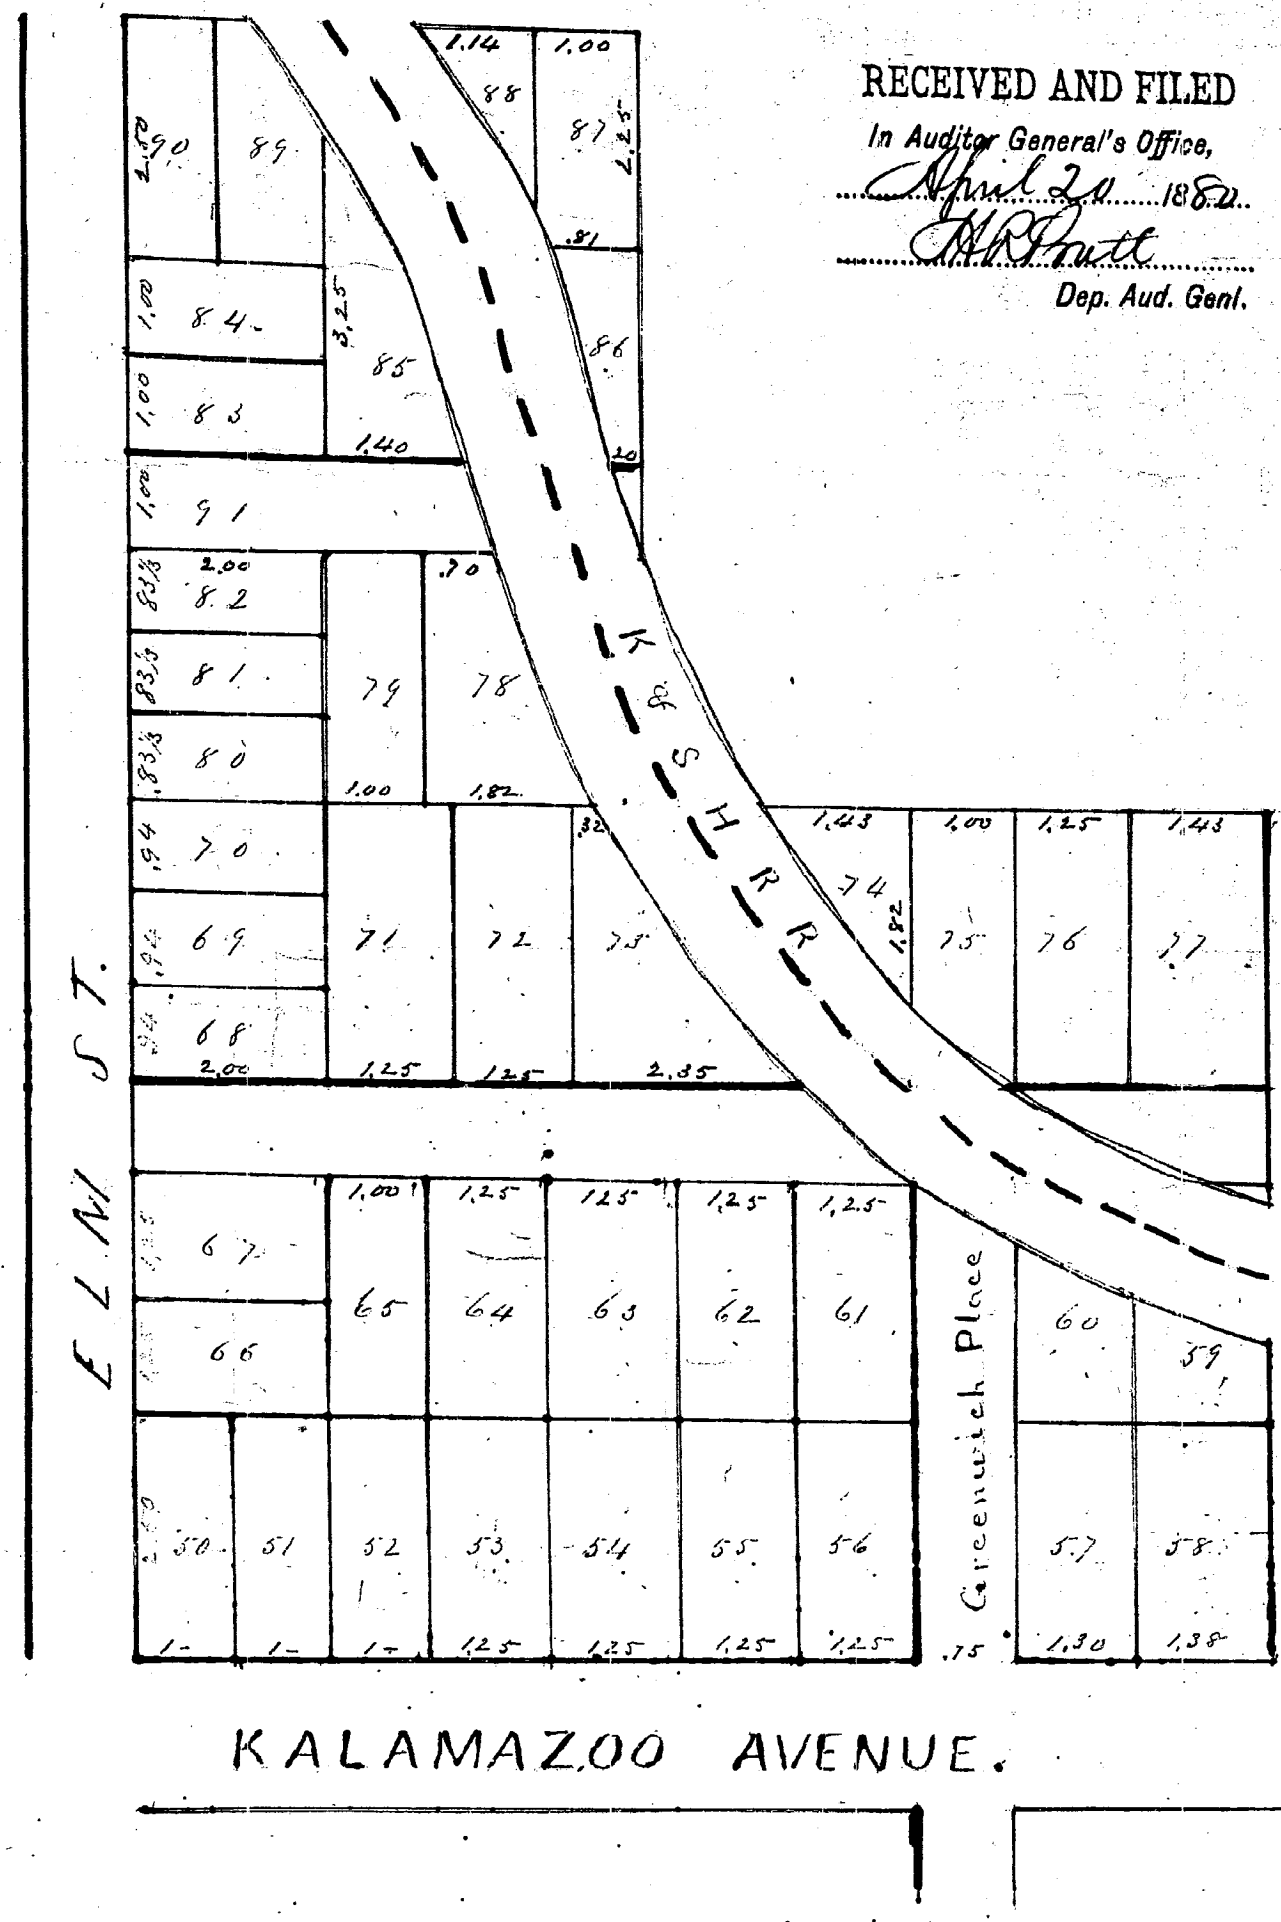

RECEIVED AND FILED
In Auditor General's Office,
April 20 1882
M. P. Pratt
Dep. Aud. Genl.

REVISED PLAT of PROUTY'S ADDITION To the Village of Kalamazoo.



Scale two chains to one inch

State of Michigan
County of Kalamazoo
I, Henry J. Smith, Register of Deeds, do hereby certify that we have carefully compared the annexed plat with the plat of Prouty's Addition to the Village of Kalamazoo, now of record in the office of said Register of Deeds, and find it to be a true and correct copy of the whole of said record.
Charles E. Smith, Register of Deeds
Henry J. Smith, Register of Deeds

Recorded in Volume 3 of Plats Page 10
Record for Record April 6th A.D. 1882 at 10 o'clock A.M.
Henry J. Smith
Register of Deeds
Kalamazoo, Mich

Revised Plat of Prouty's addition to the village of Kalamazoo being on lots 12, 13 and 14, Plat 2 on revised plat of section 16 Town 2 South of Range 11 West and on the east half of said section 16 the Greenwich Place is 75 links wide. The red figures denote the width of streets and size of lots in chains and links. The black figures denote the numbers of the lots. Scale two chains to one inch.

State of Michigan
County of Kalamazoo

Charles E. Smith
Draftsman.

On this first day of April in the year one thousand eight hundred and eighty before me the subscriber a notary public in and for said County personally appeared Charles E. Smith to me known to be the same person described in and who executed the annexed instrument and acknowledged the same to be his free act and deed.

Robert Dyer
Notary Public

Know all men by these presents that we Amariah J. Prouty and Sophia R. Prouty his wife claiming to own the lands set forth and described in the annexed plat and description do dedicate the same to be an addition to the village of Kalamazoo and do acknowledge the same to have been laid out by us as set forth in said annexed plat, and we dedicate the lands set apart for streets thereunto the village of Kalamazoo for public use as fully and as perfectly as we have power to do and the lots and streets on said plat to be annexed to the general plat of said village of Kalamazoo in the County of Kalamazoo and State of Michigan as a part and parcel thereof and we do declare the annexed plat to be a correct plat of said addition.

In Presence of
State of Michigan
County of Kalamazoo
Rufus H. Grosvenor
Henry J. Smith

Amariah J. Prouty
Sophia R. Prouty

On this 3rd day of April in the year one thousand eight hundred and eighty before me the subscriber a notary public in and for said County personally appeared Amariah J. Prouty and Sophia R. Prouty his wife to me known to be the same persons described in and who executed the annexed instrument and severally acknowledged the same to be their free act and deed.

Rufus H. Grosvenor
Justice of the Peace

State of Michigan
County of Kalamazoo

We hereby certify that we have carefully compared the foregoing copy with the original plat of the Revised Plat of Prouty's Addition to the village of Kalamazoo and that it is an exact copy thereof and of the whole of said plat.

Henry J. Smith, Register of Deeds
Charles E. Smith, Draftsman

CITY OF KALAMAZOO, MICHIGAN
ORDINANCE NO. 728
AN ORDINANCE TO AMEND ORDINANCE 498 AND REPEALING
CHANGES IN STREET NAMES
THE CITY OF KALAMAZOO ORDINANCE:

Section 1. Section 2 of Ordinance 498 as amended is hereby amended by adding thereto the following:

"Section 2. The names of the following streets shall be considered changed as indicated: . . .
W. Main St. - 17378
Stone & Phillips Plat - 13089
Prouty's Revised Add. - 13083
Allen & Hays Plat - 23704

Present Name

13. Emma Vista Street (Sec. 29, from Parvian Avenue to its northern terminus) Vista 1-1-66
14. Kane (Sec. 16, a new one-way northbound street providing access from Michigan Avenue to Elm Street) Elm Crossover 1-1-66
15. Elm Place (Sec. 16, names only the portion of Elm Place lying west of the new Nelson Manor - Michigan Avenue crossover) Creek Street 1-1-66


Section 2. All ordinances or parts of ordinances inconsistent herewith are hereby repealed.

CERTIFICATE

The above ordinance was duly adopted by the City Commission of the City of Kalamazoo, Michigan at its regular meeting held on the 15th day of November, 1965, and was duly recorded, posted and authenticated by the Mayor and City Clerk on the same date.


Raymond L. Hightower, Mayor

Arlene R. Vander Roest, City Clerk

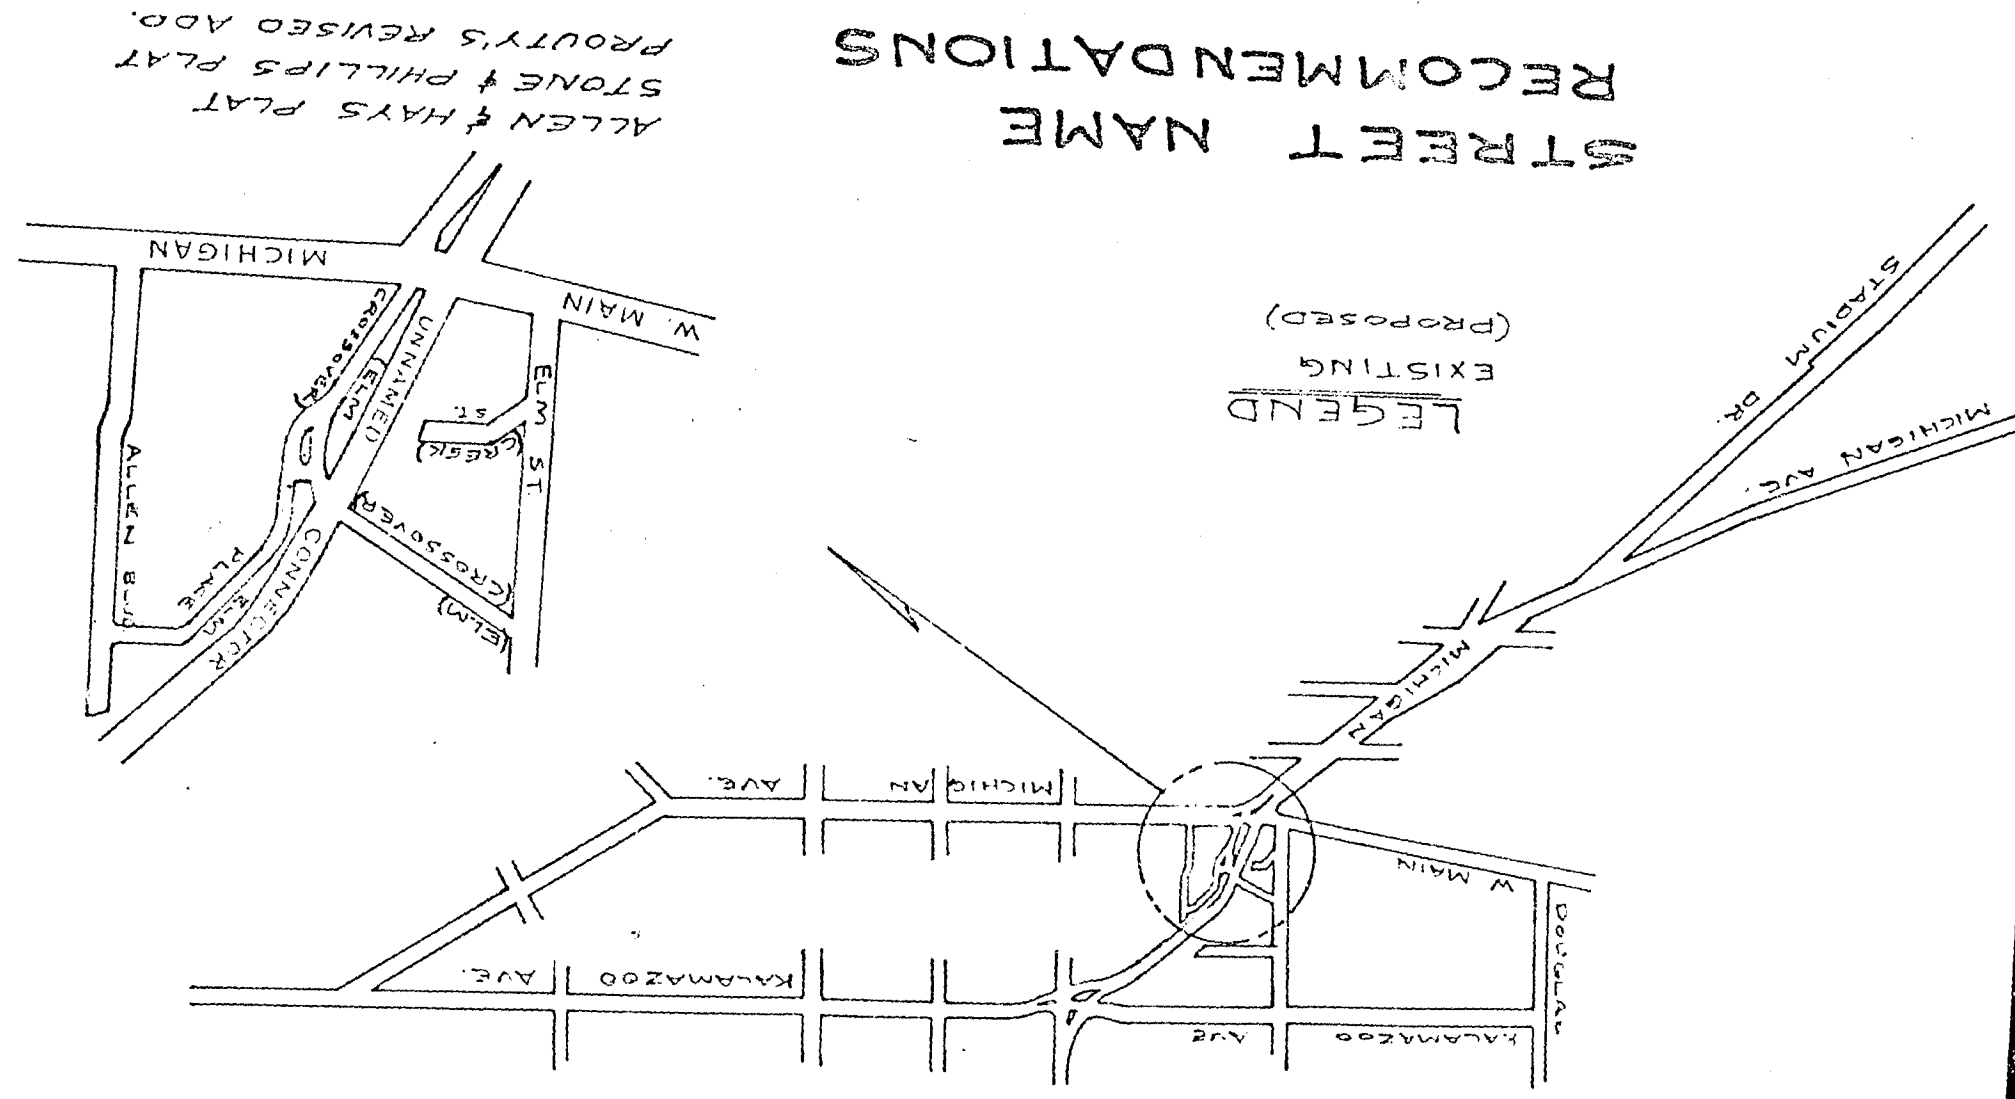

STREET NAME
RECOMMENDATIONS

LEGEND
(PROPOSED)
EXISTING

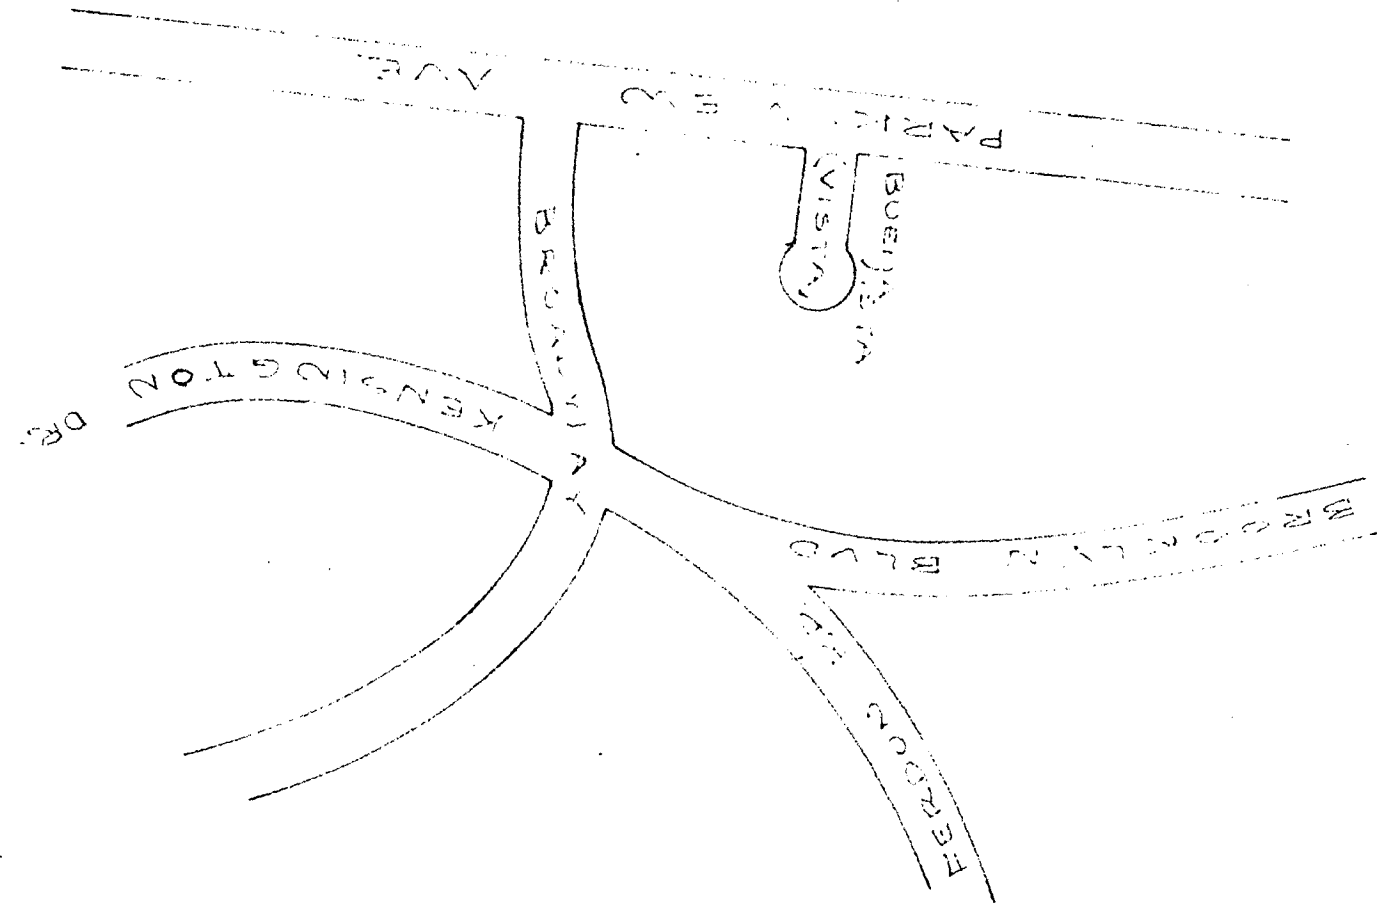

STREET NAME
RECOMMENDATIONS

STATE OF MICHIGAN,) ss. I, Arlene R. Vander Roest, City Clerk
CITY OF KALAMAZOO,)
of the City of Kalamazoo, having custody of the Ordinances of the City of Kalamazoo

of said City, do hereby certify that I have compared the attached copy of Ordinance No. 728 amending Ordinance No. 498, Change in Street Names, adopted November 15, 1965,

with the original now on file and of record in this office, and that such copy is a true and correct transcript thereof.

In Testimony Whereof, I have hereunto set my hand and affixed the Seal of said City, this 17th day of November 1965

Arlene R. Vander Roest
City Clerk

CHAPTER I
GENERAL PROVISIONS

SECTION A101. The City Flag shall be blue, charged with an emblem as follows: The American Eagle and thirteen stars and the colors red, white, and blue from the National Emblem; upper left quarter of shield symbolizing religion; upper right quarter of shield, our principal agricultural product, celery; the lower left quarter of shield, industry; the lower right quarter of shield, education; superimposed on shield the letter "K"; surrounding the shield a large circle having the letters, Education, Industry and Progress; the entire emblem surrounded by a live oak wreath indicating growth with ribbon scroll with the letters of the City of Kalamazoo, and all in accordance with the design thereof on file in the Office of the City Clerk, said design being expressly made a part of this Ordinance the same as is attached hereto. (Ord. 117, Sec. 1)

SECTION A102. It shall be unlawful for any person, persons, firm or corporation, to display the City Flag for advertising purposes, or in connection with any advertising matter, picture, or device, or to place upon the flag any inscription, letter, picture, or device other than those specified in this act. Any person offending against the provisions of this section shall be guilty of a misdemeanor, and upon the conviction thereof, before a court of competent jurisdiction, shall be punished by a fine of not less than \$5.00 nor more than \$25.00 or imprisonment in the County Jail for not less than one (1) nor more than thirty (30) days in the discretion of the Court. (Ord. 117, Sec. 2)

SECTION A103. Official Designation of Public Streets.

A103.1 That the names of the streets hereinafter set out shall be changed as follows: (Ord. 498, Sec. 1 as amended by Ord. 503)

Present Name:

Ada Street (Between Cobb Avenue & Staples Avenue)

Alcott Court
Bronson Court
Burrell Place
Cambridge Road
Carlton Court
Cherry Avenue
Crawford Court
Edgewood Place
Field Court
Fisher Court
Fletcher Place
Franklin Circle
Fredrick Place
Garfield Court
Gibson Street
Glen Road
Glenwood Avenue
Grand Prairie Street
Hawley Court
King Avenue
Lookout Street
Madison Avenue
Melrose Street
Morgan Avenue
Nelson Court
Sterns Avenue
Upjohn Court

Changed to:

Nola Street
West Alcott Street
Sally's Court
Lawrence Street
Dover Road
Cadillac Street
Redwood Avenue
Hickory Court
Westchester Lane
Fenwick Place
Federal Court
Skinner Drive
Franklin Street
Evergreen Drive
Vandersalm Court
Cameron Street
Peake Road
Knollwood Avenue
Alamo Avenue
Hawley Street
Kent Avenue
LaRue Street
Sutherland Avenue
Lay Boulevard
Farrell Avenue
Statson Court
Buckingham Avenue
Patterson Court

*A103.2 (Ord. 498, Sec. 2 added by Ord. 502, and amended by Ord. 620, amended by Ord. 714) The names of the following streets shall be considered changed as indicated:

Present Name	Changed To	Effective
Vandegiesen Rd., South of US 12	Waite Avenue	5-6-57
Parker Street	Pioneer Street	5-6-57
Sunnydale Avenue (Hill's 'Brook Plat)	Edgecliff Lane	2-24-58
Thomas Avenue	Centerridge Road	2-24-58
Michigan Avenue (Lovell to South)	Oakland Drive	8-11-58
New Unnamed US 12 (Lovell to South)	Michigan Avenue	8-11-58
New Unnamed Access Street to Milwood Jr. High (Miller Road South to Cambridge Dr.)	Balkema Street	8-11-58
Adams Street (Sec. 34)	Albany Street	2-15-62
Crest Street (Sec. 17)	Lawn Drive	2-15-62
*Fennel Street (Sec. 36 from Cork St. to its southern terminus)	Emerald Drive	6-1-65
*Emerald Drive (Sec. 35 and 36, three non- continuous loop streets from Cork St. to its southern terminus)	Pennway Street	6-1-65
*Norwood Avenue (Sec. 29 from Parkview Ave. to its northern terminus)	Broadway Street	6-1-65

A103.3 (Ord. 498, Sec. 3 as added by Ord. 525, repealed by Ord. 620)

A103.4 (Ord. 498, Sec. 4 as added by Ord. 542, repealed by Ord. 620)