

Sub A

0 5515

1811


SUB of LOT A
OF
RADZINSKI SUB. OF THE N. 2 1/8 ACRES OF LOT 9
OF
EUREKA STEEL AND IRON WORKS SUB.

PART OF SEC. 29 ECORSE WAYNE Co. Mich
SCALE: 1 INCH = 50 FT.

VACATED BY RESOLUTION
OF CITY COUNCIL
ON 2-2-1904
VOUCHER No. 240-51

RADZINSKI ST. 89° 40' E. 45 FT. WD.

12 TH. ST. N. 0° 30' W. 60 FT. WD.

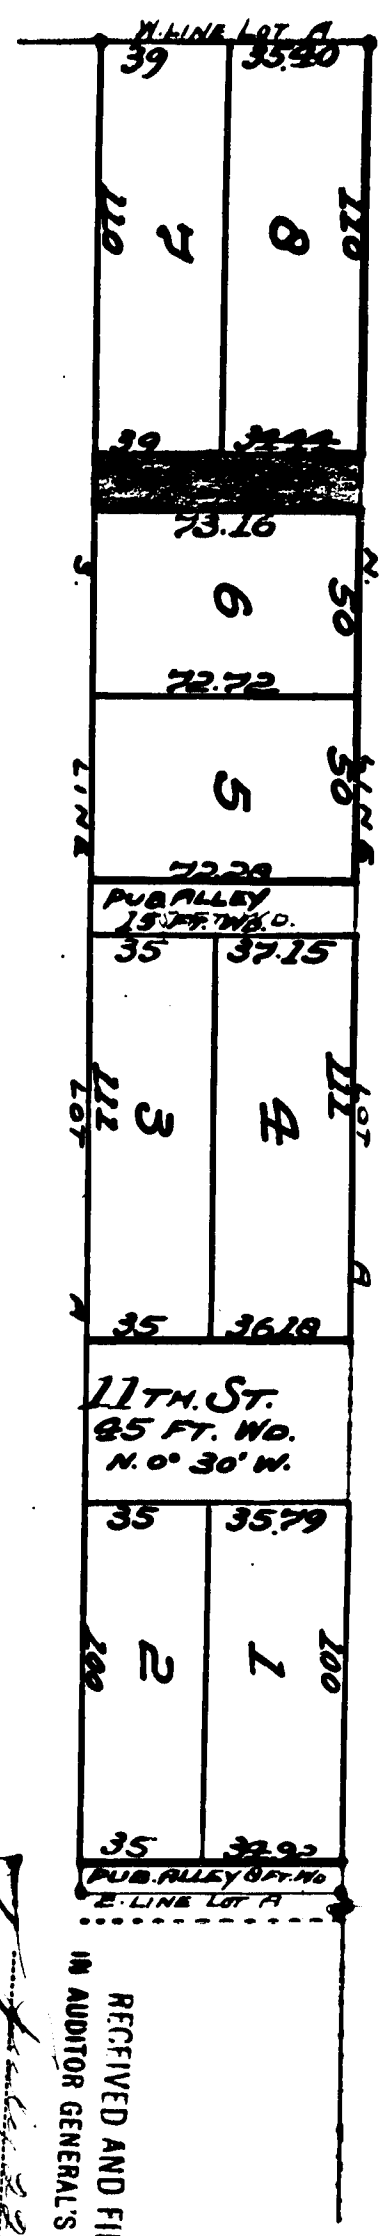

RECEIVED AND FILED,
IN AUDITOR GENERAL'S OFFICE,
JAN 23 1904

I hereby certify that the above plat is correct and that the same is a true and correct copy of the original plat on file in the office of the Auditor General of the State of Michigan.

William C. King
Auditor General

W. C. King








REGISTER OF DEEDS OFFICE
WAYNE COUNTY, MICH.




32/81

05515

SUB OF LOT A OF RADZINSKI SUB. OF THE N. 2 1/2 ACRES OF LOT 9 OF EUREKA STEEL AND IRON WORKS SUB.


PART OF SEC. 29 ECORSE WAYNE CO. MICH.
SCALE: 1 INCH = 50 FT.

VACATED BY RESOLUTION
OF CITY COUNCIL
MARCH 10, 1908

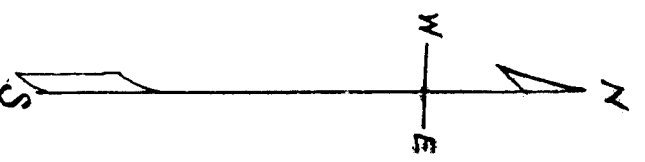

RADZINSKI ST. 69° 40' E. 45 FT. WD.

12 TH. ST. N. 0° 30' W. 60 FT. WD.

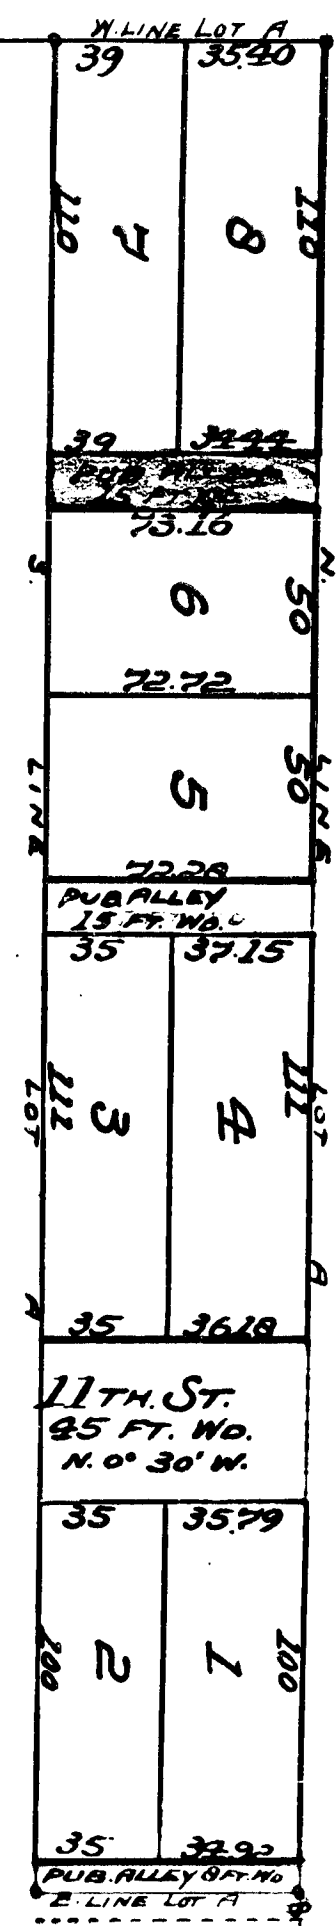

RECEIVED AND FILED,
IN AUDITOR GENERAL'S OFFICE,

Deputy Auditor General









