

COPY
REGISTERED OFFICE.
Kalamazoo County, Mich.
PLAT OF
Brown & Hoekstra's Addition
WAS RECORDED THIS
11th DAY OF
Oct. 11, 1911
AT 8 O'CLOCK
A. M. IN LINE
30 OF PLAT
S. H. Carleton
REGISTER OF DEEDS
ORIGINAL ON FILE

Filed in Auditor General's Dep't
OCT 13 1911
Geo. L. Hanson
Deputy Auditor General.

Examined and Approved
OCT 10 1911
Geo. L. Hanson
Deputy Auditor General.

PLAT OF Brown & Hoekstra's Addition TO THE CITY OF KALAMAZOO, MICHIGAN

SURVEY BY
MICHIGAN ENGINEERING CO.
Kalamazoo, Michigan

Scale 1 inch to 80 feet

DESCRIPTION OF LAND PLATTED

The annexed plat of Brown and Hoekstra's Addition consists of a portion of lots 23 and 35 of Plat No. 2, or Revised Plat of Section 10, T. 2, S. R. 11, W. and is more particularly described as follows: Commencing at a point in the N. , thence S. 22° 34' E. along the Easterly line of Douglas Ave. 644.5 feet; thence S. 89° 43' E. 160.2 feet; thence South 165 feet to the N. line of North Street; thence S. 89° 43' E. along the N. line of North Street 330 feet; 89° 43' W. 631.12 feet; thence N. 89° 43' E. 168.85 feet to the place of beginning. Excepting the following: commencing at a point in the N. & S. $\frac{1}{4}$ line 1672.14 feet S. of the N. $\frac{1}{4}$ post of said section and running thence S. 132 feet; thence S. 89° 43' E. 168.1 feet; thence N. 132 feet; thence N. 89° 43' W. 168.85 feet to beginning.

SURVEYOR'S CERTIFICATE

I hereby certify that the plat hereon delineated is a correct one, and that permanent monuments consisting of iron rods $\frac{3}{8}$ inch in diameter and twenty-four inches long have been planted at all points marked thus (o) as thereon shown, at all angles in the boundaries of the land platted and at the intersections of the streets.

DEDICATION

KNOW ALL MEN BY THESE PRESENTS: That we, Samuel Hoekstra & Sada M. Hoekstra, his wife, and Wm. W. Brown & Cora Brown, his wife, as proprietors, have caused the land embraced in the annexed plat to be surveyed, laid out and platted, to be known as BROWN AND HOEKSTRA'S ADDITION, and that the streets and avenues as shown on said plat are hereby dedicated to the public.

Witnessed by

STATE OF MICHIGAN }
COUNTY OF KALAMAZOO } ss.

On this 11th day of September, A. D. 1911, before me, appeared Samuel Hoekstra & Sada M. Hoekstra, his wife, and Wm. W. Brown & Cora Brown, his wife, known by me to be the persons who executed the above dedication and acknowledged the same to be their free act and deed.

My commission expires October 6, 1914

Notary Public, Kalamazoo County, Michigan.

CITY OF KALAMAZOO }
COUNTY OF KALAMAZOO } ss.
STATE OF MICHIGAN }

The annexed plat of BROWN AND HOEKSTRA'S ADDITION was approved by the Common Council in regular meeting, Sept. 11, 1911.

TAX CERTIFICATES

STATE OF MICHIGAN }
COUNTY OF KALAMAZOO } ss.
CITY OF KALAMAZOO }

I hereby certify that I have examined the records in my office relating to the description of real estate described in the plat of Brown and Hoekstra's Addition dated Sept. 11, 1911, and from such examination I hereby certify that all City taxes and assessments, extraordinary as well as ordinary, which are now due, have been paid.

This does not cover City taxes of the current year (payable July 1) until after Jan. 9


Kalamazoo, Mich., Sept. 21, 1911.

TAX CERTIFICATE

STATE OF MICHIGAN }
COUNTY OF KALAMAZOO } ss.

I hereby certify that I have examined the records in my office relating to the description of lands in the plat of Brown and Hoekstra's Addition, dated Sept. 11, 1911, and from such examination it appears that the taxes have been fully paid for the five years preceding said date, and that there are no tax liens or titles held by the State or individuals for five years preceding said date.

Kalamazoo, Mich., Sept. 21, 1911.

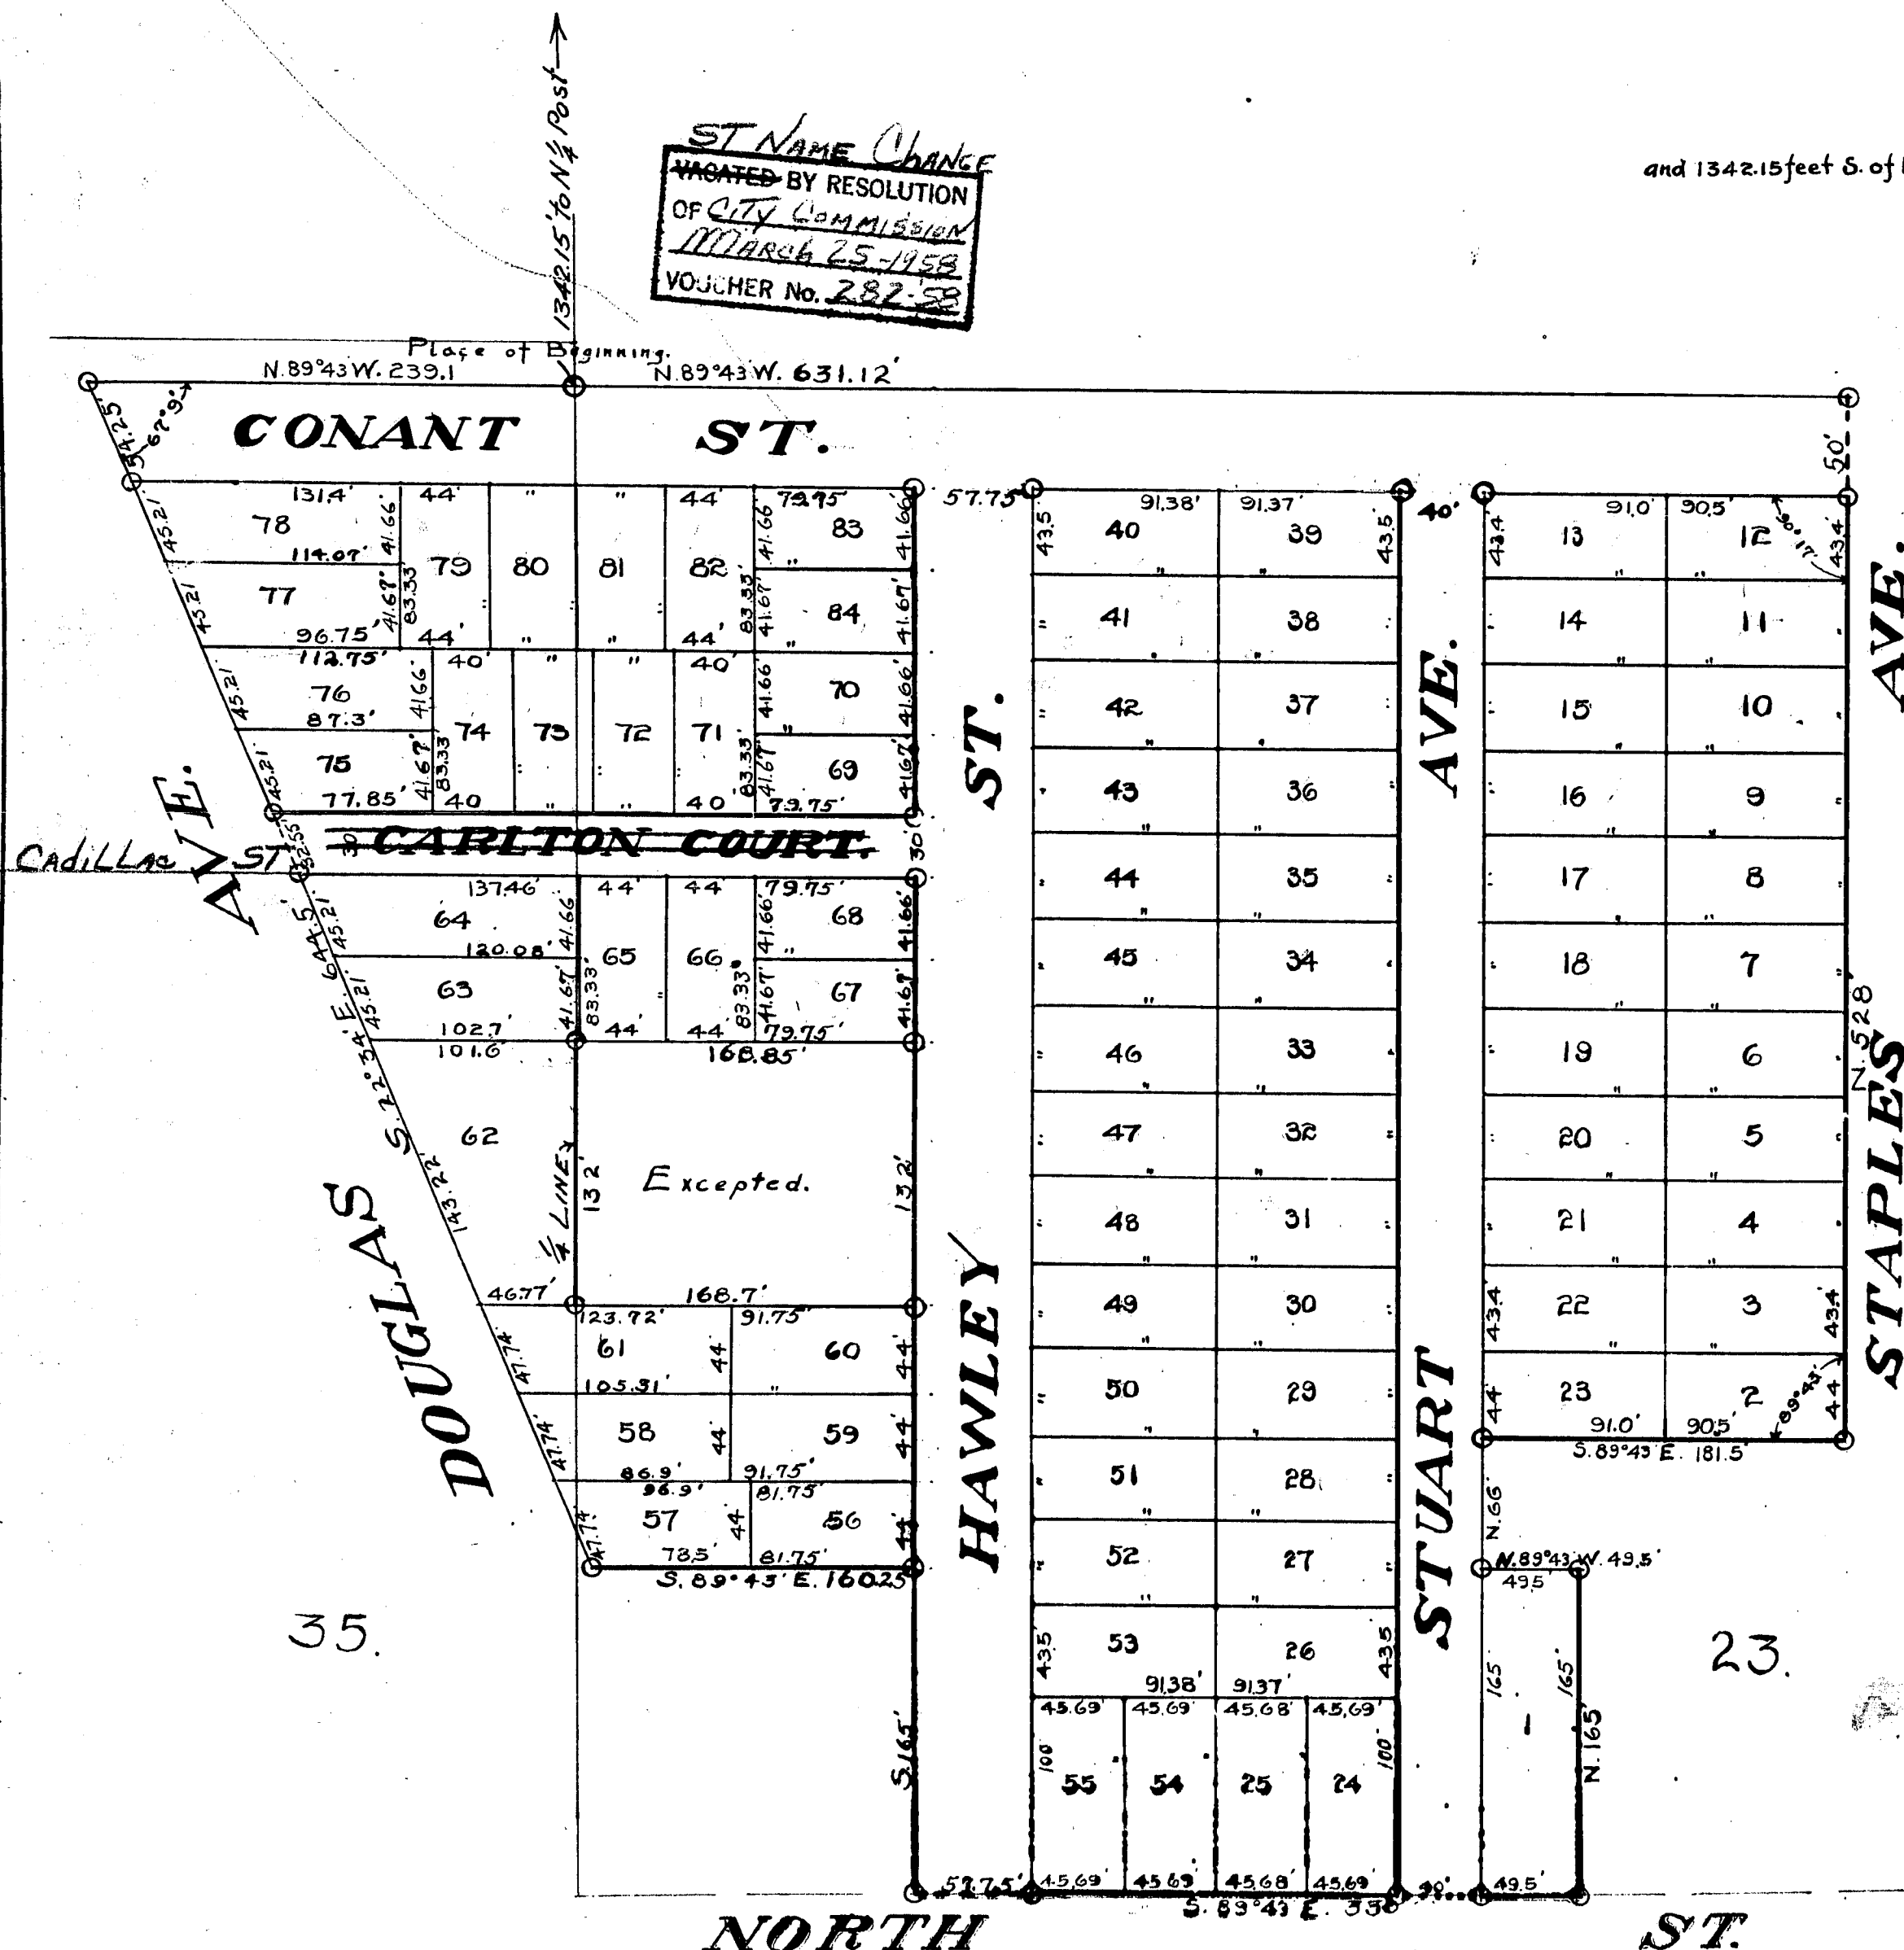

13234

Kalamazoo, Mich.
Noted
Oct 11 1911
S. H. Leighton
ORIGINAL ON FILE

Filed for Record
OCT 13 1911
Geo. L. Hanson

OCT 10 1911
Geo. L. Hanson

PLAT OF Brown & Hoekstra's Addition TO THE CITY OF KALAMAZOO, MICHIGAN

SURVEY BY
MICHIGAN ENGINEERING CO.
Kalamazoo, Michigan

Scale 1 inch to 80 feet

DESCRIPTION OF LAND PLATTED

The annexed plat of Brown and Hoekstra's Addition consists of a portion of lots 23 and 35 of Plat No. 2, or Revised Plat of Section 16, T. 2, S. R. 11, W. and is more particularly described as follows: Commencing at a point in the N. and S. 1/4 line of Sec. 16, 22.90 feet south of the N. E. corner of lot 35 of Plat No. 2, or Revised Plat of Section 16, T. 2, S. R. 11, W. and running thence N. 89° 43' W. 239.1 feet to the Easterly line of Douglas Ave., thence S. 22° 34' E. along the Easterly line of Douglas Ave. 644.5 feet; thence S. 89° 43' E. 160.2 feet; thence South 165 feet to the N. line of North Street; thence S. 89° 43' E. along the N. line of North Street 330 feet; thence North 165 feet; thence N. 89° 43' W. 49.5 feet; thence North 60 feet; thence S. 89° 43' E. 181.5 feet to the west line of Staples Ave.; thence North along the W. line of Staples Ave. 528 feet; thence N. 89° 43' W. 631.12 feet; to the place of beginning. Excepting the following: commencing at a point in the N. & S. 1/4 line 1672.14 feet S. of the N. 1/4 post of said section and running thence S. 132 feet; thence S. 89° 43' E. 168.1 feet; thence N. 132 feet; thence N. 89° 43' W. 168.85 feet to beginning.

SURVEYOR'S CERTIFICATE

I hereby certify that the plat hereon delineated is a correct one, and that permanent monuments consisting of iron rods 3/8 inch in diameter and twenty-four inches long have been planted at all points marked thus (o) as thereon shown, at all angles in the boundaries of the land platted and at the intersections of the streets.

DEDICATION

KNOW ALL MEN BY THESE PRESENTS: That we, Samuel Hoekstra & Sada M. Hoekstra, his wife, and W. W. Brown & Cora Brown, his wife, have caused the land embraced in the annexed plat to be surveyed, laid out and platted, to be known as BROWN AND HOEKSTRA'S ADDITION, and that the streets and avenues as shown on said plat are hereby dedicated to the public.

Witnessed by

STATE OF MICHIGAN }
COUNTY OF KALAMAZOO } ss.

On this 11th day of Sept. 1911, before me, appeared W. W. BROWN & CORA BROWN HIS WIFE, known by me to be the persons who executed the above dedication and acknowledged the same to be their free act and deed.

My commission expires 1st Jan. 1912

Notary Public, Kalamazoo County, Michigan.

CITY OF KALAMAZOO }
COUNTY OF KALAMAZOO } ss.
STATE OF MICHIGAN }

The annexed plat of BROWN AND HOEKSTRA'S ADDITION was approved by the Common Council in regular meeting, Sept. 11, 1911.

TAX CERTIFICATES

STATE OF MICHIGAN }
COUNTY OF KALAMAZOO } ss.
CITY OF KALAMAZOO }

I hereby certify that I have examined the records in my office relating to the description of real estate described in the plat of Brown and Hoekstra's Addition dated Sept. 11, 1911, and from such examination I hereby certify that all City taxes and assessments, extraordinary as well as ordinary, which are now due, have been paid.

This does not cover City taxes of the current year (payable July 1) until after Aug. 14, nor School taxes of the current year (payable Dec. 1) until after Jan. 9.

Kalamazoo, Mich., Sept. 21, 1911.

Frank Tomlinson
City Treasurer.


TAX CERTIFICATE

STATE OF MICHIGAN }
COUNTY OF KALAMAZOO } ss.

I hereby certify that I have examined the records in my office relating to the description of lands in the plat of Brown and Hoekstra's Addition, dated Sept. 11, 1911, and from such examination it appears that the taxes have been fully paid for the five years preceding said date, and that there are no tax liens or titles held by the State or individuals for five years preceding said date.

Kalamazoo, Mich., Sept. 21, 1911.

Walter Smith
County Treasurer.

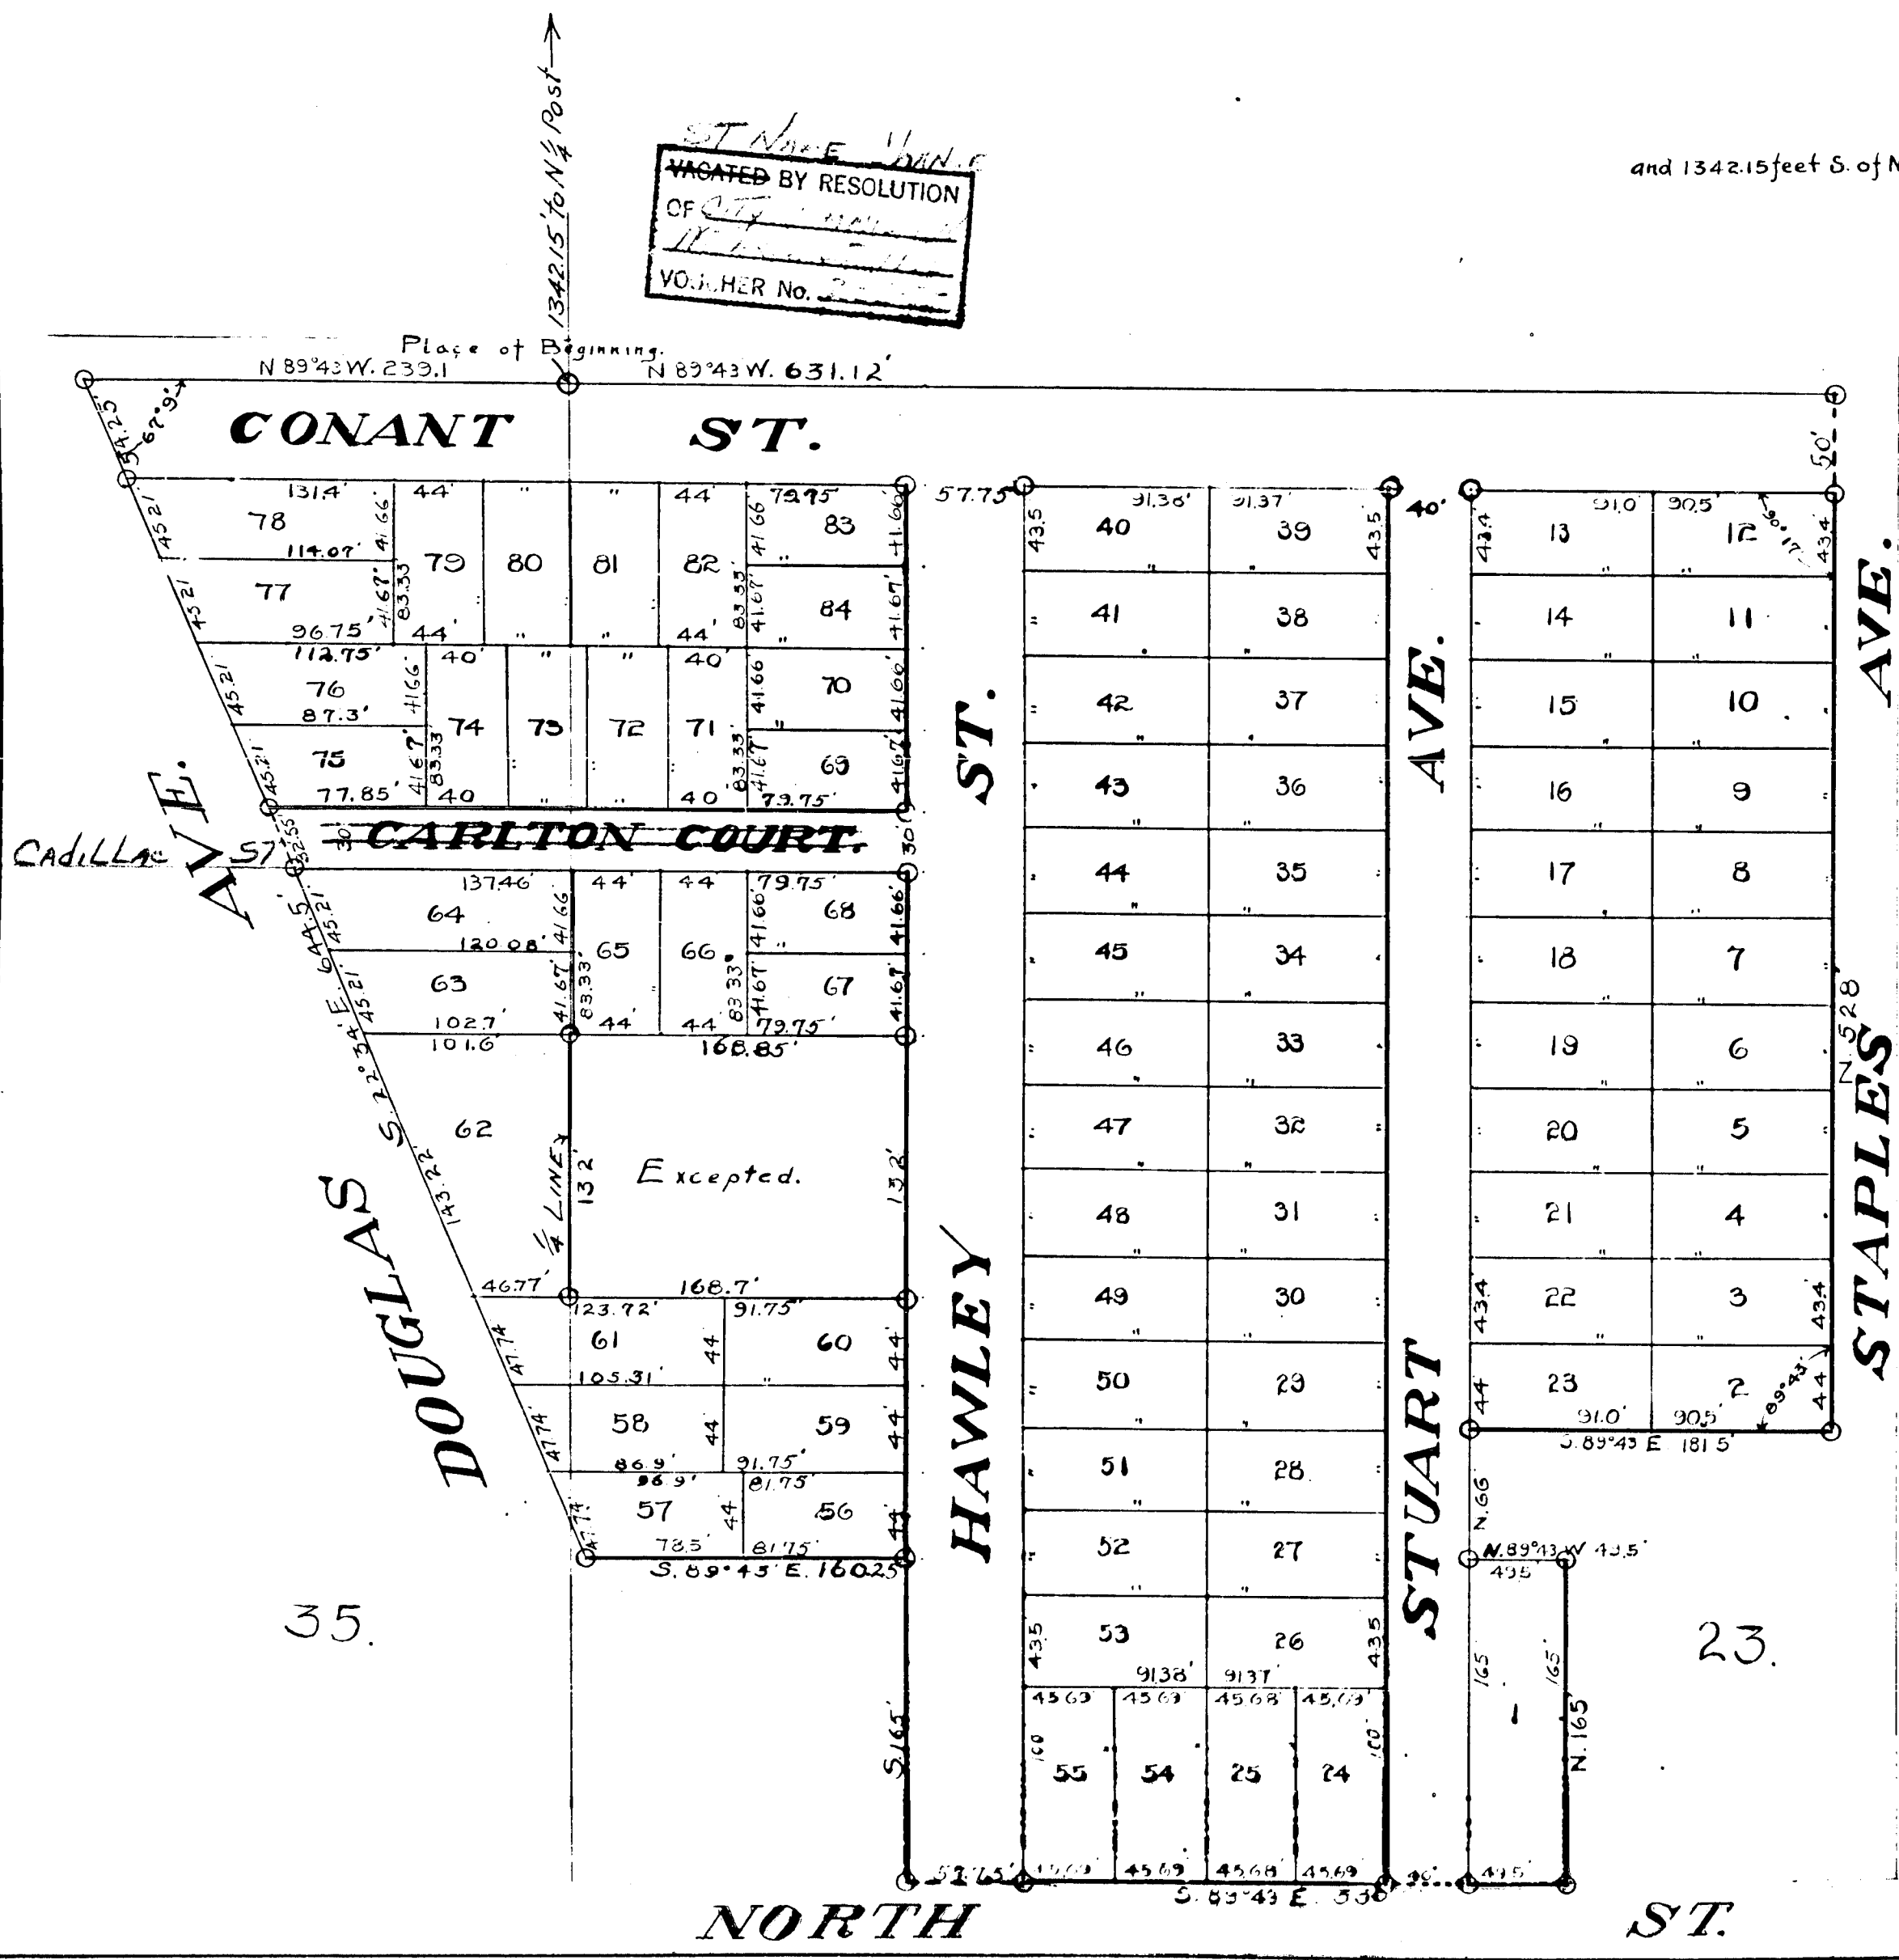

13234