

DESCRIPTION OF LAND PLATTED

Commencing at the quarter post between sections sixteen (16) and twenty-one (21), T. 2 S., R. 11 W. and running thence east along the section line between said sections sixteen (16) and twenty-one (21), 1011.33 feet, thence north 2 degrees 4 minutes east 33.0 feet to the place of beginning; running thence north 2 degrees 4 minutes east 255.46 feet; thence south 88 degrees 32 minutes west 167.08 feet; thence south 49 degrees 30 minutes west 362.57 feet; thence south 31 degrees 26 minutes west 21.43 feet; thence east 444.61 feet to the place of beginning; being the west part of lot 30, Plat number 2 of Section 16, Township of Kalamazoo, Kalamazoo County, Michigan.

DEDICATION

KNOW ALL MEN BY THESE PRESENTS, that the L. H. WHITE LAND COMPANY, a corporation organized and existing under the laws of the State of Michigan, by Andrew J. Furst, President, and Leroy H. White, Treasurer, and by authority of its Board of Directors, have caused the land embraced in the annexed plat to be surveyed, laid out and platted, to be known as WHITE'S PARK, Kalamazoo, Mich.

Being a subdivision of the west part of that part of lot 30, lying south of South Street, of Plat No. 2, or revised plat of Section 16, T. 2 S., R. 11 W.
 L. H. White Land Company
 By: *Andrew J. Furst*
 President.
Leroy H. White
 Treasurer.

Signed and sealed in presence of

M. C. Taft
L. B. White

STATE OF MICHIGAN,
 COUNTY OF KALAMAZOO, ss.

On this third day of February, A. D. 1912, before me, a Notary Public in and for said County, appeared Andrew J. Furst and Leroy H. White, to me personally known, who being by me duly sworn, did depose and say that they are respectively the President and Treasurer of the L. H. WHITE LAND COMPANY, a corporation organized and existing under the laws of the State of Michigan, and that the seal affixed to the foregoing instrument is the corporate seal of said corporation, and that said instrument was signed and sealed in behalf of said corporation by authority of its Board of Directors and that said Andrew J. Furst and Leroy H. White acknowledged said instrument to be the free act and deed of the said L. H. WHITE LAND COMPANY.

My Commission expires Nov. 24, 1913.

William B. Kane
 Notary Public, Kalamazoo Co., Mich.

SURVEYOR'S CERTIFICATE

I hereby certify that the plat hereon delineated is a correct one, and that permanent monuments consisting of 1/2 inch iron rods 2 feet long have been set at points marked thus (O) as thereon shown at all angles in the boundaries of the land platted.

M. C. Taft
 Surveyor.

STATE OF MICHIGAN,
 CITY OF KALAMAZOO, ss.

The annexed Plat of WHITE'S PARK was approved by the Common Council
 February 19th, 1912.

Clarence L. Miller
 City Clerk

TAX CERTIFICATES

STATE OF MICHIGAN,
 COUNTY OF KALAMAZOO, ss.

I hereby certify that I have examined the records in my office relating to the description of lands in WHITE'S PARK, dated February third, 1912, and from such examination I hereby certify that all city taxes and assessments, extraordinary as well as ordinary, which are now due, have been paid.

February 3d, 1912.

Frank Forman
 City Treasurer.

STATE OF MICHIGAN,
 COUNTY OF KALAMAZOO, ss.

I hereby certify that I have examined the records in my office relating to the description of lands in WHITE'S PARK, dated February third, 1912, and from such examination it appears that the taxes have been fully paid for the five years preceding said date, and that there are no tax liens or titles held by the State or individuals for five years preceding said date.

February 3d, 1912.

Arthur Tipling
 County Treasurer.

----- Boundary line of Lot 30, Section 16

PLAT OF

White's Park

CITY OF KALAMAZOO, KALAMAZOO CO., MICH.
 1912

SCALE 30 FEET PER INCH

M. C. TAFT, SURVEYOR

Examined and Approved
 MAR 21 1912

Geo S. Hansen
 Deputy Auditor General.


COPY
 REGISTER'S OFFICE,
 Kalamazoo County, ss.
 Plat of
White's Park
 WAS RECORDED THIS 22 DAY OF
March A. D. 1912 AT 9 O'CLOCK
A. M. IN LINE 8 OF Plats
 ON PAGE 34
M. C. Taft
 REGISTER OF DEEDS.
 ORIGINAL ON FILE

Filed in Auditor General's Dep't
 APR 9-1912

Geo S. Hansen
 Deputy Auditor General.

Street Name Change
 VACATED BY RESOLUTION
 OF City Commission
 August 11, 1908
 VOUCHER No. 499-58
 591-58

I hereby certify that this copy is a true copy of the M. or PLAT forwarded the Register of Deeds for recording.
 COMPARED MAR 21 1912
Geo S. Hansen
 Deputy Auditor General.

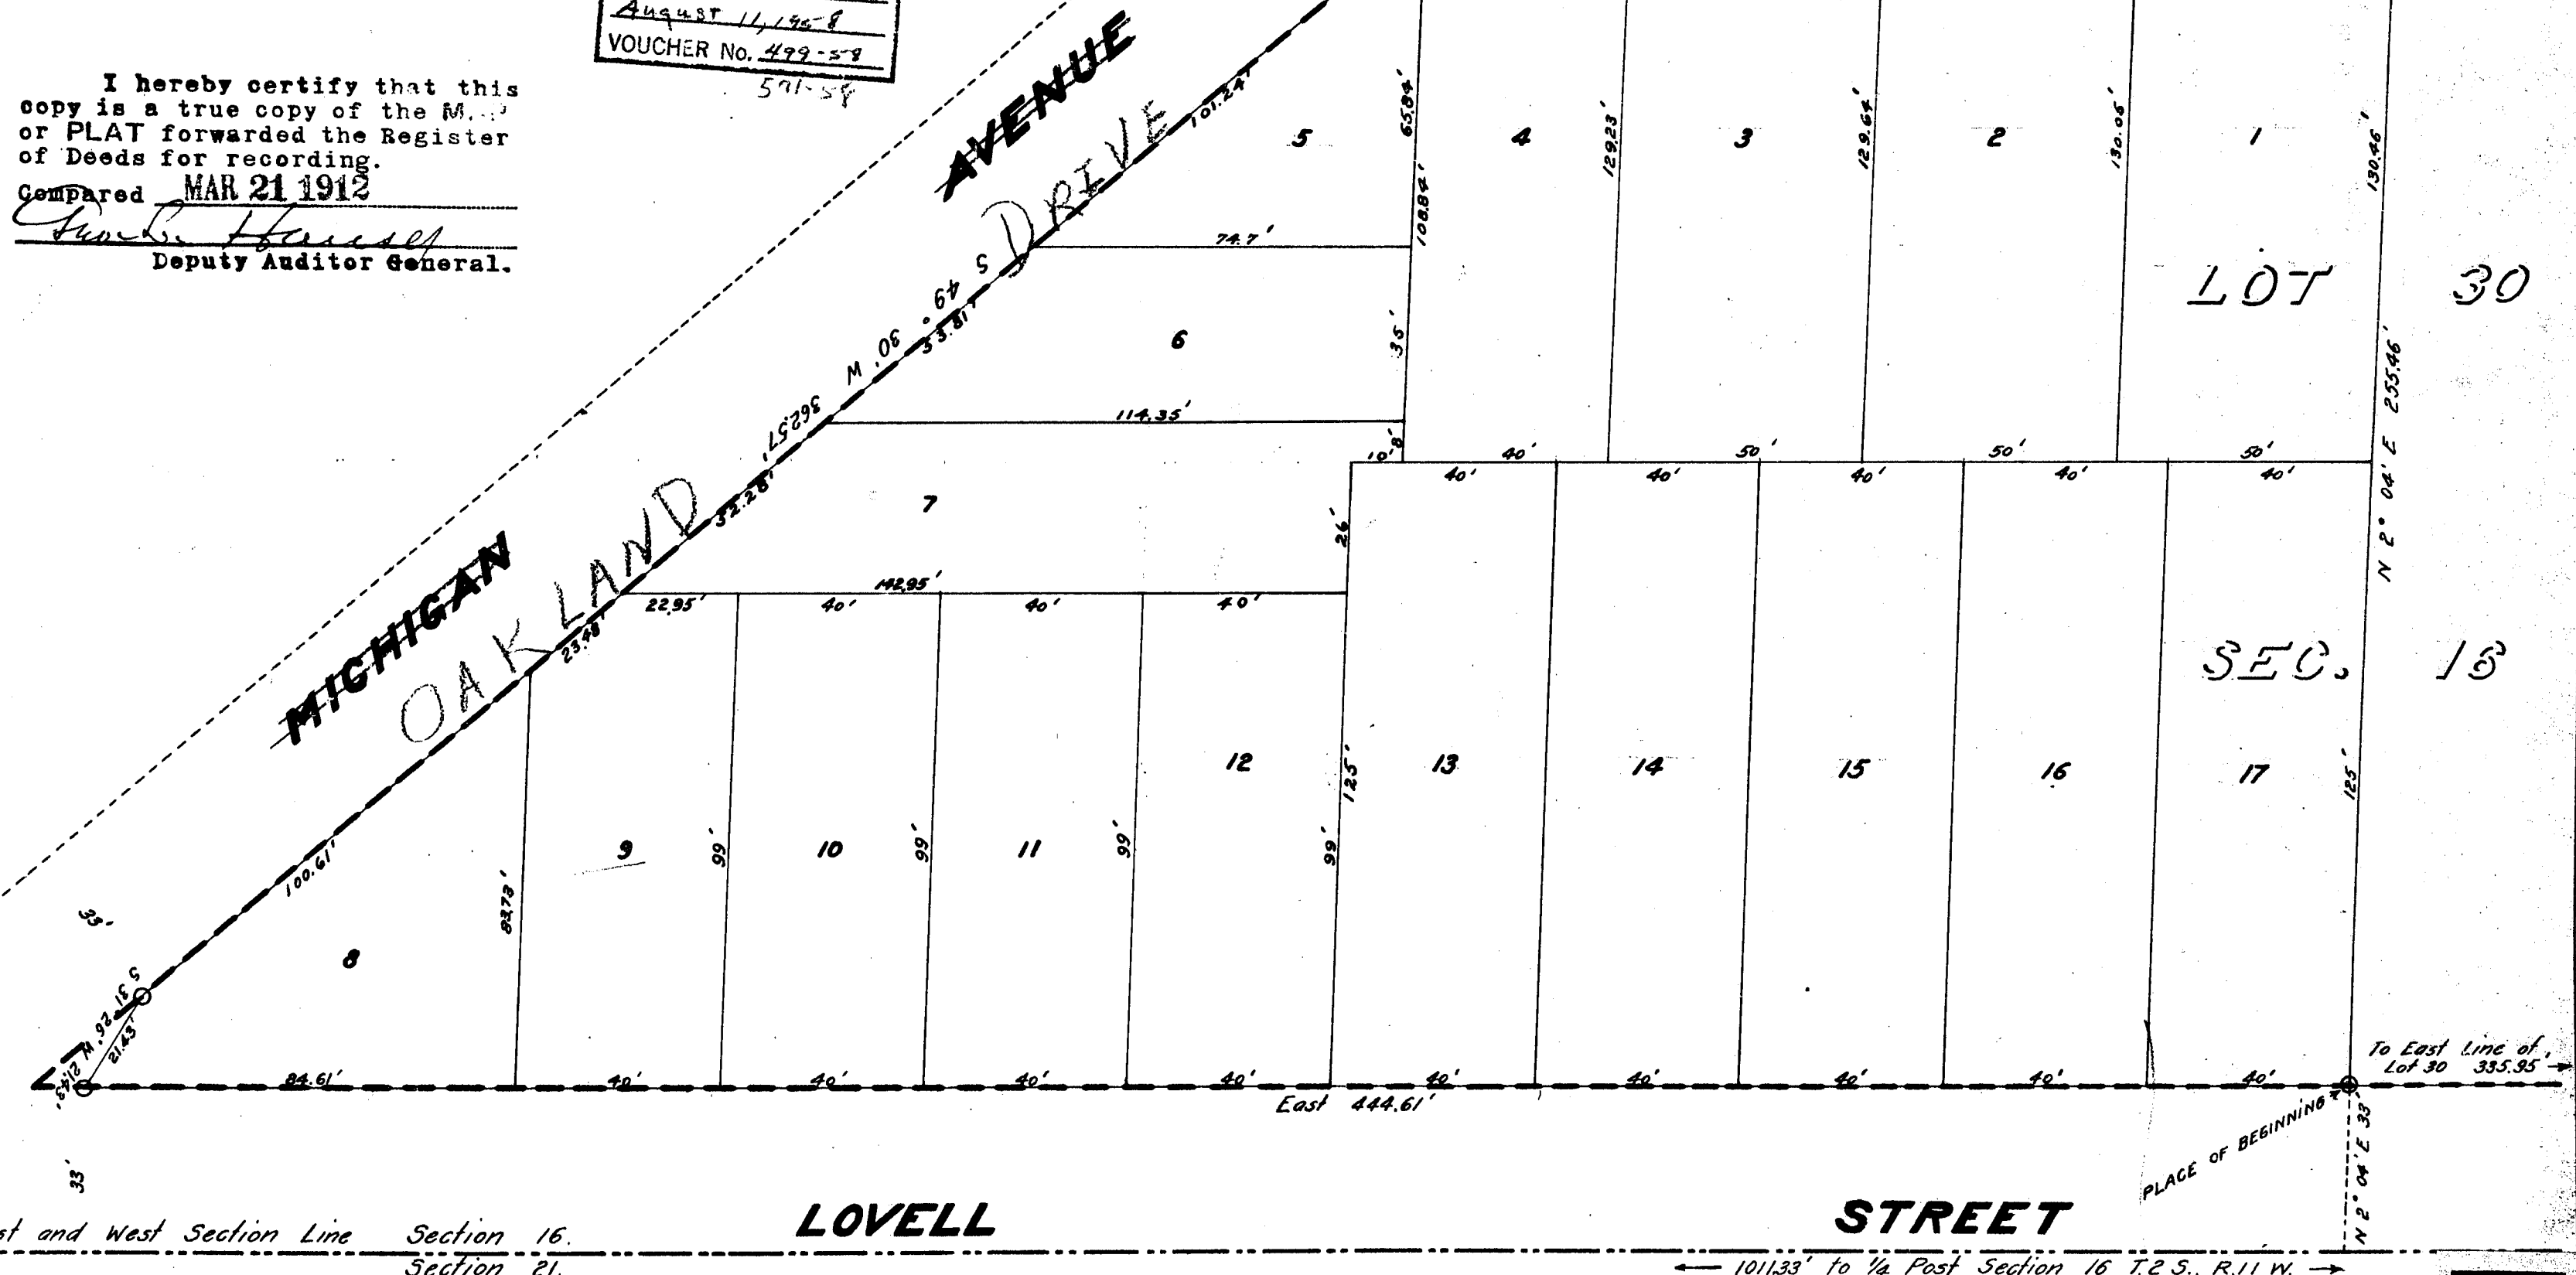

13238

DESCRIPTION OF LAND PLATTED

Commencing at the quarter post between sections sixteen (16) and twenty-one (21), T. 2 S., R. 11 W. and running thence east along the section line between said sections sixteen (16) and twenty-one (21), 1011.33 feet, thence north 2 degrees 4 minutes east 33.0 feet to the place of beginning; running thence north 2 degrees 4 minutes east 255.46 feet; thence south 89 degrees 32 minutes west 167.08 feet; thence south 49 degrees 30 minutes west 362.57 feet; thence south 31 degrees 26 minutes west 21.43 feet; thence east 444.61 feet to the place of beginning; being the west part of lot 30, Plat number 2 of Section 16, Township of Kalamazoo, Kalamazoo County, Michigan.

DEDICATION

KNOW ALL MEN BY THESE PRESENTS, that the L. H. WHITE LAND COMPANY, a corporation organized and existing under the laws of the State of Michigan, by Andrew J. Furst, President, and Leroy H. White, Treasurer, and by authority of its Board of Directors, have caused the land embraced in the annexed plat to be surveyed, laid out and platted, to be known as WHITE'S PARK, Kalamazoo, Mich.

Being a subdivision of the west part of that part of lot 30, lying south of South Street, of Plat No. 2, or revised plat of Section 16, T. 2 S., R. 11 W., plat of Section 16, Township of Kalamazoo, Kalamazoo County, Michigan.

By L. H. White Land Company
Andrew J. Furst President.
Leroy H. White Treasurer.

Signed and sealed in presence of

M. C. Taft
L. O. White

STATE OF MICHIGAN, }
COUNTY OF KALAMAZOO, }

On this third day of February, A. D. 1912, before me, a Notary Public in and for said County, appeared Andrew J. Furst and Leroy H. White, to me personally known, who being by me duly sworn, did depose and say that they are respectively the President and Treasurer of the L. H. WHITE LAND COMPANY, a corporation organized and existing under the laws of the State of Michigan, and that the seal affixed to the foregoing instrument is the corporate seal of said corporation, and that said instrument was signed and sealed in behalf of said corporation by authority of its Board of Directors and that said Andrew J. Furst and Leroy H. White acknowledged said instrument to be the free act and deed of the said L. H. WHITE LAND COMPANY.

Albion B. Tiers
Notary Public, Kalamazoo Co., Mich.

My Commission expires Nov. 22, 1912.

SURVEYOR'S CERTIFICATE

I hereby certify that the plat hereon delineated is a correct one, and that permanent monuments consisting of 1/2 inch iron rods 2 feet long have been set at points marked thus (O) as thereon shown at all angles in the boundaries of the land platted.

M. C. Taft
Surveyor.

STATE OF MICHIGAN, }
COUNTY OF KALAMAZOO, }

The annexed Plat of WHITE'S PARK was approved by the Common Council
February 19th, 1912.

Clarence L. Millard
City Clerk

TAX CERTIFICATES

STATE OF MICHIGAN, }
COUNTY OF KALAMAZOO, }

I hereby certify that I have examined the records in my office relating to the description of lands in WHITE'S PARK, dated February third, 1912, and from such examination I hereby certify that all city taxes and assessments, extraordinary as well as ordinary, which are now due, have been paid.

February 3d, 1912.

Frank Formela
City Treasurer.

STATE OF MICHIGAN, }
COUNTY OF KALAMAZOO, }

I hereby certify that I have examined the records in my office relating to the description of lands in WHITE'S PARK, dated February third, 1912, and from such examination it appears that the taxes have been fully paid for the five years preceding said date, and that there are no tax liens or titles held by the State or individuals for five years preceding said date.

February 3d, 1912.

Arthur J. Tiffany
County Treasurer.

----- Boundary line of Lot 30, Section 16

PLAT OF

White's Park

CITY OF KALAMAZOO, KALAMAZOO CO., MICH.

1912

SCALE 30 FEET PER INCH

M. C. TAFT, SURVEYOR

Examined and Approved

MAR 21 1912

Geo. S. Haines
Deputy Auditor General.

Filed in Auditor General's Dep't

MAR 9 - 1912

Geo. S. Haines
Deputy Auditor General.

COPY
REGISTER'S OFFICE.
COUNTY
Kalamazoo
PLAT OF
White's Park
WAS RECORDED THIS 22 DAY OF
March A. D. 1912 AT 9 O'CLOCK
AM IN CASE 8 OF Plat
2 PAGES
2 SHEETS OF DEEDS
ORIGINAL ON FILE

SEAL OF THE CITY OF KALAMAZOO
VACATED BY RESOLUTION
OF CITY COUNCIL

I hereby certify that this copy is a true copy of the plat or PLAT forwarded the Register of Deeds for recording.
Compared MAR 21 1912
Geo. S. Haines
Deputy Auditor General.

