


VACATED BY RESOLUTION
OF City Commission
June 2-1958
VOUCHER No. 532-53

PASCO'S ADDITION TO Battle Creek

RECEIVED AND FILED

February 11, 1884
R. B. Merritt
Dep. Aud. Genl.

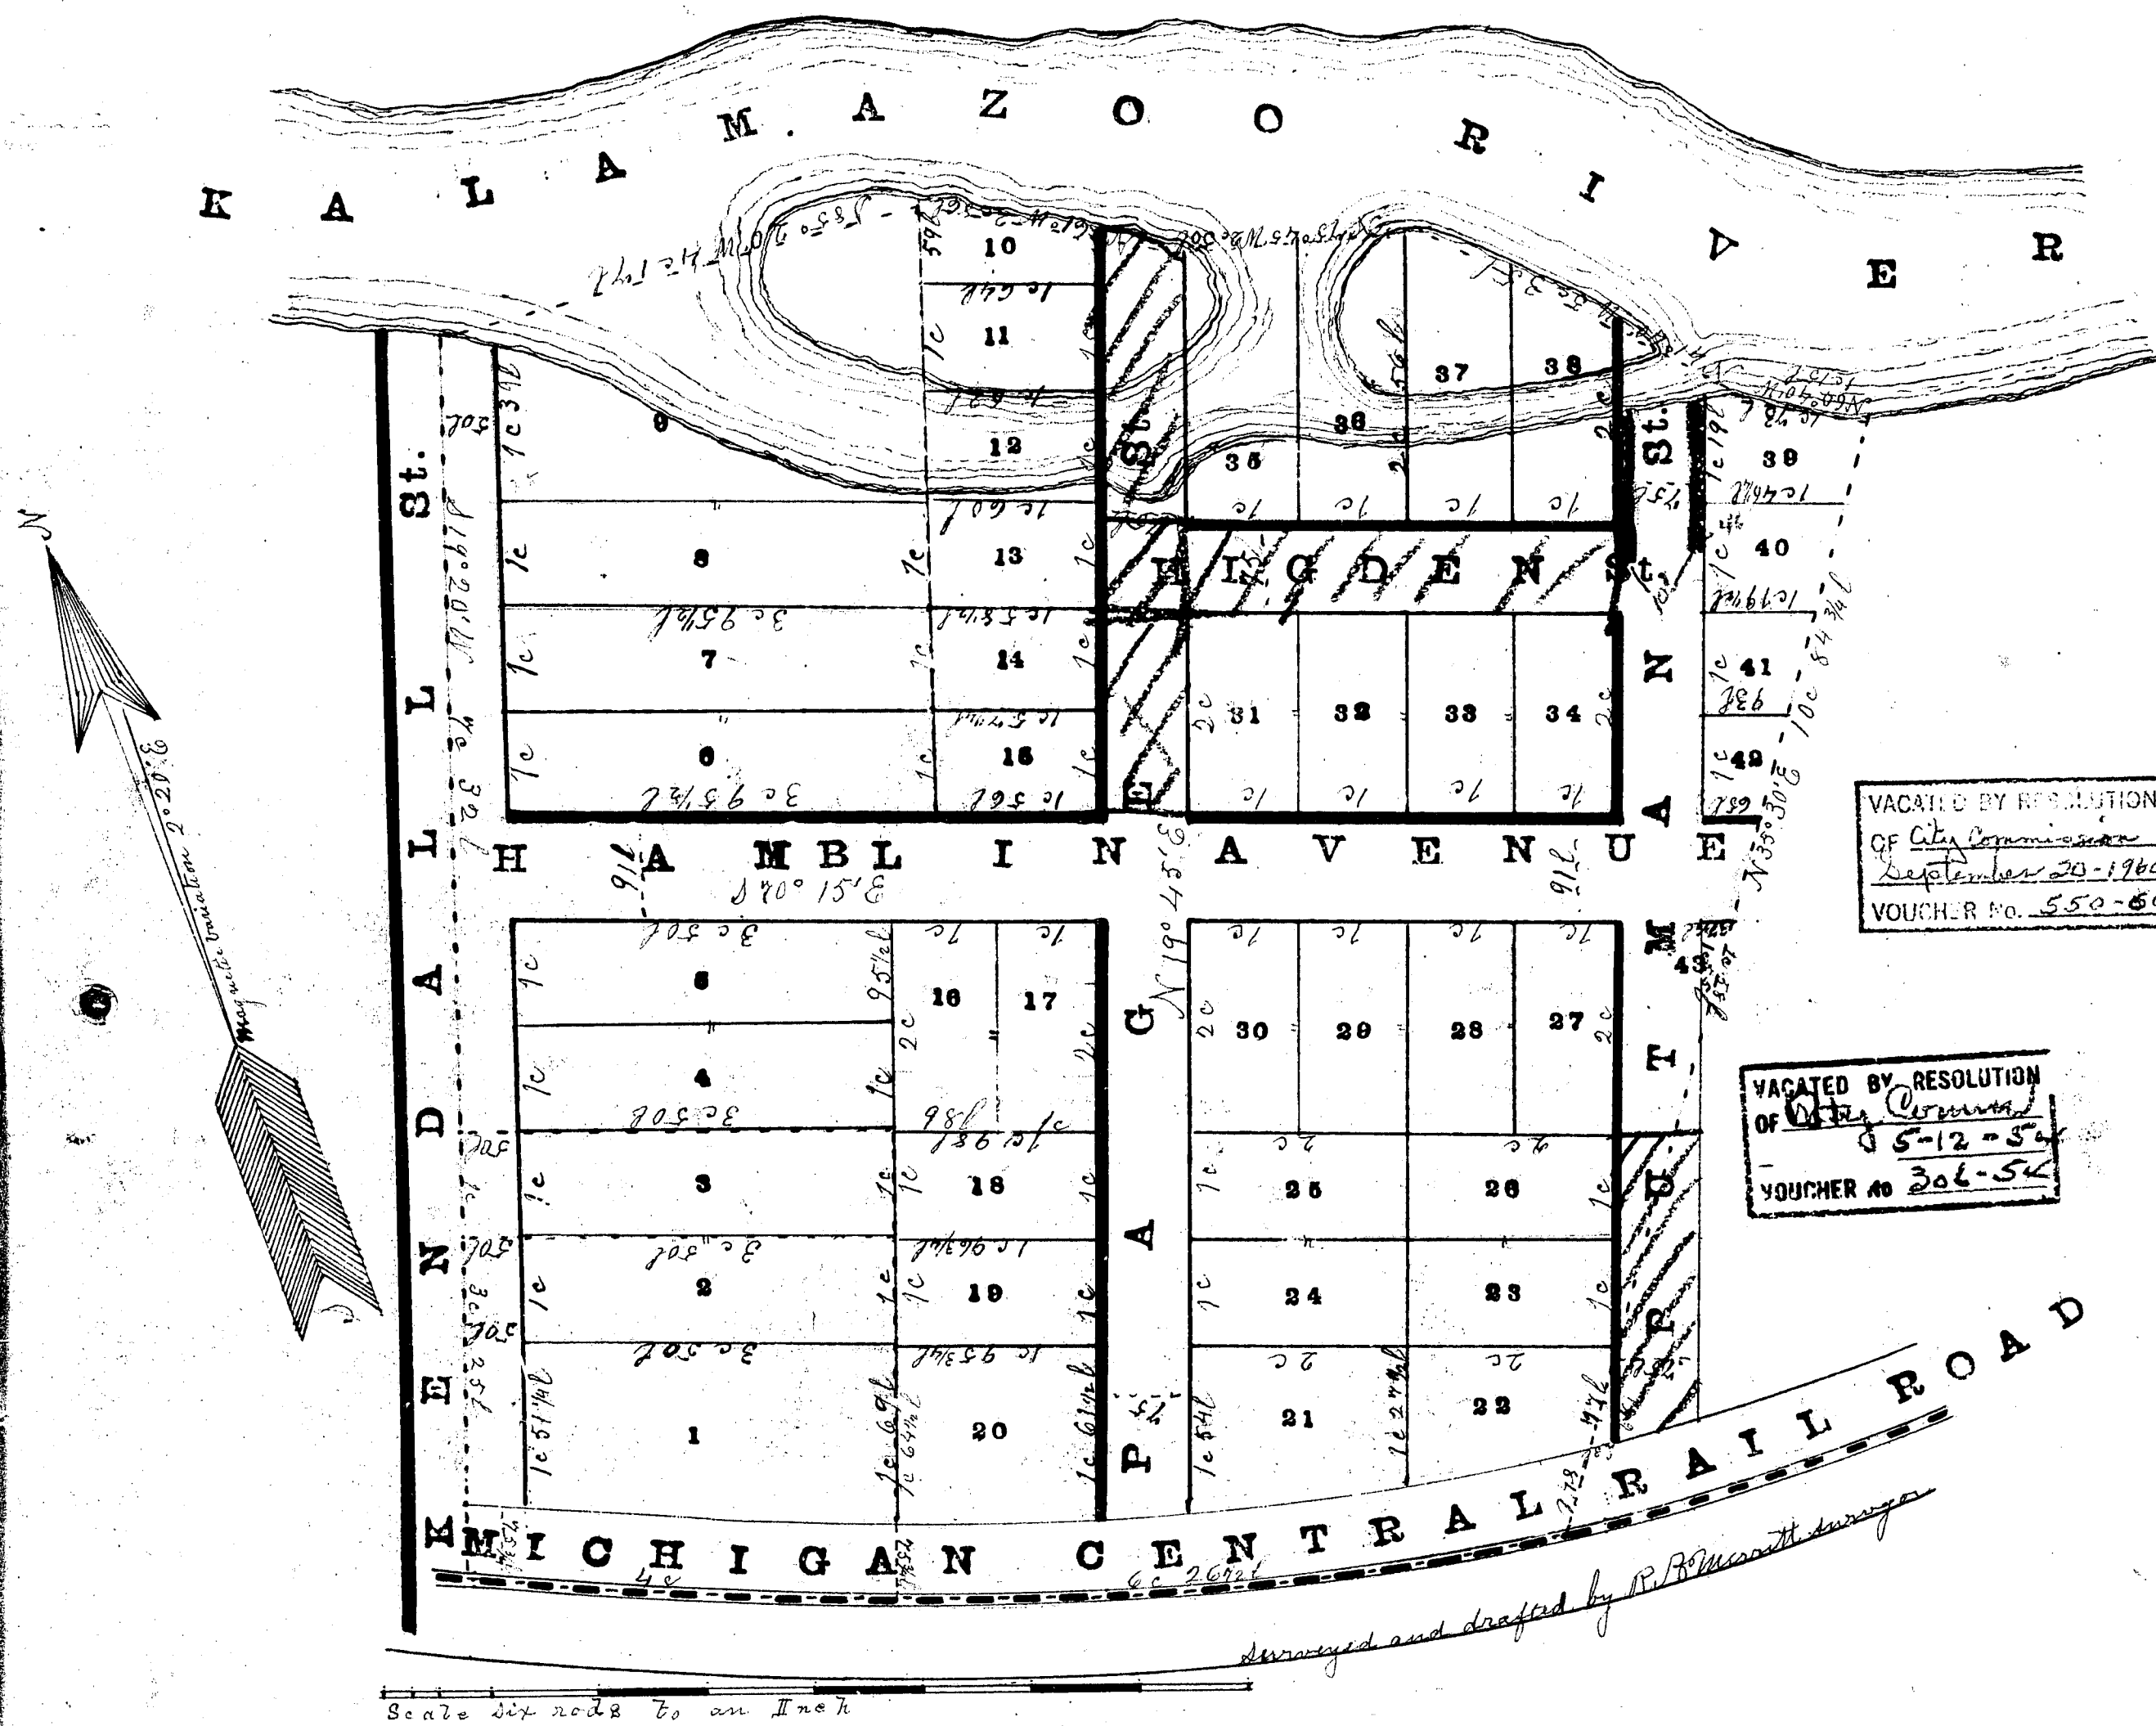

VACATED BY RESOLUTION
OF City Commission
September 20-1960
VOUCHER No. 550-60

VACATED BY RESOLUTION
OF City Commission
September 20-1960
VOUCHER No. 550-60

Description of Ralph B. Cummings' portion of the adjoining Plat
Beginning at the point where the center of Randall Street intersects the line of the above plat on the south side of the Kalamazoo River on Section one in Town 2 South of Range Eight West in the City of Battle Creek County of Calhoun and State of Michigan running thence S 19° 20' W in the center of Randall Street (7) seven chains and (32) thirty two links to the North line of lands of Maggie Cook thence S 70° 40' E at right angles with Randall Street (4) four chains thence S 19° 20' W parallel with Randall Street (4) four chains and (33) thirty three and three quarter links to the center of the Michigan Central Rail Road track thence Eastward on a curved line to the left and along the center of said track (6) six chains and (26) twenty six links to the West line of lands of Maggie Cook thence N 35° 30' E along said West line (10) ten chains and (97) ninety seven links to the South Bank of the Kalamazoo River thence N 60° 40' W down along said bank (1) one chain and (5) fifteen links thence N 41° 40' W across the head of the Race (83) eighty three links and on same bearing along bank of River (2) two chains and (45) forty five links thence N 75° 45' W (2) two chains and (50) fifty links across an arm of the stream to the bank of an island thence N 61° W along said bank (2) two chains and (86) eighty six links thence S 80° 20' W (4) four chains and (17) seventeen links across the arm of the stream to the place of beginning containing (137) thirteen and seventy one one hundredths acres of land more or less subject to the rights and privileges of the Michigan Central Rail Road.

Description of Maggie Cook's portion of the adjoining Plat
Beginning at a point on the center of Randall Street in the City of Battle Creek County of Calhoun and State of Michigan said point being situated (3) three chains and (25) twenty five links North from the center of the Michigan Central Rail Road track on the line of the center of Randall Street running thence S 70° 40' E at right angles with Randall Street (4) four chains thence N 19° 20' E parallel with Randall Street (1) one chain thence S 70° 40' W (4) four chains to the center of Randall Street thence S 19° 20' W in the center of Randall Street (1) one chain to the place of beginning containing (64) sixty four square rods of land more or less.

Description of James A. Howe's portion of the adjoining Plat
Beginning at the point where the center line of Randall Street intersects the center of the Michigan Central Rail Road track running thence Eastward in the center of said track (4) four chains thence N 19° 20' E parallel with Randall Street (3) three chains and (43) forty three and three quarter links to the South line of lands of Maggie Cook thence N 70° 40' W (4) four chains to the center of Randall Street thence S 19° 20' W in the center of Randall Street (3) three chains and (25) twenty five links to the place of beginning containing (133) one and thirty three one hundredths acres of land more or less subject to the rights and privileges of the Michigan Central Rail Road - The boundaries of each piece being indicated on the plat by red dotted lines.

Be it understood that Ralph B. Cummings - Maggie Cook - James A. Howe and Ann M. Howe his wife all of the City of Battle Creek County of Calhoun and State of Michigan Proprietors of the above described piece of land do hereby lay out the same into lots and streets of the size dimensions and with boundaries courses and extent and numbered and named as set forth on the adjoining map and plat and which map and plat and the certain figures and signs on the map of Mapping Paper truly represent and describe the same the better to stand for North (N) for South (S) for East (E) for West (W) for links (L) for feet (F) for degrees (D) for minutes (M) and the figures printed near the center being the number of each lot and the size being written on the lines of each. And it is mutually agreed that this Plat shall be known as "Pasco's Addition to Battle Creek" And those portions marked as streets within the above boundaries are hereby released to said County of Calhoun as provided by statute in trust for the use of the public as streets.

In witness whereof we have hereunto set our hands and seals this 7th day of February, A.D. 1884.

In presence of
John W. Hall
J. J. Pasco

Ralph B. Cummings LS
Maggie Cook LS
James A. Howe LS
Ann M. Howe LS

State of Michigan } ss. Notary Public in and for said County personally appeared Ralph B. Cummings Maggie Cook James A. Howe and Ann M. Howe his wife known to be the same persons described in and who executed the above and within instrument who solemnly acknowledged to me as Notary Public for the use and purposes therein named and specified.

En this seventh day of February in the year one thousand eight hundred and eighty four before me the subscriber a Notary Public in and for said County personally appeared Ralph B. Cummings Maggie Cook James A. Howe and Ann M. Howe his wife known to be the same persons described in and who executed the above and within instrument who solemnly acknowledged to me as Notary Public for the use and purposes therein named and specified.

Witness my hand and Notary Seal this 7th day of February, A.D. 1884.

13322

State of Michigan } ss. I, the undersigned Earl Smith Register of Deeds for Calhoun County and R. B. Merritt Civil Engineer and maker of this plat do hereby certify that we have carefully compared the annexed copy of the plat of "Pasco's Addition to Battle Creek" with the original and have found the same to be an exact transcript thereof and of the whole of such map or plat.

Frank B. Snyder Deputy Regr
R. B. Merritt C. E.

State of Michigan } ss. I, the undersigned Earl Smith Register of Deeds for Calhoun County and R. B. Merritt Civil Engineer do hereby certify that we have carefully compared the annexed copy of "Pasco's Addition to Battle Creek" with the original and also with the copy now on file in this office and find the same to be an exact transcript thereof and of the whole of such map or plat.

Frank B. Snyder Deputy Regr
R. B. Merritt C. E.

State of Michigan } ss. Received for record at 9:30 A. M. Oct. 8, 1884 and recorded in book No. 1 of Plate on page 26.

Frank B. Snyder Deputy Regr

1489


1489

PASCO'S

ADDITION TO

Battle Creek.

February 11 84
H. H. Pratt

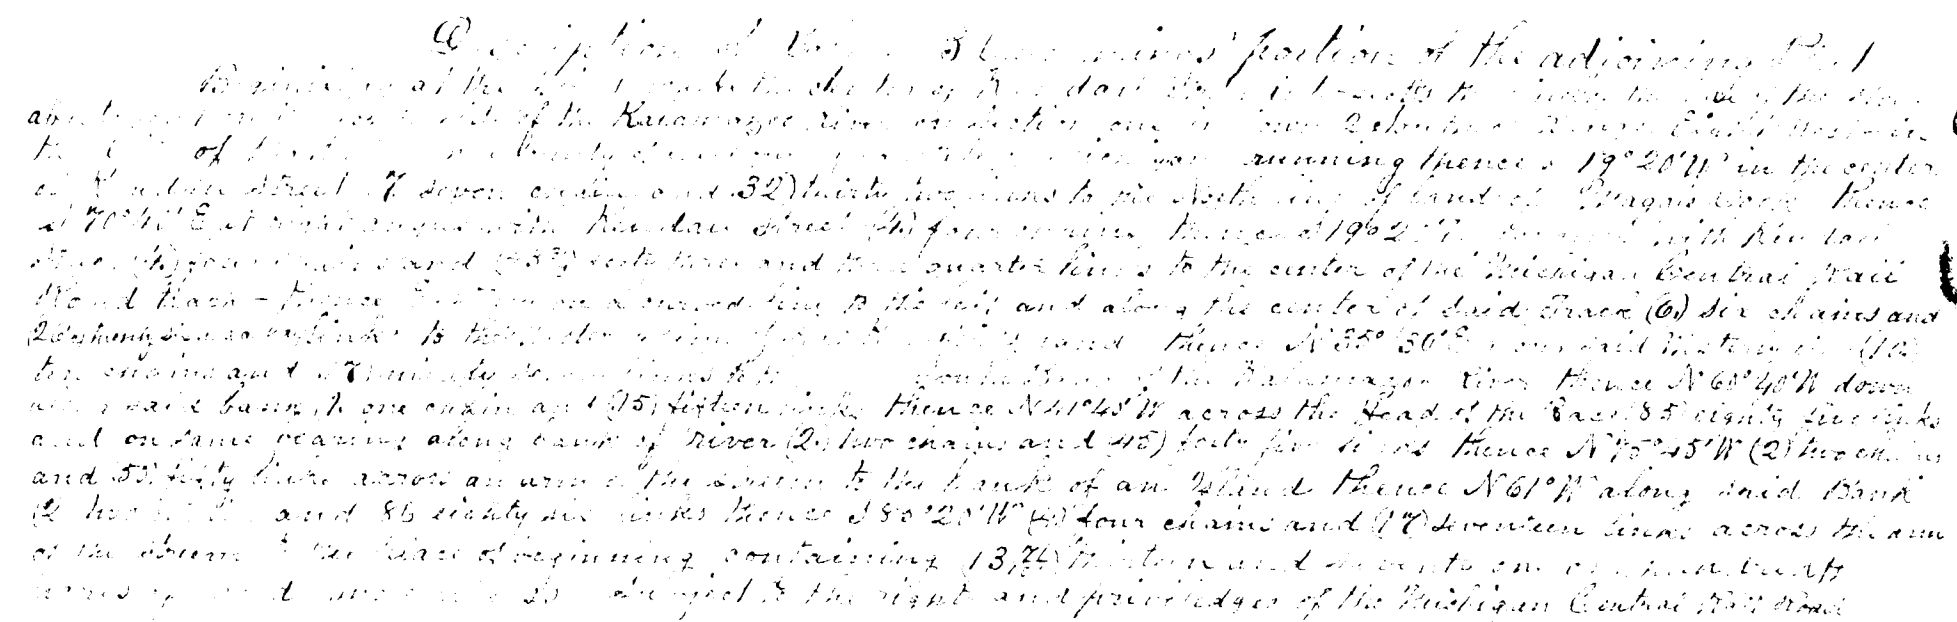


[illegible]


[illegible]

In witness whereof we have hereunto set our hands and seals this 7th day of February A.D. 1854

In presence of
Edmund A Hall
J. J. Powell J. Passco

Ralph T. Cummings LS
 Maggie C. Cook LS
 James A. Howe LS
 Ann M. Howe LS

State of Michigan
(cont. of former)


13322

6871

[illegible]




