

RECEIVED AND FILED
In Auditor General's Office,
April 27 1884
Attest
Dep. Aud. Genl.

CUSHING'S ADDITION TO

13325














C O N T I N U E D

S T R E E T

M A I N S T R E E T

Garfield Ave

1 2 3 4 5 6 7

8 9 10 11 12 13

14 15 16 17

18 19 20 21

22 23 24 25

26 27 28 29 30 31 32 33 34










CITY HALL - BATTLE CREEK, MICHIGAN 49014

PATRICIA CARPENTER
ASS'T CITY CLERK



866-3427

Department of Treasury
Bureau of Local Property Services
2nd Floor, Treasury Building
Lansing, MI 48922

Enclosed are copies of resolutions adopted by the City Commission on August 25, 1981 and maps of the following alley and street vacations:

- Very truly yours,

LAB/pc

BURR ST

BOULDER ST




SCALE: 1:65




BURNHAM ST

WEST END ADD

13443
13385
13399
13325

B

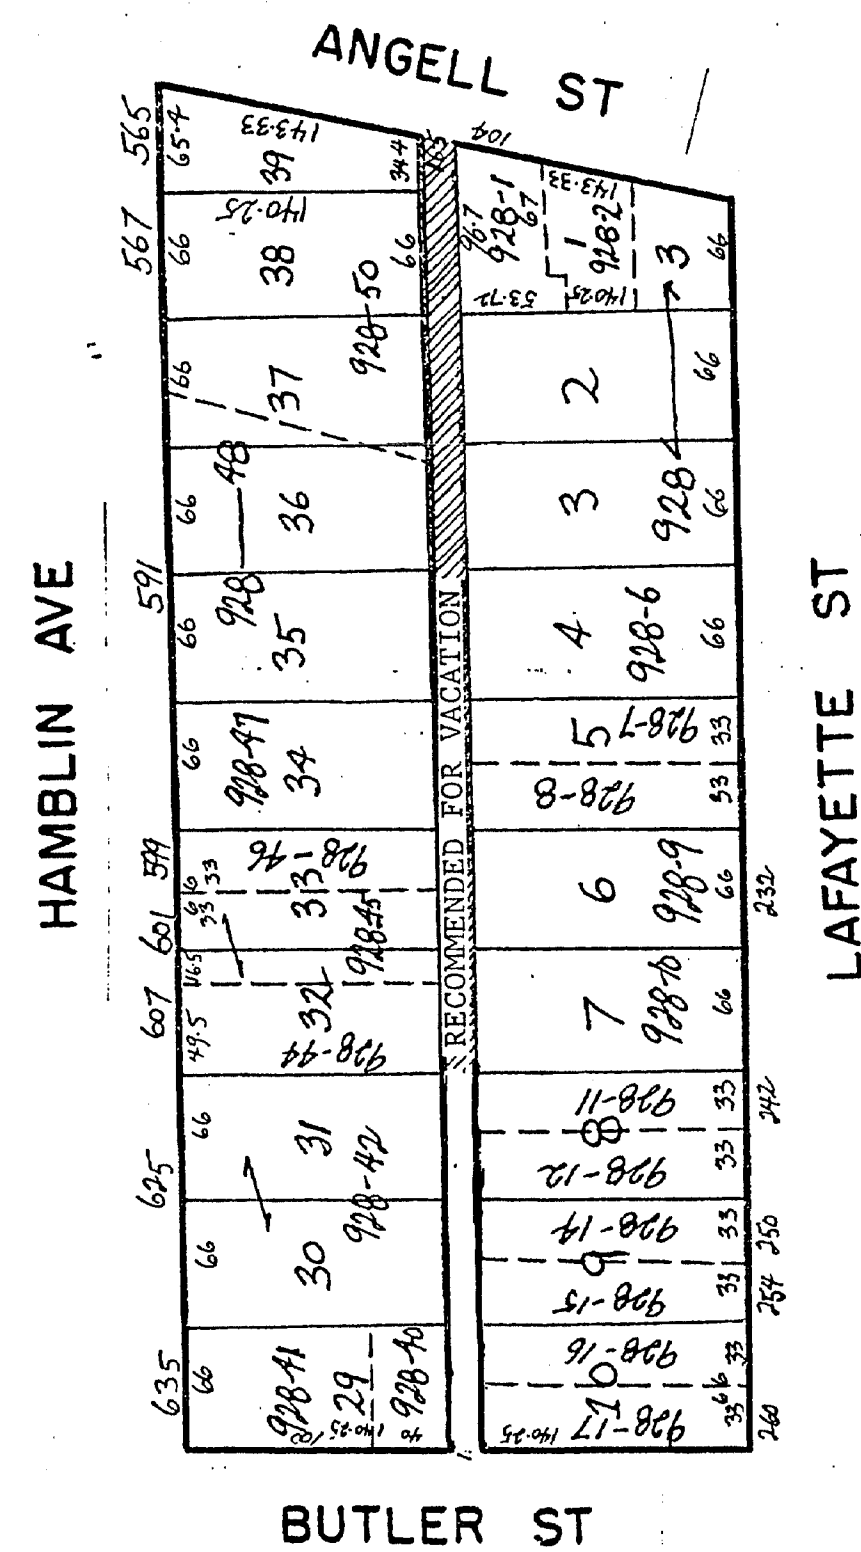


SCALE: 1/100



EMMETT PARK ADD

13443
13385
13399
13325

E

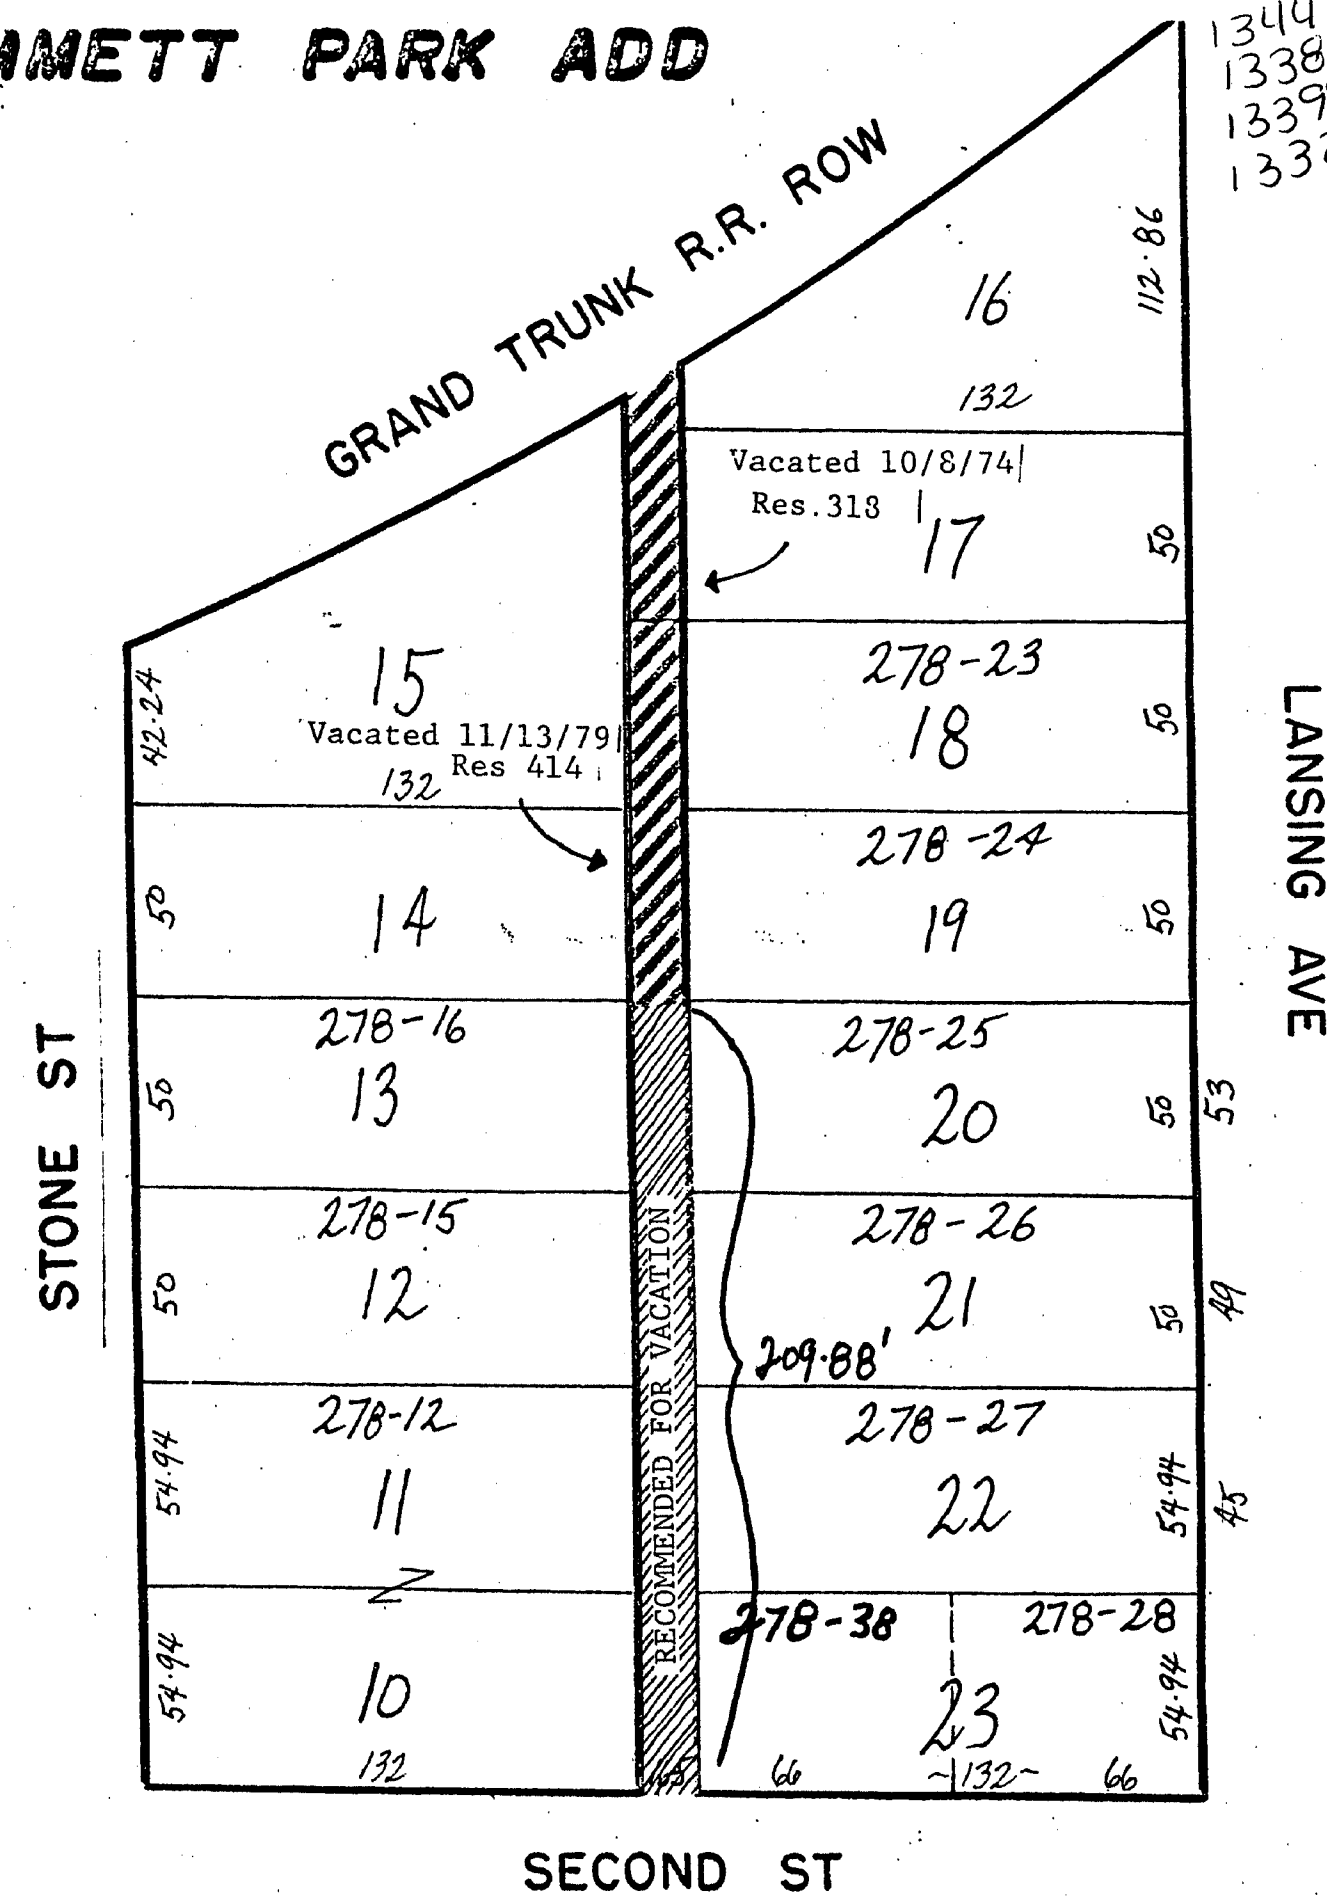

SCALE: 1/100

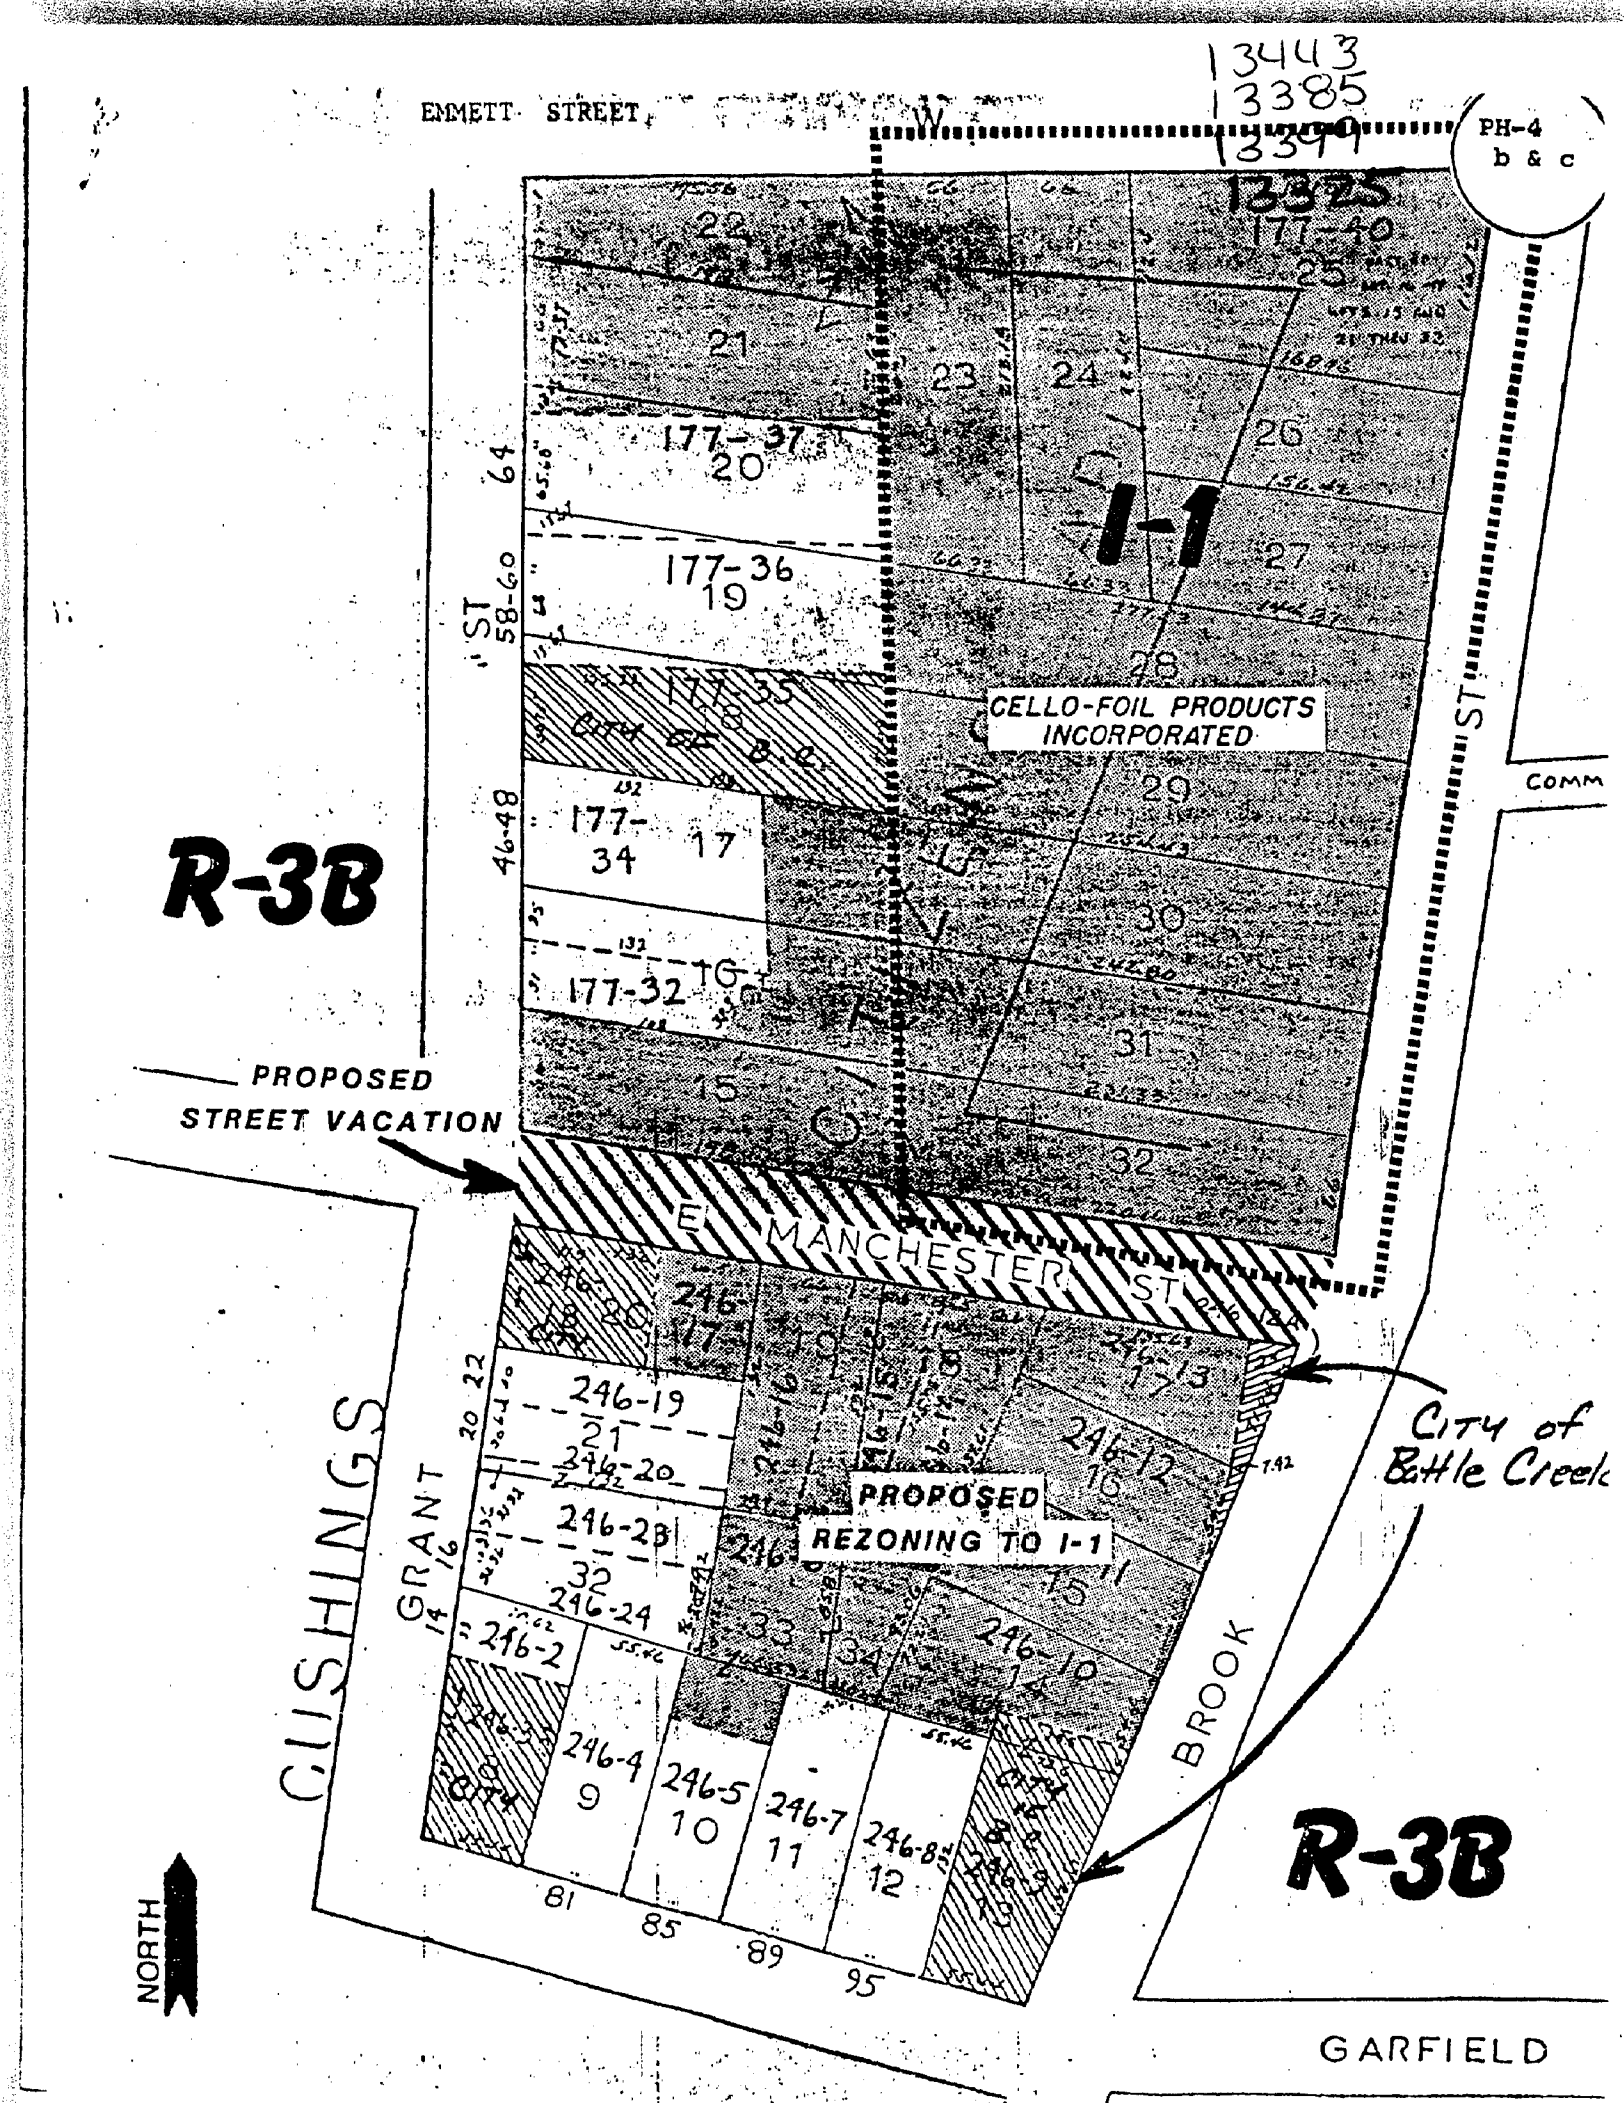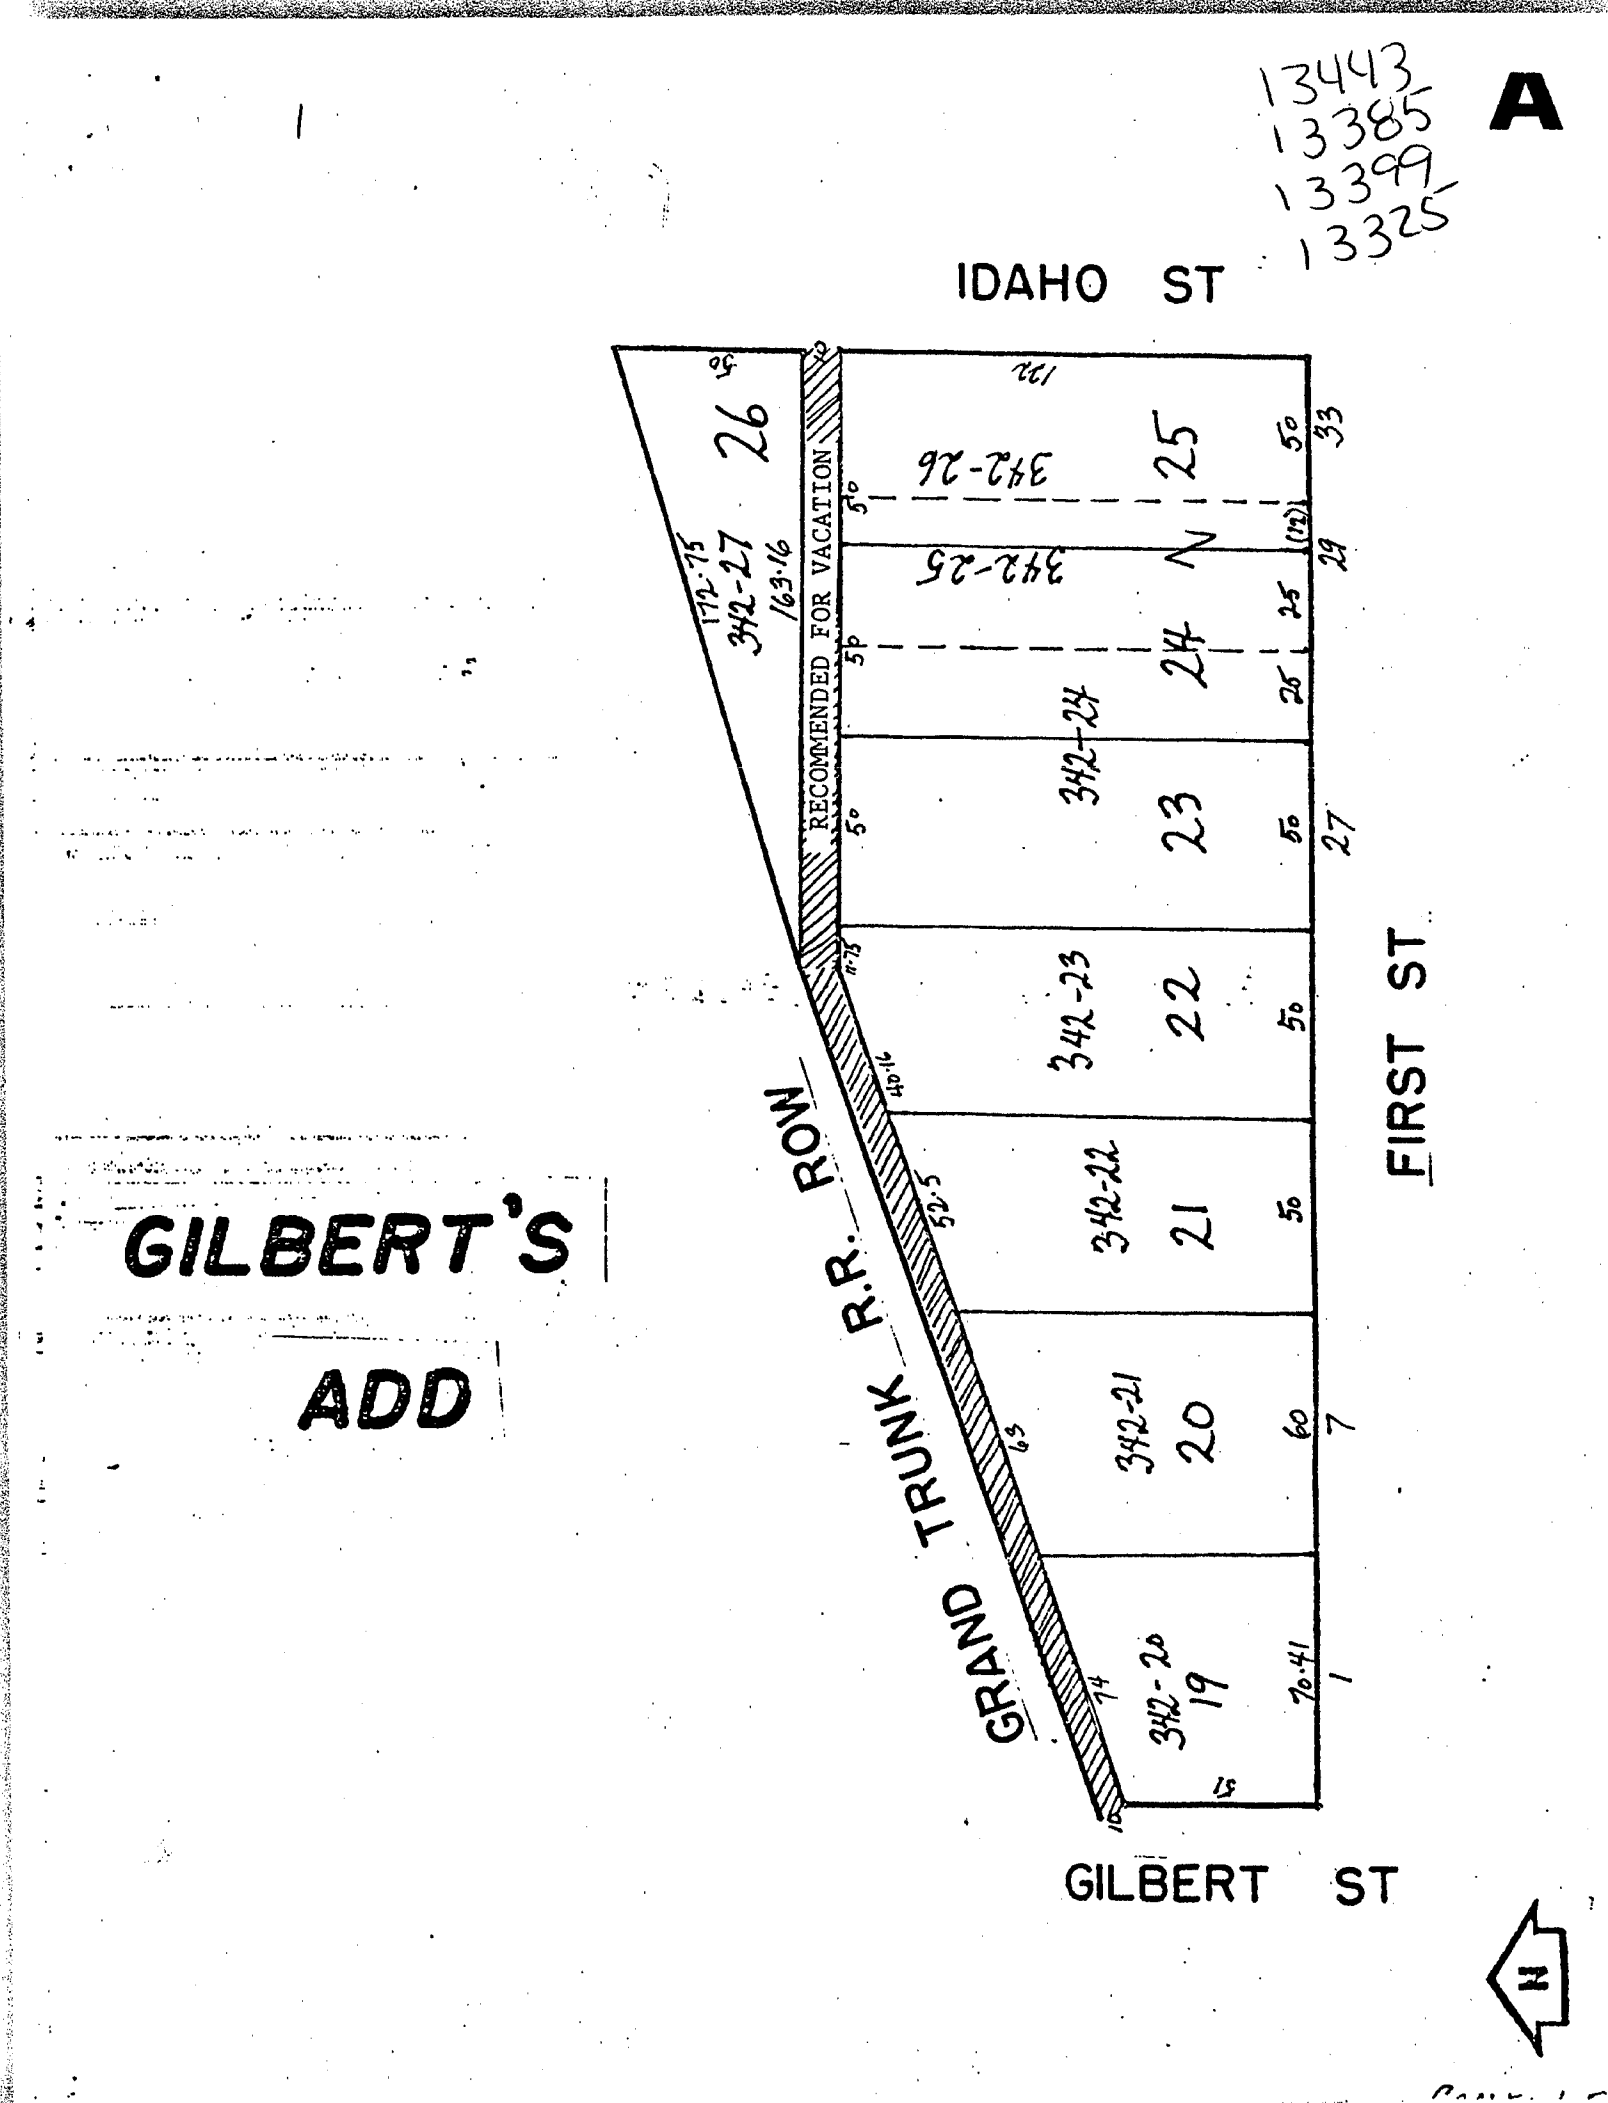



RESOLUTION

A RESOLUTION VACATING A PUBLIC ALLEY
IN HOMEFINDER'S ADDITION TO THE CITY
OF BATTLE CREEK

Battle Creek, Mich., August 25, 1981

Resolved by the Commission of the City of Battle Creek:

WHEREAS, it appears to the City Commission that the public alley in Homefinder's Addition as hereafter described is not necessary for public use and convenience, and no public or private interests will be adversely affected by the abandonment and vacation thereof as a public alley,

NOW, THEREFORE, BE IT RESOLVED that all that portion of the alley between Burr Street on the North and Burnham Street on the South extending from the West line of Lot 10, 329.0 feet to the West line of Lot 3 of Blocks 2 and 3 of the Plat of Homefinder's Addition as recorded in Plats at Liber 4, Page 15, with the Register of Deeds for Calhoun County, Michigan, be and the same is hereby vacated, abandoned and discontinued as a public alley, subject, however, to the reservation to the City for the benefit of itself and the public of such easements and rights-of-way for public utility purposes as may be necessary; and

BE IT FURTHER RESOLVED that the vacation of said alley is upon the condition that title to all gas, electric poles, wires, conduits, cables, appurtenances and facilities now in, under or over said alley are reserved to and shall remain in the owner thereof, together with the easements and continued rights to occupy said alley for public utility purposes with present and additional facilities, and to operate, maintain, repair, replace, substitute for or remove the same to the same effect and in the same manner as if said alley had remained a public alley; and

BE IT FURTHER RESOLVED that the City Clerk is hereby instructed to file in the Office of the State Treasurer and record with the Office of the Register of Deeds for Calhoun County, Michigan, certified copies of this Resolution, together with a certificate that the Plat of Homefinder's Addition to the City of Battle Creek as recorded in Plats at Liber 4, Page 15, in the Office of the Register of Deeds for Calhoun County, Michigan, is the recorded plat affected by this Resolution.

Robert A. Buckner
City Clerk

ORIGINAL *File*

I, Loraine A. Buckner, Clerk of the City of Battle Creek, hereby certify the above and foregoing is a true and correct copy of a resolution adopted by the City Commission

at a regular meeting held on the 25th

day of August, 1981

Loraine A. Buckner
Loraine A. Buckner, City Clerk

Recorded September 8, 1981 in Liber 1236,
Page 785.



RESOLUTION

A RESOLUTION VACATING A PUBLIC ALLEY
IN WEST END ADDITION TO THE CITY OF
BATTLE CREEK

Battle Creek, Mich., August 25, 1981

Resolved by the Commission of the City of Battle Creek:

WHEREAS, it appears to the City Commission that the alley in West End Addition as hereafter described is not necessary for public use and convenience, and no public or private interests will be adversely affected by the abandonment and vacation thereof as an alley,

NOW, THEREFORE, BE IT RESOLVED that all that portion of the alley between Hamblin Avenue on the North, Lafayette Street on the South, extending from the West line of Angell Street West 690.7 feet to the West line of Lot 7 extended North in the Plat of West End Addition as recorded in Plats at Liber 2, Page 35, with the Register of Deeds for Calhoun County, Michigan, be and the same is hereby vacated, abandoned and discontinued as a public alley, subject, however, to the reservation to the City for the benefit of itself and the public of such easements and rights-of-way for public utility purposes as may be necessary; and

BE IT FURTHER RESOLVED that the vacation of said alley is upon the condition that title to all gas, electric poles, wires, conduits, cables, appurtenances and facilities now in, under or over said alley are reserved to and shall remain in the owner thereof, together with the easements and continued rights to occupy said alley for public utility purposes with present and additional facilities and to operate, maintain, repair, replace, substitute for or remove the same to the same effect and in the same manner as if said alley had remained a public alley; and

BE IT FURTHER RESOLVED that the City Clerk is hereby instructed to file in the Office of the State Treasurer and record with the Office of the Register of Deeds for Calhoun County, Michigan, certified copies of this Resolution, together with a certificate that the Plat of West End Addition to the City of Battle Creek, as recorded in Plats at Liber 2, Page 35, in the Office of the Register of Deeds for Calhoun County, Michigan, is the recorded plat affected by this Resolution.

Robert A. Buckner
City Clerk

ORIGINAL *File*

I, Loraine A. Buckner, Clerk of the City of Battle Creek, hereby certify the above and foregoing is a true and correct copy of a resolution adopted by the City Commission

at a regular meeting held on the 25th

day of August, 1981

Loraine A. Buckner
Loraine A. Buckner, City Clerk

Recorded September 8, 1981 in
Liber 1236, Page 784.



RESOLUTION

A RESOLUTION VACATING A PORTION OF
MANCHESTER STREET

Battle Creek, Mich.,

August 25, 1981

RECORDED
SEP 9 1 47 PM '81
13443
13385
13399
13325
NO. 298

Resolved by the Commission of the City of Battle Creek:

WHEREAS, it appears to the City Commission that the public street known as East Manchester Street in Cushing's Addition as hereafter described is not necessary for public use and convenience, and no public or private interests will be adversely affected by the abandonment and vacation thereof as a public street,

NOW, THEREFORE, BE IT RESOLVED that all of the public street known as Manchester Street from the West line of Brook Street to the East line of Grant Street in Cushing's Addition to the City of Battle Creek as recorded at Liber 1, Page 28, with the Register of Deeds for Calhoun County, Michigan, be and the same is hereby vacated, abandoned and discontinued as a public street subject, however, to the reservation to the City for the benefit of itself and the public of such easements and rights-of-way for public utility purposes as may be necessary; and

BE IT FURTHER RESOLVED that the vacation of said public street is upon the condition that title to all gas, electric poles, wire, conduits, cables, appurtenances and facilities now in, under or over said public street are reserved to and shall remain in the owner thereof, together with the easements and continued rights to occupy said public street for public utility purposes with present and additional facilities, and to operate, maintain, repair, replace, substitute for or remove the same to the same effect and in the same manner as if said public street had remained a public street; and

BE IT FURTHER RESOLVED that the City Clerk is hereby instructed to file in the Office of the State Treasurer and record with the Office of the Register of Deeds for Calhoun County, Michigan, certified copies of this Resolution, together with a certificate that the Plat of Cushing's Addition to the City of Battle Creek as recorded in Plats at Liber 1, Page 28, in the Office of the Register of Deeds for Calhoun County, Michigan, is the recorded plat affected by this Resolution.

Forrest C. Sen
Herbert Huel

ORIGINAL

I, Loraine A. Buckner, Clerk of the City of Battle Creek, hereby certify the above and foregoing is a true and correct copy of a resolution adopted by the City Commission

Recorded September 8, 1981 in Liber 1236
Page 781.

at a regular meeting held on the 25th

day of August, 1981

Loraine A. Buckner
Loraine A. Buckner, City Clerk

LIBER 1236 PAGE 781

74610EED 3.00



RESOLUTION

A RESOLUTION VACATING A PUBLIC ALLEY
IN GILBERT'S ADDITION TO THE CITY

Battle Creek, Mich., August 25, 1981

Resolved by the Commission of the City of Battle Creek:

WHEREAS, it appears to the City Commission that the alley in Gilbert's Addition as hereafter described is not necessary for public use and convenience, and no public or private interests will be adversely affected by the abandonment and vacation thereof as an alley,

NOW, THEREFORE, BE IT RESOLVED that all of the alley between the South ROW line of the Grant Trunk Railroad on the North and First Street on the South, extending from the East line of Gilbert Street to the West Line of Idaho Street in the plat of Gilbert's Addition to the City of Battle Creek as recorded at Liber 3, Page 8, with the Register of Deeds for Calhoun County, Michigan, be and the same is hereby vacated, abandoned and discontinued as a public alley subject, however, to the reservation to the City for the benefit of itself and the public of such easements and rights-of-way for public utility purposes as may be necessary; and

BE IT FURTHER RESOLVED that the vacation of said alley is upon the condition that title to all gas, electric poles, wire, conduits, cables, appurtenances and facilities now in, under or over said alley are reserved to and shall remain in the owner thereof, together with the easements and continued rights to occupy said alley for public utility purposes with present and additional facilities, and to operate, maintain, repair, replace, substitute for or remove the same to the same effect and in the same manner as if said alley had remained a public alley; and

BE IT FURTHER RESOLVED that the City Clerk is hereby instructed to file in the Office of the State Treasurer and record with the Office of the Register of Deeds for Calhoun County, Michigan, certified copies of this Resolution, together with a certificate that the Plat of Gilbert's Addition to the City of Battle Creek, as recorded in Plats at Liber 3, Page 8, in the Office of the Register of Deeds for Calhoun County, Michigan, is the recorded plat affected by this Resolution.

Forrest C. Sen
Herbert Huel

ORIGINAL

I, Loraine A. Buckner, Clerk of the City of Battle Creek, hereby certify the above and foregoing is a true and correct copy of a resolution adopted by the City Commission

Recorded September 8, 1981 in Liber 1236
Page 782

at a regular meeting held on the 25th

day of August, 1981

Loraine A. Buckner
Loraine A. Buckner, City Clerk



RESOLUTION

A RESOLUTION VACATING A PUBLIC ALLEY
IN EMMETT PARK ADDITION TO THE CITY
OF BATTLE CREEK

Battle Creek, Mich., August 25, 1981

Resolved by the Commission of the City of Battle Creek:

WHEREAS, it appears to the City Commission that the public alley in Emmett Park Addition as hereafter described is not necessary for public use and convenience, and no public or private interests will be adversely affected by the abandonment and vacation thereof as a public alley,

NOW, THEREFORE, BE IT RESOLVED that all that portion of the alley between Stone Street on the West, Lansing Avenue on the East, extending from the North line of Second Street North 209.88 feet to the North line of Lot 13 extended East in the Plat of Emmett Park Addition as recorded in Plats at Liber 1, Page 18, with the Register of Deeds for Calhoun County, Michigan, be and the same is hereby vacated, abandoned and discontinued as a public alley, subject, however, to the reservation to the City for the benefit of itself and the public of such easements and rights-of-way for public utility purposes as may be necessary; and

BE IT FURTHER RESOLVED that the vacation of the said alley is upon the condition that title to all gas, electric poles, wires, conduits, cables, appurtenances and facilities now in, under or over said alley are reserved to and shall remain in the owner thereof, together with the easements and continued rights to occupy said alley for public utility purposes with present and additional facilities, and to operate, maintain, repair, replace, substitute for or remove the same to the same effect and in the same manner as if said alley had remained a public alley; and

BE IT FURTHER RESOLVED that the City Clerk is hereby instructed to file in the Office of the State Treasurer and record with the Office of the Register of Deeds for Calhoun County, Michigan, certified copies of this Resolution, together with a certificate that the Plat of Emmett Park Addition to the City of Battle Creek, as recorded in Plats at Liber 1, Page 18, in the Office of the Register of Deeds for Calhoun County, Michigan, is the recorded plat affected by this Resolution.

Forrest C. Sen
Herbert Huel

ORIGINAL

I, Loraine A. Buckner, Clerk of the City of Battle Creek, hereby certify the above and foregoing is a true and correct copy of a resolution adopted by the City Commission

Recorded September 8, 1981 in Liber 1236
Page 783.

at a regular meeting held on the 25th

day of August, 1981

Loraine A. Buckner
Loraine A. Buckner, City Clerk