GILBERTS 2d ADDITION
TO
BATTLE CREEK

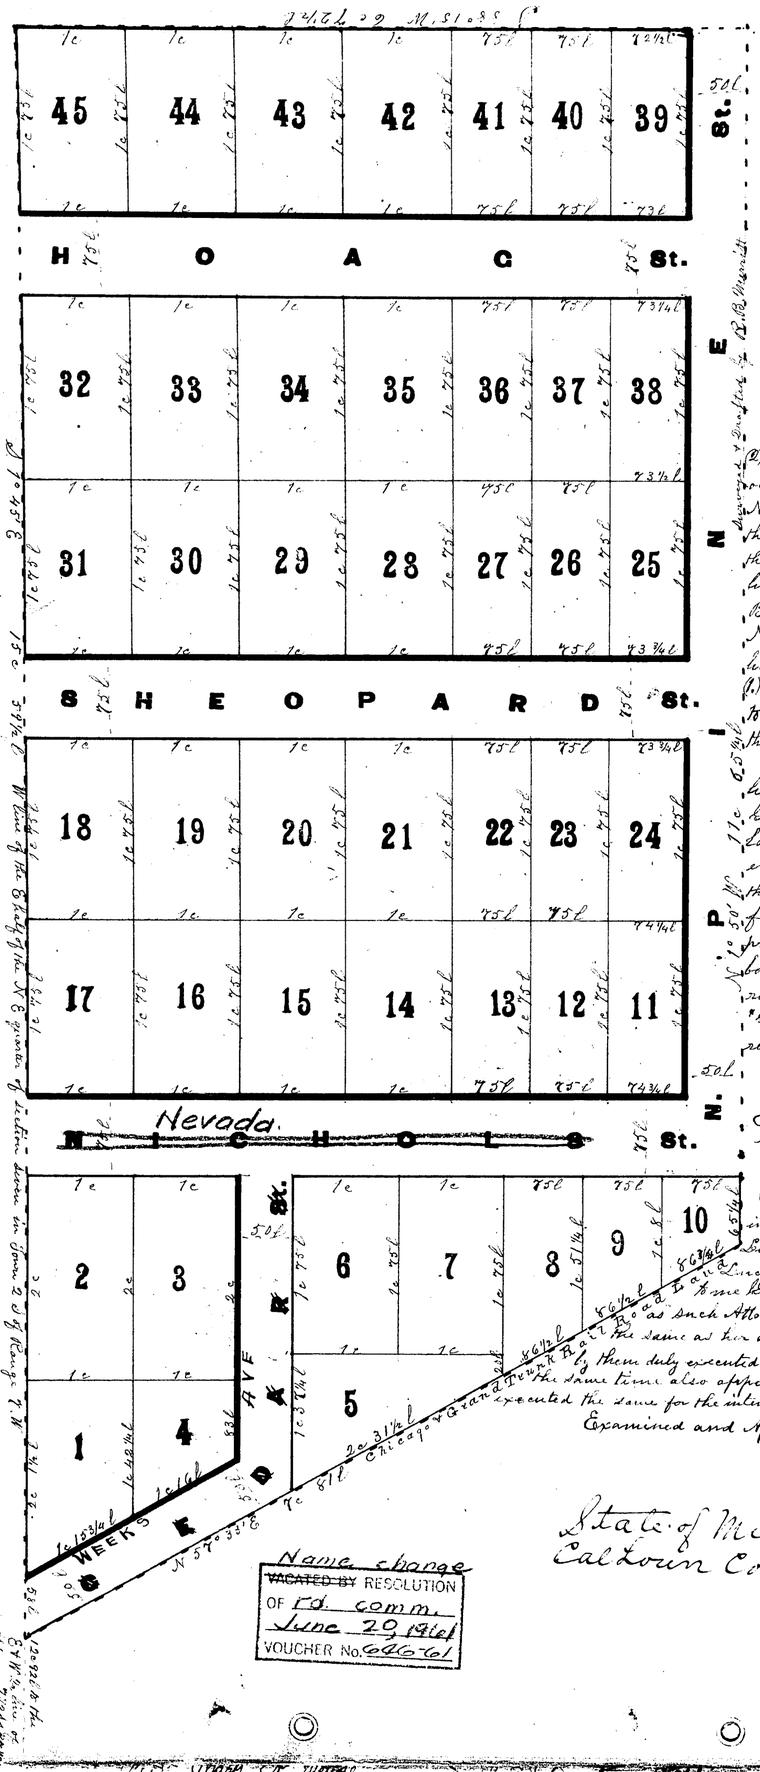

Name change
VACATED BY RESOLUTION
OF Ed. comm.
June 20, 1961
VOUCHER No. 646-61

RECEIVED AND FILED
in Auditor General's Office
July 28 1885
H. R. Pratt

Minutes of the Survey

Beginning at a point on the West line of the East half of the Northeast quarter of section (7) seven in Town (2) two South of Range (7) Seven West and 12 c & 92 l North of the East & West Quarter line of said section & where the North line of land occupied by the Chicago & Grand Trunk Rail Road Company intersects the same running thence N 58° 35' E along said North line (7) seven chains and (81) eighty one links to the West line of the recorded Plat known as "Roberts Addition to Battle Creek" Witness the Northwest corner of said Rail Road Company's coal shed bearing S 17° 45' E (3) three chains and (43 3/4) forty three and two thirds links Also the Northwest corner of the Brick Machine Shop bearing S 88° E (3) three chains and (67) sixty nine links thence N 1° 50' W along the West line of said Roberts Plat (71) eleven chains and (65 1/2) sixty five and a half links Witness the Northwest corner of Samuel Bowers House bearing S 41° 30' E (1) one chain and (23) twenty eight links Also the Southwest corner of J H Sisa's house bearing N 81° 30' E (1) one chain and (46 3/4) forty six and three quarter links thence S 88° 75' W (6) six chains and (82 1/2) seventy two and a half links to the West line of the East half of the Northeast quarter of section (7) Seven aforesaid thence S 1° 45' E along said line (1) one chain and (75) seventy five links to the Northeast corner of the Recorded Plat known as "Nichols & Sheopard's Addition to Battle Creek" thence S 1° 45' E continuing on said West line (13) thirteen chains and (84 1/2) eighty four and a half links to the place of beginning containing (97 100) nine and fourteen one hundredths acres of land more or less

We the undersigned George F. Gilbert & Lillis H. Gilbert his wife Stephen Gilbert & Nellie Gilbert his wife Samuel S Gilbert & Lucy G. Gilbert his wife Mary A Kyte & Chester E Kyte her husband & Mary J Gilbert and Olive Gilbert of the City of Battle Creek County of Calhoun and State of Michigan Proprietors of the above described piece of Land do hereby lay out the same into Lots and Streets of the size dimensions and with boundaries courses and extent and numbered and named as set fourth on the adjoining Map and Plat and which map and Plat and the certain figures and signs on this page of Mapping paper truly represent and describe the same the letter (N) standing for North (S) for South (E) for East (W) for West (St) for Street (c) for chains (l) for links (°) for degrees (') for minutes and the figures printed near the center of each Lot being the Number thereof and the size being written on the lines of each and the outside boundaries being indicated by red dotted lines and Nichols street and Sheopard street and Hoag street running at right angles with the West line of this Plat And we further hereby proclaim that this Plat shall be known as "Gilberts 2d Addition to Battle Creek" and those portions marked as Streets within the above boundaries are hereby released to said County of Calhoun as provided by statute in trust for the use of the public as Streets

In witness where of we have hereunto set our hands and seals this twenty fifth day of June A D 1885

In Presence of
Loyd R Mechem
Geo W. Mechem

Olive Gilbert [L.S.]
George F. Gilbert [L.S.]
Lillis H. Gilbert [L.S.]
Stephen Gilbert [L.S.]
Nellie Gilbert [L.S.]
Samuel S. Gilbert [L.S.]
Lucy G. Gilbert [L.S.]
Mary A. Kyte [L.S.]
Chester E Kyte. [L.S.]
Mary J Gilbert [L.S.]
Olive Gilbert [L.S.] their attorney

State of Michigan } ss. On this 24th day of July 1885 before me a Notary Public in and for said County personally appeared Olive Gilbert in her individual capacity and also as Attorney in fact of George F Gilbert and Lillis H his wife Stephen Gilbert and Nellie his wife Samuel S Gilbert and Lucy G his wife Mary A. Kyte and Chester E. her husband and Mary J Gilbert to me known to be the person named in, and who in her individual capacity and as such Attorney executed the above instrument and she acknowledged that she executed the same as her own act and deed and as the act and deed of the parties above named by virtue of a power of Attorney to them duly executed bearing date June 9th 1885 & before me produced and proven and for the intents and purposes above mentioned and at the same time also appeared R B. Merritt the surveyor who drafted and executed the above as such surveyor and he acknowledged that he executed the above as his free act and deed

Loyd R. Mechem
Notary Public

Examined and Approved July 8th 1885
H R Pratt
Dep. Auditor General

R B. Merritt surveyor [L.S.]

State of Michigan } Received for record this 25th day of July A.D. 1885.
Calhoun County } ss. at 8:30 o'clock A M. and recorded in Liber 7 of Plats on page 35.

Frank B. Snyder Register of Deeds.

State of Michigan } We Frank B. Snyder Register of Deeds and
County of Calhoun } ss. R B. Merritt Surveyor for said County do hereby certify that we have separately carefully compared the annexed copy with the duplicate plat of "Gilberts 2d Addition to Battle Creek" now of record in the office of said Register of Deeds and that said copy is a true transcript thereof and of the whole of such duplicate plat so recorded.

Frank B. Snyder Register of Deeds.
R B. Merritt Surveyor

1791
13332

GILBERTS 2d ADDITION
TO
BATTLE CREEK

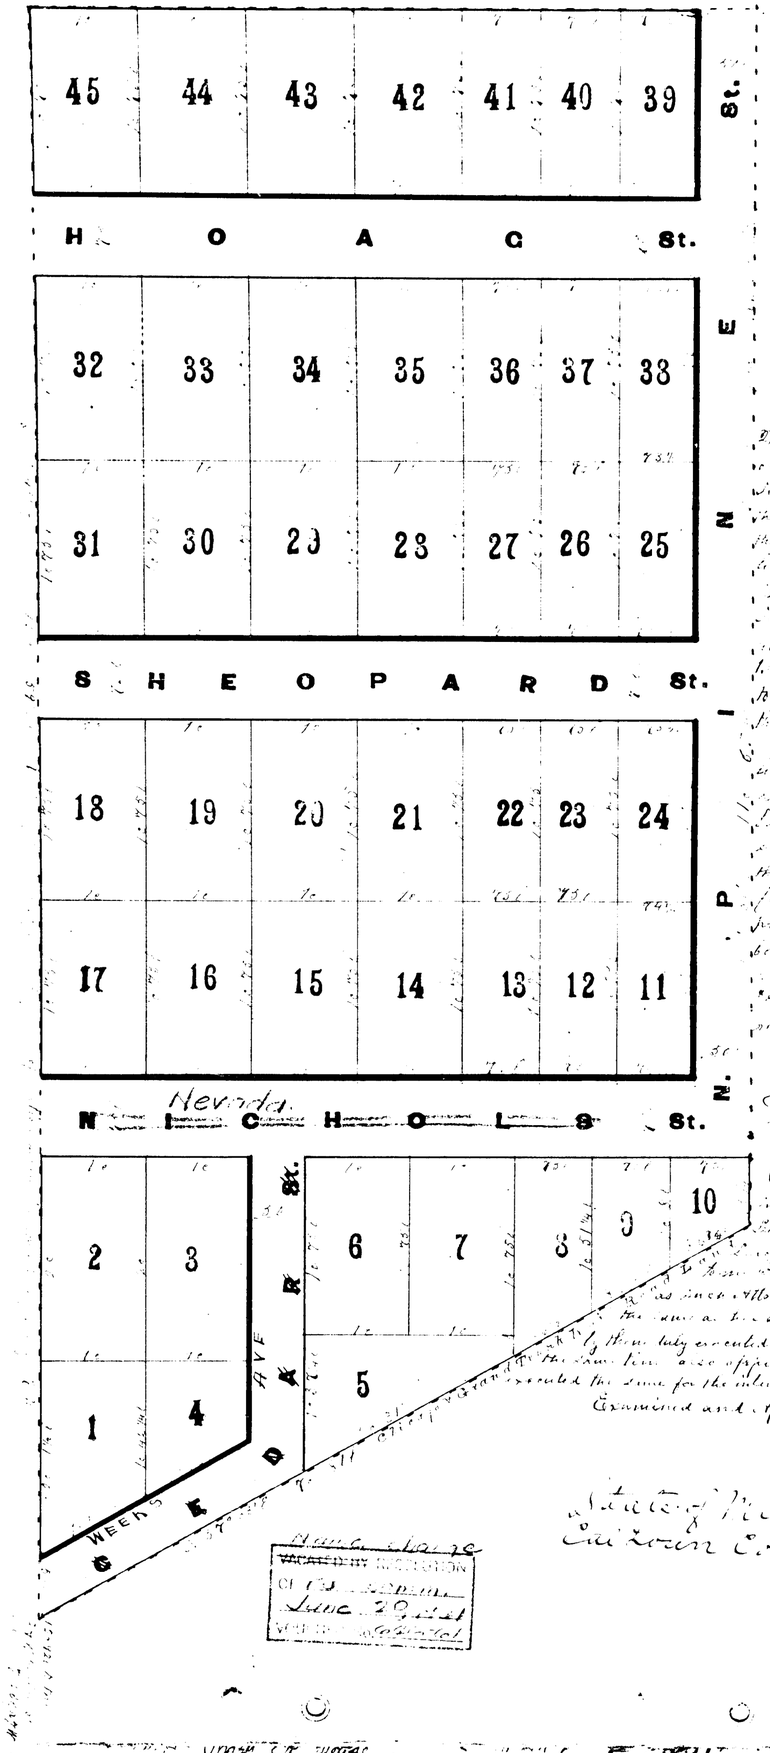

Minutes of the Survey

more or less

We the undersigned George Gilbert & Libbie Gilbert his wife Stephen Gilbert & Nellie Gilbert his wife Samuel D Gilbert & Lucy Gilbert his wife, Mary A Ryte Chester Ryte her husband & Frank J Gilbert and Olive Gilbert of the City of Battle Creek County of Calhoun and State of Michigan Proprietors of the above described piece of land do hereby lay out the same into lots and streets of the size dimensions and with boundaries courses and extent and encumbered and named as it is upon the accompanying map and Plat and the letters figures and signs on this page of drawing paper both represent and describe the same the letter (N) standing for North (S) for South (E) for East (W) for West (ch) for chains (l) for links (°) for degrees (') for minutes and the figures printed near the center of each lot are the Number thereof and the dots being written on the lines of each and the outside boundaries being inclosed by red dotted lines and Nichols Street and Shepard Street and Henry Street running at right angles to the said Plat as shown thereon and further hereby for ourselves that this Plat shall be known as "Gilbert's 2d Addition to Battle Creek" and those portions marked as streets within the above boundaries are hereby released to said County of Calhoun as provided by Statute in trust for the use of the public as streets

In witness whereof we have hereunto set our hands and seals this twenty fifth day of June A.D. 1885

In Presence of
Floyd R Meecham
Geo W Meecham

State of Michigan } ss. On this 24th day of July 1885 before me a Notary Public
County of Calhoun } in and for said County personally appeared Olive Gilbert
to be the individual & only & sole Attorney in fact of Geo. T. Gilbert and
& Home with Stephen Gilbert and Nellie his wife Samuel D Gilbert and
Mary A his wife Mary A Ryte and Chester Ryte husband and Mary J Gilbert
known to be the persons named in, and who in her individual capacity and
as such Attorney executed the above instrument and she acknowledged that she executed
the same as her own act and deed and as the act and deed of the parties above named by virtue
of them duly executed bearing date June 4th 1885 & by me produced and proven and for the intents & purposes above mentioned
the same. Also appeared R B Merrill the surveyor who executed the above survey & made oath that he
executed the same for the intents & purposes above mentioned
Examined and Approved July 8th 1885
H R Pattell
Dep Auditor General

Floyd R Meecham
Notary Public

R B Merrill Surveyor

State of Michigan } ss. Received for record this 25th day of July A.D. 1885
Calhoun County } at 8 30 o'clock A M. and recorded in Book 7 of
Plats on page 35.
Frank J Snyder Register of Deeds.

13332

We Frank J Snyder Register and
County of Calhoun Michigan Register of Deeds and
Recorder of Records of said County do hereby certify
that the annexed copy with the indicated date of
Gilbert's 2d Addition to Battle Creek" consisting of
said Register's office and that it is a true transcript
and of the whole of such original.
In witness whereof I have hereunto subscribed my name
and affixed the seal of said office this 25th day of
Frank J Snyder Register of Deeds
R B Merrill Deputy

Filed for record Aug 25 1885 at 10 o'clock A.M.
Elwin S Hurd
Register of Deeds