13371

Received and Filed
IN AUDITOR GENERAL'S OFFICE
December 3 1890
A. V. Pratt
Deputy Auditor General.

# BROWN'S ADDITION TO BATTLE CREEK.

## DEDICATION.

Know all Men by these Presents, That we, Mrs. Martha L. Brown, Henry J. Brown, and Hattie Brown, his wife, as proprietors, have caused the land embraced in the annexed plat to be surveyed, laid out and platted, to be known as "Brown's Addition to Battle Creek," and that the streets and avenues as shown on said plat are hereby dedicated to the use of the public.

Signed and sealed in presence of

William F Neale } Martha L Brown [L.S.]
Michael Neale } Henry J. Brown [L.S.]
Hattie Brown [L.S.]

## ACKNOWLEDGMENT.

STATE OF MICHIGAN, } ss
COUNTY OF CALHOUN, }

On this Twentieth day of November, 1890, before me, a Notary Public, in and for said county, personally came the above named Mrs. Martha L. Brown, Henry J. Brown, and Hattie Brown, his wife, known to me to be the persons who executed the above dedication, and acknowledged the same to be their free act and deed.

William F Neale
Notary Public, Calhoun Co., Mich.

## DESCRIPTION OF LAND PLATTED.

The land embraced in the annexed plat of Brown's Addition to Battle Creek is situate on the S. E. ¼ of the N. E. Frac. ¼ of Sec. 6, Tp. 2 S., R. 7 W., Calhoun county, and described as follows: Beginning on the ⅛ line of said N. E. Frac. ¼ of said Sec. 6, two rods from the east end thereof, and running thence west on said ⅛ line 78 rods to the half ¼ post on said ⅛ line; thence south on the ⅛ line of the N. E. ¼ of said Sec. 6, 20 rods; thence east parallel with ⅛ line (east and west) 78 rods to the west side of East Ave. in the city of Battle Creek; thence north along the west side of said East Ave. 20 rods, to the place of beginning.

## SURVEYOR'S CERTIFICATE.

*I HEREBY CERTIFY,* That the plat hereon delineated is a correct one, and that permanent monuments, each consisting of a Cedar stake four to five inches through and twenty inches long, planted full depth in the ground, surrounded with three stones, each six to eight inches across, bedded even with the surface of the ground, at points marked thus, "M", as thereon shown at all angles in the boundaries of the land platted, and at all intersections of streets and avenues.

A W Austin
SURVEYOR.

STATE OF MICHIGAN, } ss
COUNTY OF CALHOUN, }

We, Albert H. Geddes. Register of Deeds, and A. W. Austin, Surveyor, hereby certify that we have each carefully compared this copy with the original plat of Brown's Addition to Battle Creek, and that it is an exact copy of the whole of such original map or plat.

Albert H Geddes
Register of Deeds.

A W Austin
Surveyor.

Examined and approved November 21 1890. A V Pratt
Deputy Auditor General.

Received for record this 26th day of November A.D. 1890, at 9 o'clock Am, and recorded in Liber 2 of Plats on page 22

Albert H Geddes
Register of Deeds.

State of Michigan } ss, We Albert H. Geddes Register
County of Calhoun } of Deeds and A W Austin Surveyor hereby certify that we have each carefully compared the annexed copy with the plat of "Brown's Addition to Battle Creek" now of record in the office of said Register of Deeds, and that it is a true transcript therefrom and of the whole of such record

Albert H Geddes } Register of Deeds
A W Austin } Surveyor

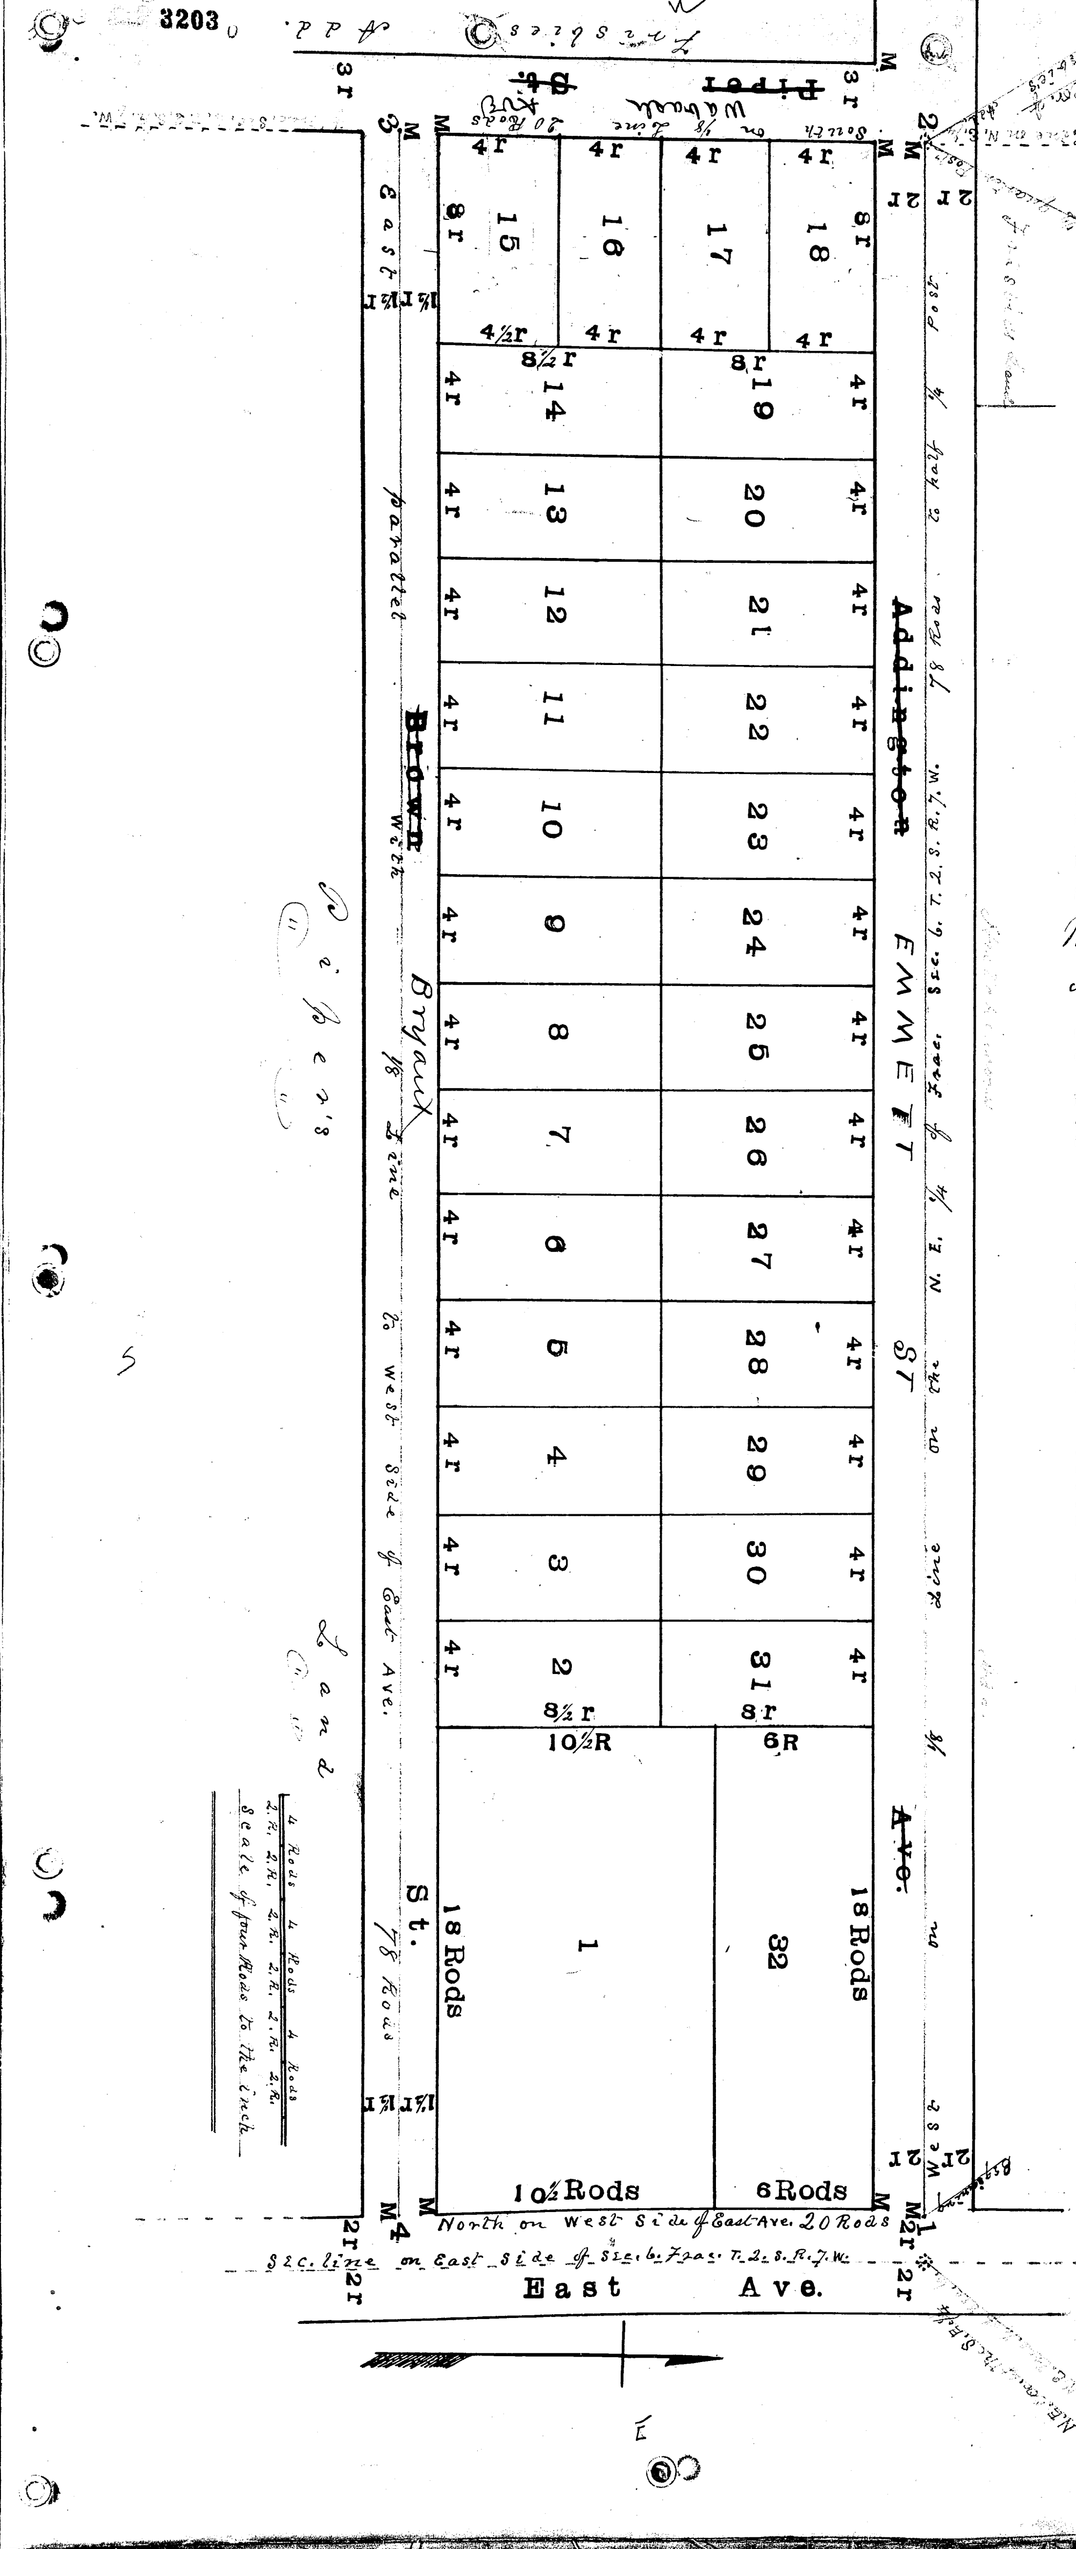

13371

Received and Filed
IN AUDITOR GENERAL'S OFFICE
December 3 1890
M. A. Platt
Deputy Auditor General.

# BROWN'S ADDITION
## TO
# BATTLE CREEK.

## DEDICATION.

Know all Men by these Presents, That we, Mrs. Martha L. Brown, Henry J. Brown, and Hattie Brown, his wife, as proprietors, have caused the land embraced in the annexed plat to be surveyed, laid out and platted, to be known as "Brown's Addition to Battle Creek," and that the streets and avenues as shown on said plat are hereby dedicated to the use of the public.

Signed and sealed in presence of

Martha L Brown [L.S.]
William F Neale — Henry J Brown [L.S.]
Michael Neale — Hattie Brown [L.S.]

## ACKNOWLEDGMENT.

STATE OF MICHIGAN, } ss
COUNTY OF CALHOUN, }

On this twenty-sixth day of November, 1890, before me, a Notary Public, in and for said county, personally came the above named Mrs. Martha L. Brown, Henry J. Brown, and Hattie Brown, his wife, known to me to be the persons who executed the above dedication, and acknowledged the same to be their free act and deed.

William F Neale
Notary Public, Calhoun Co., Mich.

## DESCRIPTION OF LAND PLATTED.

The land embraced in the annexed plat of Brown's Addition to Battle Creek is situate on the S. E. ¼ of the N. E. Frac. ¼ of Sec. 6, Tp. 2 S., R. 7 W., Calhoun county, and described as follows: Beginning on the ¼ line of said N. E. Frac. ¼ of said Sec. 6, two rods from the east end thereof, and running thence west on said ¼ line 78 rods to the half ¼ post on said ¼ line; thence south on the ¼ line of the N. E. ¼ of said Sec. 6, 20 rods; thence east parallel with ¼ line (east and west) 78 rods to the west side of East Ave. in the city of Battle Creek; thence north along the west side of said East Ave. 20 rods, to the place of beginning.

## SURVEYOR'S CERTIFICATE.

*I HEREBY CERTIFY*, That the plat hereon delineated is a correct one, and that permanent monuments, each consisting of a Cedar stake four to five inches through and twenty inches long, planted full depth in the ground, surrounded with three stones, each six to eight inches across, bedded even with the surface of the ground, at points marked thus, "M", as thereon shown at all angles in the boundaries of the land platted, and at all intersections of streets and avenues.

A. W. Austin
SURVEYOR.

STATE OF MICHIGAN, } ss
COUNTY OF CALHOUN, }

We, Albert H. Geddes, Register of Deeds, and A. W. Austin, Surveyor, hereby certify that we have each carefully compared this copy with the original plat of Brown's Addition to Battle Creek, and that it is an exact copy of the whole of such original map or plat.

Albert H. Geddes
Register of Deeds.
A. W. Austin
Surveyor.

Examined and approved December 21 1890. M. A. Platt
Deputy Auditor General.

Received for record this 26th day of November A.D. 1890, at 9 o'clock AM, and recorded in Liber 2 of Plats on page 22

Albert H. Geddes
Register of Deeds.

State of Michigan } ss, We Albert H. Geddes, Register of Deeds and A. W. Austin Surveyor hereby certify that we have each carefully compared the annexed copy with the plat of "Brown's Addition to Battle Creek" now of record in the office of said Register of Deeds, and that is a true transcript thereof and of the whole of such record
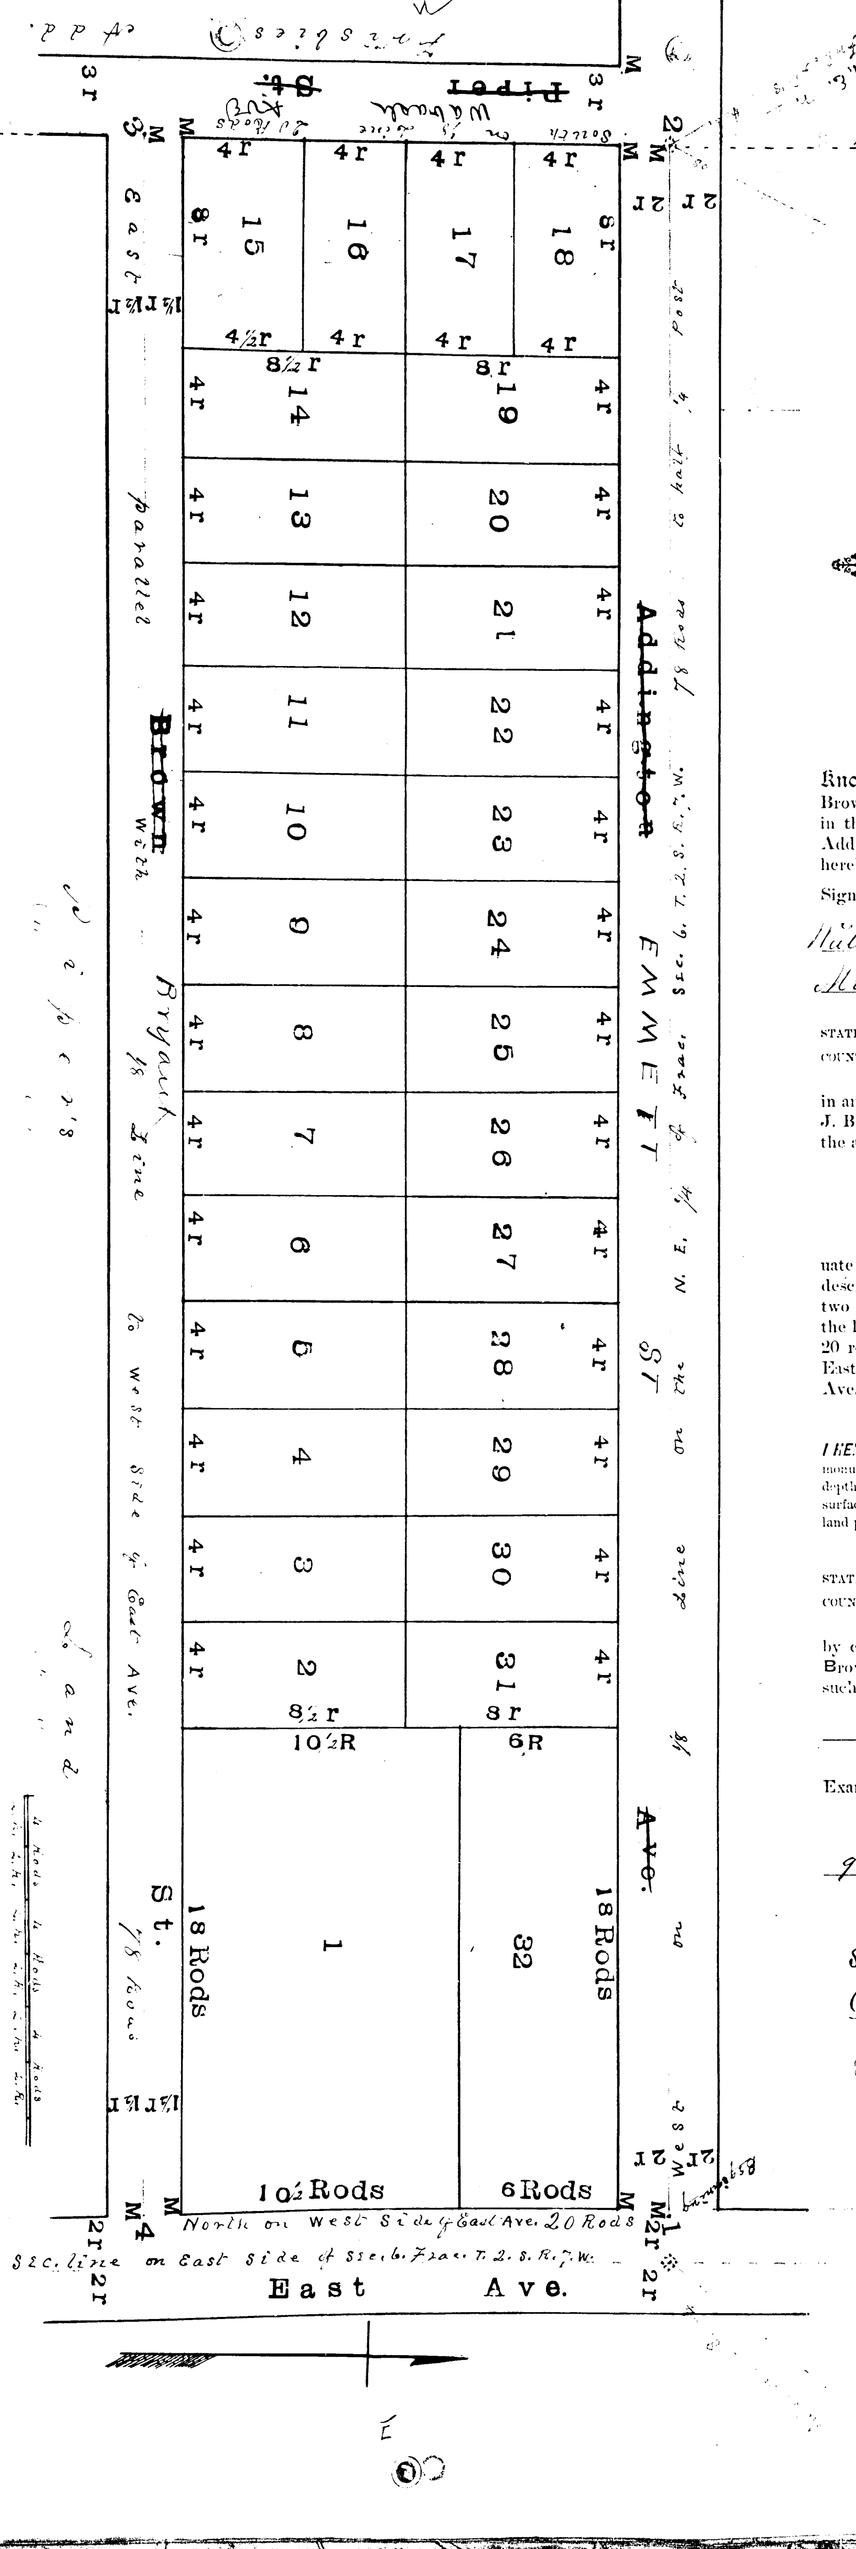
Albert H. Geddes — Register of Deeds
A. W. Austin — Surveyor