

3263

Pro. Auditor General's Office
Jan. 25-1891
Dec. 25-1891

13374

FRISBIE'S SOUTH SIDE ADDITION

PLAT OF

TO THE CITY OF BATTLE CREEK

CALHOUN COUNTY, MICHIGAN.



CONSISTING of a strip of land 50 links wide off from the South side of the Southwest quarter of Section 12, also a strip of land 50 links wide off from the North end of the West half of the Northwest quarter of Section 13, and a piece of land 12.50 chains wide off from the East side of the remaining part of the Southeast quarter of the Southwest quarter of Section 12, all in Township 2, South Range 8 West.

HARRY HODGMAN, SURVEYOR.

I DO HEREBY CERTIFY, that this is a correct plat of Frisbie's South Side Addition to the City of Battle Creek, as surveyed by me and that permanent monuments have been planted at all the angles in the boundary line of the land platted and at the intersections of all streets, or of streets and alleys, at the points marked with black circles on the plat. These monuments consist of cedar stakes, driven eighteen inches in the ground with three stones planted around each stake, except at the Section Corner and Quarter Post, where solid earthen posts 3 inches in diameter are planted.

Witness to North-east corner of Plat, Black Oak 10 inches in diameter, N. 24 1/2 degrees W. 44 links.
Witness to South Quarter Post of Section 12, White Oak 22 inches in diameter, N. 61 1/2 degrees E. 66 1/2 links. Apple tree S. 75 degrees E. 74 links.
Witness to Corner of Sections 11, 12, 13 and 14, Burr Oak 14 inches diameter, S. 69 1/2 degrees W. 69 links. Hickory 12 inches diameter, S. 23 1/2 degrees E. 139 links.

We, Omer B. Frisbie and Estella Frisbie his wife, and George R. Burnham and Marietta A. Burnham his wife, owners of the land described in this plat of Frisbie's South Side Addition to the City of Battle Creek, do hereby execute said Plat, and dedicate to the public, the land marked thereon as Streets and Avenues for use as public highways, and for no other purpose.

IN TESTIMONY WHEREOF, we have hereunto affixed our signatures this 14th day of November, A. D. 1890.

REPORTED IN PRESENCE OF
O. B. Frisbie L. S.
Estella Frisbie L. S.
George R. Burnham L. S.
Marietta A. Burnham L. S.

STATE OF MICHIGAN,
COUNTY OF CALHOUN.

On this 14th day of November, A. D. 1890, before me a Notary Public, in and for said County, personally appeared Omer B. Frisbie and Estella Frisbie his wife, and George R. Burnham and Marietta A. Burnham his wife, to me known to be the persons who executed this plat, and who severally acknowledged the same to be their free act and deed.

O. B. Frisbie Notary Public.

Examined and approved November 21st 1890

Deputy Auditor General.

Received for record the 16 day of December A. D. 1890, at 9 o'clock A. M. and recorded in Liber 2 of Plats, on Page 25

STATE OF MICHIGAN,
COUNTY OF CALHOUN.

We, Albert H. Goodrich, Register of Deeds and Harry Hodgman, Surveyor, hereby certify that we have each care-fully compared this copy with the original plat of Frisbie's South Side Addition to the City of Battle Creek, and that it is an exact copy thereof, and of the whole of such original plat.

Albert H. Goodrich Register of Deeds.


STATE OF MICHIGAN,
COUNTY OF CALHOUN.

We, Albert H. Goodrich, Register of Deeds and Harry Hodgman, Surveyor, do hereby certify that we have each carefully compared this copy with the plat of Frisbie's South Side Addition to the City of Battle Creek, now on record in the office of said Register of Deeds, and that it is a true transcript therefrom, and of the whole of such record.

Albert H. Goodrich Register of Deeds.


Harry Hodgman Surveyor.

NOTE - In changed of La balle AT-10
Standard Road See Letter #9335-1429
Wm R. Kamech

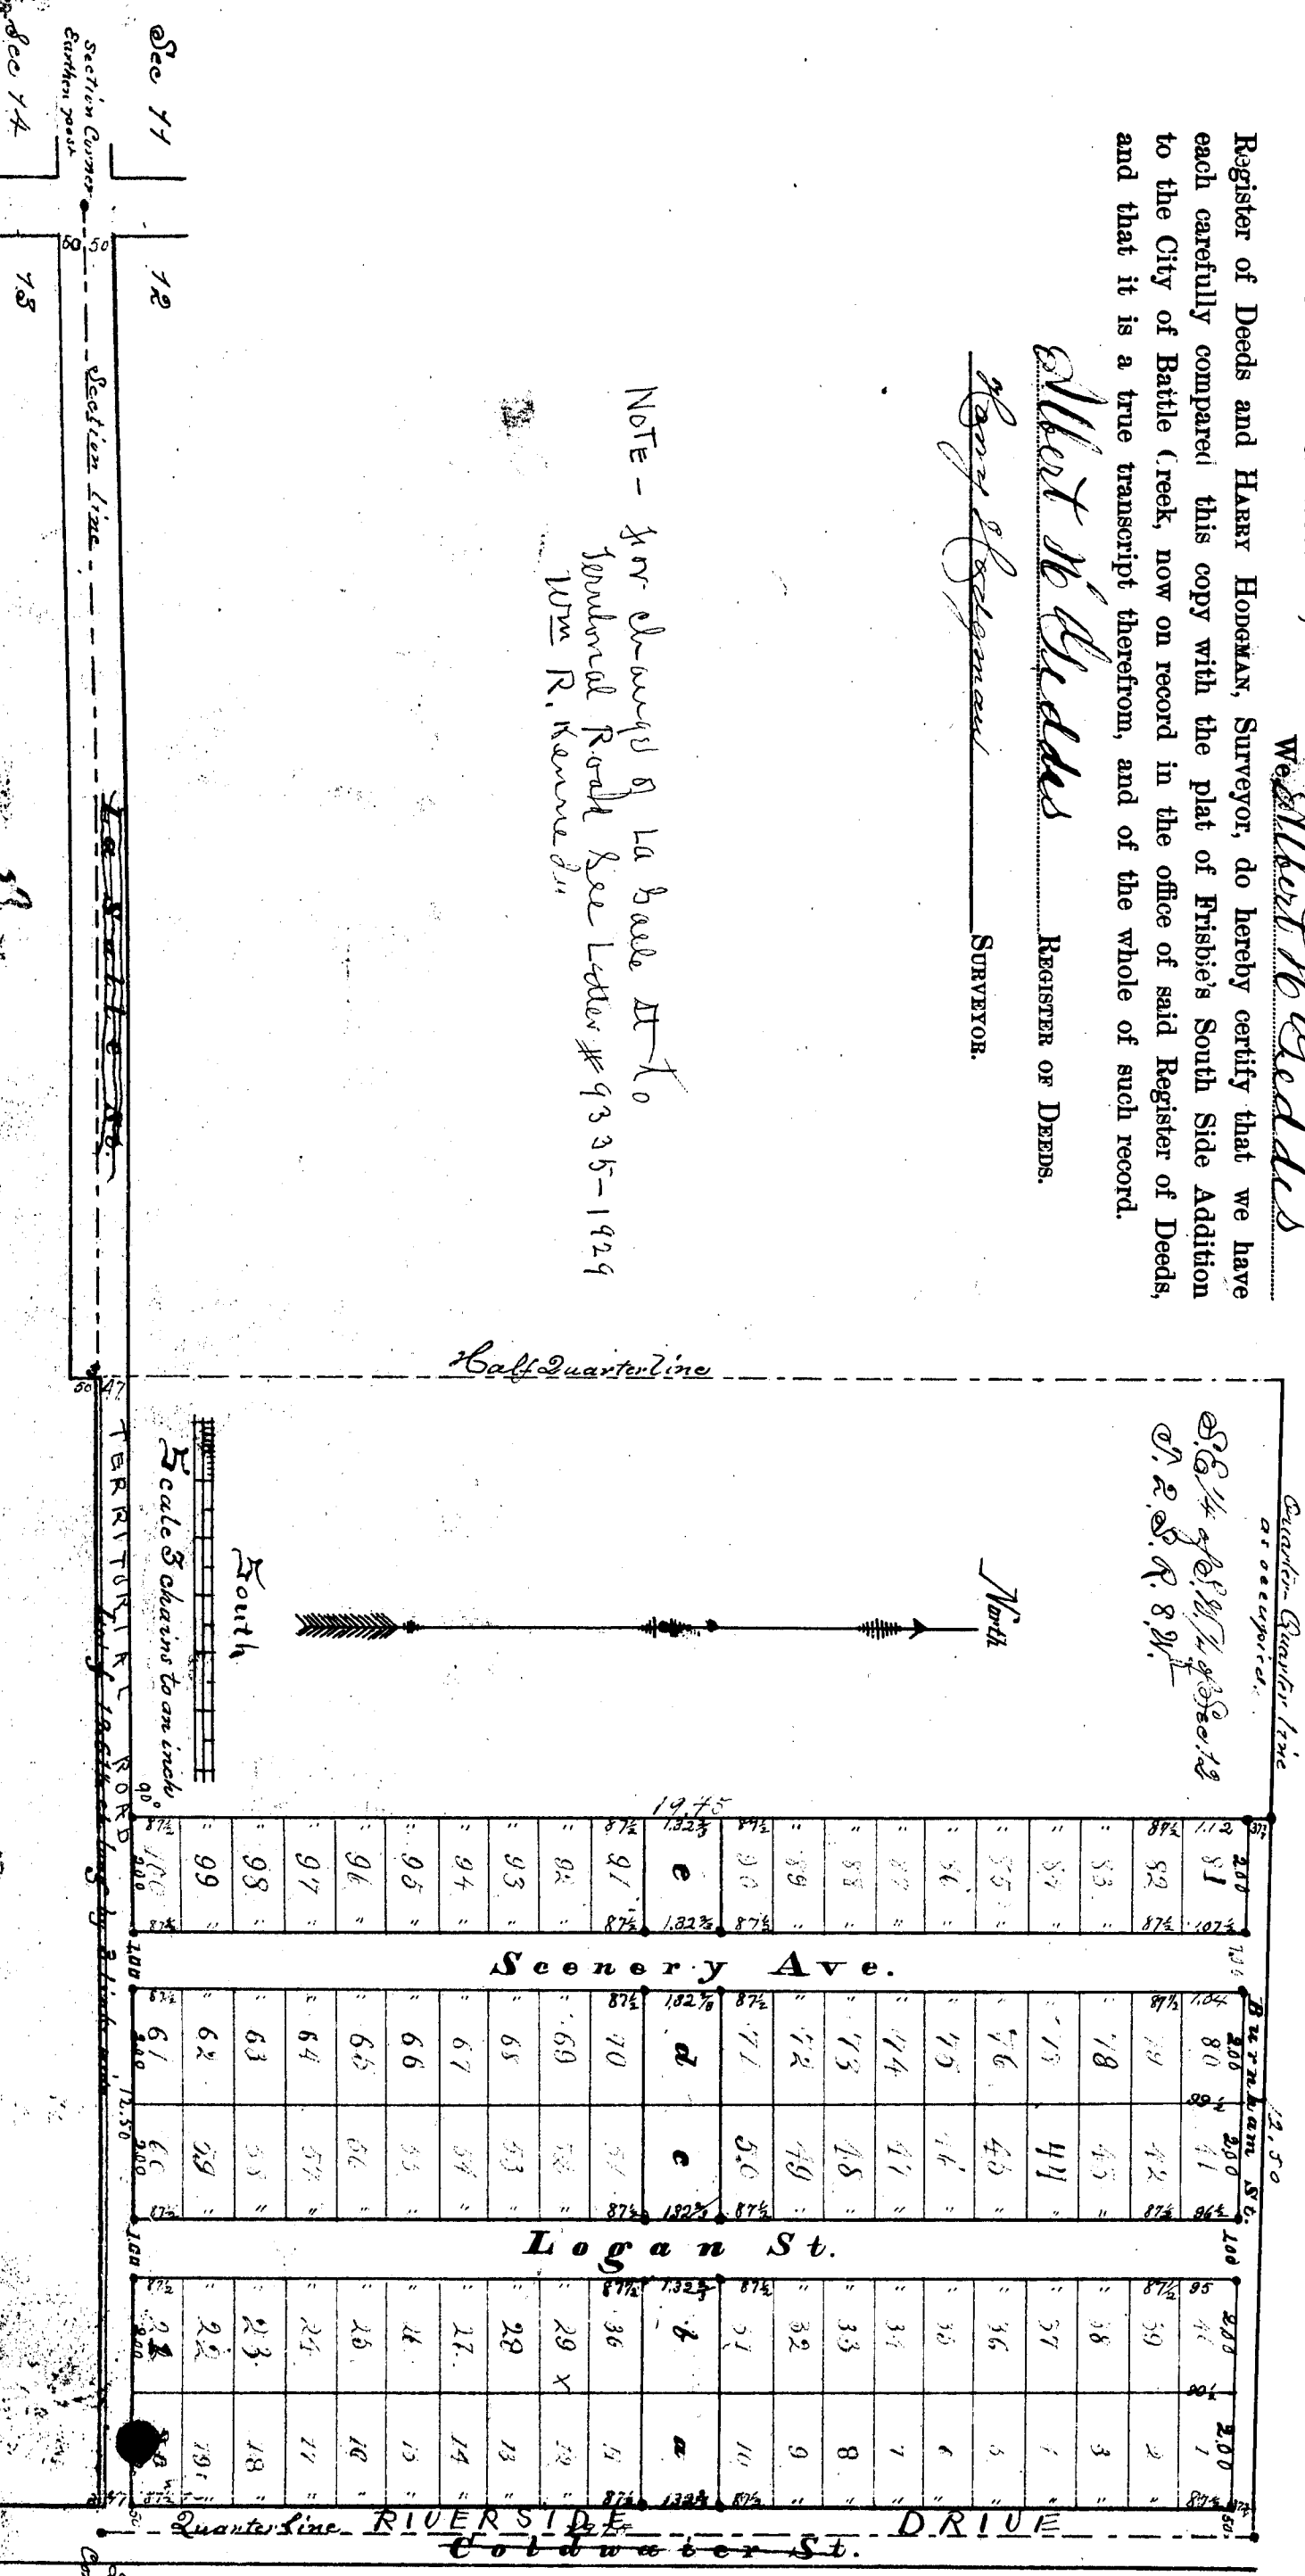

And Audited Summary of
 Frisbie's South Side Add. No. 1
 Dec 25-1891

PLAT OF FRISBIE'S SOUTH SIDE ADDITION

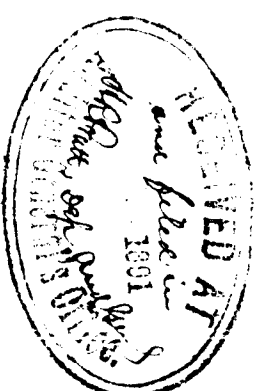

TO THE CITY OF BATTLE CREEK, CALHOUN COUNTY, MICHIGAN.

CONSISTING of a strip of land 50 links wide off from the South side of the Southwest quarter of Section 12, also a strip of land 50 links wide off from the North end of the West half of the Northwest quarter of Section 13, and a piece of land 1250 chains wide off from the East side of the remaining part of the Southeast quarter of the Southwest quarter of Section 12, all in Township 2, South Range 8 West.

HARRY HODGMAN, SURVEYOR.

I DO HEREBY CERTIFY, that this is a correct plat of Frisbie's South Side Addition to the City of Battle Creek as surveyed by me and that permanent monuments have been planted at all the angles in the boundary line of the land platted and at the intersections of all streets, or of streets and alleys, at the points marked with black circles on the plat. These monuments consist of cedar stakes, driven eighteen inches in the ground with three stones planted around each stake, except at the Section Corner and Quarter Post, where solid earthen posts 3 inches in diameter are planted.

Witness to Northeast corner of Plat. Black Oak 10 inches in diameter, N. 24 1/2 degrees W. 44 links.

Witness to South Quarter Post of Section 12. White Oak 22 inches in diameter, N. 61 1/2 degrees E. 66 1/2 links. Apple tree S. 75 degrees E. 74 links.

Witness to Corner of Sections 11, 12, 13 and 14. Burr Oak 14 inches diameter, S. 69 1/2 degrees W. 69 links. Hickory 12 inches diameter, S. 29 1/2 degrees E. 139 links.

Harry Hodgman, SURVEYOR.

We, Ours B. Friesse and Estella Friesse his wife, and George R. BURNHAM and MARIETTA A. BURNHAM his wife, owners of the land described in this plat of Frisbie's South Side Addition to the City of Battle Creek, do hereby execute said Plat, and dedicate to the public the land marked thereon as Streets and Avenues for use as public highways, and for no other purpose.

IN TESTIMONY WHEREOF, we have hereunto affixed our signatures this 14th day of November, A. D. 1890.

EXPECTED IN PRESENCE OF

E. S. Friesse

Estella Friesse

George R. Burnham

Marietta A. Burnham

STATE OF MICHIGAN.

COUNTY OF CALHOUN.

On this 14th day of November, A. D. 1890, before me a Notary Public, in and for said County, personally appeared Ours B. Friesse and Estella Friesse his wife, and George R. BURNHAM and MARIETTA A. BURNHAM his wife, to me known to be the persons who executed this plat, and who severally acknowledged the same to be their free act and deed.

Notary Public.

Examined and approved, 14th day of November, 1890.

Received for record the 14th day of December, A. D. 1890, at 5 o'clock P. M. and recorded in Liber 2 of Plats, on Page 25.

DEPUTY AUDITOR GENERAL.

STATE OF MICHIGAN.

COUNTY OF CALHOUN.

We, Alfred H. Gledits, Register of Deeds and Harry Hodgman, Surveyor, hereby certify that we have each carefully compared this copy with the plat of Frisbie's South Side Addition to the City of Battle Creek, and that it is an exact copy thereof, and of the whole of such original plat.

Alfred H. Gledits, REGISTER OF DEEDS.

Harry Hodgman, SURVEYOR.

STATE OF MICHIGAN.


COUNTY OF CALHOUN.

Register of Deeds and Harry Hodgman, Surveyor, do hereby certify that we have each carefully compared this copy with the plat of Frisbie's South Side Addition to the City of Battle Creek, now on record in the office of said Register of Deeds, and that it is a true transcript therefrom, and of the whole of such record.

Alfred H. Gledits, REGISTER OF DEEDS.

Harry Hodgman, SURVEYOR.


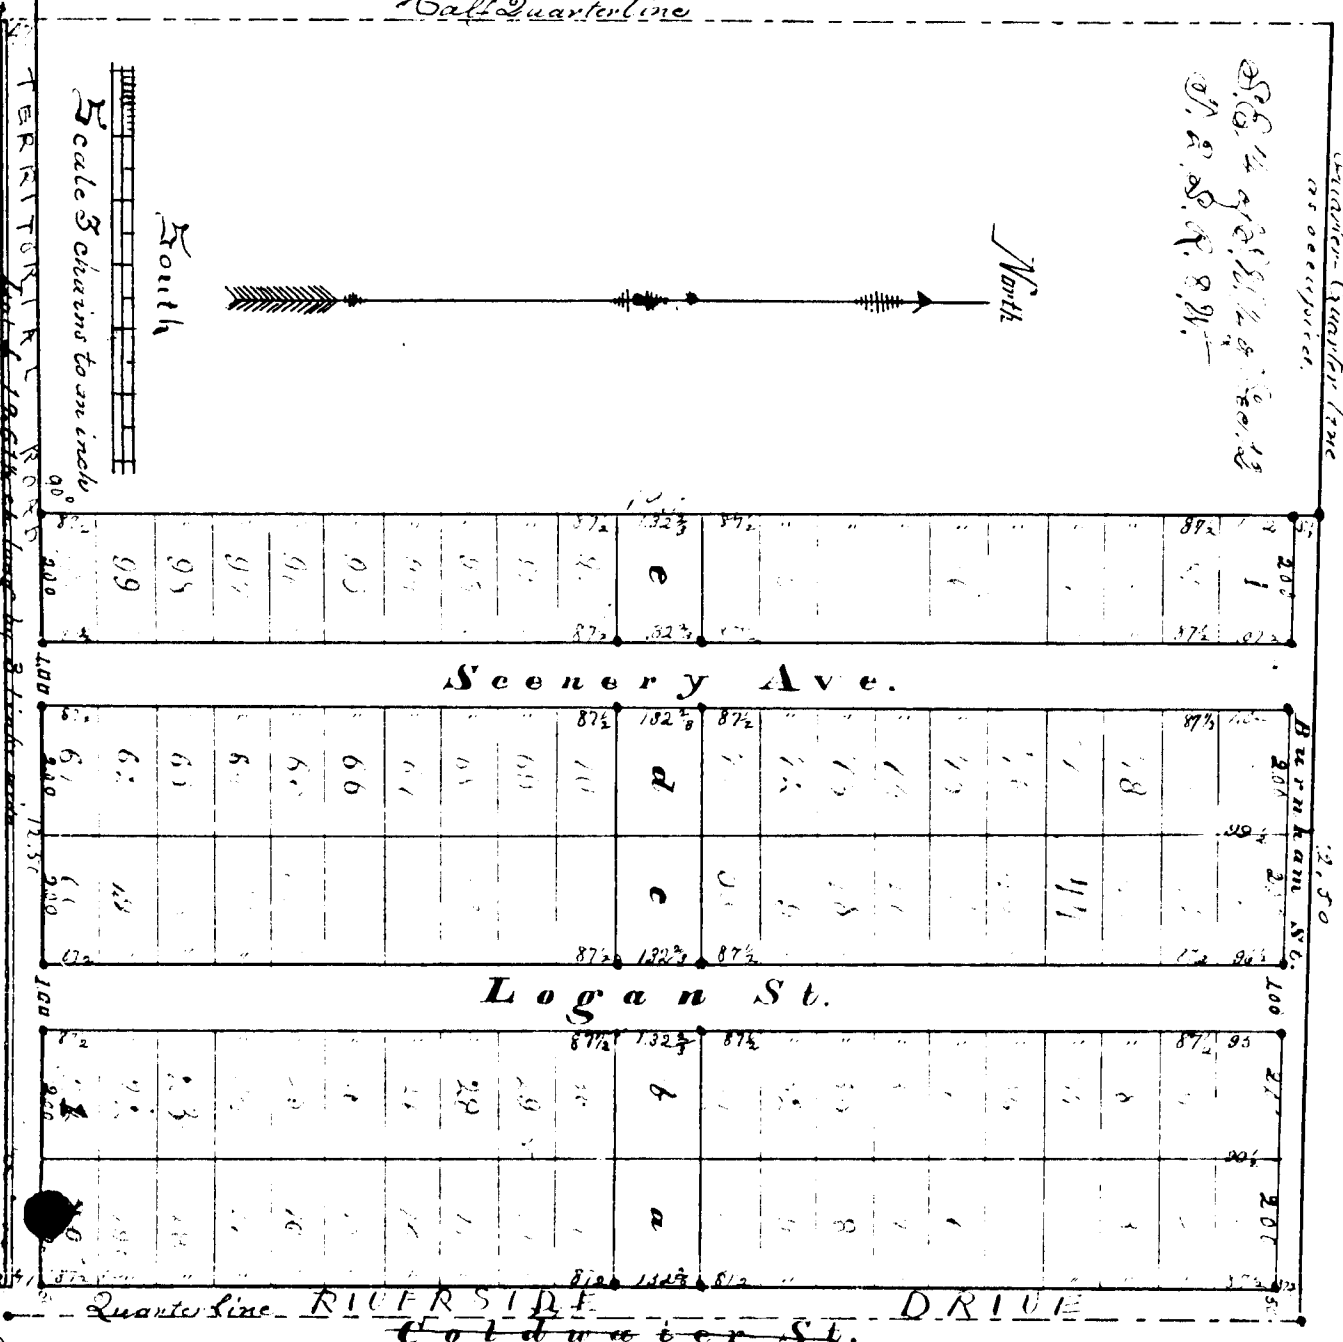

Sec 11 12
 Sec 13 14