

Patle Creek.

Description of band Platted in

of the West half of the N. W. $\frac{1}{4}$, and the West half of the S. W. $\frac{1}{4}$ of Section 8) Town 1 north (A) South of Range 2 west (B) West, County of Michigan, described as follows: to-wit: — Beginning at the Southwest corner of Cornered Post [Pittsburg] in the City of Great Bend, Michigan, which opened easterly to station S in Hundred Sixty (60) feet easterly along the Northern line of Marshall Street from a point in the West Section Nine Twenty, near to its center (S $\frac{1}{2}$ E $\frac{1}{2}$) South of the Well Quarter River, of said Section; Said Place of Beginning being situated as it was made (S $\frac{1}{2}$ E $\frac{1}{2}$) South of the Well Quarter River, of said Section; 5 rods North, also a 12 inch Maple S. 13° E. 57 ft. 6 in.; Running thence West 10 West along the Eastern Boundary Line of said Cornered Post, Thence thence thirty seven rods one half (1937 $\frac{1}{2}$) feet to the Chicago and Toledo Street Railway Company's land, and 50 feet distant southeasterly from the center of the Main Track said Railway; Running thence westerly along the Southern Boundary Line of said Railway Company's land; on a P $\frac{1}{2}$ curve to the left, Eight Hundred Fifty-one (851) feet to a point in the West quarter line (as surveyed) of the N. W. Quarter of said Section, 50 ft. distant southeasterly from the center of the above Main Track, and having written a 32 inch White Oak S with 78 ft. 3 in.; Running thence South along said Half quarter line (as surveyed) and a straight continuation thereof, Two hundred eighty six (2086) feet to a point on the Northern line of Marshall Street, having distance as it was made S. 79° W., 32 ft. 3 in., also a 15 inch Maple S. 23° E. 1 ft. 2 in., also a 14 inch Oak of same size of Napoleon's House, S. 67° E., 75 ft. 7 in.; Running thence N. 89° 48' W. along said Northern line of Marshall Street, One hundred Sixty (60) feet to the Place of Beginning; Enclosing the Height of Way of the Michigan Road East and Company some odd lands all bearing due true indication and all S stations if put and visible.

SUPERVISOR OF COUNTY

Surveyor's Certificate

[illegible]

Dedication

[illegible]

As to execution by Chas. C. Beach, George W. Moberg,
Caleb C. Stoddard and Josephine Stoddard:—

Chas. W. Meeker


Read H. With
re to execution by
Ashley C. Smith & Geo. May Smith: -
J. T. Pottier

Walter C. Stone
Josephine Stone
Charles C. Stone

largest P. Colwin, deceased

John A. Williams.

C. Aug. Smith.

11

State of Michigan } 35. On the 16th day of January, A.D. 1896, before me a Notary Public in and County of Calhoun }
street, and Josephine Stone, for and saying, personally appeared Albert C. Black, George W. Michener, William C. Compounding, all of whom I know to be the persons so named who executed the foregoing plat, who severally acknowledged the same to be their free act and deed. And the said Albert C. Black, and George W. Michener acknowledged that they executed the same as Co-Executors as their decision, for the initiate and purposes therein mentioned, of said C. Willson, Notary Public.

State of Illinois } ss.
County of Cook }

3. Dr. J. Pomeroy, a Notary Public in and for said County, do hereby certify that Ashley B. Smith and E. Amy Smith his wife, appeared to me the 11th of

Seal.

Same persons whose names are subscribed to the foregoing instrument aforesaid executed the same, appeared before me this day in January and acknowledged that they, singular, sealed, and delivered the said instrument as ~~their~~ ^{their} free and voluntary act, for the uses and purposes therein given which may stand as official and this 21st day of January A.D. 1846.

JOS. PONTACOT

* I thereby certify, that this Plat was approved by the Common Council of the City of Detroit, Mich., on the 17th day of February, A.D., 1896.
C. R. Thompson
Recorder of the City of Detroit

Examined and approved Feb'y 1st 1896.
 E. B. King
 Deputy Auditor General

Received for record this 24th day of February A.D. 1896, at 2 o'clock P.M., and recorded in Rider 8 of Plate on page 20, as a proper certificate was furnished in compliance with Section 135, Act 206, Laws of 1893.

MURIEL McFARLANE

State of Michigan) ss. W. C. Howell, Mayor, City of Detroit, County of Wayne, State of Michigan, hereby certify that we have each individually compared this copy with the original plat of "Cottone Addition to Bath Creek," and that it is an exact copy thereof and of the whole of each original map or plat.




RECEIVED AND FILED
IN AUDITOR GENERAL'S OFFICE

Field # 1896

[Signature]
Deputy Assistant General.


VACATED BY RESOLUTION

OF City Commission

MOBILE 241431
VOUCHER NO. 316-57

VACATED BY RESOLUTION

OF city comm
Dec 12 1911

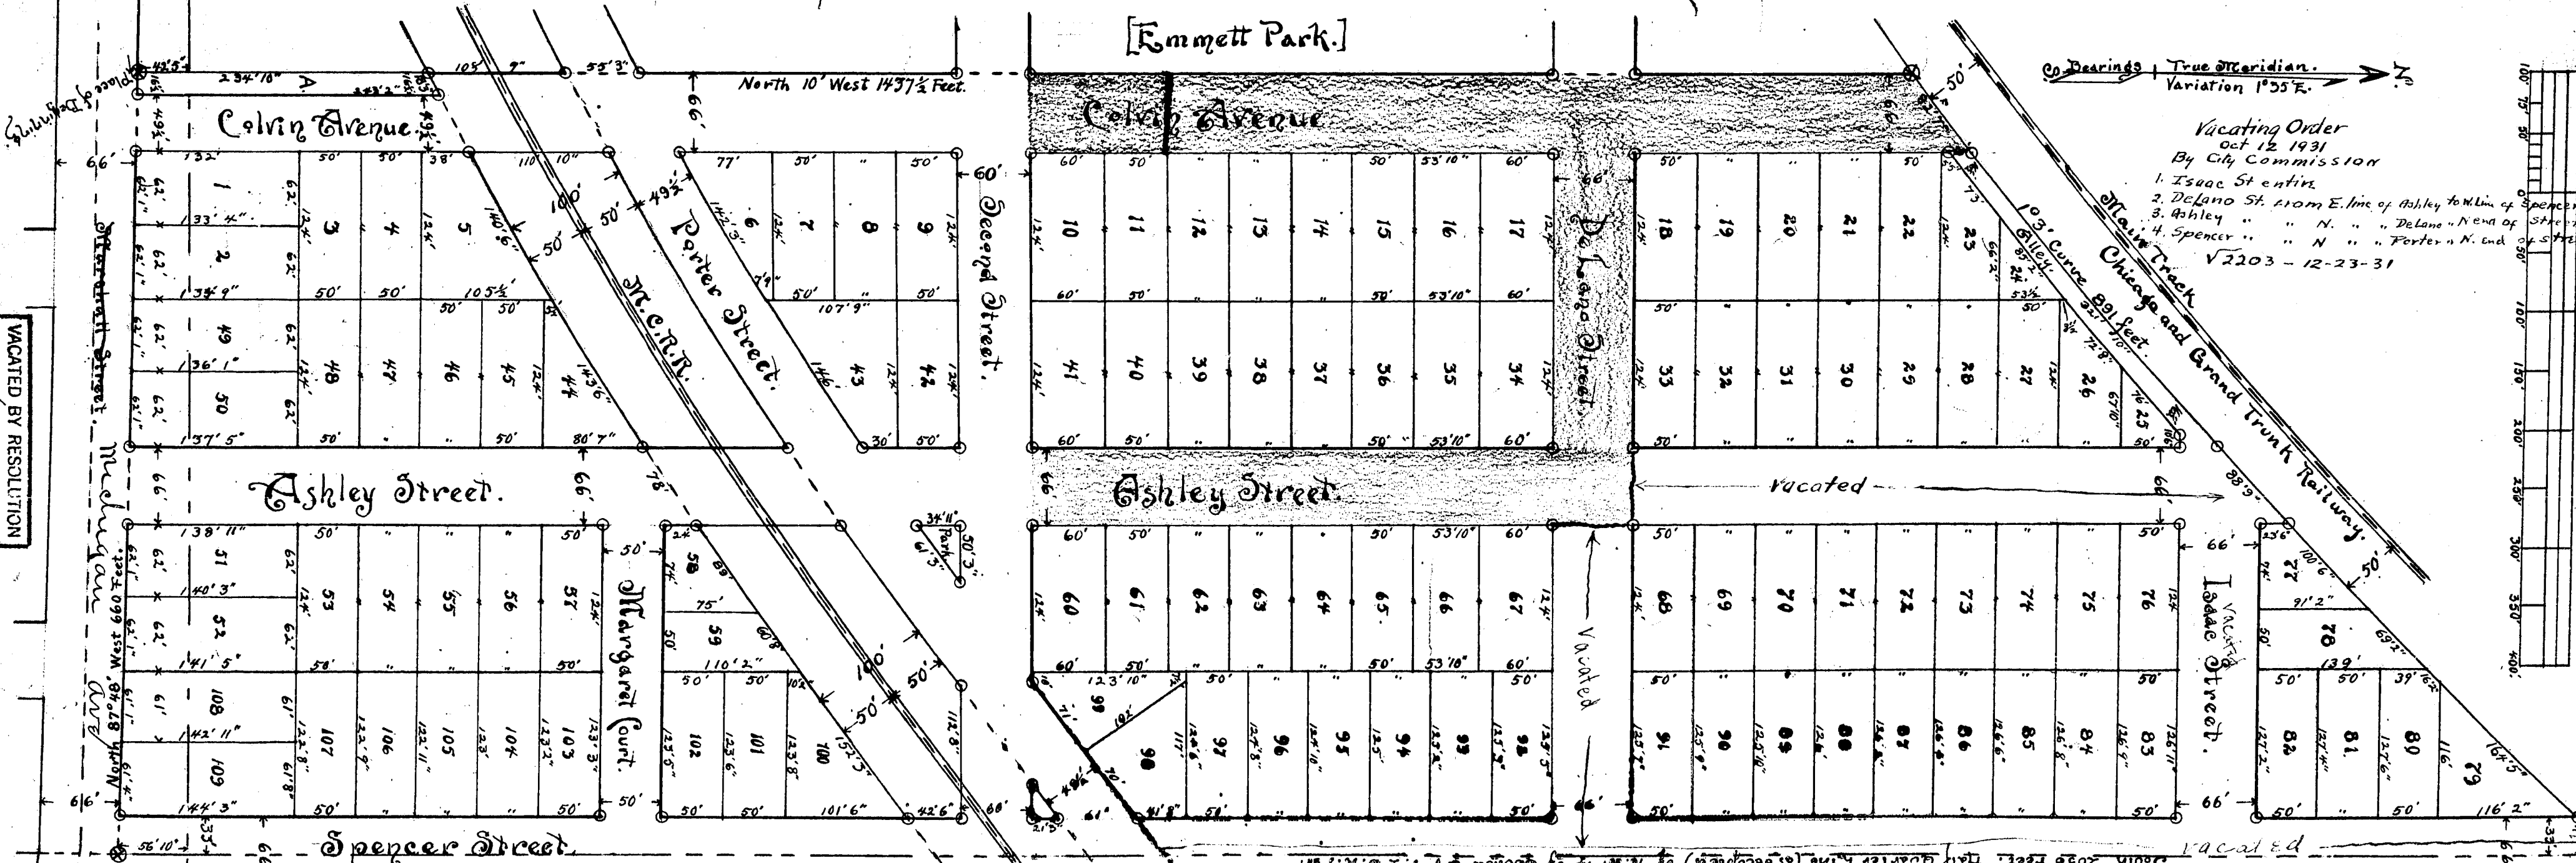

Scale, - 1 Inch = 100 Feet

tion of han

[illegible]

Half Quarter h.	13.6. 5. "	13.6. 5. "	13.6. 5. "
73	26	23	25
72	27	22	24
71	28	21	23

[illegible][illegible][illegible]








[illegible]

at Street. The
VACATED BY RESOLUTION
OF city council
12-13-1914
12-13-1914