


GRISWOLD'S ADDITION TO THE CITY OF JACKSON


On this third day of October A.D. 1873 before me James Crissy a notary Public in and for said county of Jackson personally came Philo R. Sabin, Caroline S. Sabin, Charles Abby, Henrietta Abby, Lorenzo D. Griswold and Minerva Griswold and J.S. Bird to me known to be the same persons described and who executed the accompanying instrument, and the said Philo R. Sabin, Caroline S. Sabin, Charles Abby, Henrietta Abby, Lorenzo D. Griswold and Minerva Griswold acknowledged that they executed the same as their own free act and deed, and the said J.S. Bird acknowledges the same to be his free act and deed for the uses and purposes of the act and acts of the Legislature of said State of Michigan in said accompanying instrument.

James Crissy
Notary Public.

DOUGLASS ST.											
2	4	6	8	10	12	14	16	18	20	22	24
7	3	5	7	9	11	13	15	17	19	21	23
11											
10											
GRISWOLD ST.											

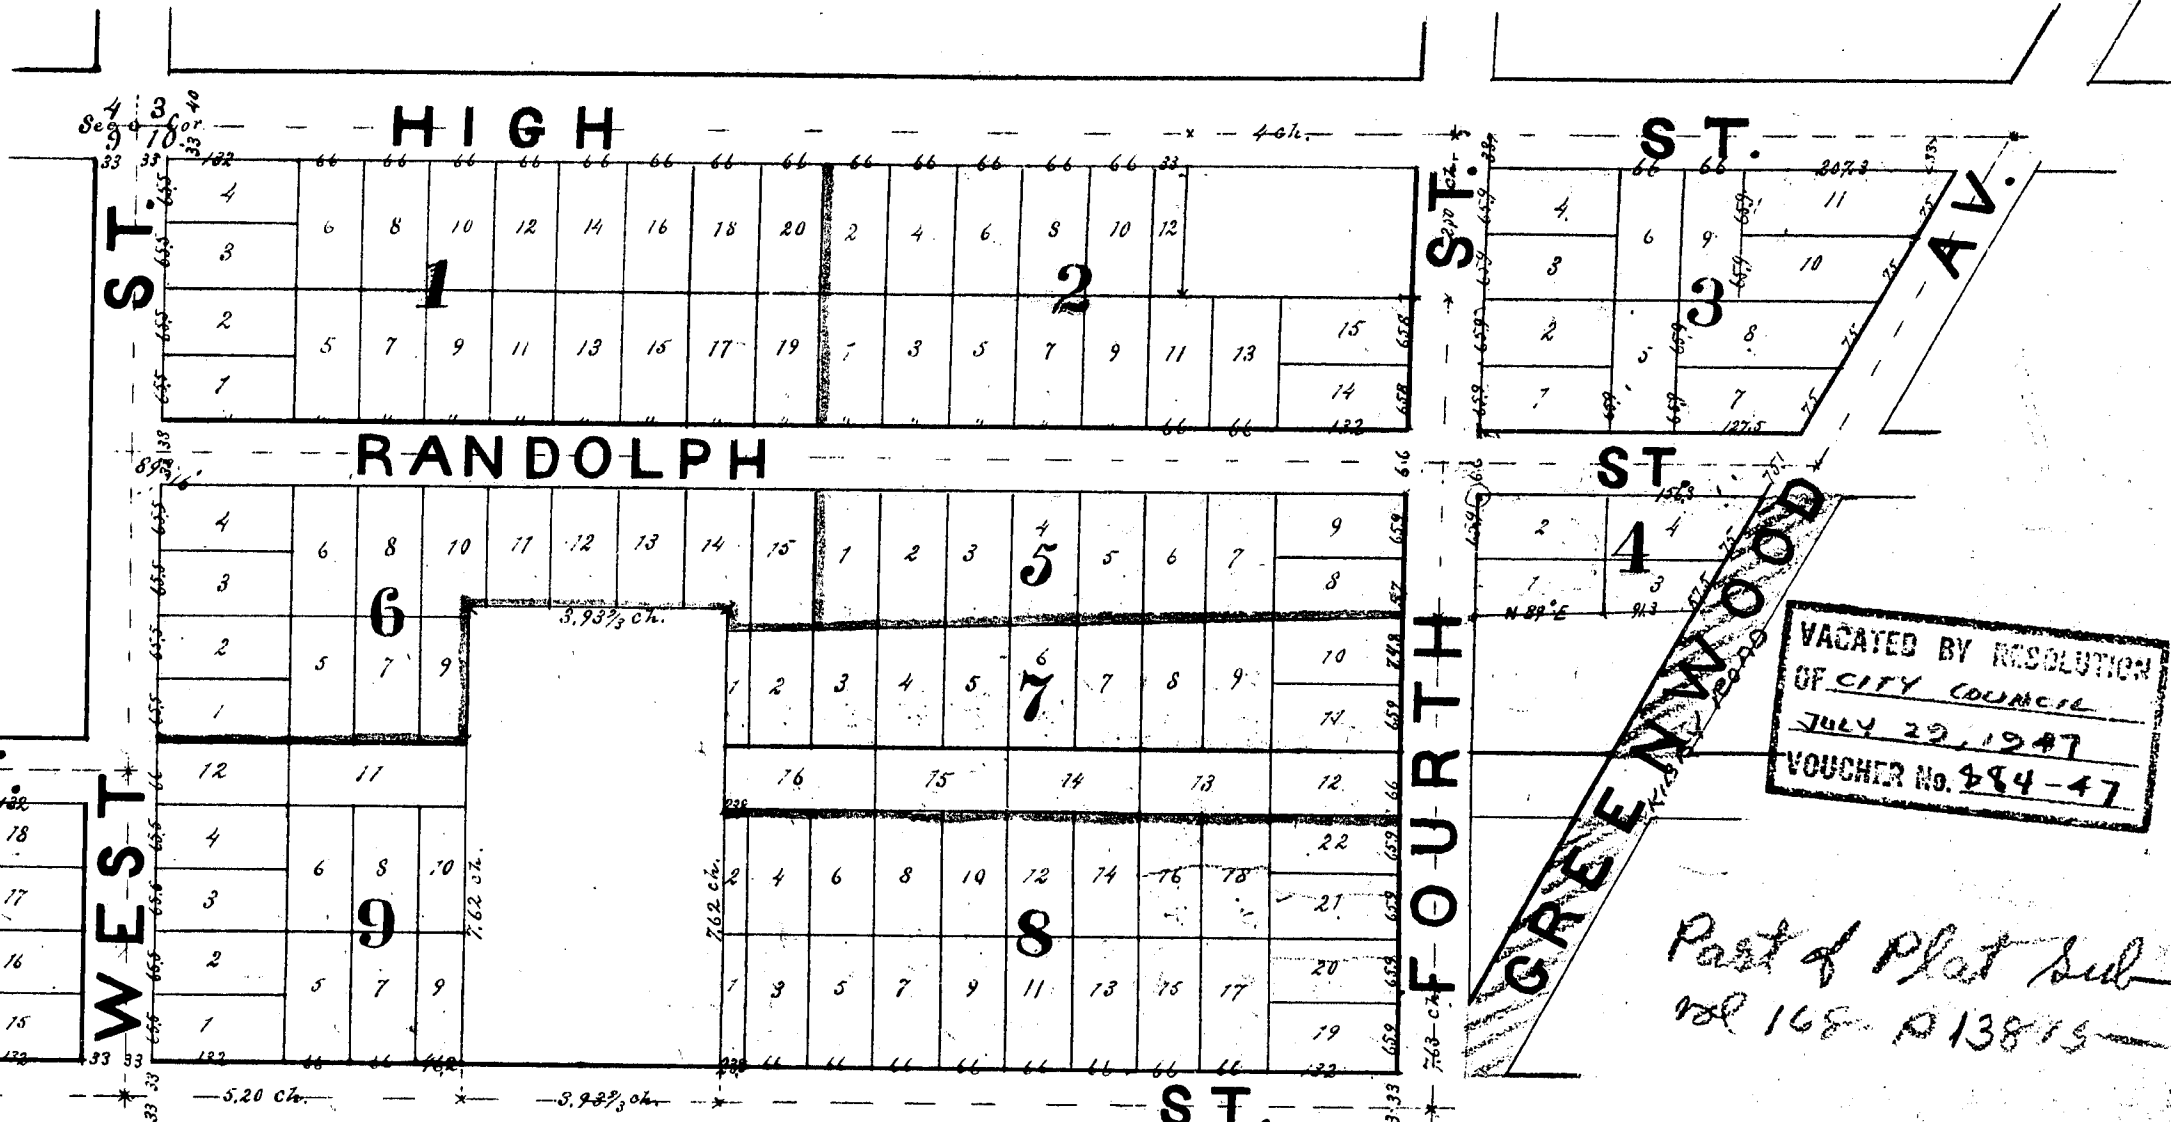

Know all men by these presents that we Philo R. Sabin, Caroline S. Sabin, Charles Abby, Henrietta Abby, Lorenzo D. Griswold and Minerva Griswold owners and proprietors have caused to be made by J.S. Bird a Civil Engineer in accordance with an act of the Legislature of the State of Michigan entitled an "act to provide for the recording of town plats and for vacating the same in certain cases and the acts amendatory thereof" the annexed true map and plat to be called and known as Griswold's Addition to the City of Jackson, which map or plat embraces all that parcel of land situated in the county of Jackson and State of Michigan and sections 9 and 10 of town 3 south Range 1 west, and in the city of Jackson aforesaid and particularly set forth and described as follows to wit: Commencing on the north line of Sec. 10 at the center of Spring Arbor Road now called Greenwood Avenue, thence west on the north line of said Sec. 10 to the N.W. cor. of the E. 1/2 of the N.W. 1/4 of sec 10, thence south ten rods, thence west 16 rods thence north 10 rods to the north line of sec 10, thence west along the north line of sec. 10 to the north N.W. cor. of sec. 10, thence south on the west line of sec. 10 to the N.E. cor. of the S. 3/4 of the E. 1/2 of the N.E. 1/4 of sec. 9, thence west along the north line of said S. 3/4 of the E. 1/2 of the N.E. 1/4 of sec 9 to the west line of the E. 1/2 of the N.E. 1/4 of sec. 9. thence south on the west line of the E. 1/2 of the N.E. 1/4 of sec. 9 to the east and west road on sec. 9 now called Griswold Street, thence east on the center line of said road or street to a point five chains and twenty links (5.20) east of the west line of sec 10, thence north parallel to the west line of sec. 10 seven chains and sixty two links (7.62), thence east three chains and ninety three and two thirds links (3.93 2/3), thence south seven chains and sixty two links (7.62) to the center of the above mentioned east and west road or Griswold Street, thence east on the center line of said road or street to the east line of the west 1/2 of the N.W. 1/4 of sec. 10, thence north on the east line of the west 1/2 of the N.W. 1/4 of sec. 10 seven chains and

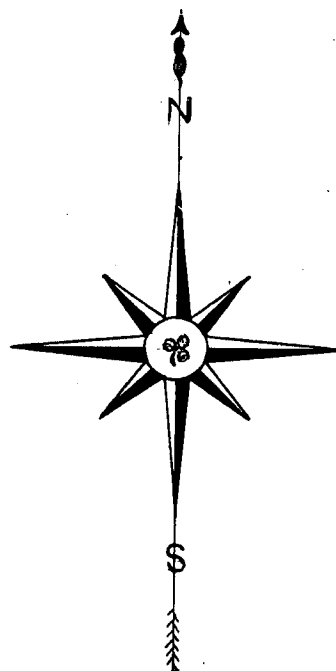

Received and filed in
Auditor General's Office
October 7-1873
Wm. H. H. H.

This Plat is now in the City of Jackson
sixty one links (6.6) thence N 89° E four chains and forty five links to the center of the Spring Arbor Road or Greenwood Avenue thence north 29° E along the center of said road to the place of beginning. Said plat is drawn to a scale of 200 feet to the inch. Large figures denote the number of the blocks, the small figures near the center of the lot the number of the lot and the small figures within the lines the size of the lots.

In witness whereof said Philo R. Sabin, Caroline S. Sabin, Charles Abby, Henrietta Abby, Lorenzo D. Griswold and Minerva Griswold have caused to be executed and have caused the same to be signed and sealed by the same J.S. Bird maker of said map and Plat, and Civil Engineer this third day of October A.D. 1873

Signed and sealed in presence of
James Crissy
W. H. H.


Philo R. Sabin
Caroline S. Sabin
Charles Abby
Henrietta Abby
Lorenzo D. Griswold
J.S. Bird

State of Michigan } ss
County of Jackson }
I, Harry Bush Register of the County of Jackson State of Michigan and J.S. Bird maker of the map or plat known as Griswold's Addition to the City of Jackson, do hereby certify that we have carefully compared the map and plat on this sheet with the original map and plat known as Griswold's Addition to the City of Jackson and we do also certify that the same is an exact duplicate of said original map and plat and of the whole of said map and plat, as the same appears by Record in Liber of Plats on page 2.
In witness whereof we have hereunto set our hands this fourth day of October A.D. 1873
Harry Bush Register of Deeds
J.S. Bird, Civil Engineer


GRISWOLD'S ADDITION TO THE CITY OF JACKSON

On this third day of October A.D. 1873 before me James Crissy a notary Public in and for said county of Jackson personally came Philo R. Sabin, Caroline S. Sabin, Charles Abby, Hennietta Abby, Lorenzo D. Griswold and Minerva Griswold and J.S. Bird to me known to be the same persons described and who executed the accompanying instrument, and the said Philo R. Sabin, Caroline S. Sabin, Charles Abby, Hennietta Abby, Lorenzo D. Griswold and Minerva Griswold acknowledged that they executed the same as their own free act and deed, and the said J.S. Bird acknowledges the same to be his free act and deed for the uses and purposes of the act and acts of the Legislature of said State of Michigan in said accompanying instrument. James Crissy Notary Public.

DOUGLASS ST.										ST.									
GRISWOLD										ST.									

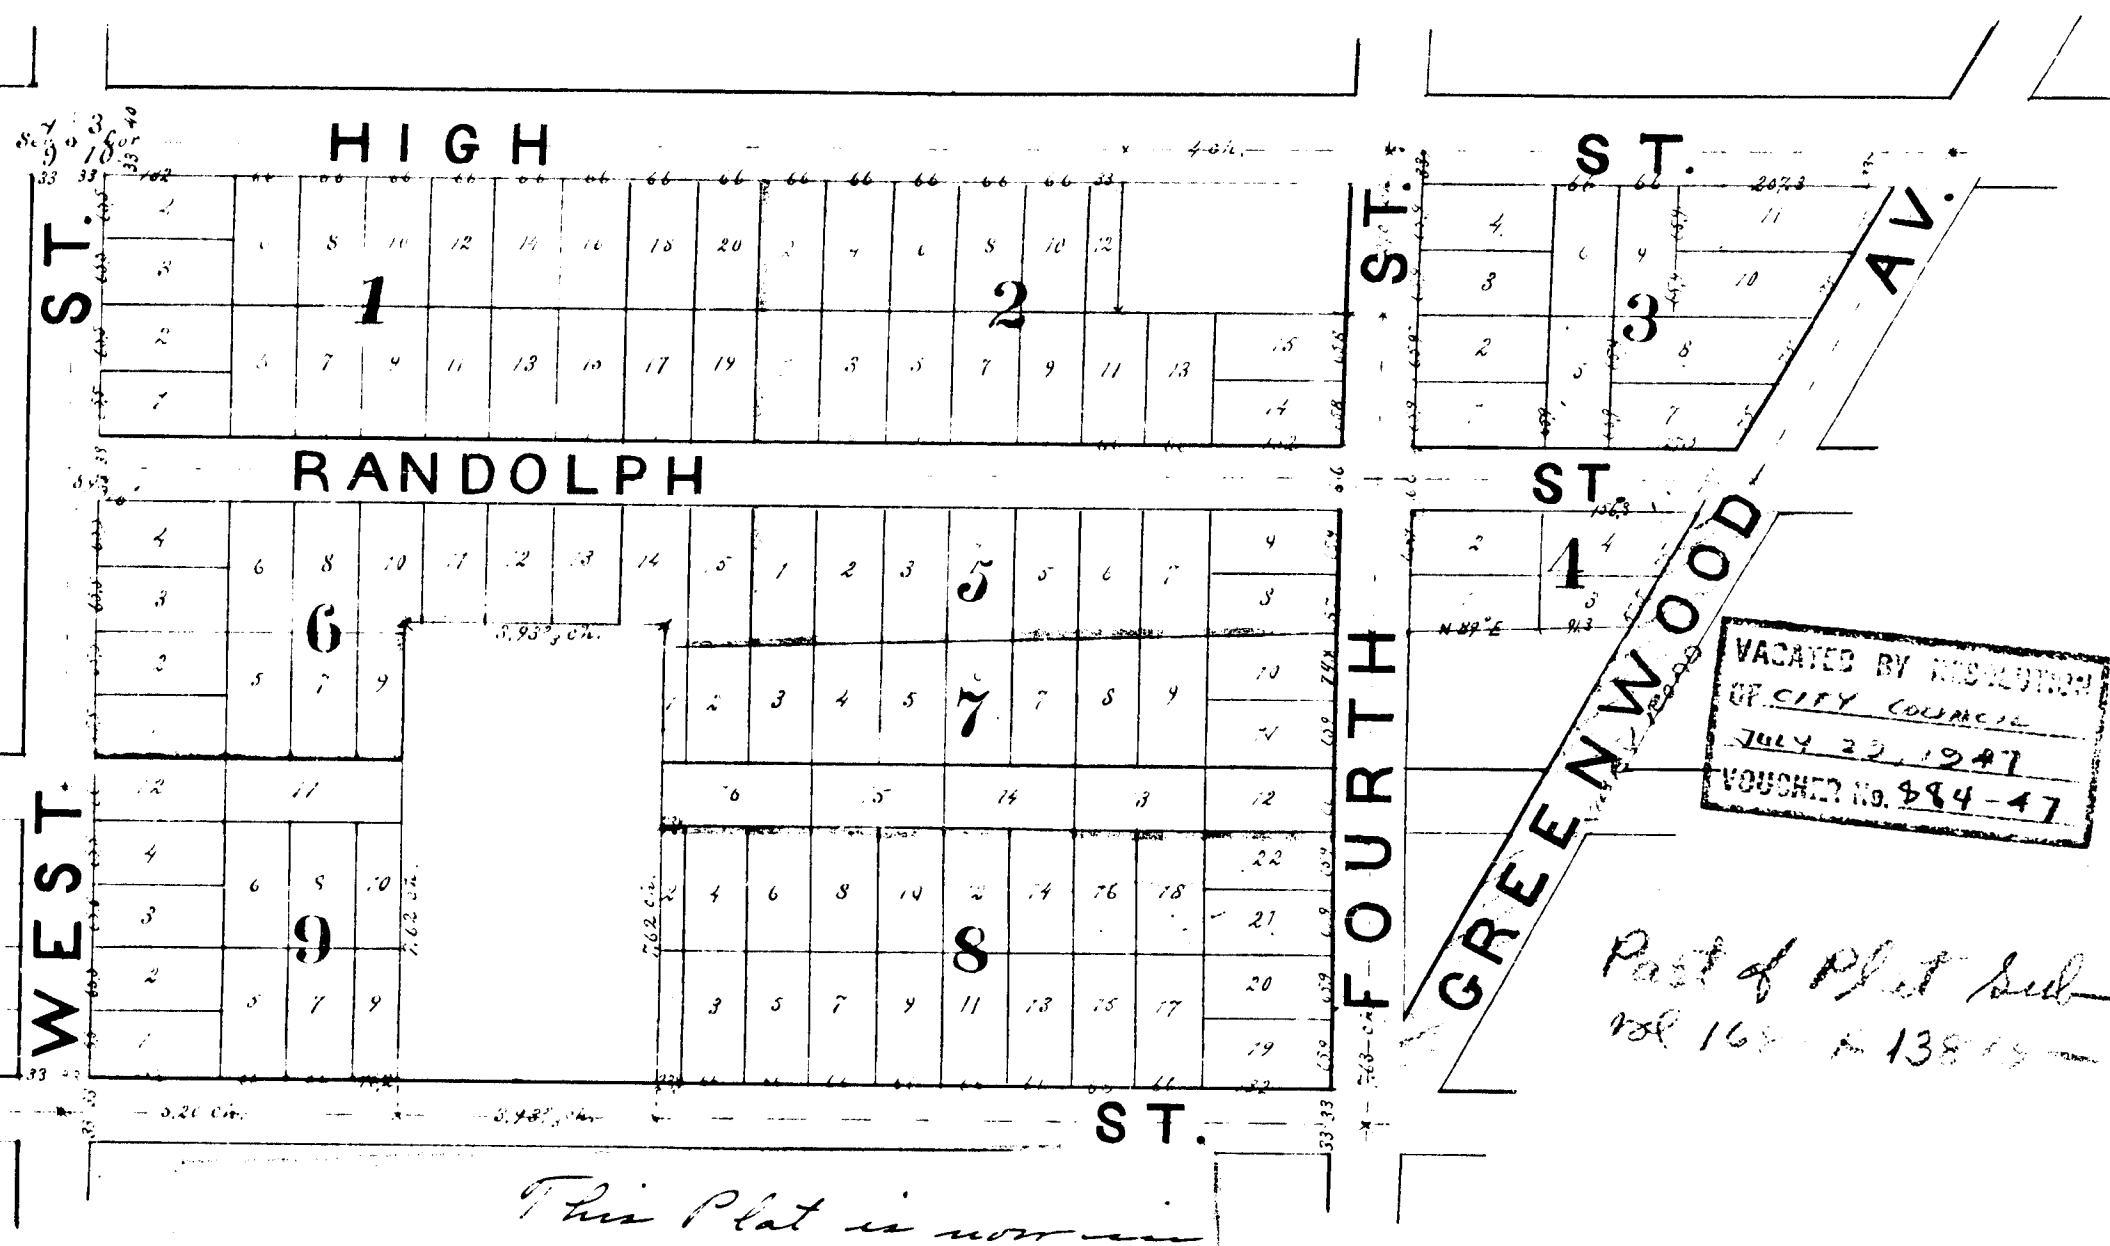

Know all men by these presents that we Philo R. Sabin, Caroline S. Sabin, Charles Abby, Hennietta Abby, Lorenzo D. Griswold and Minerva Griswold owners and proposers have caused to be made by J.S. Bird, a Civil Engineer in accordance with an act of the Legislature of the State of Michigan entitled an act to provide for the recording of town plats and for vacating the same in certain cases and the acts amendatory thereto, the annexed true map and plat to be called and known as Griswold's Addition to the City of Jackson, which map or plat embraces all that parcel of land situated in the county of Jackson and State of Michigan and sections 9 and 10 of town 3 south Range 1 west, and in the city of Jackson aforesaid and particularly set forth and described as follows to wit: Commencing on the north line of Sec. 10 at the center of Spring Arbor Road now called Greenwood Avenue, thence west on the north line of said Sec. 10 to the N.W. cor. of the E. 1/2 of the N.W. 1/4 of sec 10, thence south ten rods, thence west 16 rods thence north 10 rods to the north line of sec 10, thence west along the north line of sec. 10 to the north N.W. cor. of sec. 10, thence south on the west line of sec. 10 to the N.E. cor. of the S. 3/4 of the E. 1/2 of the N.E. 1/4 of sec. 9, thence west along the north line of said S. 3/4 of the E. 1/2 of the N.E. 1/4 of sec 9 to the west line of the E. 1/2 of the N.E. 1/4 of sec. 9. Thence south on the west line of the E. 1/2 of the N.E. 1/4 of sec. 9 to the east and west road on sec. 9 now called Griswold Street, thence east on the center line of said road or street to a point five chains and twenty links (520) east of the west line of sec 10, thence north parallel to the west line of sec. 10 seven chains and sixty two links (762), thence east three chains and ninety three and two thirds links (393 2/3), thence south seven chains and sixty two links (762) to the center of the above mentioned east and west road or Griswold Street, thence east on the center line of said road or street to the east line of the West 1/2 of the N.W. 1/4 of sec. 10, thence north on the east line of the west 1/2 of the N.W. 1/4 of sec. 10 seven chains and

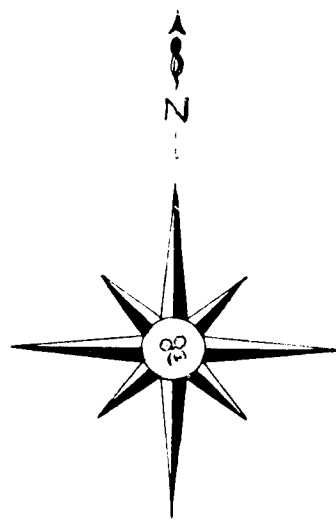

Received and filed in
Recorder's Office
October 7-1873
J.S. Bird

sixty three links (763) thence N 89° E four chains and forty five links to the center of the Spring Arbor Road or Greenwood Avenue thence north 29° E along the center of said road to the place of beginning. Said plat is drawn to a scale of 200 feet to the inch. Large figures denote the number of the blocks, the small figures near the center of the lot the number of the lot and the small figures on the lines the size of the lots.

In witness whereof said Philo R. Sabin, Caroline S. Sabin, Charles Abby, Hennietta Abby, Lorenzo D. Griswold and Minerva Griswold have caused to be executed and have caused the same to be signed and sealed by the same J.S. Bird maker of said map and Plat, and Civil Engineer this third day of October A.D. 1873

Signed and sealed in presence of
James Crissy
Philo R. Sabin
Caroline S. Sabin
Charles Abby
Hennietta Abby
Lorenzo D. Griswold
Minerva Griswold
J.S. Bird

State of Michigan } ss
County of Jackson }
I, Harry Bush Register of the County of Jackson State of Michigan and J.S. Bird maker of the map or plat known as Griswold's Addition to the City of Jackson, do hereby certify that we have carefully compared the map and plat on this sheet with the original map and plat known as Griswold's Addition to the City of Jackson and we do also certify that the same is an exact duplicate of said original map and plat and of the whole of said map and plat, as the same appears of record in Liber of Plats on page 2.
In witness whereof we have hereunto set our hands this fourth day of October A.D. 1873
Harry Bush Register of Deeds
J.S. Bird, Civil Engineer