



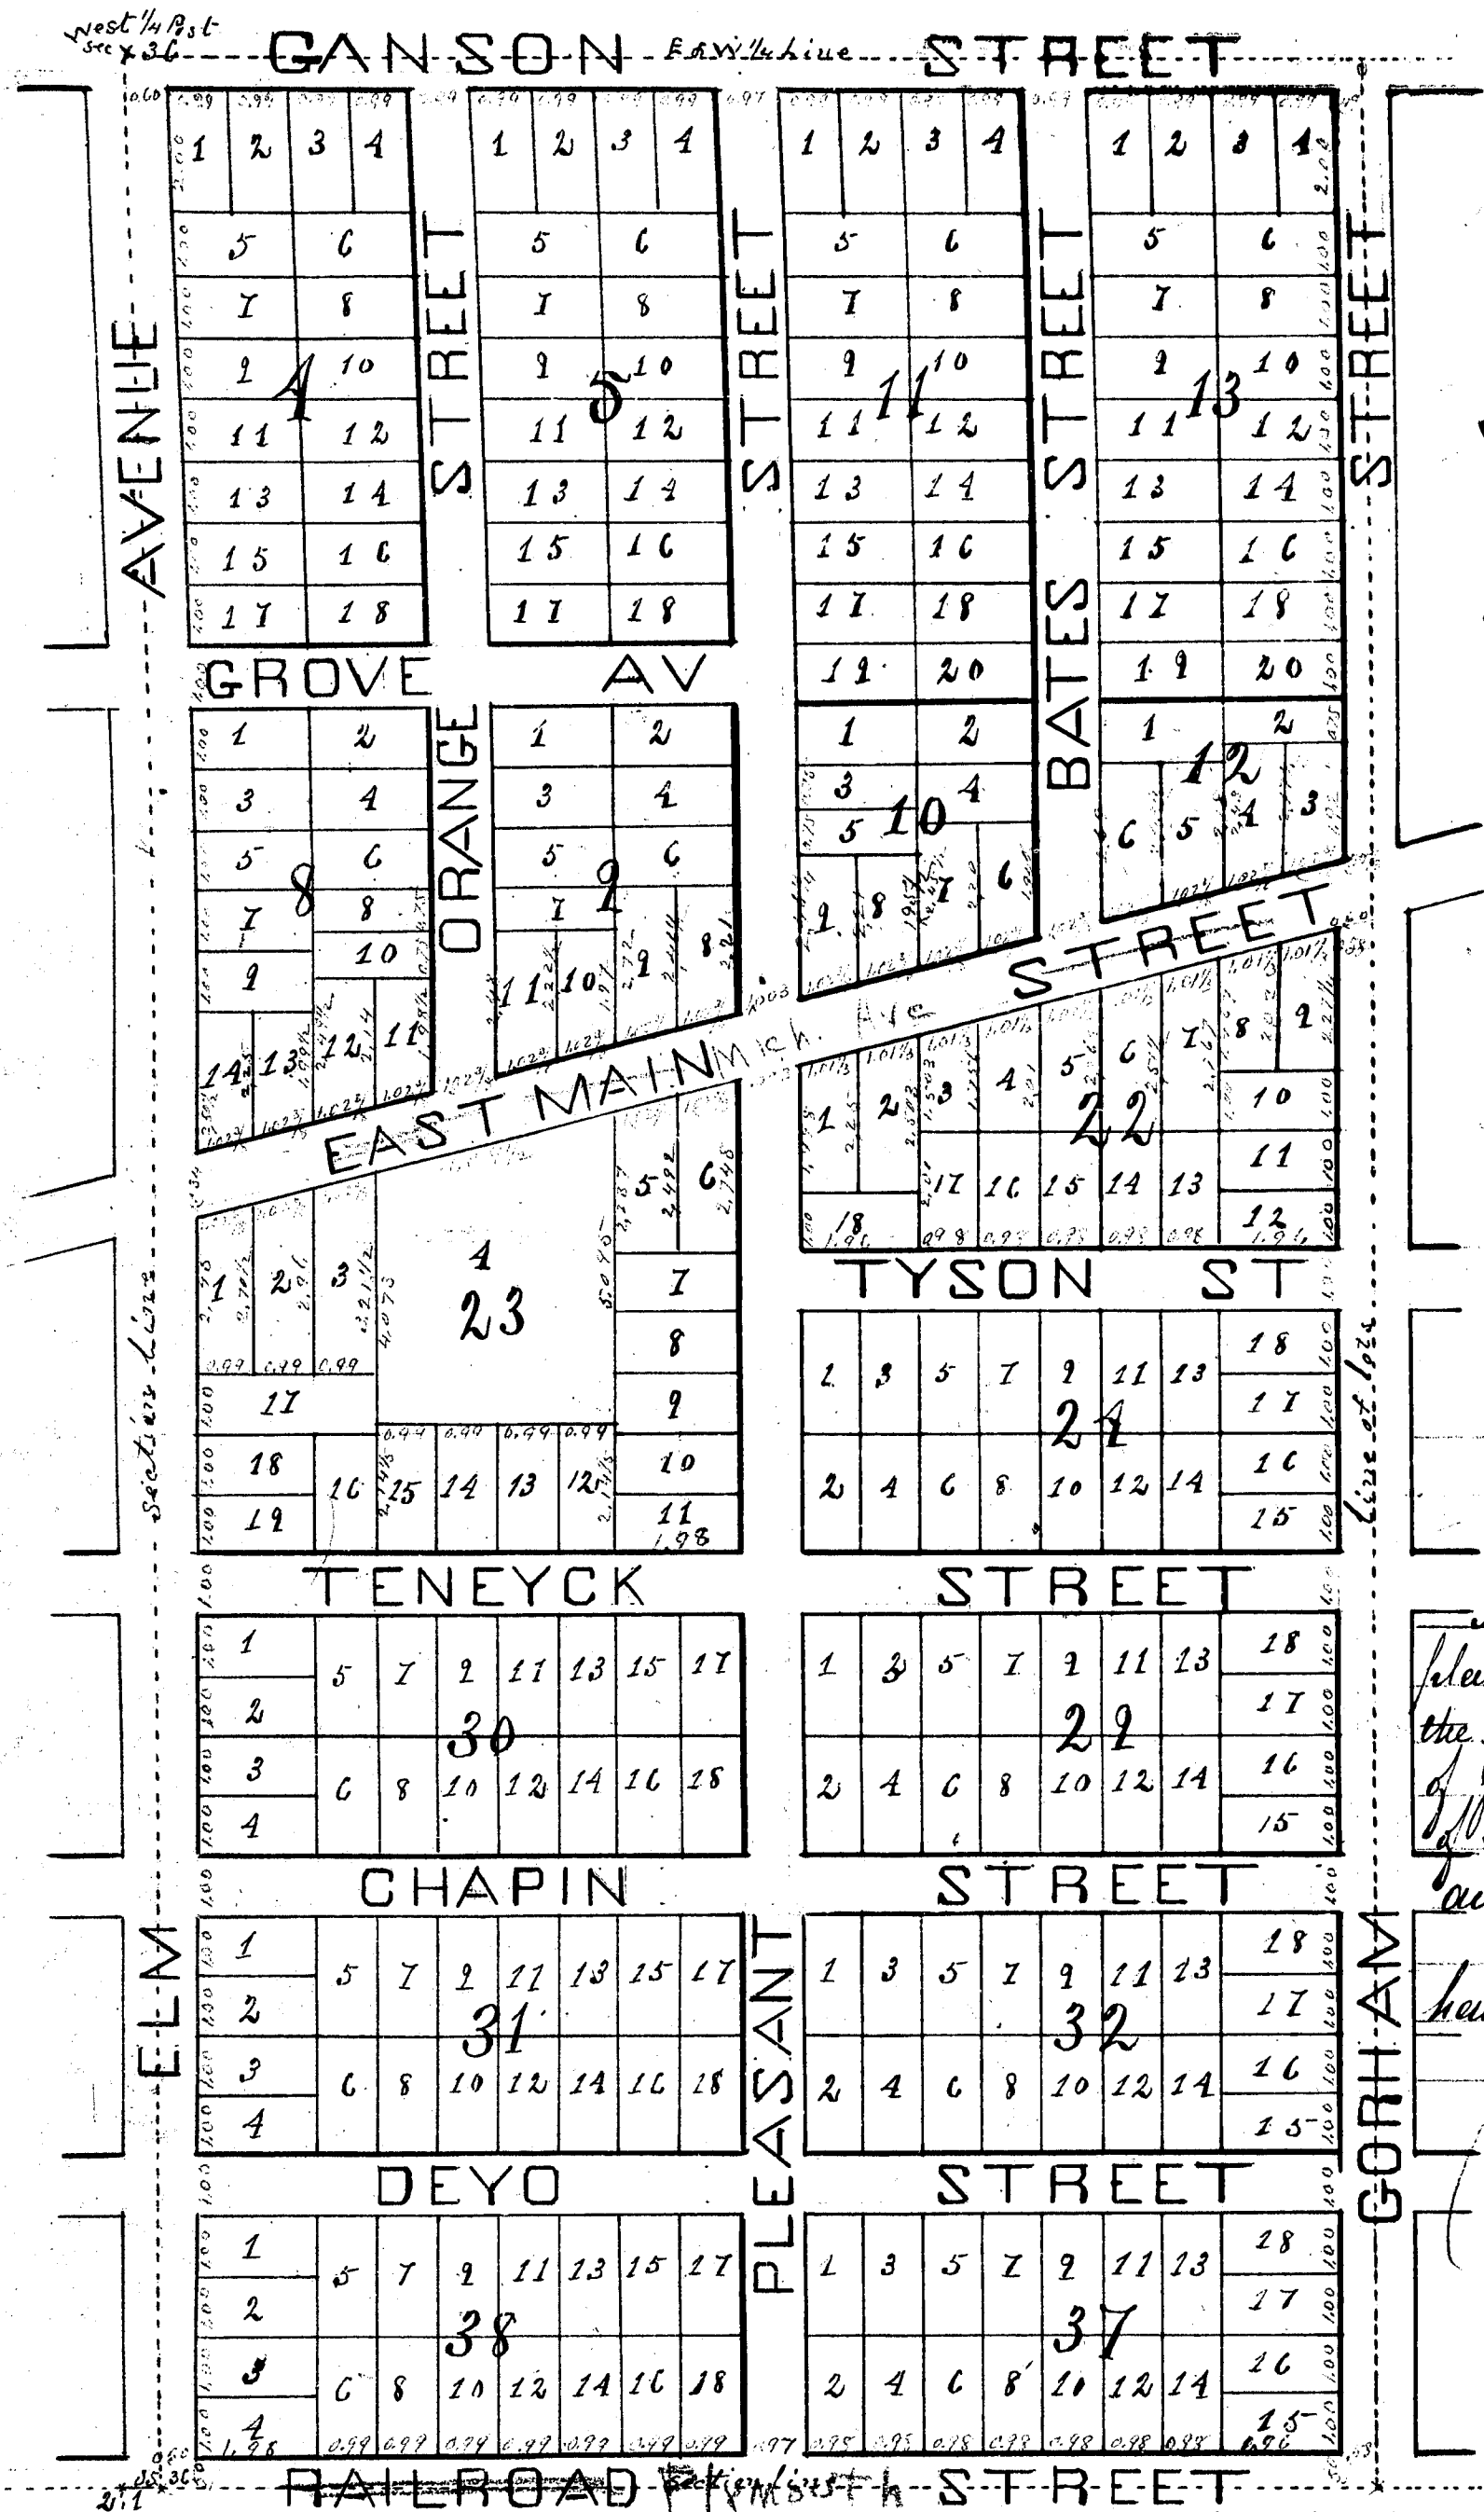

EAST ADDITION TO THE CITY OF JACKSON

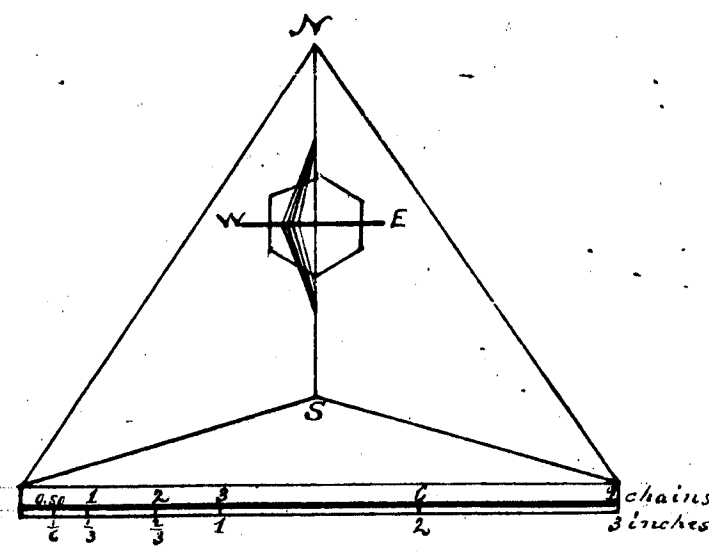

EAST MAIN STREET changed to
MICHIGAN AVENUE. JANUARY 29 - 1924
VOW 13-1925

State of Michigan } ss
County of Jackson }

We Harry Bush Register of Deeds and
Merritt S. Cook the Surveyor who made the annexed
plat hereby certify that we have carefully compared
the same with the plat of East Addition to the City
of Jackson now of Record in the office of said Register
of Deeds and that it is a true transcript therefrom
and of the whole of such original.
In Witness Whereof we have hereunto set our
hands and seals this 3rd day of July 1874

Harvey Bush, Register of Deeds
Merritt S. Cook Surveyor

State of Michigan } ss
County of Jackson }

On this the 3^d day of July A.D. 1874, before me a Notary public, in and for the said
County of Jackson, personally appeared the following named persons, to wit: Hiram H. Smith, Harriet B. Smith,
Peter B. Loomis, Charles E. Webb, Elizabeth S. Webb, Walter B. Webb, Julia A. Webb, Barnabas S. Chapin, Charissa
A. Chapin, and Merritt S. Cook, all of whom are known by me to be the persons who executed the foregoing
instrument, and acknowledged the same to be their free act and deed.

J. W. Chapin Notary Public

Know all Men by these presents, that Hiram H. Smith and Harriet B. Smith
his wife, Peter B. Loomis, Charles E. Webb and Elizabeth S. Webb, his wife,
Walter B. Webb and Julia A. Webb, his wife, Barnabas S. Chapin and Charissa
A. Chapin, his wife, all of the City and County of Jackson, State of Michigan,
proprietors of the lands hereinafter described, have caused Merritt S. Cook,
a Surveyor, in accordance with law, to make the annexed true Map,
and plat, to be called and known as the "East Addition to the City
of Jackson," which map or plat embraces the following piece or
parcel of land, situated in the aforesaid County of Jackson.

To wit:
The west half of the South west quarter of section number
thirty six, Town two, South of Range one west.

Said Map is laid out on a scale of three chains to
the inch. The numbers of each block respectively are indicated by
large figures near the center thereof. Likewise the numbers
of each lot are indicated by small figures in dark ink, near the
center of the same. All distances, width of streets, and size of
lots are indicated by small figures in red ink, representing
chains or fractions thereof. All streets laid out on said Map
or plat, are hereby dedicated to the public, to be used only as public
highways.

In Witness whereof, we hereby set our hands and seals,
and have caused the same to be signed and sealed, by the said
Merritt S. Cook, on this the 3^d day of July A.D. 1874.

Witness J. W. Chapin
Sylvester B. Gorham
J. W. Chapin
W. A. Wetmore
Nathan H. Williams
J. W. Chapin
Hettie M. Morrison
J. W. Chapin
J. W. Chapin
H. E. Chapin


H. H. Smith } ss
Harriet B. Smith } ss
P. B. Loomis } ss
C. E. Webb } ss
Elizabeth S. Webb } ss
Walter B. Webb } ss
Julia A. Webb } ss
Barnabas S. Chapin } ss
Charissa A. Chapin } ss
Merritt S. Cook } ss

Received and filed in Auditor
General's Office January 25 - 1875
H. R. Pratt
Sp. and Land


NOTARY PUBLIC
J. W. Chapin
VOUCHER NO. 520-54

13782

266

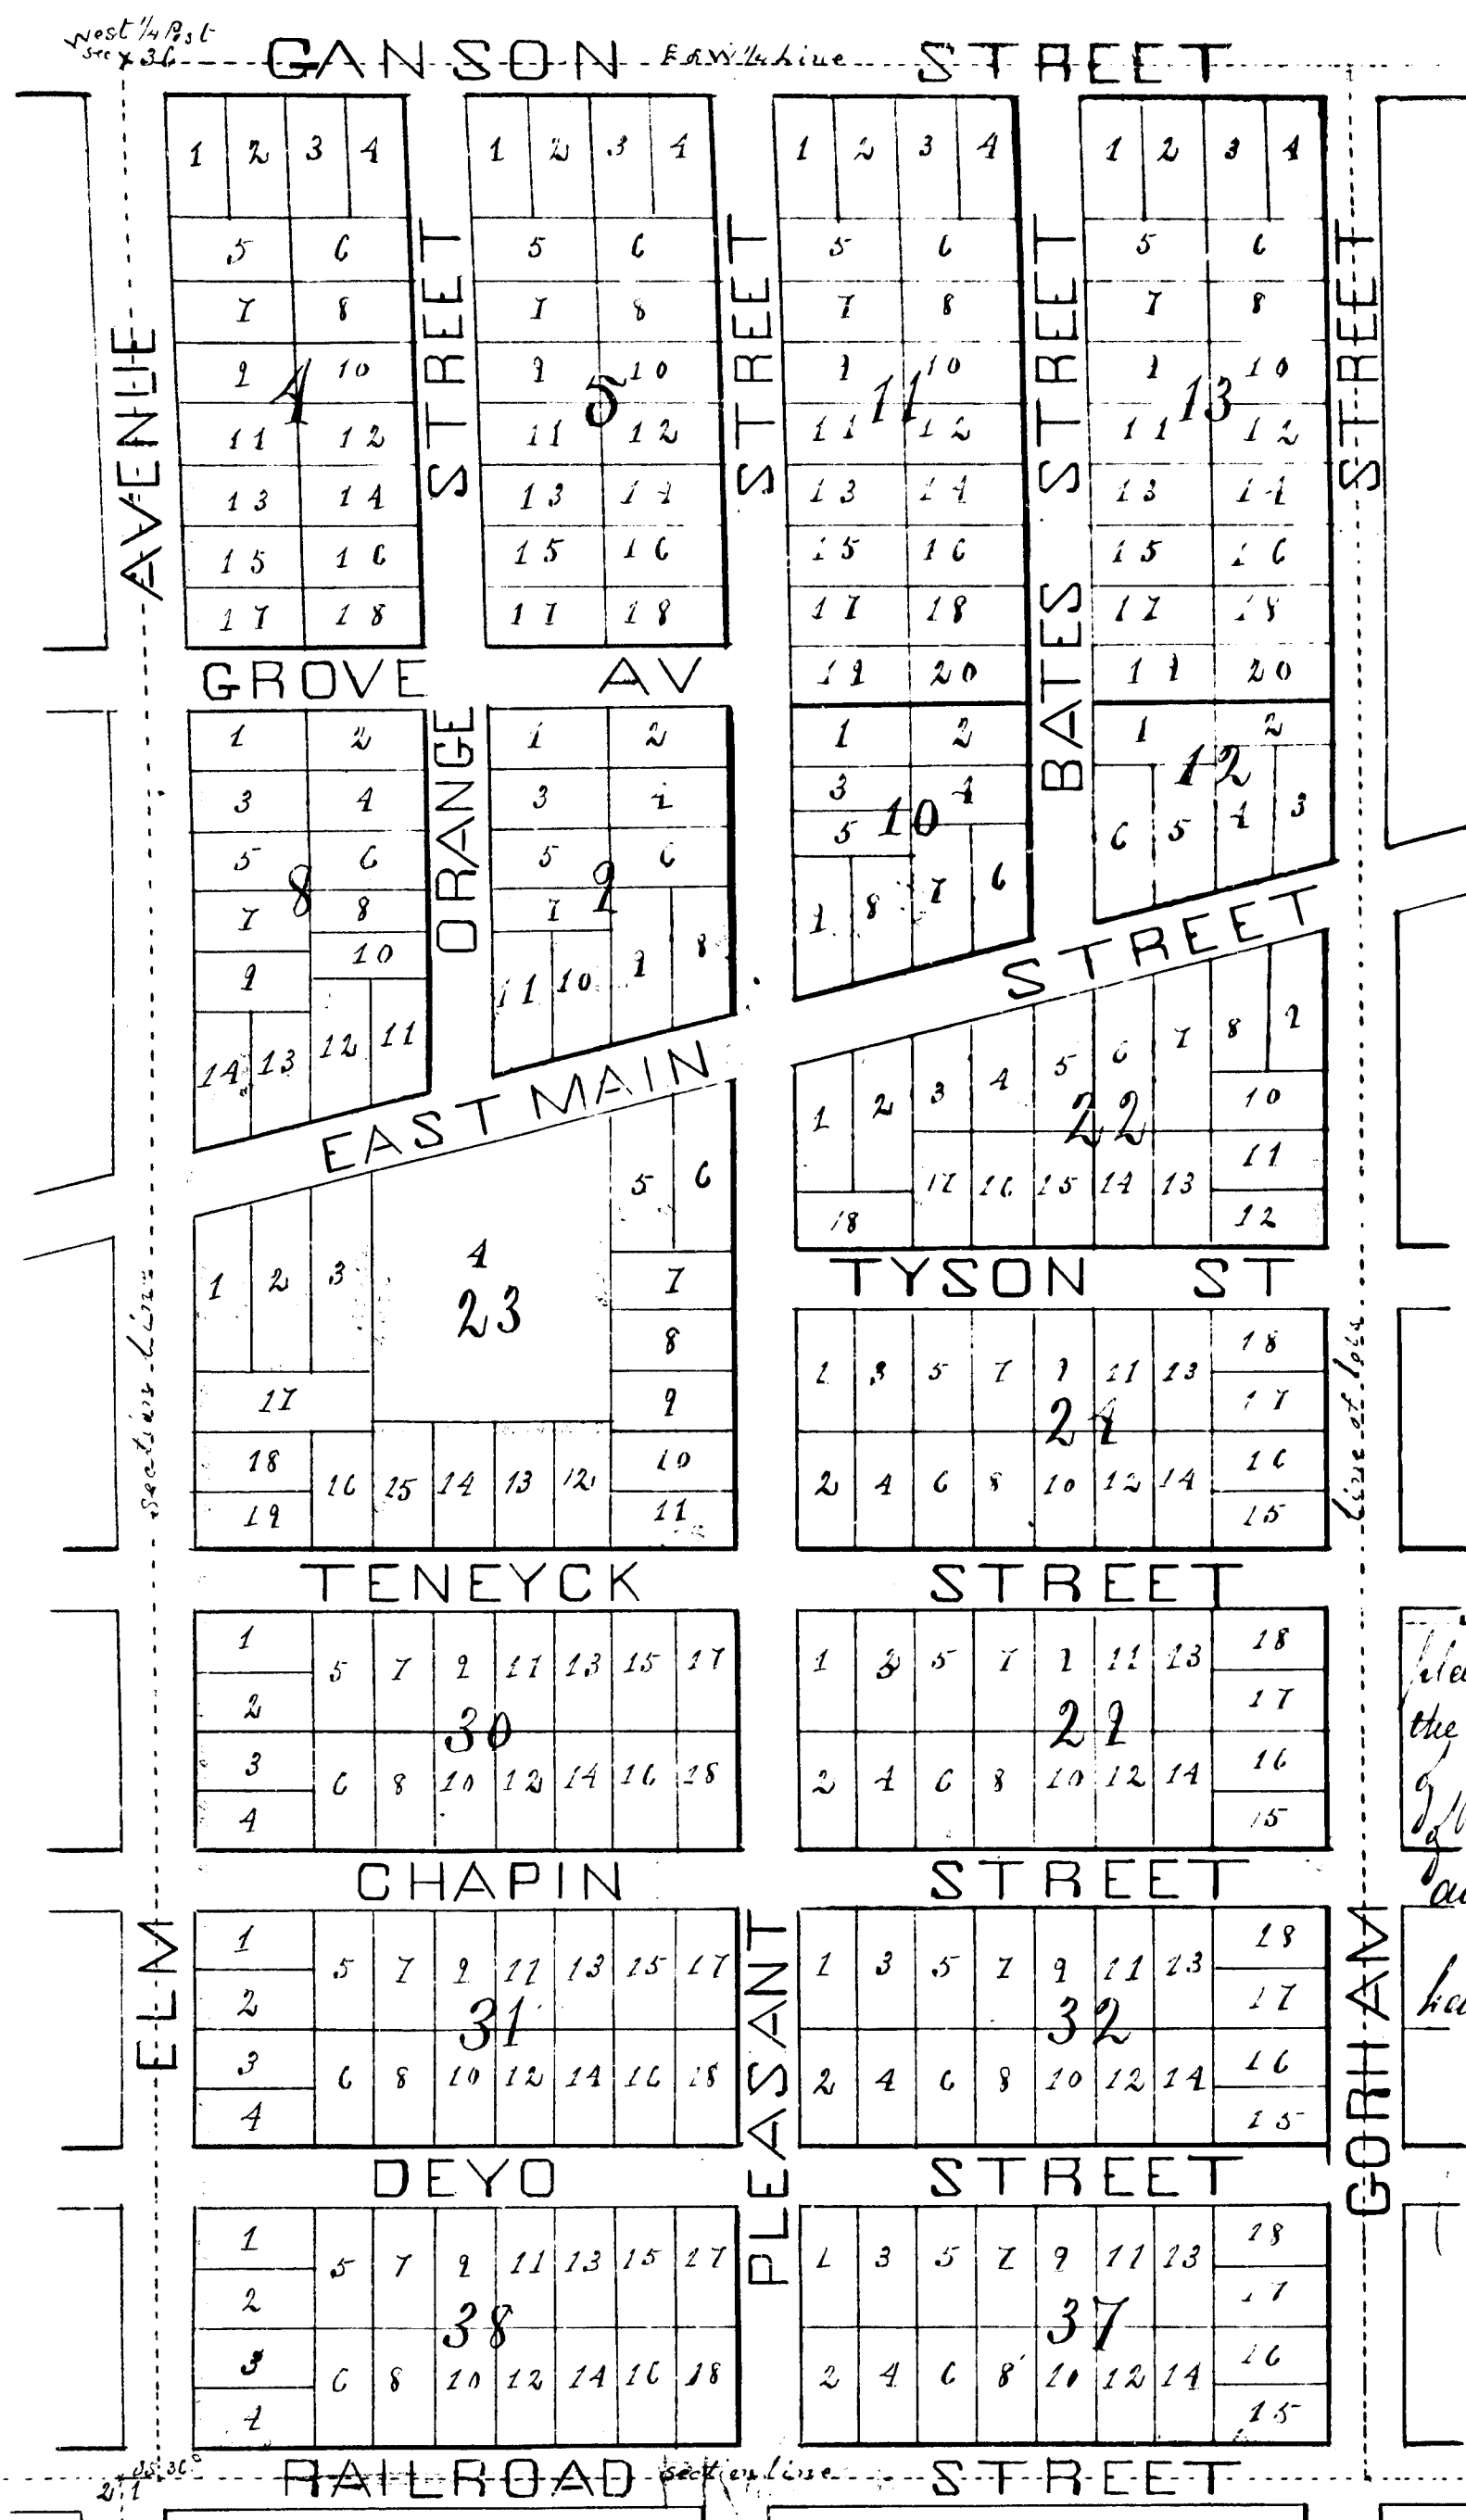

EAST ADDITION TO THE CITY OF JACKSON

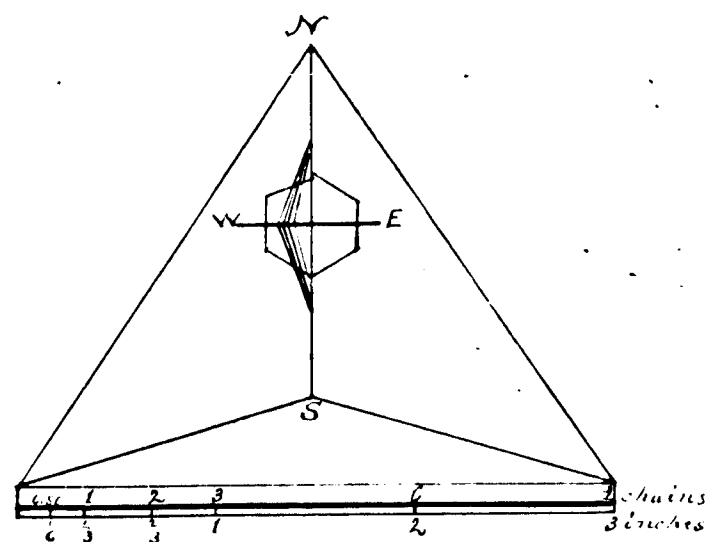

EAST MAIN STREET changed to
MICHIGAN AVENUE. June 19 1874
Ord 73-17-5

State of Michigan } ss
County of Jackson }
We Harry Bush Register of Deeds and
Merritt S. Cook Surveyor who made the annexed
plat hereby certify that we have carefully compared
the same with the plat of East Addition to the City
of Jackson now of Record in the office of said Register
of Deeds and that it is a true transcript therefrom
and of the whole of such original.

In Witness Whereof we have hereunto set our
hands and seals this 3rd day of July 1874

Harry Bush Register of Deeds
Merritt S. Cook Surveyor

State of Michigan } ss
County of Jackson }

On this the 3rd day of July A.D. 1874. Before me a Notary public, in and for the said
County of Jackson, personally appeared the following named persons, to wit: Hiram H. Smith, Harriet B. Smith,
Peter B. Louis, Charles E. Webb, Elizabeth J. Webb, Walter B. Webb, Julia A. Webb, Barnabas S. Chapin, Clarissa
A. Chapin, and Merritt S. Cook, all of whom are known by me to be the persons who executed the foregoing
instrument, and acknowledged the same to be their free act and deed.

J. W. Chapin Notary Public

Know all men by these presents, that Hiram H. Smith and Harriet B. Smith
his wife, Peter B. Louis, Charles E. Webb and Elizabeth J. Webb, his wife,
Walter B. Webb and Julia A. Webb his wife, Barnabas S. Chapin and Clarissa
A. Chapin, his wife, all of the City and County of Jackson, State of Michigan,
proprietors of the lands hereinafter described, have caused Merritt S. Cook,
a Surveyor, in accordance with law, to make the annexed true Map
and Plat, to be called and known as the "East Addition to the City
of Jackson," which map or plat embraces the following piece or
parcel of land, situated in the aforesaid County of Jackson.

To wit:
The west half of the South west quarter of section number
Thirty Six, Town two South, of Range one West.
Said Map is laid out on a scale of three chains to
the inch. The numbers of each block respectively are indicated by
large figures near the center thereof. Likewise the numbers
of each lot are indicated by small figures in dark ink, near the
center of the same. All distances, width of streets, and size of
lots are indicated by small figures in red ink, representing
chains or fractions thereof. All streets laid out on said Map
or plat, are hereby dedicated to the public, to be used only as public
highways.

In Witness whereof, we hereby set our hands and seals
and have caused the same to be signed and sealed by the said
Merritt S. Cook, on this the 3rd day of July A.D. 1874.

Witness J. W. Chapin
Hymour B. Gorham
J. W. Chapin
W. R. Wetmore
Nathan H. Williams
J. W. Chapin
Nottie M. Morrison
J. W. Chapin
J. W. Chapin
H. C. Chapin

H. H. Smith } L. S.
Harriet B. Smith } L. S.
P. B. Louis } L. S.
C. E. Webb } L. S.
Elizabeth J. Webb } L. S.
Walter B. Webb } L. S.
Julia A. Webb } L. S.
Barnabas S. Chapin } L. S.
Clarissa A. Chapin } L. S.
Merritt S. Cook } L. S.

Received and filed in Auditor
General's Office January 2. 1875
H. R. Pratt
S. Land

RECEIVED
JAN 2 1875
AUDITOR GENERAL