


Received for Record the 29th day of June
AD 1889 at 10 O'clock A.M. and Recorded
in Liber 44 of Plats on Page 8.
C. E. Townsend
Register of Deeds.

ORDER OF VACATION
That part of Chapin Street
from Horton St. to E. City
limits, vacated by City
Commission Jan'y 13-1928
Voucher 27-1930

MAP OF
EAST ADDITION
NUMBER FIVE
TO THE CITY OF
JACKSON
MICHIGAN.

RECEIVED AND FILED
IN AUDITOR GENERAL'S OFFICE
April 14 1891
Deputy Auditor General

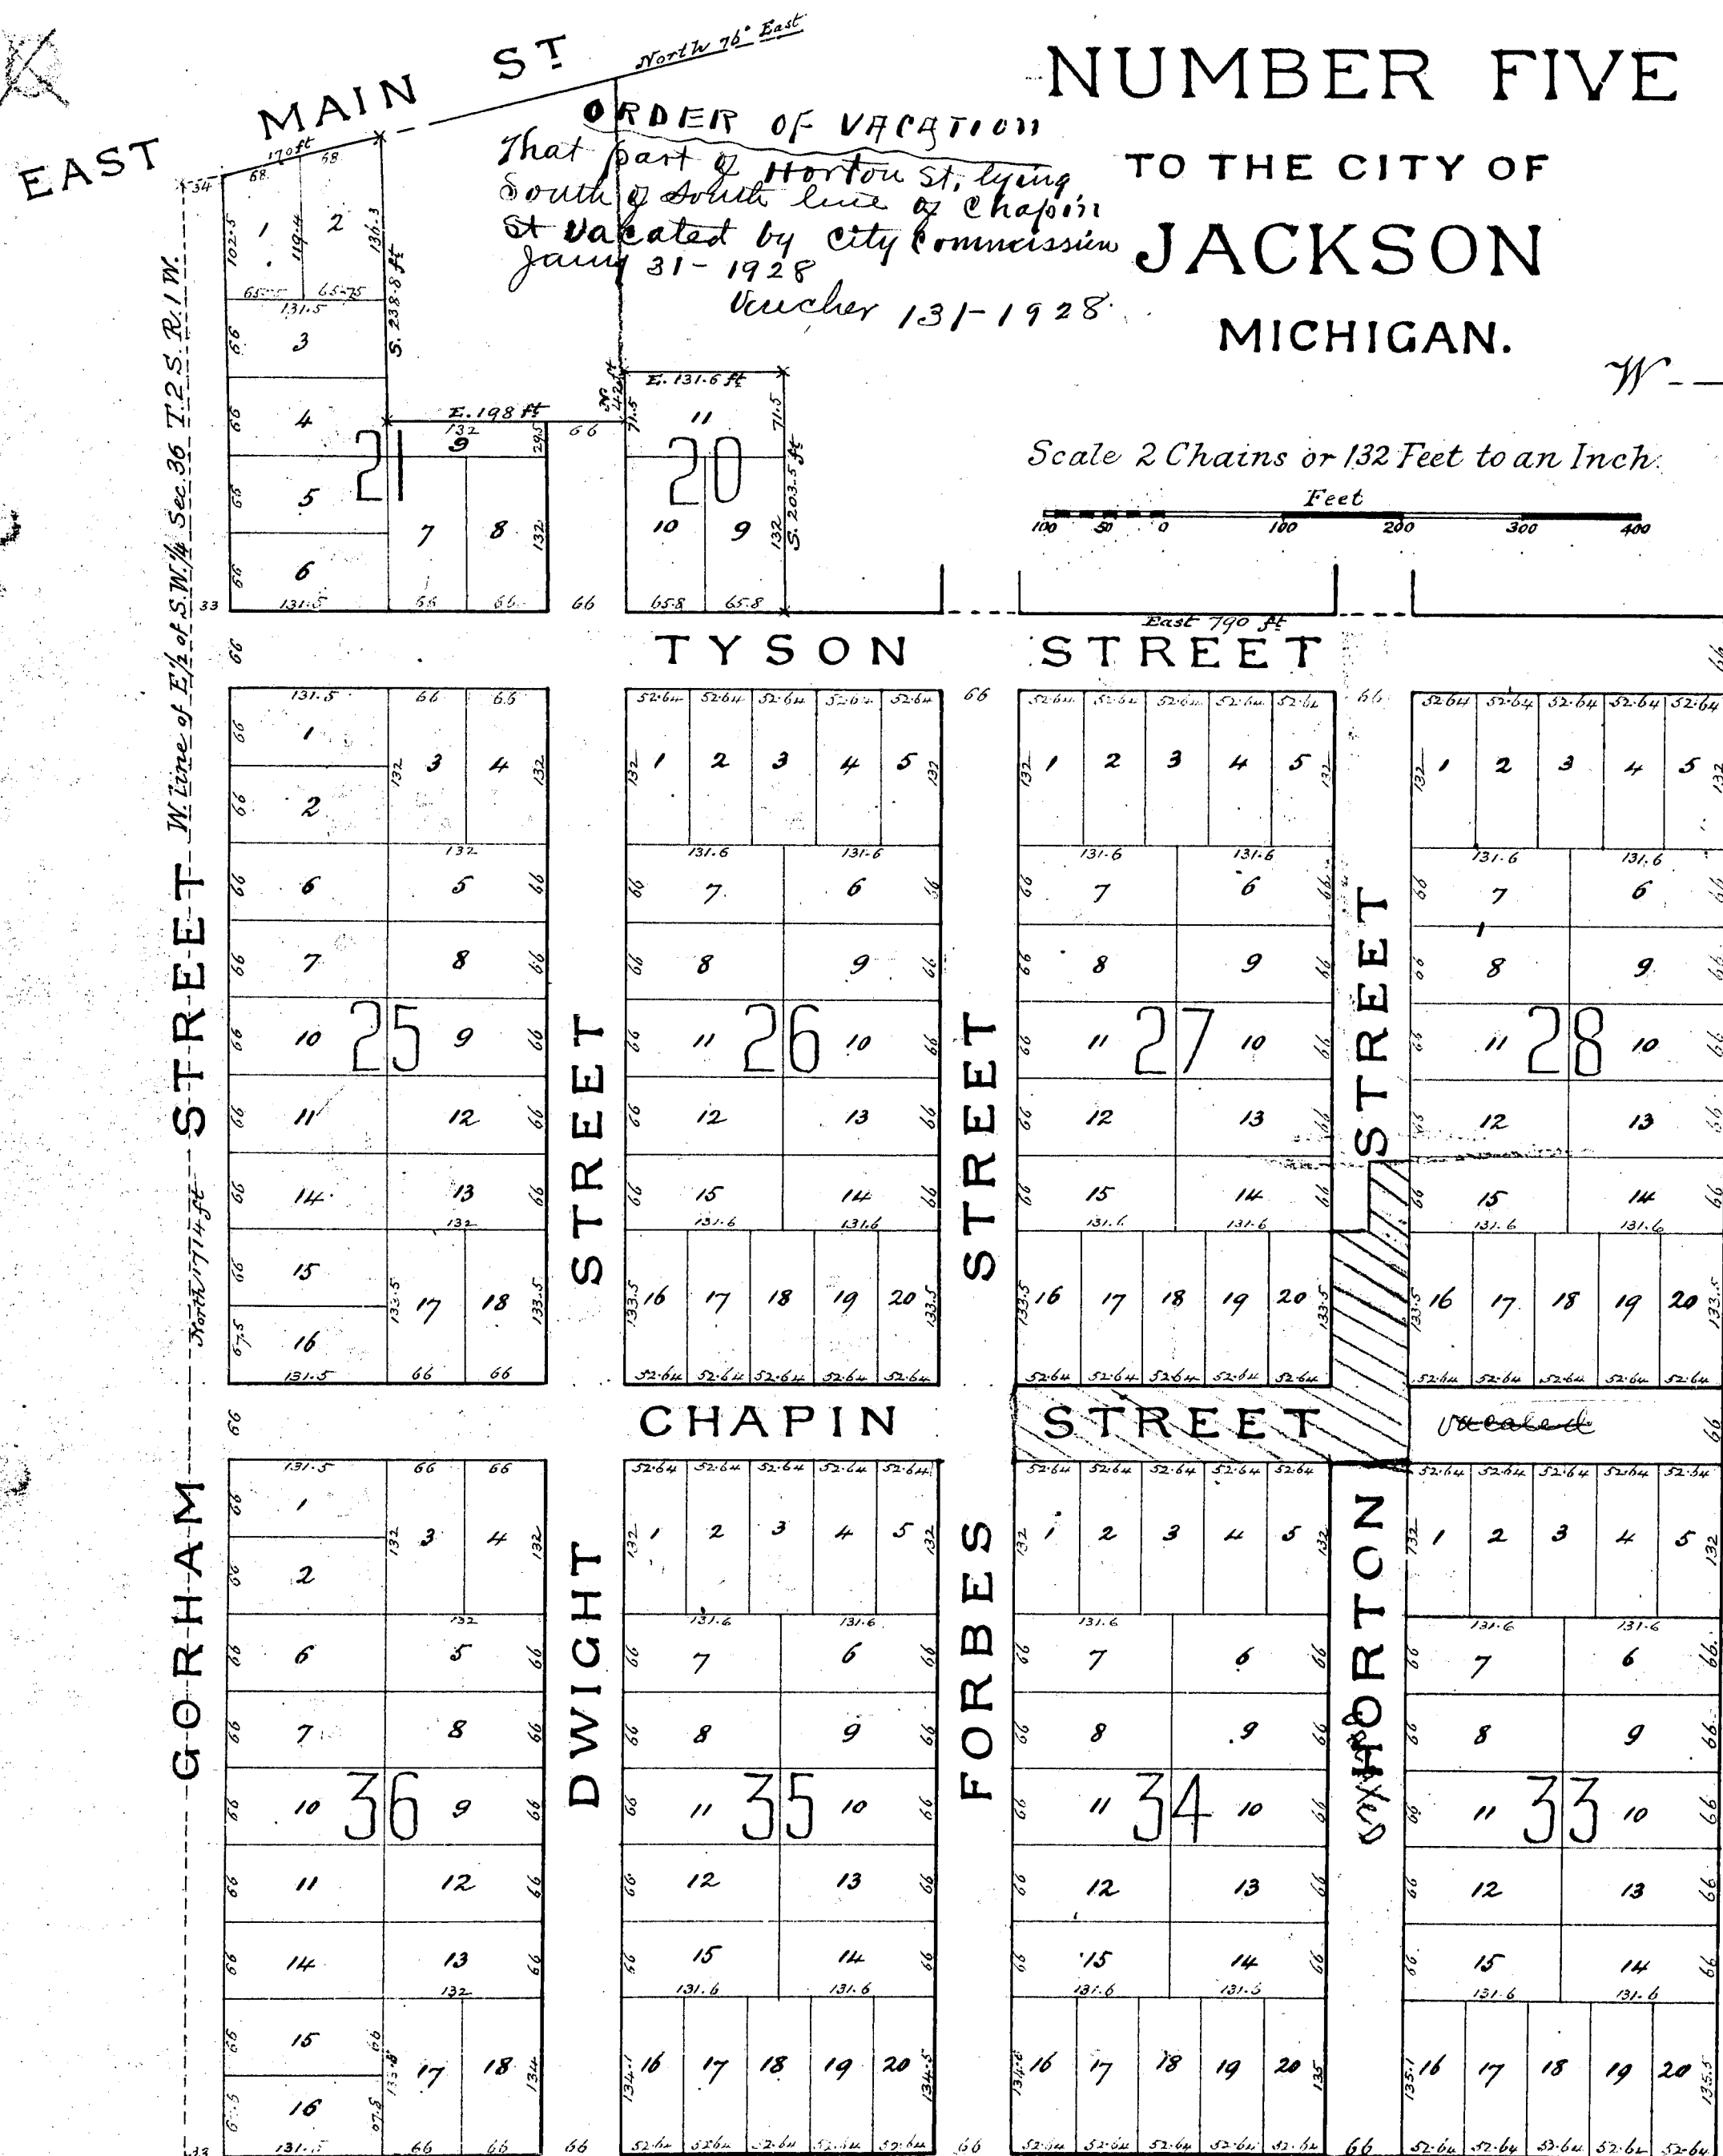

ORDER OF VACATION
That part of Horton St. lying
South of White line of Chapin
St vacated by City Commission
Jan'y 31-1928
Voucher 131-1928

Scale 2 Chains or 132 Feet to an Inch.

Know all men by these presents that we Hiram H. Smith and Harriet B. Smith his wife Henry H. Smith and Emma M. Smith his wife Dwight S. Smith and Joe M. Smith his wife Samuel B. Collins and Helen E. Collins his wife all of the City and County of Jackson State of Michigan and Charles H. Plummer of the City of East Saginaw County of Saginaw State of Michigan proprietors of the land hereinafter described have caused Robert M. Newman of the City of Jackson aforesaid a Civil Engineer and Surveyor to make this map or plat of an addition to the said City of Jackson to be known as East addition number five which said addition embraces all that part of the East half of the South west quarter of Section thirty six (36) Township two (2) South Range one (1) West bounded as follows: Beginning at a point in the South line of said section thirty six (36) thirty three (33) feet west of the South quarter first where a stone monument has been planted thence west along said South line of Section thirty six (36) twelve hundred eighty four (1284) feet to the division line between the East and west halves of the South west quarter of said section thirty six (36); thence north along said division line seventeen hundred fourteen (1714) feet to the South line of East Main Street thence north seventy six (76) degrees east along the South line of East Main Street one hundred seventy (170) feet, thence South two hundred thirty eight and 3/4 (238 3/4) feet, thence East one hundred ninety eight (198) feet, thence North forty two (42) feet, thence East one hundred thirty one 1/4 (131 1/4) feet, thence South two hundred three 5/8 (203 5/8) feet to the North line of Tyson Street, thence East along the North line of Tyson Street seven hundred ninety (790) feet to a point thirty three (33) feet west of the North and South quarter line of Section thirty six (36) aforesaid, thence South parallel to said quarter line thirteen hundred fifty eight (1358) feet to the point of beginning.

This map is drawn to a scale of two (2) Chains or one hundred thirty two (132) feet to an inch. The sizes of lots and other measurements are marked in feet. The numbers of the lots are indicated by black figures and the numbers of the blocks by red figures at or near the centers of the same.

The above described land is hereby dedicated as an addition to the City of Jackson County of Jackson and State of Michigan. The streets are named as shown on this map their widths are shown by figures thereon and they are hereby dedicated to the public to be used only as highways.

In witness whereof the said parties hereto have hereunto set their hands and seals this 22nd day of March 1889.

Signed and Sealed
in presence of

John C. Opeh
Fred J. Hall

Hiram H. Smith (S) Harriet B. Smith (S)
Henry H. Smith (S) Emma M. Smith (S)
Dwight S. Smith (S) Joe M. Smith (S)
Samuel B. Collins (S) Helen E. Collins (S)
Charles H. Plummer (S) Robert M. Newman (S)

State of Michigan } ss. On this 22nd day of March A.D. 1889, before me a Notary Public in and for said County, personally appeared Hiram H. Smith and Harriet B. Smith his wife, Henry H. Smith and Emma M. Smith his wife, Dwight S. Smith and Joe M. Smith his wife, Samuel B. Collins and Helen E. Collins his wife, Charles H. Plummer, Robert M. Newman Surveyor, who are by me known to be the persons who made and executed this plat of the East Addition No. 5. to the City of Jackson, and who severally acknowledge the same to be their free act and deed.

Fred J. Hall Notary Public
Jackson County Michigan

I hereby certify that the plat herein delineated is a correct one and that permanent monuments, consisting of iron stakes, have been planted at points marked thus x as thereon shown at all angles in the boundaries of the land platted and at all intersections of streets. Robert M. Newman. Surveyor.

State of Michigan } ss. We C. E. Townsend Register of
County of Jackson } Deeds and Robert M. Newman
Surveyor hereby certify that we have each
carefully compared this copy with the original
plat of East addition number five, and that it is
an exact copy thereof, and of the whole of such
original map or plat.

C. E. Townsend
Register of Deeds
Robert M. Newman
Surveyor

State of Michigan } ss. We C. E. Townsend Register of
County of Jackson } Deeds and Robert M. Newman
Surveyor hereby certify that we have each carefully compared
the original copy with the plat of East addition number
five now of record in the office of said Register of
Deeds, and that it is a true and correct copy of
the whole of such record.

C. E. Townsend
Register of Deeds
Robert M. Newman
Surveyor

13795

3360

Received for Record the 29th day of June
A.D. 1889 at 10 o'clock A.M. and Recorded
in Liber 44 of Plats on Page 8.
C. E. Townsend
Register of Deeds.



MAP OF

EAST ADDITION NUMBER FIVE

TO THE CITY OF
JACKSON
MICHIGAN.

Scale 2 Chains or 132 Feet to an Inch.

100 200 300 400

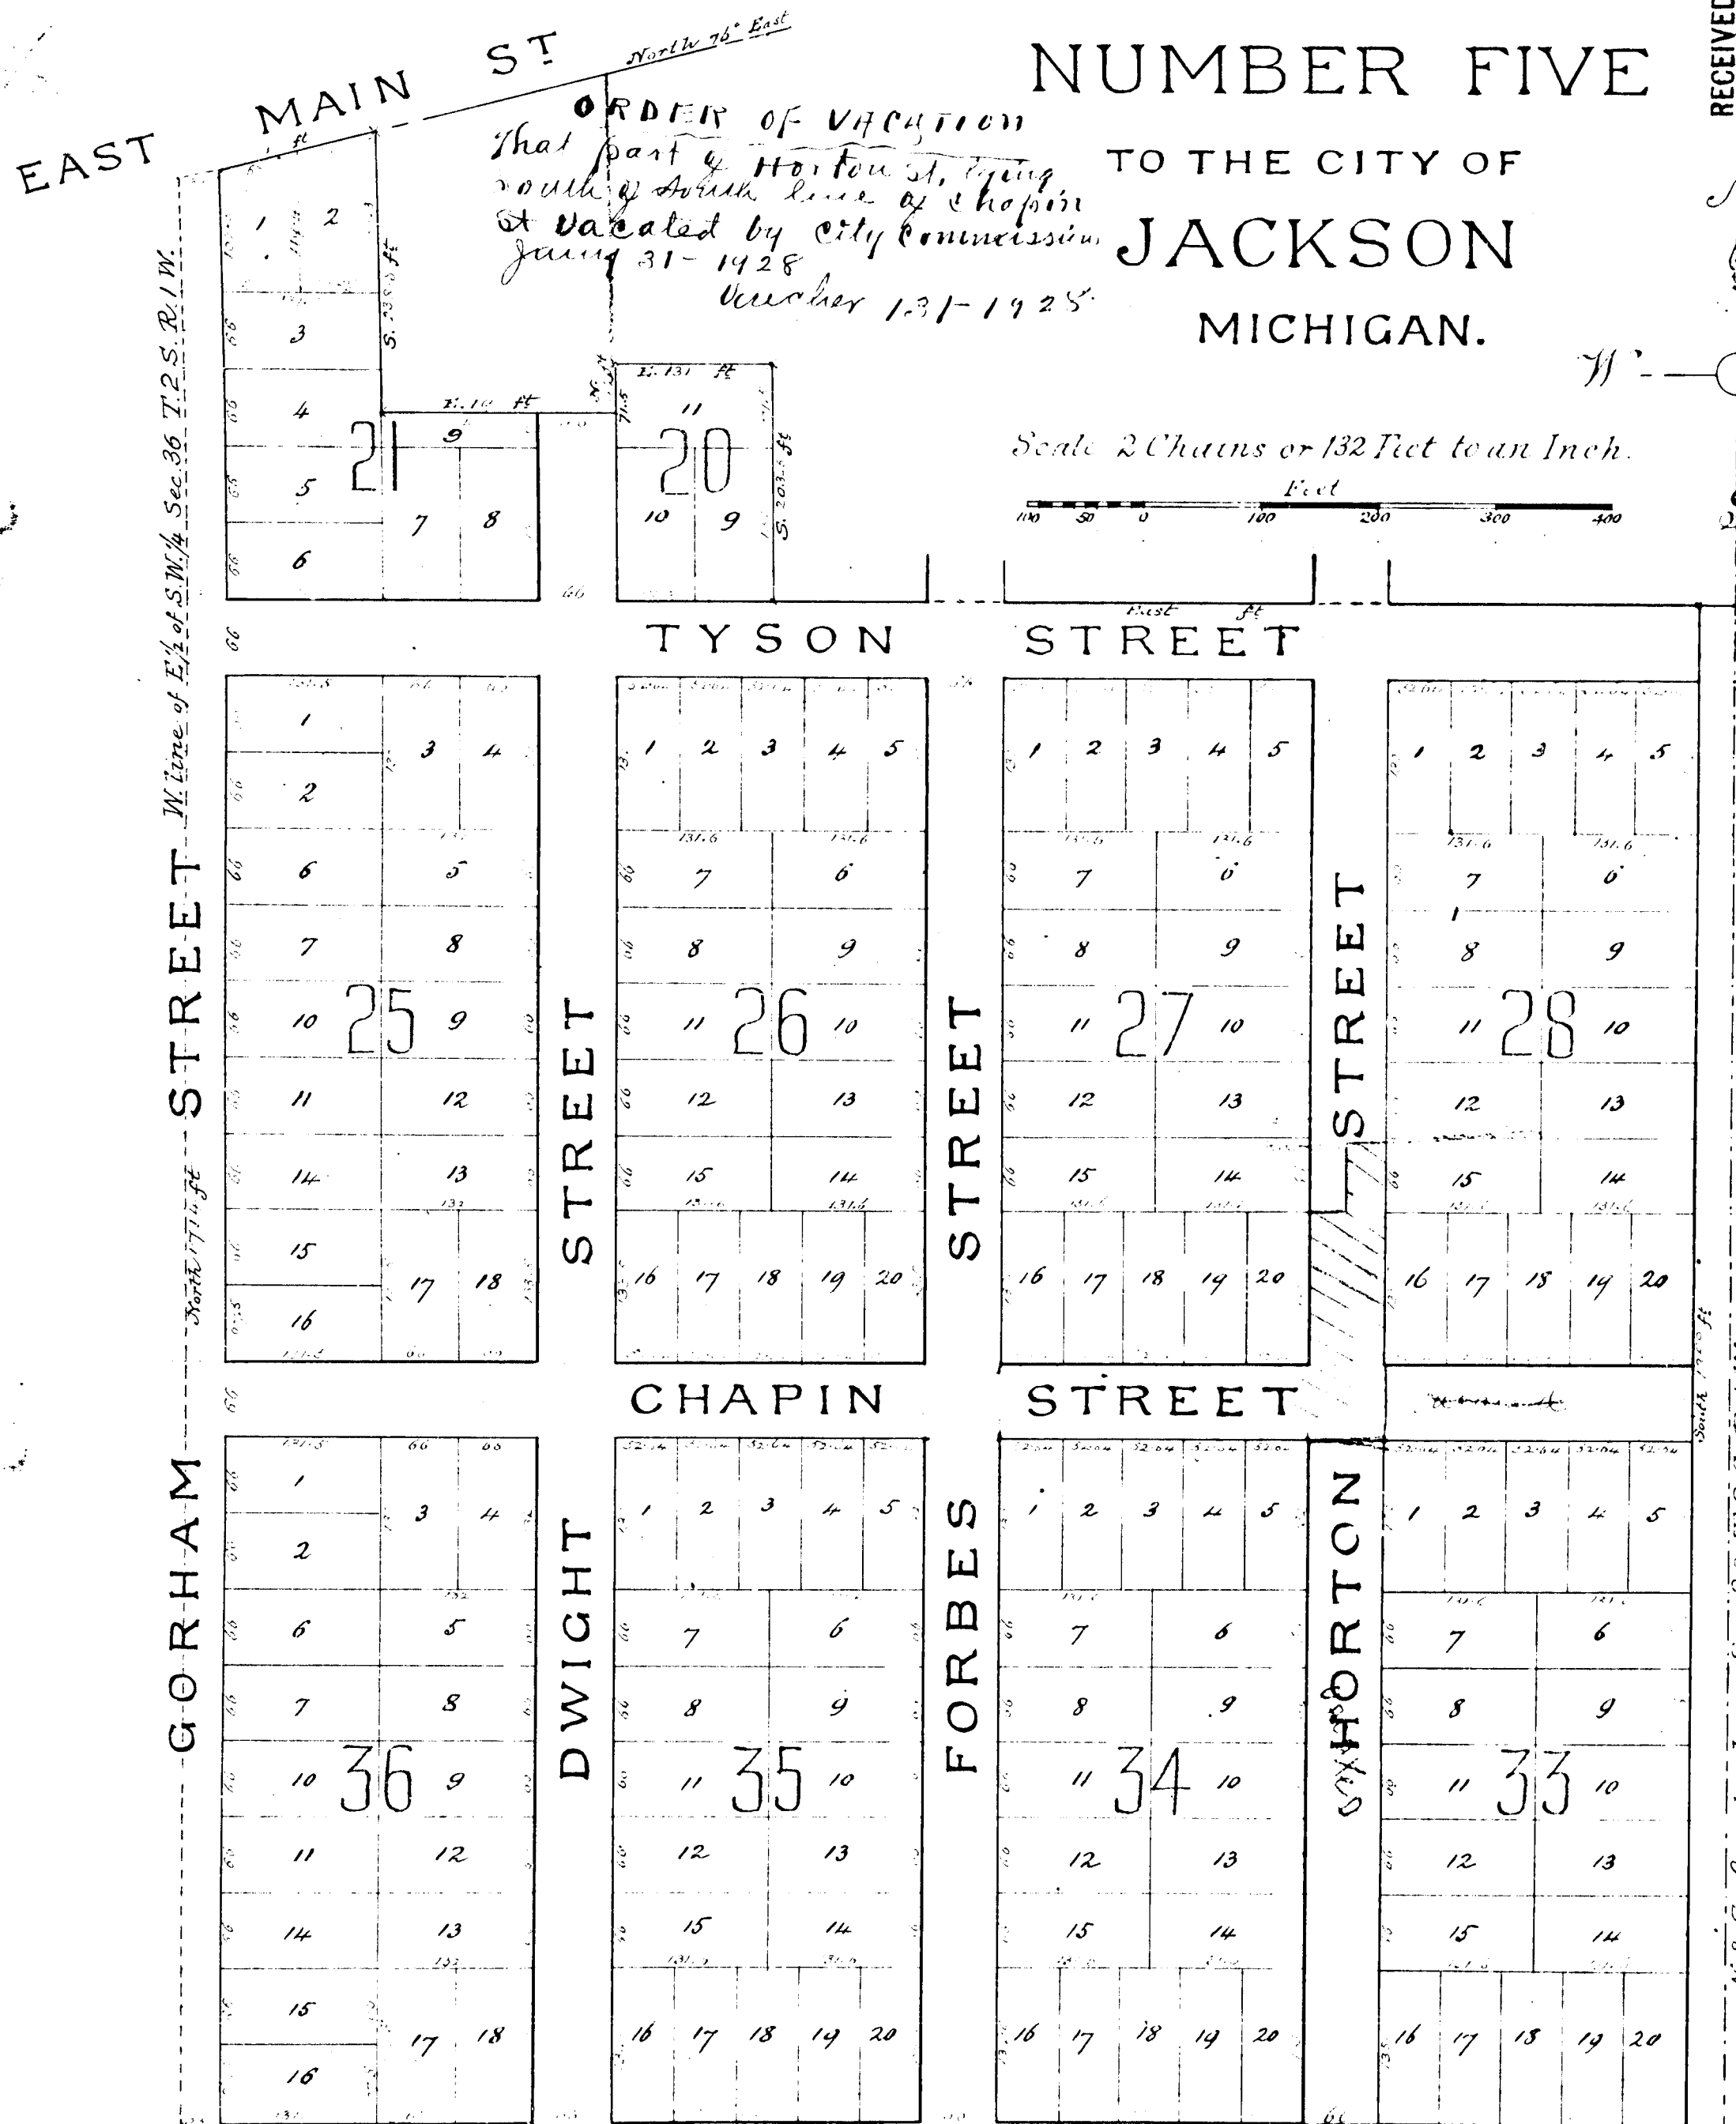

RECEIVED AND FILED
IN AUDITOR GENERAL'S OFFICE
April 22 1889
Deputy Auditor General

Know all men by these presents, that we Hiram H. Smith and Harriet B. Smith his wife, Henry H. Smith and Emma M. Smith his wife, Dwight S. Smith and Joe M. Smith his wife, Samuel B. Collins and Helen E. Collins his wife, all of the City and County of Jackson State of Michigan, and Charles H. Plummer of the City of East Saginaw County of Saginaw State of Michigan, proprietors of the land hereinafter described have caused Robert M. Newman of the City of Jackson aforesaid a Civil Engineer and Surveyor to make this map or plat of an addition to the said City of Jackson to be known as East Addition Number Five which said addition embraces all that part of the East half of the South west quarter of Section thirty six (36) Township two (2) South Range one (1) West bounded as follows, Beginning at a point on the South line of said Section thirty six (36) thirty three (33) feet west of the South quarter post where a stone monument has been planted thence west along said South line of Section thirty six (36) twelve hundred eighty four (1284) feet to the division line between the East and West halves of the South west quarter of said Section thirty six (36); thence north along said division line Seventeen hundred fourteen (1714) feet to the South line of East Main Street, thence North seventy six (76) degrees East along the South line of East Main Street One hundred seventy (170) feet, thence South two hundred thirty eight and 9/10 (238 9/10) feet, thence East one hundred ninety eight (198) feet, thence North forty two (42) feet, thence East one hundred thirty one 1/10 (131 1/10) feet, thence South two hundred three 5/10 (203 5/10) feet to the North line of Tyson Street, thence East along the North line of Tyson Street seven hundred ninety (790) feet to a point thirty three (33) feet west of the North and South quarter line of Section thirty six (36) aforesaid, thence South parallel to said quarter line thirteen hundred fifty eight (1358) feet to the point of beginning.

This map is drawn to a scale of two (2) Chains or one hundred thirty two (132) feet to an inch. The size, of lots and other measurements are marked in feet. The numbers of the lots are indicated by black figures and the numbers of the blocks by red figures at or near the centers of the same.

The above described land is hereby dedicated as an addition to the City of Jackson County of Jackson and State of Michigan. The streets are named as shown on this map their widths are shown by figures thereon and they are hereby dedicated to the public to be used only as highways.

In witness whereof the said parties hereto have hereunto set their hands and seals this 22nd day of March 1889.

Signed and Sealed
in presence of
John Joseph
Fred J. Hall
Hiram H. Smith
Harriet B. Smith
Henry H. Smith
Emma M. Smith
Dwight S. Smith
Joe M. Smith
Samuel B. Collins
Helen E. Collins
Charles H. Plummer
Robert M. Newman

State of Michigan } ss.
County of Jackson } On this 22nd day of March A.D. 1889, before me a Notary Public in and for said County, personally appeared Hiram H. Smith, Harriet B. Smith his wife, Henry H. Smith, Emma M. Smith his wife, Dwight S. Smith, Joe M. Smith his wife, Samuel B. Collins, Helen E. Collins his wife, Charles H. Plummer, Robert M. Newman Surveyor, who are by me known to be the persons who made and executed this plat of the East Addition No. 5. to the City of Jackson, and who severally acknowledge the same to be their free act and deed.

Fred J. Hall Notary Public
Jackson County Michigan
I hereby certify that the plat hereto delineated is a correct one and that permanent monuments consisting of iron stakes, have been planted at points marked thus x as thereon shown at all angles in the boundaries of the land platted and at all intersections of streets. Robert M. Newman. Surveyor.

State of Michigan } ss. We C. E. Townsend, Register of
County of Jackson } Deeds and Robert M. Newman, Surveyor
hereby certify that we have each carefully compared
the annexed copy with the plat of East Addition Number
Five now of record in the office of said Register of
Deeds, and that it is a true and correct copy of the
whole of such record.

C. E. Townsend
Register of Deeds
Robert M. Newman
Surveyor.

13795

330