

3836

RECEIVED AND FILED
AUDITOR GENERAL'S OFFICE
Scale, 200 feet to an inch
January 3, 1893
H.R. Pratt
Deputy Auditor General

PROSPECT ADDITION TO THE CITY OF Jackson Michigan.

Being an Amended Plat of Blocks 2-3-4-5-7-8-16-17 and 19 to 30 inclusive, also the east 5 rods of Block 1, the north 16 rods of Block 6, the east 8 rods of Block 15 and that part of Block 18 lying north of Prospect Boulevard; all in Sabins Addition to the City of Jackson Michigan.

Know all men by these presents that the Jackson Land and Improvement Company, a corporation duly organized under the laws of the State of Michigan, as proprietor, has caused the land embraced in the annexed plat, and hereinafter described, to be surveyed laid out and platted to be known as Prospect Addition to the City of Jackson Michigan, and that the streets and alleys as shown on said plat are hereby dedicated to the use of the public as highways, which said land so embraced in the said annexed plat is described as follows, to-wit, comprising Blocks 2-3-4-5-7-8-16-17 and Blocks 19 to 30 inclusive, also the east 5 rods of Block 1, the north 16 rods of Block 6, the east 8 rods of Block 15, and that part of Block 18 lying north of Prospect Boulevard (as here on shown) all in Sabins Addition to the City of Jackson Michigan, and being further described and bounded as follows:— Commencing at the southeast corner of the west half of the north-east quarter of section ten (10) in Town three (3) South of Range one (1) west and running thence north on the one eighth section line sixteen hundred twenty six and eight tenths (1626 ⁸/₁₀) feet to the south line of Griswold Street, thence west parallel with the north line of section 10, thirteen hundred twenty eight and sixty five one hundredths (1328 ⁶⁵/₁₀₀) feet to the north and south quarter section line, thence west parallel with the east and west quarter line of said section 10, eight hundred twenty five (825) feet, thence south parallel with the north and south quarter line of section 10, four hundred twenty nine (429) feet, thence west parallel with the east and west quarter line of section 10, four hundred sixty two (462) feet thence south parallel with the north and south quarter line, six hundred sixty one (661) feet, thence east parallel with the east and west quarter line nine hundred forty and one half (940 ¹/₂) feet, thence south along the east line of First Street, one hundred seventy four and six five one hundredths (174 ⁶⁵/₁₀₀) feet to the northerly line of the Air Line Railroad Company's lands, thence N 57° 40' E, along said railroad lands three hundred seventy one and forty five one hundredths (371 ⁴⁵/₁₀₀) feet, thence north fifty three and eighty five one hundredths (53 ⁸⁵/₁₀₀) feet, thence east along the south line of Prospect Boulevard, five hundred thirty nine and two tenths (539 ²/₁₀) feet, thence south parallel with Jackson Street, six hundred fourteen and eight tenths (614 ⁸/₁₀) feet to the east and west quarter line of section 10, thence east on said quarter line eight hundred twenty five (825) feet to the place of beginning.

In witness whereof the said Jackson Land and Improvement Company has caused these presents to be signed by Andrew J. Weatherwax its president and Charles P. Hunt its Secretary and has caused to be affixed hereto its corporate seal at the City of Jackson, County of Jackson, and State of Michigan on this 29th day of January A.D. 1892.

Signed and sealed in presence of
J.K. Bogert
Franklin S. Clarke
by
Andrew J. Weatherwax, President.
Charles P. Hunt, Secretary.


State of Michigan } ss.
County of Jackson }

On this 29th day of January A.D. 1892 before me a Notary Public in and for said County personally came the above named Andrew J. Weatherwax, President and Charles P. Hunt Secretary of the Jackson Land and Improvement Company, well known to me to be the persons named in and who executed the above dedication, and severally acknowledged the same to be their free act and deed and the free act and deed of the said Jackson Land and Improvement Company

J.K. Bogert
Notary Public Jackson Co., Michigan

I hereby certify that the plat hereon delineated is a correct one and that permanent monuments consisting of fire-clay posts 2 1/4 x 2 1/4 x 16 inches have been planted at all points marked thus (a) as thereon shown at all angles in the boundaries of the land platted and at all intersections of streets, and that permanent monuments consisting of oak stakes 2 inches square and from 18 to 20 inches long have been planted at points marked thus (x) at the intersections of streets and alleys.

Prospect Boulevard changed to BLISS ST changed to BLISS ST
Summer July 5-1920
W. G. Fargo Surveyor
Voucher No. 436-1925

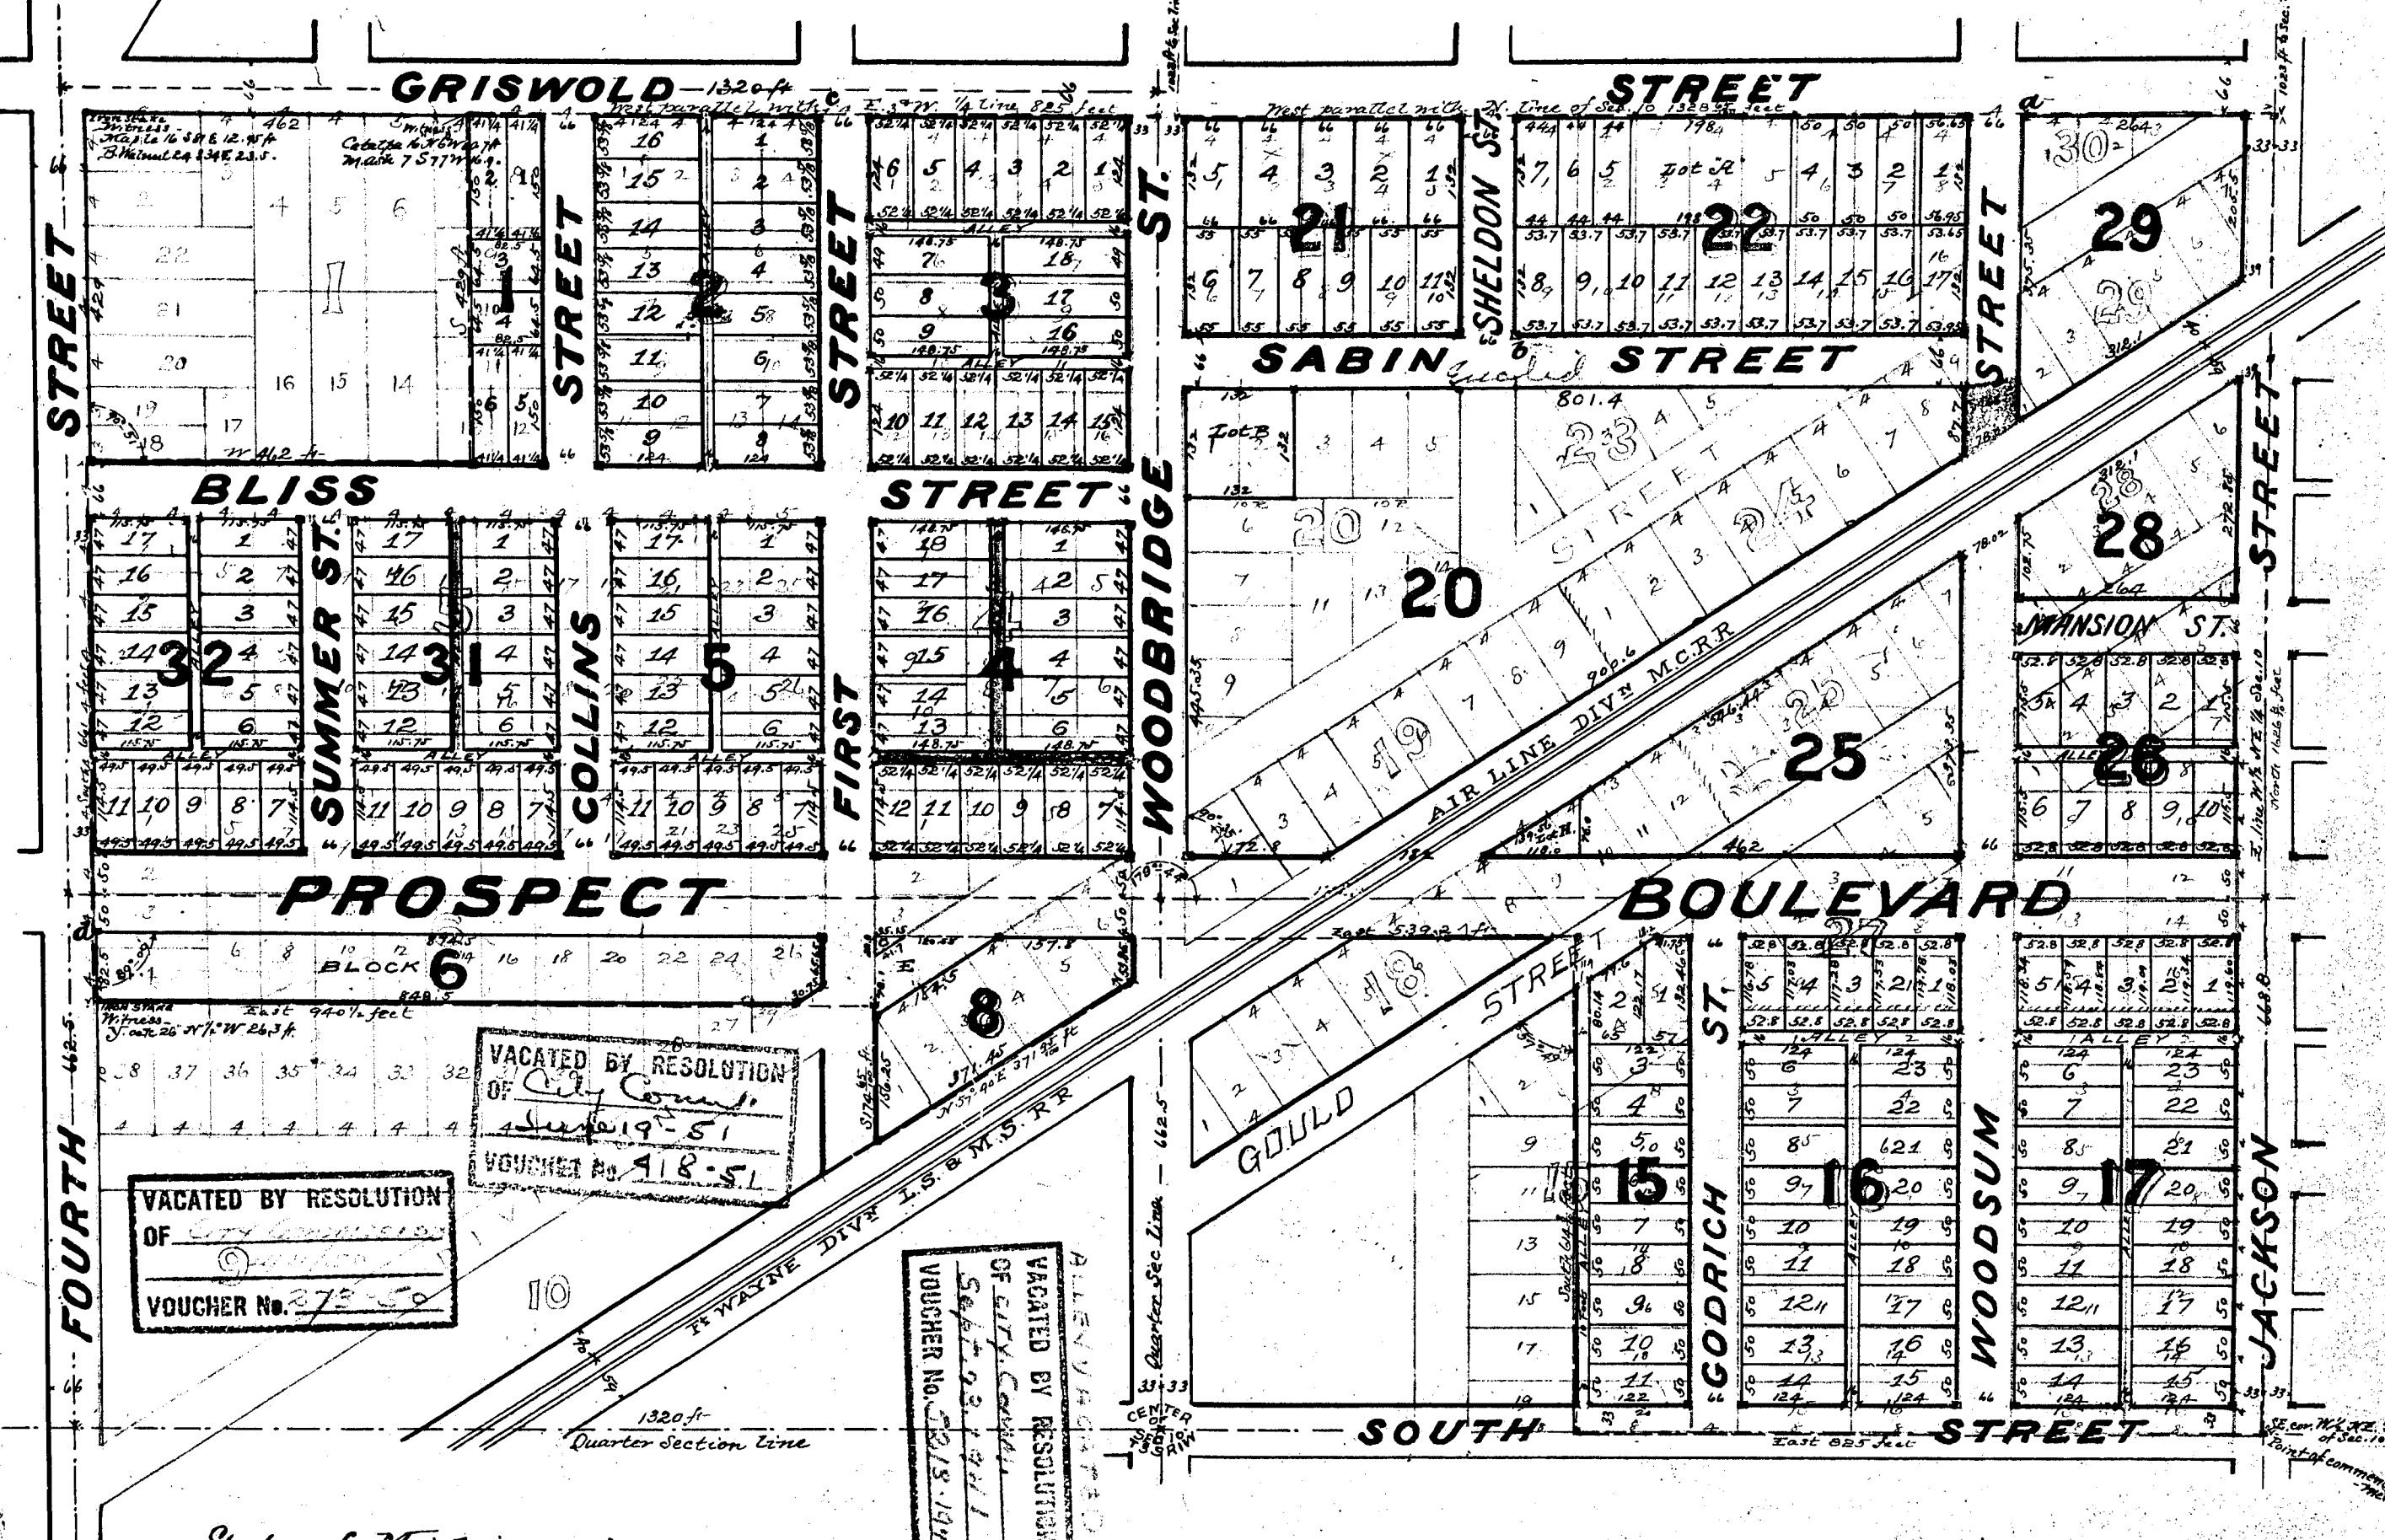

State of Michigan } ss.
County of Jackson }

We the Commune Register of Deeds and W. G. Fargo Surveyor, hereby certify that we have each carefully compared this copy with the original plat of Prospect Addition to the City of Jackson Michigan, and that it is an exact copy thereof and of the whole of such original map or plat.

W. G. Fargo
Surveyor

State of Michigan } ss.
County of Jackson }

We the Commune Register of Deeds and W. G. Fargo Surveyor, hereby certify that we have each carefully compared the annexed copy with the plat of Prospect Addition to the City of Jackson Michigan, now of record in the office of said Register of Deeds and that it is a true transcript therefrom and of the whole of such record.

W. G. Fargo
Surveyor

Witnesses to Monuments.

At	a	Iron Poplar	N 8° W	73.1 feet
	b	Maple	20° N 18° W	41.0
			16° S 59° W	85.0
	c	Elm	4° N 24° E	79.5
		Maple	10° N 57° W	96.4
	d	oak	26° S 1/2° E	54.2
		Maple	5° N 64° W	63.0

Examined and Approved
February 16 - 1892
H.R. Pratt
Deputy Auditor General.

Received for record the 25th day of June 1892 at 8 o'clock A.M. and recorded in Liber 4 of Plats on page 29

SABIN ST changed to WEST Euclid AVE.
Vou 546-1926

VACATED BY RESOLUTION
OF CITY COUNCIL
JAN. 10 1893
VOUCHER NO. 436-1925

13810

3836

Scale, 200 feet to an inch

RECORDED AND FILED
GENERAL'S OFFICE

James J. Bogert
Notary Public

PROSPECT ADDITION TO THE CITY OF Jackson Michigan.

Being an Amended Plat of Blocks 2-3-4-5-7-8-16-17 and 19 to 30 inclusive, also the east 5 rods of Block 1, the north 16 rods of Block 6, the east 8 rods of Block 15 and that part of Block 18 lying north of Prospect Boulevard; all in Sabins Addition to the City of Jackson Michigan.

Know all men by these presents that the Jackson Land and Improvement Company, a corporation duly organized under the laws of the State of Michigan, as proprietor, has caused the land embraced in the annexed plat, and hereinafter described, to be surveyed laid out and platted to be known as Prospect Addition to the City of Jackson, Michigan, and that the streets and alleys as shown on said plat are hereby dedicated to the use of the public as highways, which said land so embraced in the said annexed plat is described as follows to wit, comprising Blocks 2-3-4-5-7-8-16-17 and Blocks 19 to 30 inclusive, also the east 5 rods of Block 1, the north 16 rods of Block 6, the east 8 rods of Block 15, and that part of Block 18 lying north of Prospect Boulevard (as here on shown) all in Sabins Addition to the City of Jackson, Michigan, and being further described and bounded as follows: - Commencing at the southeast corner of the west half of the north-east quarter of section ten (10) in Town three (3) South of Range one (1) west and running thence north on the east line of section one (1) sixteen hundred twenty six and eight tenths (1626 ⁸/₁₀) feet to the south line of Griswold Street, thence west parallel with the north line of section 10, thirteen hundred twenty eight and sixty five one hundredths (1328 ⁶⁵/₁₀₀) feet to the north and south quarter section line, thence west parallel with the east and west quarter line of said section 10, eight hundred twenty five (825) feet, thence south parallel with the north and south quarter line of section 10, four hundred twenty nine (429) feet, thence west parallel with the east and west quarter line of section 10, four hundred sixty two (462) feet thence south parallel with the north and south quarter line six hundred sixty one (661) feet, thence east parallel with the east and west quarter line nine hundred forty and one half (940 ¹/₂) feet, thence south along the east line of First Street one hundred seventy four and sixty five one hundredths (174 ⁶⁵/₁₀₀) feet to the northerly line of the Air Line Railroad Company's lands, thence N 57° 20' E, along said railroad lands three hundred seventy one and forty five one hundredths (371 ⁴⁵/₁₀₀) feet, thence north fifty three and eighty five one hundredths (53 ⁸⁵/₁₀₀) feet, thence east along the south line of Prospect Boulevard five hundred thirty nine and two tenths (539 ²/₁₀) feet, thence south parallel with Jackson Street, six hundred fourteen and eight tenths (614 ⁸/₁₀) feet to the east and west quarter line of section 10, thence east on said quarter line eight hundred twenty five (825) feet to the place of beginning.

In witness whereof the said Jackson Land and Improvement Company has caused these presents to be signed by Andrew J. Weatherwax, its president and Charles P. Hunt its secretary and has caused to be affixed hereto its corporate seal at the City of Jackson, County of Jackson, and State of Michigan on this 29th day of January A.D. 1892

Signed and sealed in presence of
J.K. Bogert
Franklin S. Clarke
Jackson Land and Improvement Company
by Andrew J. Weatherwax, President. L.S.
Charles P. Hunt Secretary. L.S.


State of Michigan } ss.
County of Jackson }

On this 29th day of January A.D. 1892 before me a Notary Public in and for said County personally came the above named Andrew J. Weatherwax, President and Charles P. Hunt Secretary of the Jackson Land and Improvement Company, well known to me to be the persons named in and who executed the above dedication, and severally acknowledged the same to be their free act and deed and the free act and deed of the said Jackson Land and Improvement Company

J.K. Bogert
Notary Public Jackson Co., Michigan

I hereby certify that the plat hereon delineated is a correct one and that permanent monuments consisting of five day posts 2 1/4 x 2 1/4 x 16 1/2 inches have been planted at all points marked thus (a) as thereon shown at all angles in the boundaries of the land platted and at all intersections of streets, and that permanent monuments consisting of oak stakes 2 inches square and from 18 to 20 inches long have been planted at points marked thus (x) at the intersections of streets and alleys

W.G. Fargo Surveyor
B.L. Bledsoe
Sumner

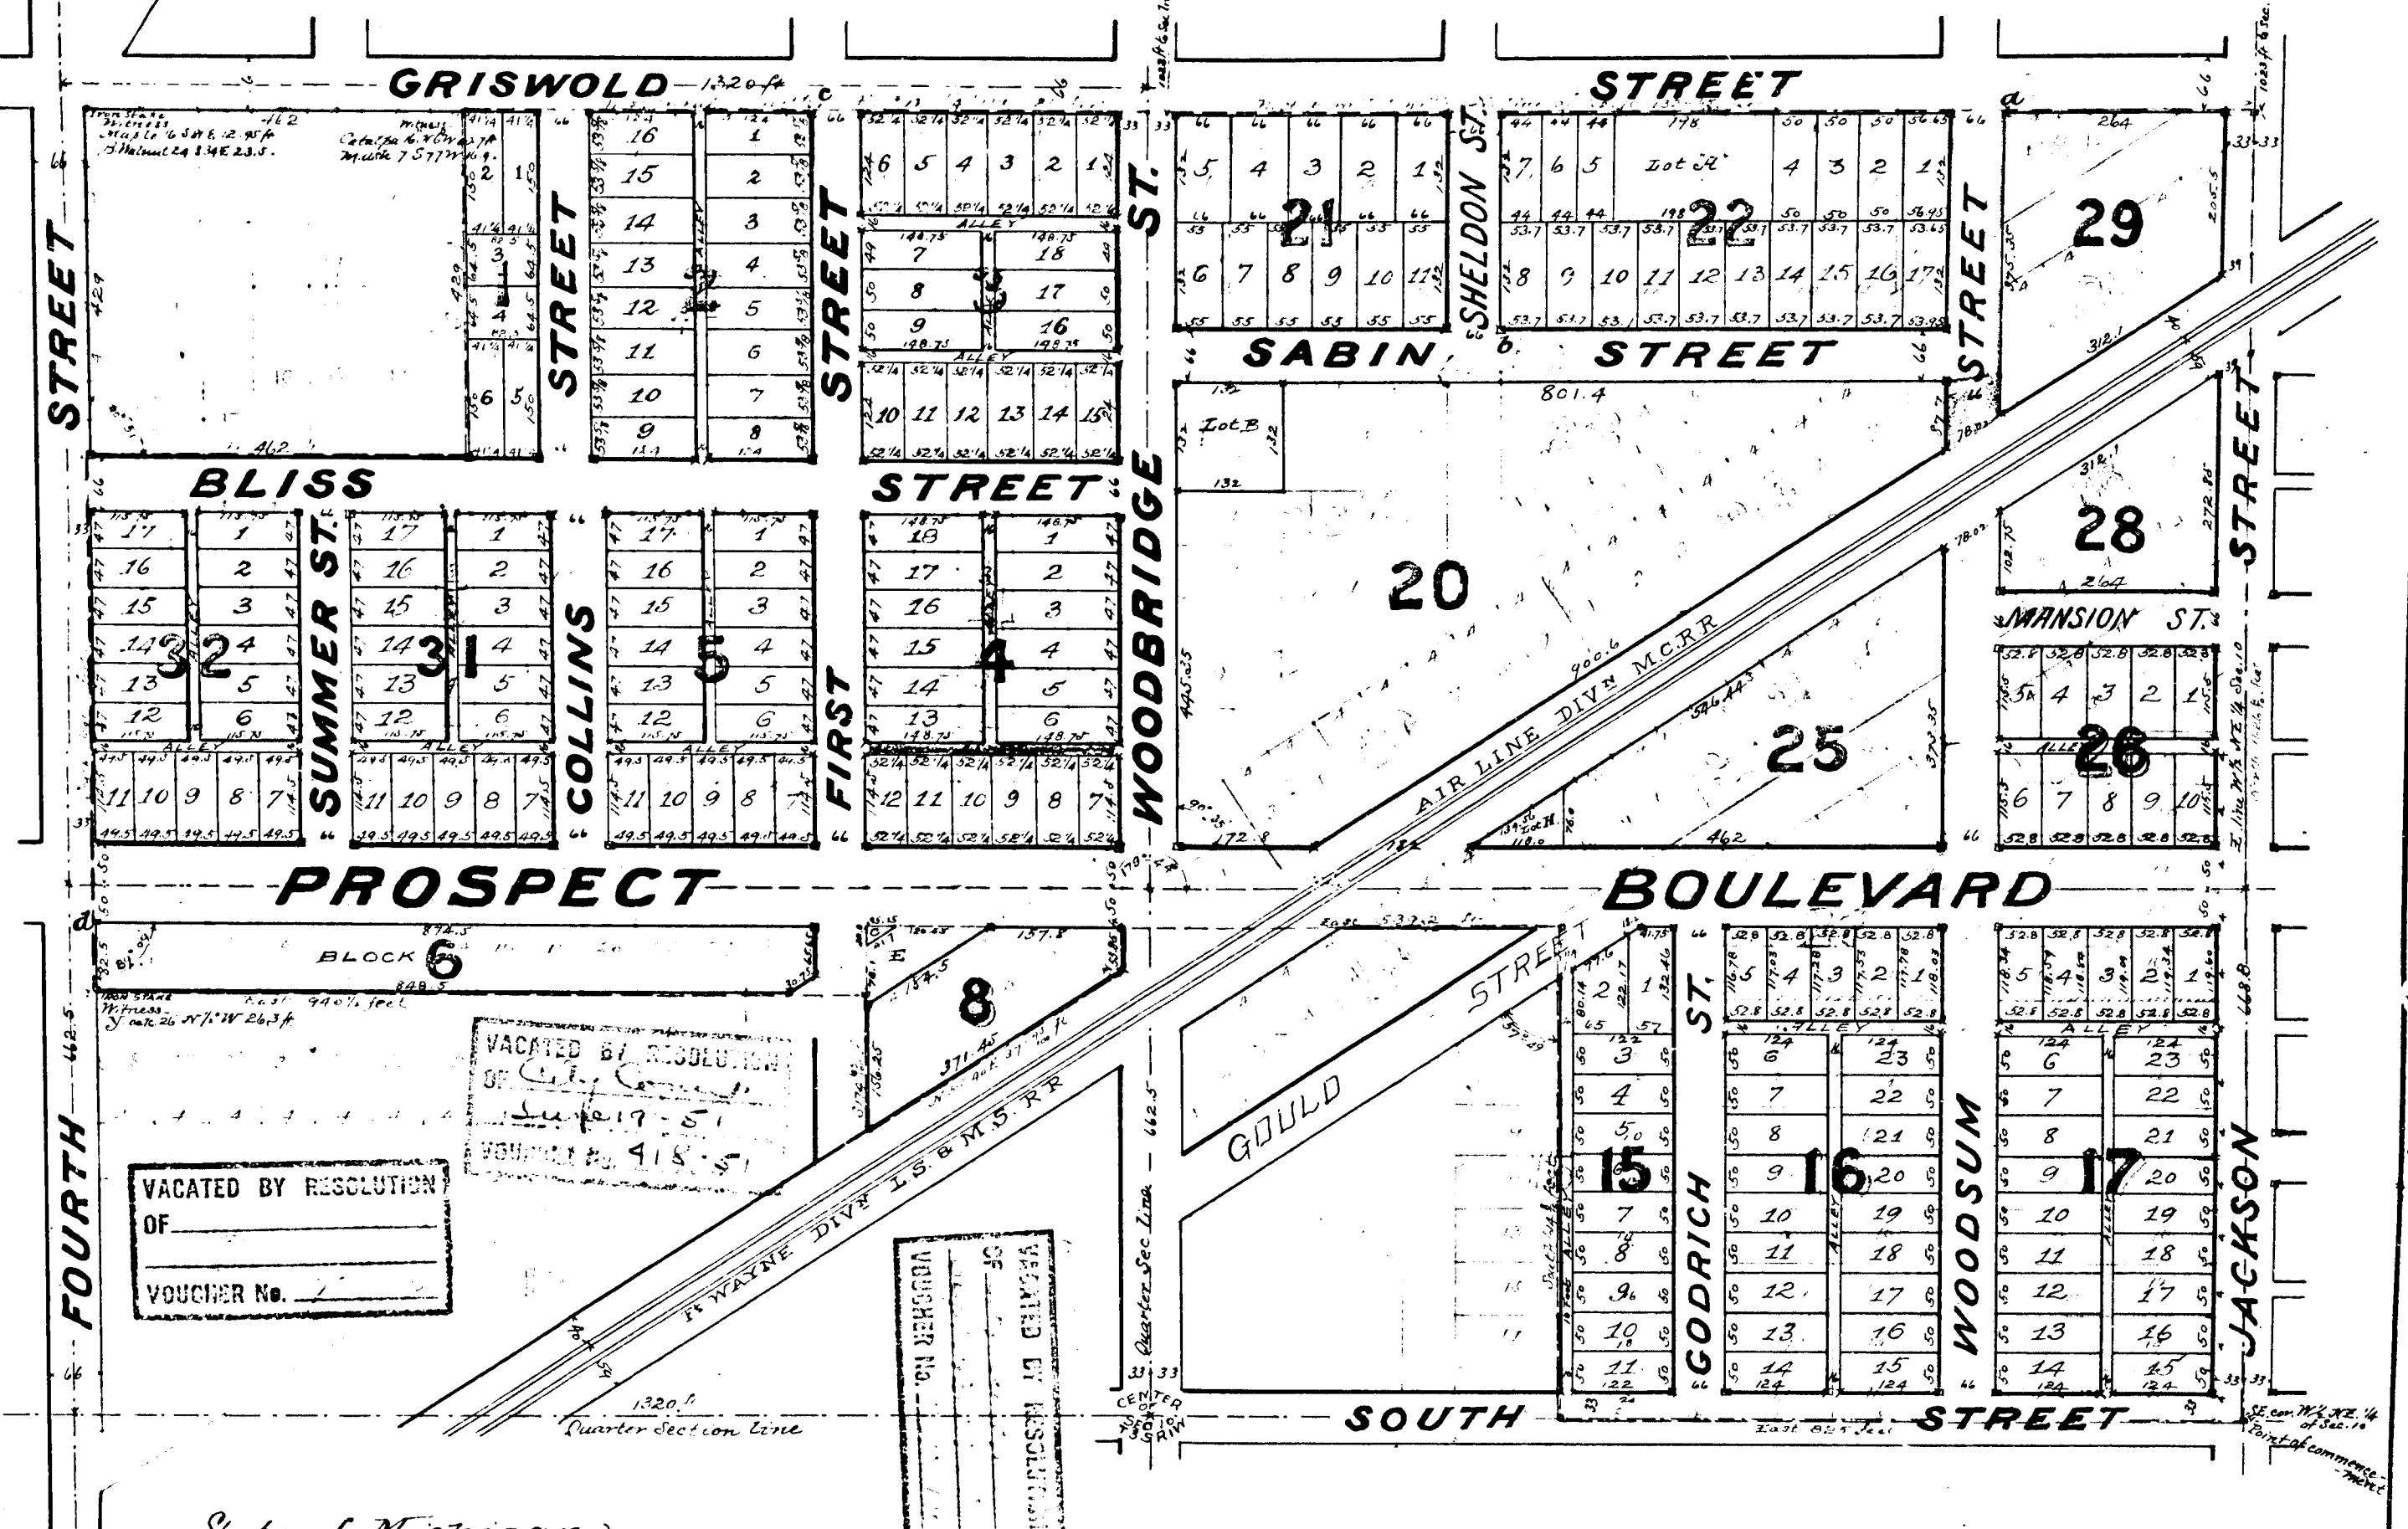

State of Michigan } ss.
County of Jackson }

We the undersigned, Register of Deeds and W.G. Fargo Surveyor, hereby certify that we have each carefully compared this copy with the original plat of Prospect Addition to the City of Jackson Michigan, and that it is an exact copy thereof and of the whole of such original map or plat.

W.G. Fargo
Register of Deeds
Surveyor

State of Michigan } ss.
County of Jackson }

We the undersigned, Register of Deeds and W.G. Fargo Surveyor, hereby certify that we have each carefully compared the annexed copy with the plat of Prospect Addition to the City of Jackson Michigan, now of record in the office of said Register of Deeds and that it is a true transcript therefrom and of the whole of such record.

W.G. Fargo
Register of Deeds
Surveyor

Witnesses to Monuments

a	Iron Poplar	N 8° W	73.1 feet
b	Maple	N 18° W	41.0
c	Elm	S 59° W	85.0
d	Maple	N 24° E	79.5
e	Maple	N 57° W	96.4
f	Maple	S 1/2 E	54.2
g	Maple	N 64° W	63.0

Examined and Approved
February 16 - 1892
H.R. Pratt
Deputy Auditor General

Received for record the 25th day of April 1892 at 8 o'clock A.M. and recorded in Liber 7 of Plats on page 23

SABIN ST changed to WEST Euclid AVE.
Nov 54 - 1926

13810



SANDRA L. PRICE
CITY CLERK

CITY OF JACKSON

161 W. MICHIGAN AVENUE JACKSON, MICHIGAN 49201

OFFICE OF CITY CLERK
PHONE (517) 788-4025
FAX (517) 788-4630

OCT 26 1994

October 21, 1994

Subdivision Control
Department of Commerce
P.O. Box 30004
Lansing, MI 48909-7504

Ladies and Gentlemen:

Re: Alley Vacation

Enclosed please find copies of an excerpt, map, and resolution adopted by the Jackson City Commission at their October 18, 1994, meeting regarding the vacation of an alley in Block 17, Prospect Addition.

Sincerely,

Lynn Fessel

Lynn Fessel
Deputy City Clerk

/s/
Enclosures

RESOLUTION

BY THE CITY COMMISSION:

WHEREAS, a petition has been filed by all of the persons, firms, corporations, and entities owning property abutting on or located in, under or over an alley in the City of Jackson, Michigan, for the vacation of said alley, more particularly described as:

The east/west alley bounded on the North by Lots 1 and 2 and on the South by Lot 23, Block 17, Prospect Addition

WHEREAS, it is determined that all persons, firms, corporations, and entities who will be affected by said vacation have filed with the City Commission their written consent to the same, and that it is necessary for the health, welfare, comfort, and safety of the people of the City to vacate and discontinue such alley;

NOW, THEREFORE, BE IT RESOLVED that the above-described alley be, and the same is hereby vacated, and the land shall revert to the abutting property free from any claim or right on the part of the public and, except as otherwise provided herein, all public claims and rights in and to said alley are hereby forever barred.

BE IT FURTHER RESOLVED that the vacation of the above-described alley is upon the condition that title to all water, sewer, gas, electric, and communication poles, wires, conduits, cables, pipes, lines, and their respective appurtenances and facilities now or hereafter in, under or over said alley are reserved to and shall remain in the respective owners thereof and their successors or assigns, together with an easement and continued right to occupy said alley within the previous right-of-way thereof for public utility purposes, with present and additional facilities, and to operate, repair, maintain, replace or remove the same to the same effect and in the same manner as if said alley remained a public way.

BE IT FURTHER RESOLVED that any abutting property owner, or their respective successors, heirs or assigns who wish to erect any structure on, or cause construction to, or otherwise modify or improve the now vacated right-of-way, shall first obtain the written permission of any utility owner who retains a right of occupancy and easement in said vacated right-of-way. Said written permission is required to ensure noninterference with the utility owner's easement and right of occupancy.

* * * * *

State of Michigan)
County of Jackson) ss
City of Jackson)

I, Sandra L. Price, City Clerk in and for the City of Jackson, County and State aforesaid do hereby certify that the foregoing is a true and complete copy of a resolution adopted by the Jackson City Commission on the 18th day of October, 1994.

IN WITNESS WHEREOF, I have hereunto
affixed my signature and the Seal of the City of
Jackson, Michigan, on this 19th day of October,
1994.

Sandra L. Price City Clerk

RESOLUTION VACATING THE EAST/WEST ALLEY BOUNDED ON THE NORTH BY LOTS 1 AND 2 AND ON THE SOUTH BY LOT 23, BLOCK 17, PROSPECT ADDITION. (CITY PLANNING COMMISSION RECOMMENDS THE VACATION.)



Motion was made by Comr. Dupuis and supported by Comr. Zyla to adopt the resolution. The motion was adopted by the following vote. Yeas: Comrs. Anderson, Zyla, Smith, Dupuis, DeLuca, and Mayor Diriam-6. Nays: 0. Absent: Comr. Lakomowski-1.

The foregoing is an excerpt from the
City Commission Proceedings of
October 18, 1994

Sandra L. Price City Clerk

PROSPECT ADDITION

SCALE
1 INCH = 100 FEET

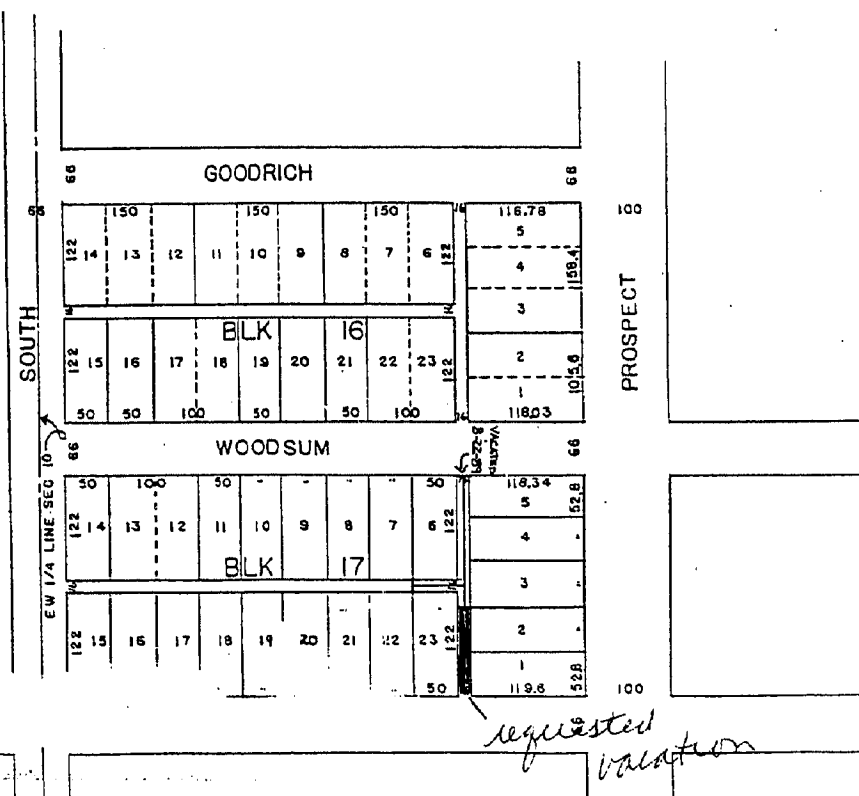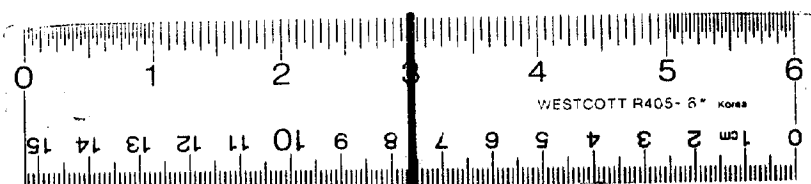

24 X

13810

CORRECTED
RESOLUTION

BY THE CITY COMMISSION:

WHEREAS, petition has been filed by all of the persons, firms, and corporations owning property abutting on or located in, under or over as alley in the City of Jackson, Michigan, for the vacation of said alley more particularly described as:

Block 17, Prospect Addition, Lots 3, 23, and 6.

Commencing at the southwest corner of Lot 6, then north to the approximate center of the south lot line of Lot 3 then east approximately 22 feet to the southeast corner of Lot 3, then south to the north lot line of Lot 23, then west approximately 22 feet to the northwest corner of lot 23, then south to the southeast corner of lot 23.

WHEREAS, it is determined that all persons, firms, and corporations who and which will be affected by said vacation have filed with the City Commission their written consent to the same, and that it is necessary for the health, welfare, comfort, and safety of the people of the City to vacate and discontinue such alley; and

NOW, THEREFORE, BE IT RESOLVED that said alley be and the same is hereby vacated, and the land shall revert to the abutting property free from any claim or right on the part of the public and that all public claims and rights in to said alley are hereby forever barred.

BE IT FURTHER RESOLVED that the vacation of said alley is upon the condition that the title to all water, sewer, and gas pipe, appurtenances and facilities; and all electric and communication poles, wires, conduits, cables, appurtenances and facilities now or hereafter in, under or over said alley are reserved to and shall remain in the respective owners thereof, their successors or assigns, together with the easement and continued right to occupy said alley, within the right-of-way thereof for public utility purposes, with present and additional facilities and to operate, repair, maintain, replace and remove the same to the same effect and in the same manner as if said alley remained a public way.

State of Michigan)
County of Jackson) ss
City of Jackson)

I, Sandra L. Conant, City Clerk in and for the City of Jackson, County and State aforesaid do hereby certify that the foregoing is a true and complete copy of a resolution adopted by the Jackson City Commission on the 22nd day of May, 1990.

IN WITNESS WHEREOF, I have hereunto affixed my signature and the Seal of the City of Jackson, Michigan, on this 23rd day of May, 1990.

Sandra L. Conant City Clerk

PROSPECT ADDN

RESOLUTION

BY THE CITY COMMISSION:

WHEREAS, petition has been filed by all of the persons, firms, and corporations owning property abutting on or located in, under or over as alley in the City of Jackson, Michigan, for the vacation of said alley more particularly described as:

Commencing at the southwest corner of Lot 6, then north to the approximate center of the south lot line of Lot 3 then east approximately 22 feet to the southeast corner of Lot 3, then south to the north lot line of Lot 23, then west approximately 22 feet to the northwest corner of lot 23, then south to the southeast corner of lot 23.

WHEREAS, it is determined that all persons, firms, and corporations who and which will be affected by said vacation have filed with the City Commission their written consent to the same, and that it is necessary for the health, welfare, comfort, and safety of the people of the City to vacate and discontinue such alley; and

NOW, THEREFORE, BE IT RESOLVED that said alley be and the same is hereby vacated, and the land shall revert to the abutting property free from any claim or right on the part of the public and that all public claims and rights in to said alley are hereby forever barred.


BE IT FURTHER RESOLVED that the vacation of said alley is upon the condition that the title to all water, sewer, and gas pipe, appurtenances and facilities; and all electric and communication poles, wires, conduits, cables, appurtenances and facilities now or hereafter in, under or over said alley are reserved to and shall remain in the respective owners thereof, their successors or assigns, together with the easement and continued right to occupy said alley, within the right-of-way thereof for public utility purposes, with present and additional facilities and to operate, repair, maintain, replace and remove the same to the same effect and in the same manner as if said alley remained a public way.

State of Michigan)
County of Jackson) ss
City of Jackson)

I, Sandra L. Conant, City Clerk in and for the City of Jackson, County and State aforesaid do hereby certify that the foregoing is a true and complete copy of a resolution adopted by the Jackson City Commission on the 22nd day of May, 1990.

IN WITNESS WHEREOF, I have hereunto affixed my signature and the Seal of the City of Jackson, Michigan, on this 23rd day of May, 1990.

Sandra L. Conant City Clerk

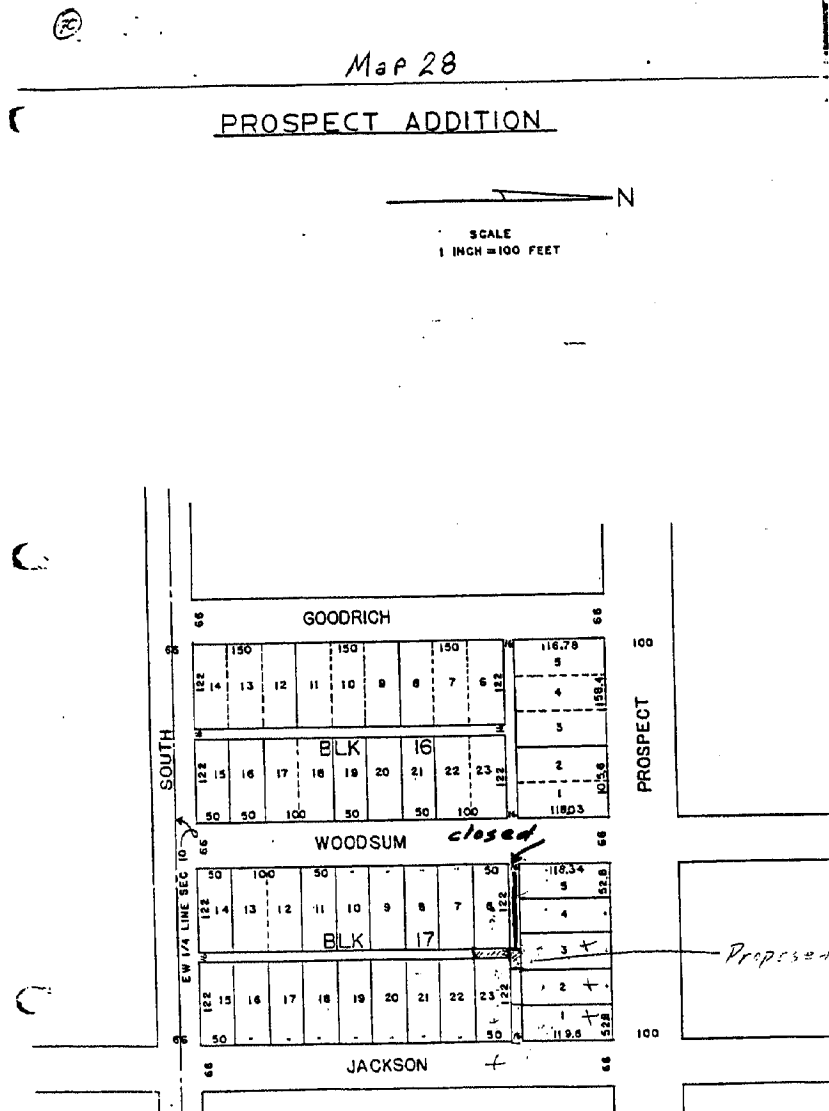

CONSIDERATION OF RESOLUTIONS.

A. RESOLUTION TO VACATE AN ALLEY ADJACENT TO LOTS 3, 23, AND 6 BETWEEN JACKSON AND WOODSUM STREETS IN BLOCK 17, PROSPECT ADDITION, AT THE REQUEST OF EDWARD MACKINS. (CITY PLANNING COMMISSION RECOMMENDS APPROVAL.)

Motion was made by Comr. Dittman and supported by Comr. Barham to adopt the resolution. The motion was adopted by the following vote: Yeas: Comrs. Smith, Griffin, DeLuca, Dupuis, Dittman, Barham, Fitzpatrick, Zyla, and Mayor Granger-9. Nays: 0. Absent: 0.

The foregoing is an excerpt from the
City Commission Proceedings of
May 22, 1990

Sandra L. Conant Deputy City Clerk

RESOLUTION

BY THE CITY COMMISSION:

WHEREAS, petition has been filed by all of the persons, firms, and corporations owning property abutting on or located in, under or over an alley in the City of Jackson, Michigan, for the vacation of said alley more particularly described as:

The westerly 122 feet of the East-West alley in Block 17, Prospect Addition to the City of Jackson (as recorded in Liber 4 of Plats, page 23, Jackson County Records), bounded on the North by Lot 5, Lot 6 and the westerly 16.4 feet of Lot 3, and bounded on the South by Lot 6 in said Block 17.

WHEREAS, it is determined that all persons, firms, and corporations who and which will be affected by said vacation have filed with the City Commission their written consent to the same, and that it is necessary for the health, welfare, comfort, and safety of the people of the City to vacate and discontinue such alley; and

NOW, THEREFORE, BE IT RESOLVED that said alley be and the same is hereby vacated, and the land shall revert to the abutting property free from any claim or right on the part of the public and that all public claims and rights in to said alley are hereby forever barred.

BE IT FURTHER RESOLVED that the vacation of said alley is upon the condition that the title to all water, sewer, and gas pipe, appurtenances and facilities; and all electric and communication poles, wires, conduits, cables, appurtenances and facilities now or hereafter in, under or over said alley are reserved to and shall remain in the respective owners thereof, their successors or assigns, together with the easement and continued right to occupy said alley, within the right-of-way thereof for public utility purposes, with present and additional facilities and to operate, repair, maintain, replace and remove the same to the same effect and in the same manner as if said alley remained a public way.


* * * * *

State of Michigan)
County of Jackson) ss
City of Jackson)

I, Sandra L. Comant, City Clerk in and for the City of Jackson, County and State aforesaid, do hereby certify that the foregoing is a true and complete copy of a resolution adopted by the Jackson City Commission on the 22nd day of August, 1989.

IN WITNESS WHEREOF, I have hereunto affixed my signature and the seal of the City of Jackson, Michigan, on this 23rd day of August, 1989.

Sandra L. Comant City Clerk

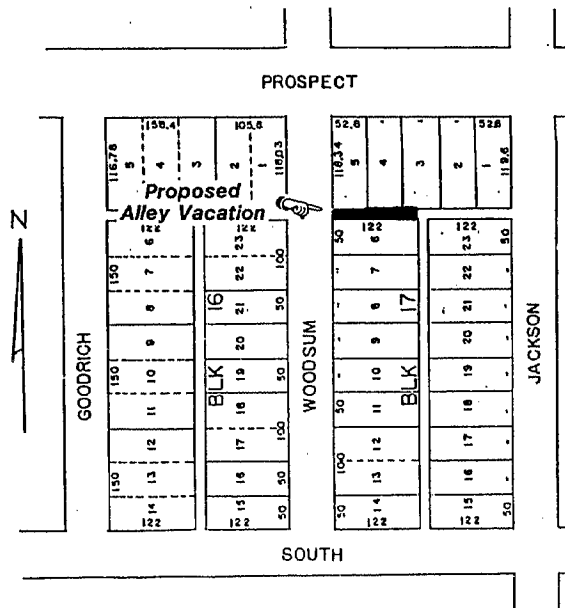

RESOLUTION

13810 MAR 29 1985
JACKSON

BY THE CITY COMMISSION:

WHEREAS, petition has been filed by all of the persons, firms, and corporations owning property abutting on or located in, under or over an alley in the City of Jackson, Michigan, for the vacation of said alley more particularly described as:

the west 68.8 feet of the east 280 feet of the east-west alley, Block 25, Prospect Addition (236 W. Prospect).

AND WHEREAS, it is determined that all persons, firms, and corporations who and which will be affected by said vacation have filed with the City Commission their written consent to the same, and that it is necessary for the health, welfare, comfort, and safety of the people of the City to vacate and discontinue such alley; and

NOW, THEREFORE, BE IT RESOLVED, that said alley be and the same is hereby vacated, and the land shall revert to the abutting property free from any claim or right on the part of the public and that all public claims and rights in to said alley are hereby forever barred; and

BE IT FURTHER RESOLVED, that the vacation of said alley is upon the condition that the title to all water, sewer, and gas pipe, appurtenances and facilities; and all electric and communication poles, wires, conduits, cables, appurtenances and facilities now of hereafter in, under or over said alley are reserved to and shall remain in the respective owners thereof, their successors or assigns, together with the easement and continued right to occupy said alley, within the right-of-way thereof for public utility purposes, with present and additional facilities and to operate, repair, maintain, replace and remove the same to the same effect and in the same manner as if said alley remained a public way.

State of Michigan)
County of Jackson)ss.
City of Jackson)


I, Betty J. Granger, Clerk in and for the City of Jackson, County and State aforesaid, do hereby certify that the foregoing is a true and complete copy of a resolution adopted by the Jackson City Commission on February 19, 1985.

IN WITNESS WHEREOF, I have hereto affixed my signature and the seal of the City of Jackson, Michigan, this 20th day of February, 1985.

Betty J. Granger City Clerk

13810

Prospect Addition
Block 25

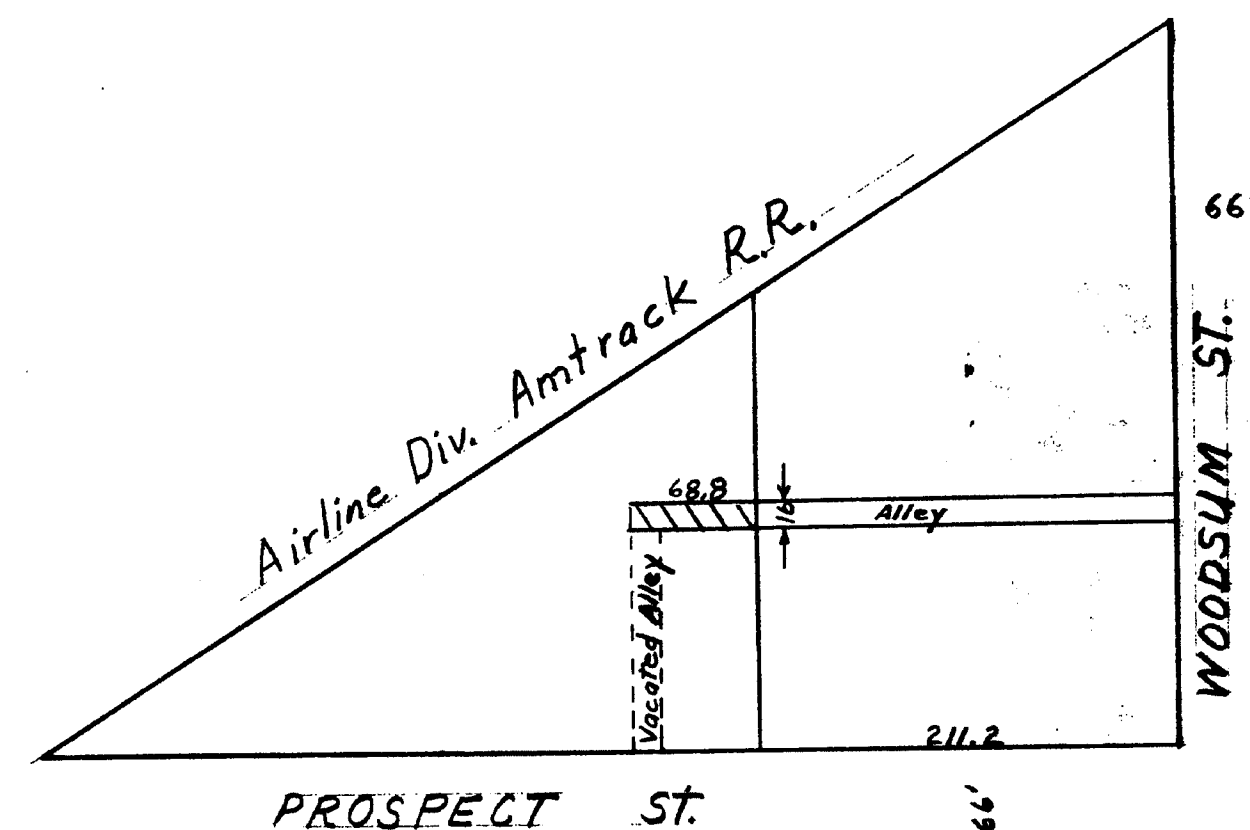

Scale 1"=100'

DEC. 27, 1984

Area to be vacated

R.P. DECKER

AUG 20 1 50 PM '73

RESOLUTION

BY THE CITY COMMISSION:

WHEREAS, petition has been filed by all of the persons, firms, and corporations owning property abutting on or located in, under or over an alley in the City of Jackson, Michigan, for the vacation of said alley more particularly described as:

First alley west of Goodrich Street between
West Prospect Avenue and West South Street.

AND WHEREAS, it is determined that all persons, firms, and corporations who and which will be affected by said vacation have filed with the City Commission their written consent to the same, and that it is necessary for the health, welfare, comfort, and safety of the people of the City to vacate and discontinue such alley; and

NOW, THEREFORE, BE IT RESOLVED, that said alley be and the same is hereby vacated, and the land shall revert to the abutting property free from any claim or right on the part of the public and that all public claims and rights in and to said alley are hereby forever barred; and

BE IT FURTHER RESOLVED, that the vacation of said alley is upon the condition that the title to all water, sewer, and gas pipe, appurtenances and facilities; and all electric and communication poles, wires, conduits, cables, appurtenances and facilities now or hereafter in, under or over said alley are reserved to and shall remain in the respective owners thereof, their successors or assigns, together with the easement and continued right to occupy said alley, within the right-of-way thereof for public utility purposes, with present and additional facilities and to operate, repair, maintain, replace and remove the same to the same effect and in the same manner as if said alley remained a public way.

* * *

State of Michigan)
County of Jackson) ss.
City of Jackson)

I, H. M. Conway, Clerk in and for the City of Jackson, County and State aforesaid, do hereby certify that the foregoing is a true and complete copy of a resolution adopted by the City Commission of the City of Jackson, Michigan, on July 17, 1973.

IN WITNESS WHEREOF, I have hereto
affixed my signature and the seal
of the City of Jackson, Michigan,
this 17th day of July, 1973.

H M Conway CITY CLERK



Jackson
13810
9107

REGISTER OF DEEDS
JACKSON COUNTY, MICH.
John M. Aldridge



[illegible]

GOODRICH

[illegible]

21	20	19	18	17	16	15

WOODSUM