5391

DREXEL PLACE

Dedication

THE TAX CERTIFICATE IN COMPLIANCE WITH [illegible] OF COMPILED LAWS OF 1897, HAVING BEEN FURNISHED.

Know all Men by these Presents, That we, Louis A. Kinsey and Lottie A. Kinsey, his wife, of the City of Indianapolis, Marion County, Indiana, as proprietors, have caused the land embraced in the annexed plat to be surveyed, laid out and platted, to be known as Drexel Place, and that the avenues, streets and alleys, as shown in said plat, are hereby dedicated to the use of the public.

INDIANAPOLIS, IND., Oct. 26th 1903.

Signed and Sealed in Presence of

Ross C. Jessup
Richard B. Tuttle

Louis A. Kinsey [L. S.]
Lottie A. Kinsey [L. S.]

STATE OF INDIANA, } ss.
COUNTY OF MARION, }

On this 26th day of October, 1903, before me, a Notary Public in and for said county, personally appeared the above named Louis A. Kinsey and Lottie A. Kinsey, his wife, known to me to be the persons named in and who executed the above dedication and severally acknowledged the same to be their free act and deed.

My Commission Expires Sept 27th 1905 — John J. Reilly, Notary Public.

Description of Land Platted

Commencing at the center post of section twenty-eight (28) in town two (2) south of range one (1) west; thence west on the quarter post line forty three (43) rods fourteen (14) links to the Maynard and Roath land; thence south parallel with the north and south quarter post line along the east line of said Maynard and Roath's land three hundred forty (340) rods to the center of the Territorial Road; thence south sixty-eight (68) degrees forty-five (45) minutes east in the center of said road forty-seven (47) rods twenty-two (22) links to the quarter post line of section thirty-three (33); thence north on the quarter post line of sections thirty-three (33) and twenty-eight (28) three hundred fifty-seven (357) rods nine (9) links to the place of beginning, containing (including excess of land) ninety-six acres more or less.

Surveyor's Certificate

I HEREBY CERTIFY, That the plat hereon delineated is a correct one, and that permanent monuments, consisting of 2"x2" oak posts eighteen (18) inches long, have been planted at the corners of all lots south of Albert Street, and at the Elm Street angle of all lots north of Albert Street, and iron pipe stakes at all angles in the boundaries of the land platted and at all intersections of streets, at points marked thus [O]. Distances are in feet and decimals. East and West lines are all parallel to the East and West Quarter Line of Section 33, except the North boundary line.

Josiah B. Frost, Surveyor.

Examined and approved
November 4th 1903
John F. Wilkinson
Deputy Auditor General

RECEIVED AND FILED.
IN AUDITOR GENERAL'S OFFICE,
Dec 5-1903
Deputy Auditor General.

State of Michigan } ss
County of Jackson }

We, Wesley Sears, Register of Deeds, and Josiah B. Frost, Surveyor, hereby certify that we have each carefully compared the annexed copy with the original plat of Drexel Place and that it is an exact copy thereof and of the whole of such original map or plat.

Wesley Sears, Register of Deeds,
Joseph B. Frost, Surveyor.

State of Michigan } ss.
County of Jackson }

We, Wesley Sears, Register of Deeds and Josiah B. Frost, Surveyor, hereby certify that we have each carefully compared the annexed copy with the plat of Drexel Place now of record in the office of said Register of Deeds, and that it is a true transcript therefrom and of the whole of such record


Wesley Sears, Register of Deeds.
Josiah B. Frost, Surveyor.


STATE OF MICHIGAN, COUNTY OF JACKSON, REGISTER'S OFFICE. } ss.

THIS within INSTRUMENT was received for RECORD this 6TH Day of NOVEMBER A. D. 1903 at 10 20 o'clock A. M. and recorded in LIBER 6 of PLATS on page 23

Wesley Sears, REGISTER OF DEEDS.

NOTARY PUBLIC SEAL MARION CO. INDIANA

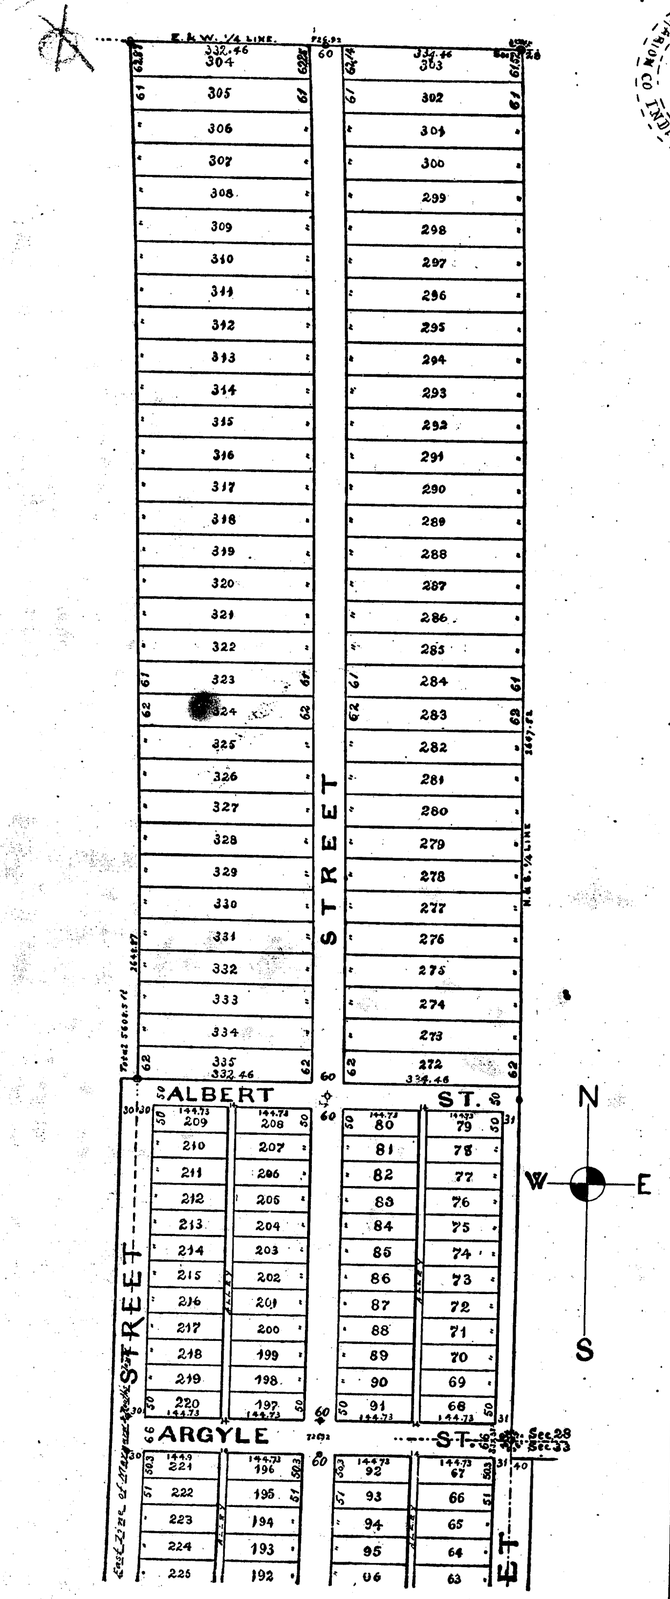

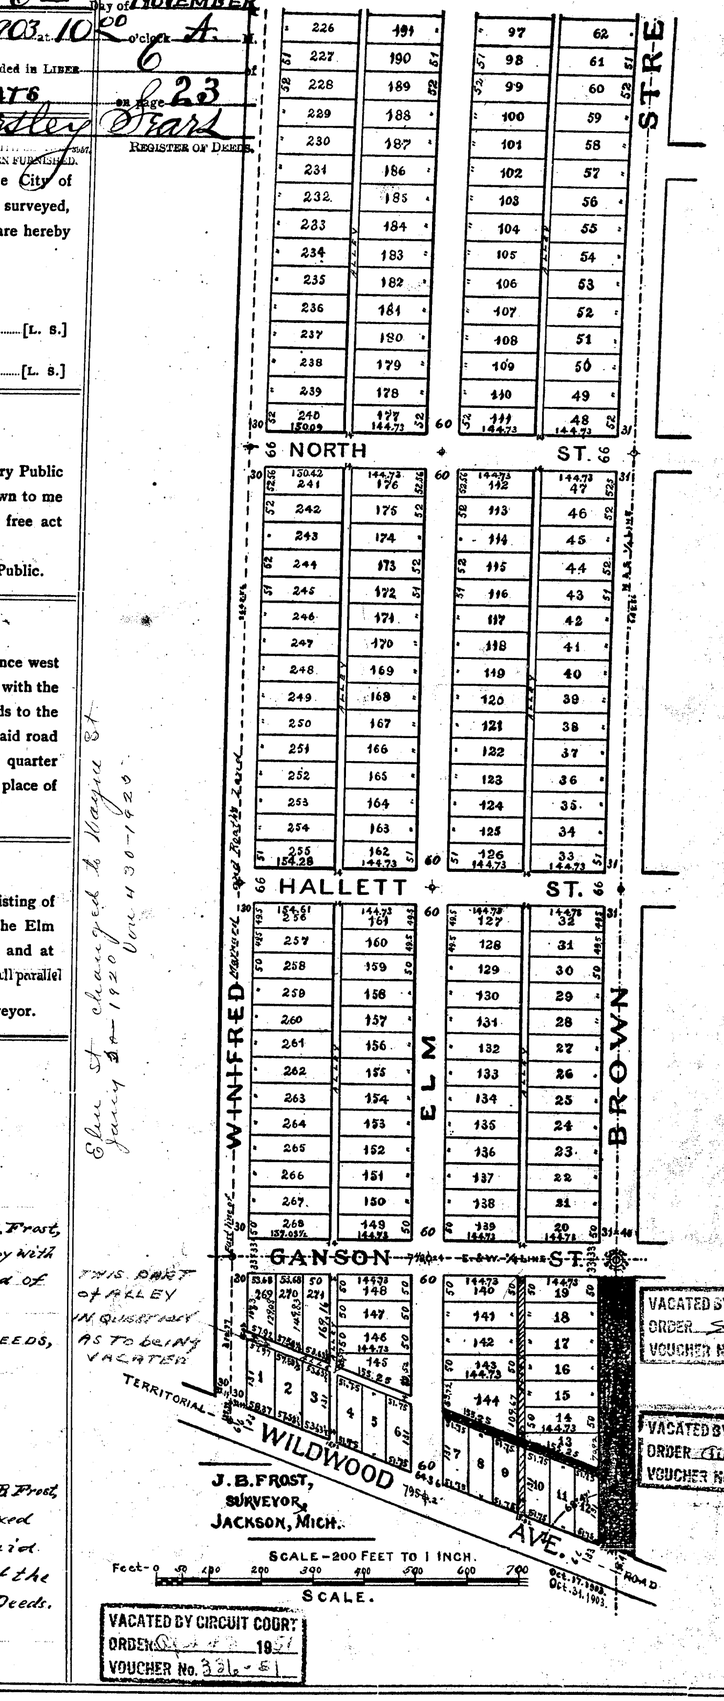

5391

DREXEL PLACE

Dedication

Know all Men by these Presents, That we, Louis A. Kinsey and Lottie A. Kinsey, his wife, of the City of Indianapolis, Marion County, Indiana, as proprietors, have caused the land embraced in the annexed plat to be surveyed, laid out and platted, to be known as Drexel Place, and that the avenues, streets and alleys, as shown in said plat, are hereby dedicated to the use of the public.

INDIANAPOLIS, IND., Oct. 26th 1903.

Signed and Sealed in Presence of

Ross A. Siegner — Louis A. Kinsey [L. S.]

Richard A. Smith — Lottie A. Kinsey [L. S.]

STATE OF INDIANA, } ss.
COUNTY OF MARION, }

On this 26th day of October, 1903, before me, a Notary Public in and for said county, personally appeared the above named Louis A. Kinsey and Lottie A. Kinsey, his wife, known to me to be the persons named in and who executed the above dedication and severally acknowledged the same to be their free act and deed.

My Commission Expires Sept 27th 1905 — John J. Reilly, Notary Public.

Description of Land Platted

Commencing at the center post of section twenty-eight (28) in town two (2) south of range one (1) west; thence west on the quarter post line forty three (43) rods fourteen (14) links to the Maynard and Roath land; thence south parallel with the north and south quarter post line along the east line of said Maynard and Roath's land three hundred forty (340) rods to the center of the Territorial Road; thence south sixty-eight (68) degrees forty-five (45) minutes east in the center of said road forty-seven (47) rods twenty-two (22) links to the quarter post line of section thirty-three (33); thence north on the quarter post line of sections thirty-three (33) and twenty-eight (28) three hundred fifty-seven (357) rods nine (9) links to the place of beginning, containing (including excess of land) ninety-six acres more or less.

Surveyor's Certificate

I HEREBY CERTIFY, That the plat hereon delineated is a correct one, and that permanent monuments, consisting of 2"x2" oak posts eighteen (18) inches long, have been planted at the corners of all lots south of Albert Street, and at the Elm Street angle of all lots north of Albert Street, and iron pipe stakes at all angles in the boundaries of the land platted and at all intersections of streets, at points marked thus [O]. Distances are in feet and decimals. East and West lines are all parallel to the East and West Quarter Line of Section 33, except the North boundary line.

Josiah B. Frost, Surveyor.

Examined and approved
November 4th 1903
John D. Wilkinson
Deputy Auditor General

RECEIVED AND FILED.
IN AUDITOR GENERAL'S OFFICE,
Dec 5-1903
Joseph Abercrombie
Deputy Auditor General.

State of Michigan, } ss. We, Wesley Sears, Register of Deeds, and Josiah B. Frost, Surveyor, hereby certify that we have each carefully compared the annexed copy with the original plat of Drexel Place and that it is an exact copy thereof and of the whole of such original map or plat.

Wesley Sears, Register of Deeds,
Josiah B. Frost, Surveyor.

State of Michigan, } ss. We, Wesley Sears, Register of Deeds and Josiah B. Frost, Surveyor, hereby certify that we have each carefully compared the annexed copy with the plat of Drexel Place now of record in the office of said Register of Deeds, and that it is a true transcript therefrom and of the whole of such record.

Wesley Sears, Register of Deeds.
Josiah B. Frost, Surveyor.


STATE OF MICHIGAN, } ss.
COUNTY OF JACKSON, }
REGISTER'S OFFICE.


This with a DRAWING was received for RECORD this 6TH day of NOVEMBER A. D. 1903 at 10 o'clock A. M. and recorded in LIBER 6 of PLATS on Page 23.

Wesley Sears, REGISTER OF DEEDS.


NOTARY PUBLIC SEAL MARION CO. INDIANA

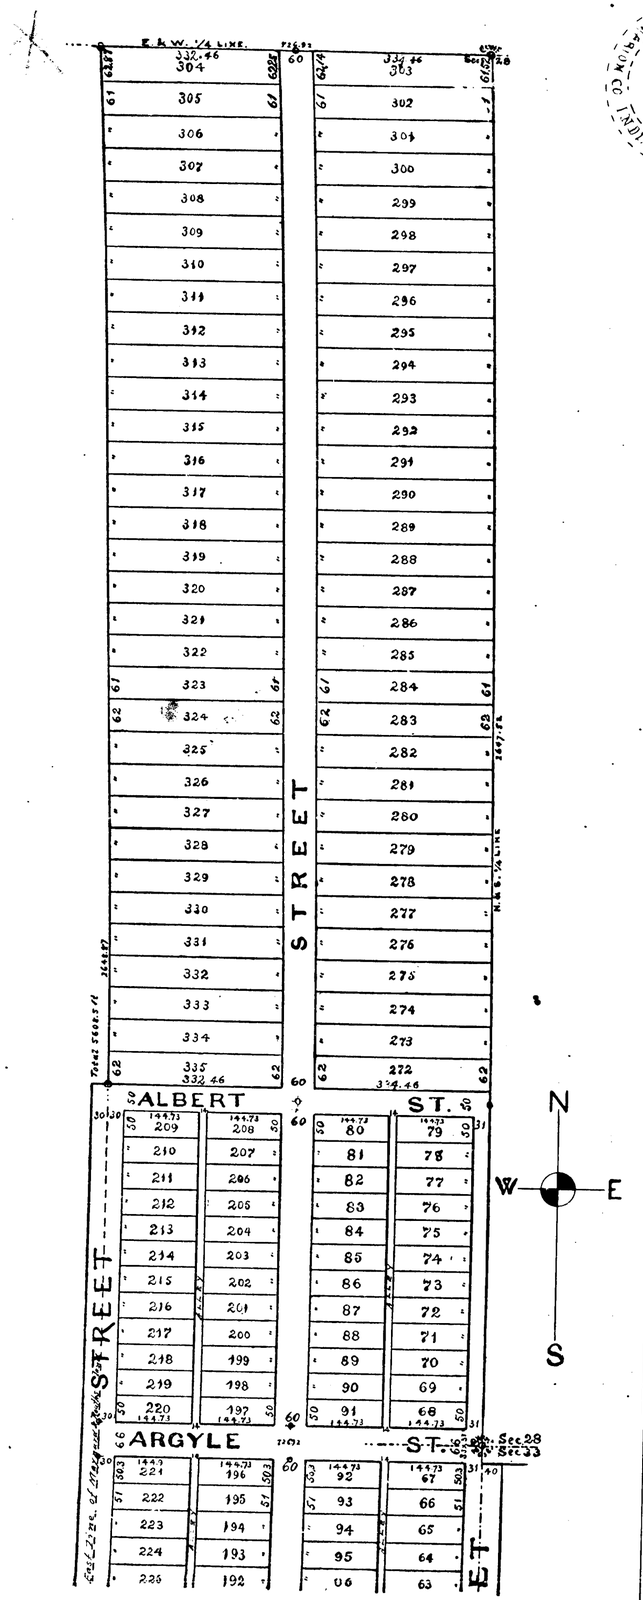

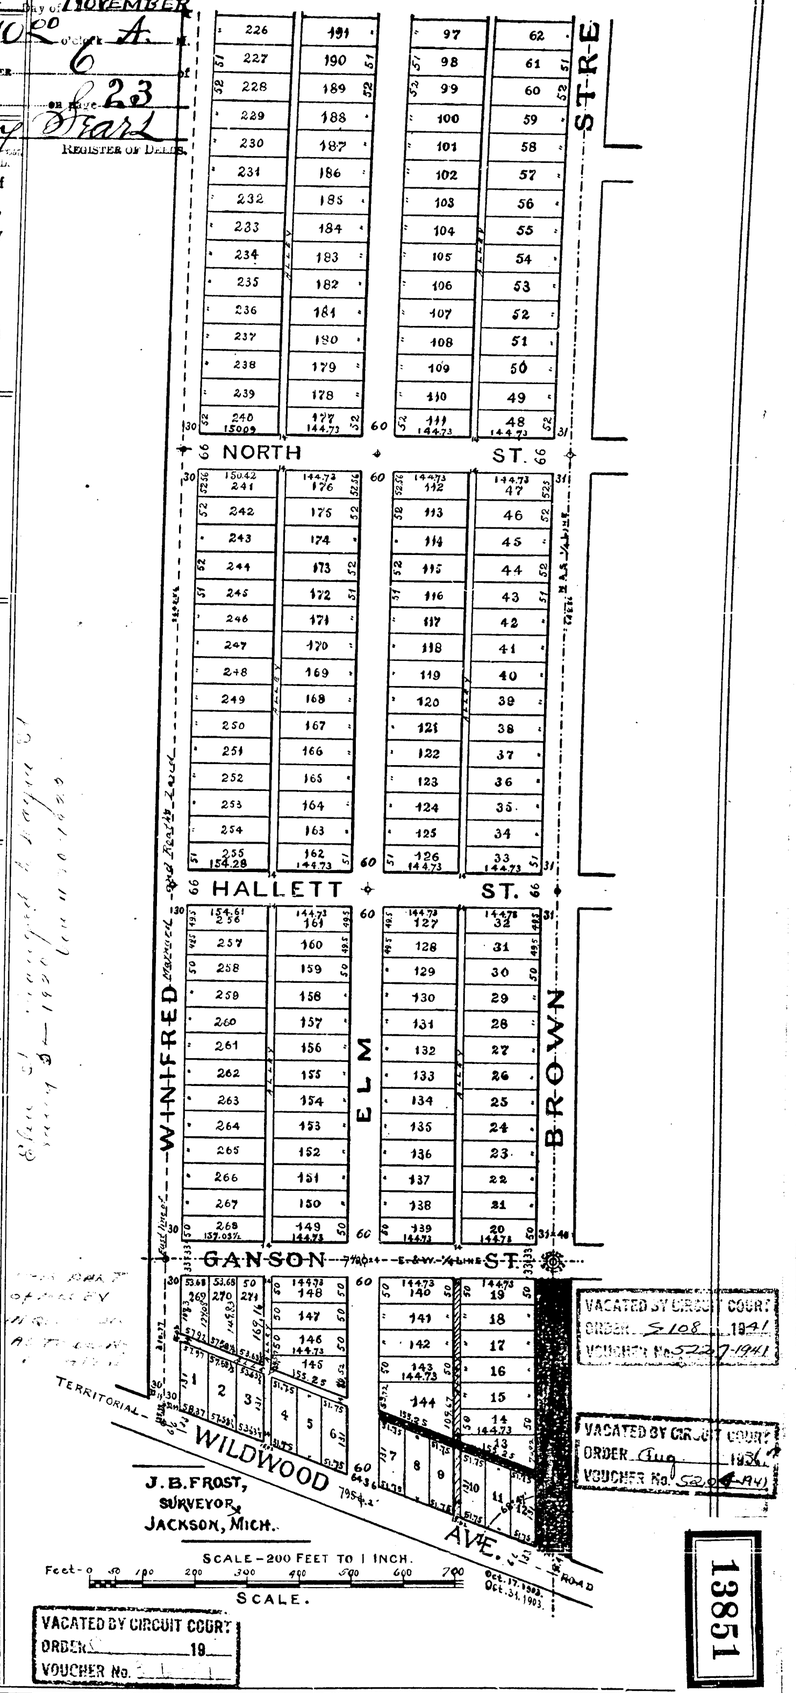

13851