

State of Michigan }
County of Houghton } S.S. This certificate made this eleventh day of November A.D. 1884
Witnesseth, that the undersigned James B. Sturges
is Receiver for the Estates of Ransom Sheldon, deceased and C.C. Douglass, deceased
the proprietors of the land embraced in the plat hereon drawn, and that the
undersigned Jas. P. Edwards, is the surveyor who made said plat.

That said plat embraces a part of Lots four (4) and five (5) in section thirty
five (35) in Township fifty-five (55) North of Range thirty-four (34) West,
particularly described as follows: Commencing at a point on the section line
between sections thirty-five (35) and thirty-six (36) town and range aforesaid,
twenty-nine and one-half feet (29 1/2) north of the quarter post on said line,
run north eighty-nine degrees and fifty-four minutes West (89° 54' W)
twenty six hundred and twenty-four (2624) feet to the north and south subdivision line
of said section thirty-five (35), thence north on said line to the shore of Portage Lake
thence north easterly along the shore of Portage Lake to the section line between
said sections thirty-five (35) and thirty-six (36), thence southerly on said section
line nine hundred and twenty-four (924) feet to the place of beginning, and is an
addition to and an extension on the West of the Village of Houghton the
plat whereof is recorded in the Register's Office of said County of Houghton
In witness whereof we have set our hands and seals this day afore mentioned.

Witness { Casper Schmitz James B. Sturges
John L. Reed James P. Edwards

WEST HOUGHTON, MICH.


Addition to Houghton
State of Michigan }
County of Houghton } S.S. On this eleventh day of November A.D. 1884
before me the undersigned a Notary
Public in and for said county, appeared James B. Sturges
and James P. Edwards to me known to be the persons
mentioned in and who submitted the foregoing certificate
and solemnly acknowledged the same to be their
free act and deed for the uses and purposes
intended by the Laws of Michigan in this
behalf made.

John L. Reed Notary Public
in and for the County of Houghton

State of Michigan }
County of Houghton } S.S. We Thos. D. Meads, Register of Deeds
of said County of Houghton, and James
P. Edwards the surveyor who made the plat of which the plat hereon
drawn is an exact duplicate, do hereby certify that we have carefully
compared the plat hereon drawn, and the certificate statement and acknowl-
edgement thereon accompanying it with the original plat of West Houghton
addition to the Village of Houghton, and the certificate statement and
acknowledgement thereof accompanying said original plat signed
and acknowledged by James B. Sturges and James P. Edwards
who made the same, and that it is an exact duplicate of said
original plat, certificate, statement, and acknowledgement and
of the whole of the same.

In witness whereof we have hereunto set our hands and seals this
eleventh day of November A.D. 1884 Thos. D. Meads
Register's Office } James P. Edwards
County of Houghton }
Received for record this eleventh day of November A.D. 1884 at Houghton, Mich.
Thos. D. Meads, Register

3 order streets
Street On PLAT VACATED
E66 VOL 2 CI VACATIONS
Page 65-68+69

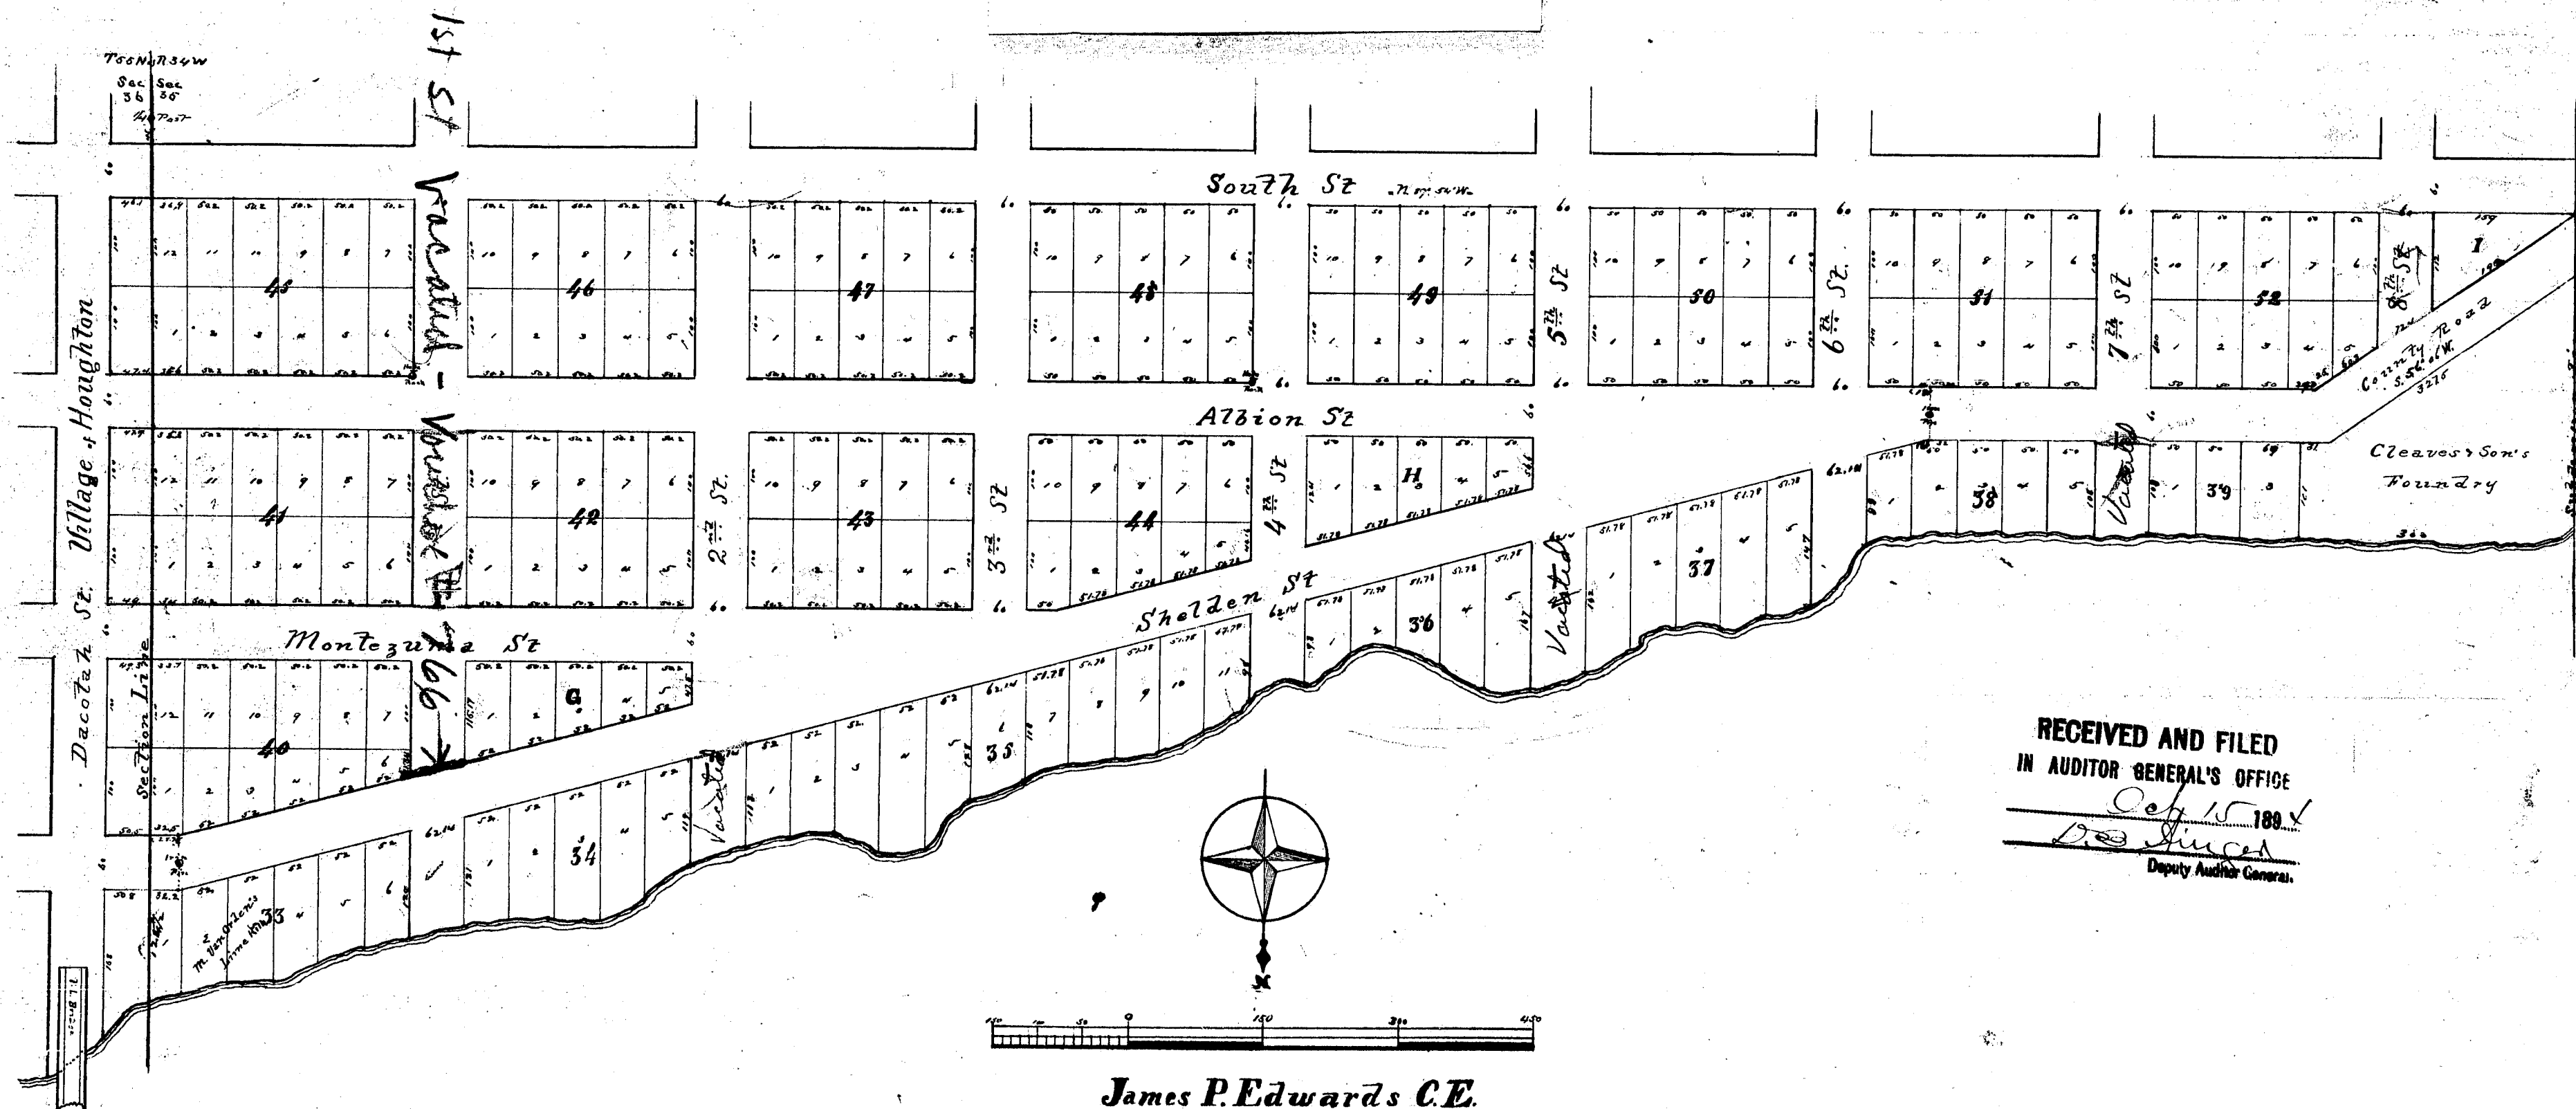

RECEIVED AND FILED
IN AUDITOR GENERAL'S OFFICE
Sep 15 1894
D. J. Juncos
Deputy Auditor General

James P. Edwards C.E.

State of Michigan } ss. This certificate made this Eleventh day of November A.D. 1884
County of Houghton }
Witnesseth, that the undersigned James B. Sturgis
is Receiver for the Estates of Ransom Sheldon deceased and C.C. Douglas deceased
the proprietors of the land embraced in the plat hereon drawn and that the
undersigned Jas. P. Edwards, is the surveyor who made said plat.

That said plat embraces a part of Lots four (4) and five (5) in Section thirty
particularly described as follows: Commencing at a point on the section line
run North eighty-nine degrees and fifty-four minutes West (N 89° 54' W)
of said section thirty-five (35), thence north on said line to the shore of Portage Lake
thence north easterly along the shore of Portage Lake to the section line between
said sections thirty-five (35) and thirty-six (36), thence southerly on said section
addition to and an extension on the West of the Village of Houghton the
plat whereof is recorded in the Register's Office of said County of Houghton
in witness whereof we have hereunto set our hands and seals this day of November

Witness } James B. Sturgis
James P. Edwards

WEST HOUGHTON, MICH.

Addition to Houghton

State of Michigan } ss. On this Eleventh day of November A.D. 1884
County of Houghton }

Before me the undersigned a Notary
Public in and for said County, appeared James B. Sturgis
and James P. Edwards to me known to be the persons
mentioned in and who submitted the foregoing certificate

in and for the County of Houghton

3 or less streets


See also PLAT NO. 100
Vol 2 of VACATIONS
Page 65 68 & 61

State of Michigan } ss. We, Thos. D. Meads, Register of Deeds
County of Houghton }

I Edwards the surveyor who made the plat of which the plat hereon
drawn is an exact duplicate, do hereby certify that we have carefully
compared the plat hereon drawn, and the certificate statement and acknowl-
edgement thereon accompanying it with the original plat of West Houghton
addition to the Village of Houghton and the certificate statement and
acknowledgement thereof accompanying said original plat signed
and acknowledged by James B. Sturgis and James P. Edwards
who made the same, and that it is an exact duplicate of said
original plat, certificate statement, and acknowledgement and
of the whole of the same.

In witness whereof we have hereunto set our hands and seals this
Eleventh day of November A.D. 1884
Register's Office } Thos. D. Meads, Register
County of Houghton } James P. Edwards

Received for record this Eleventh day of November A.D. 1884 at Houghton, Mich.
Thos. D. Meads, Register

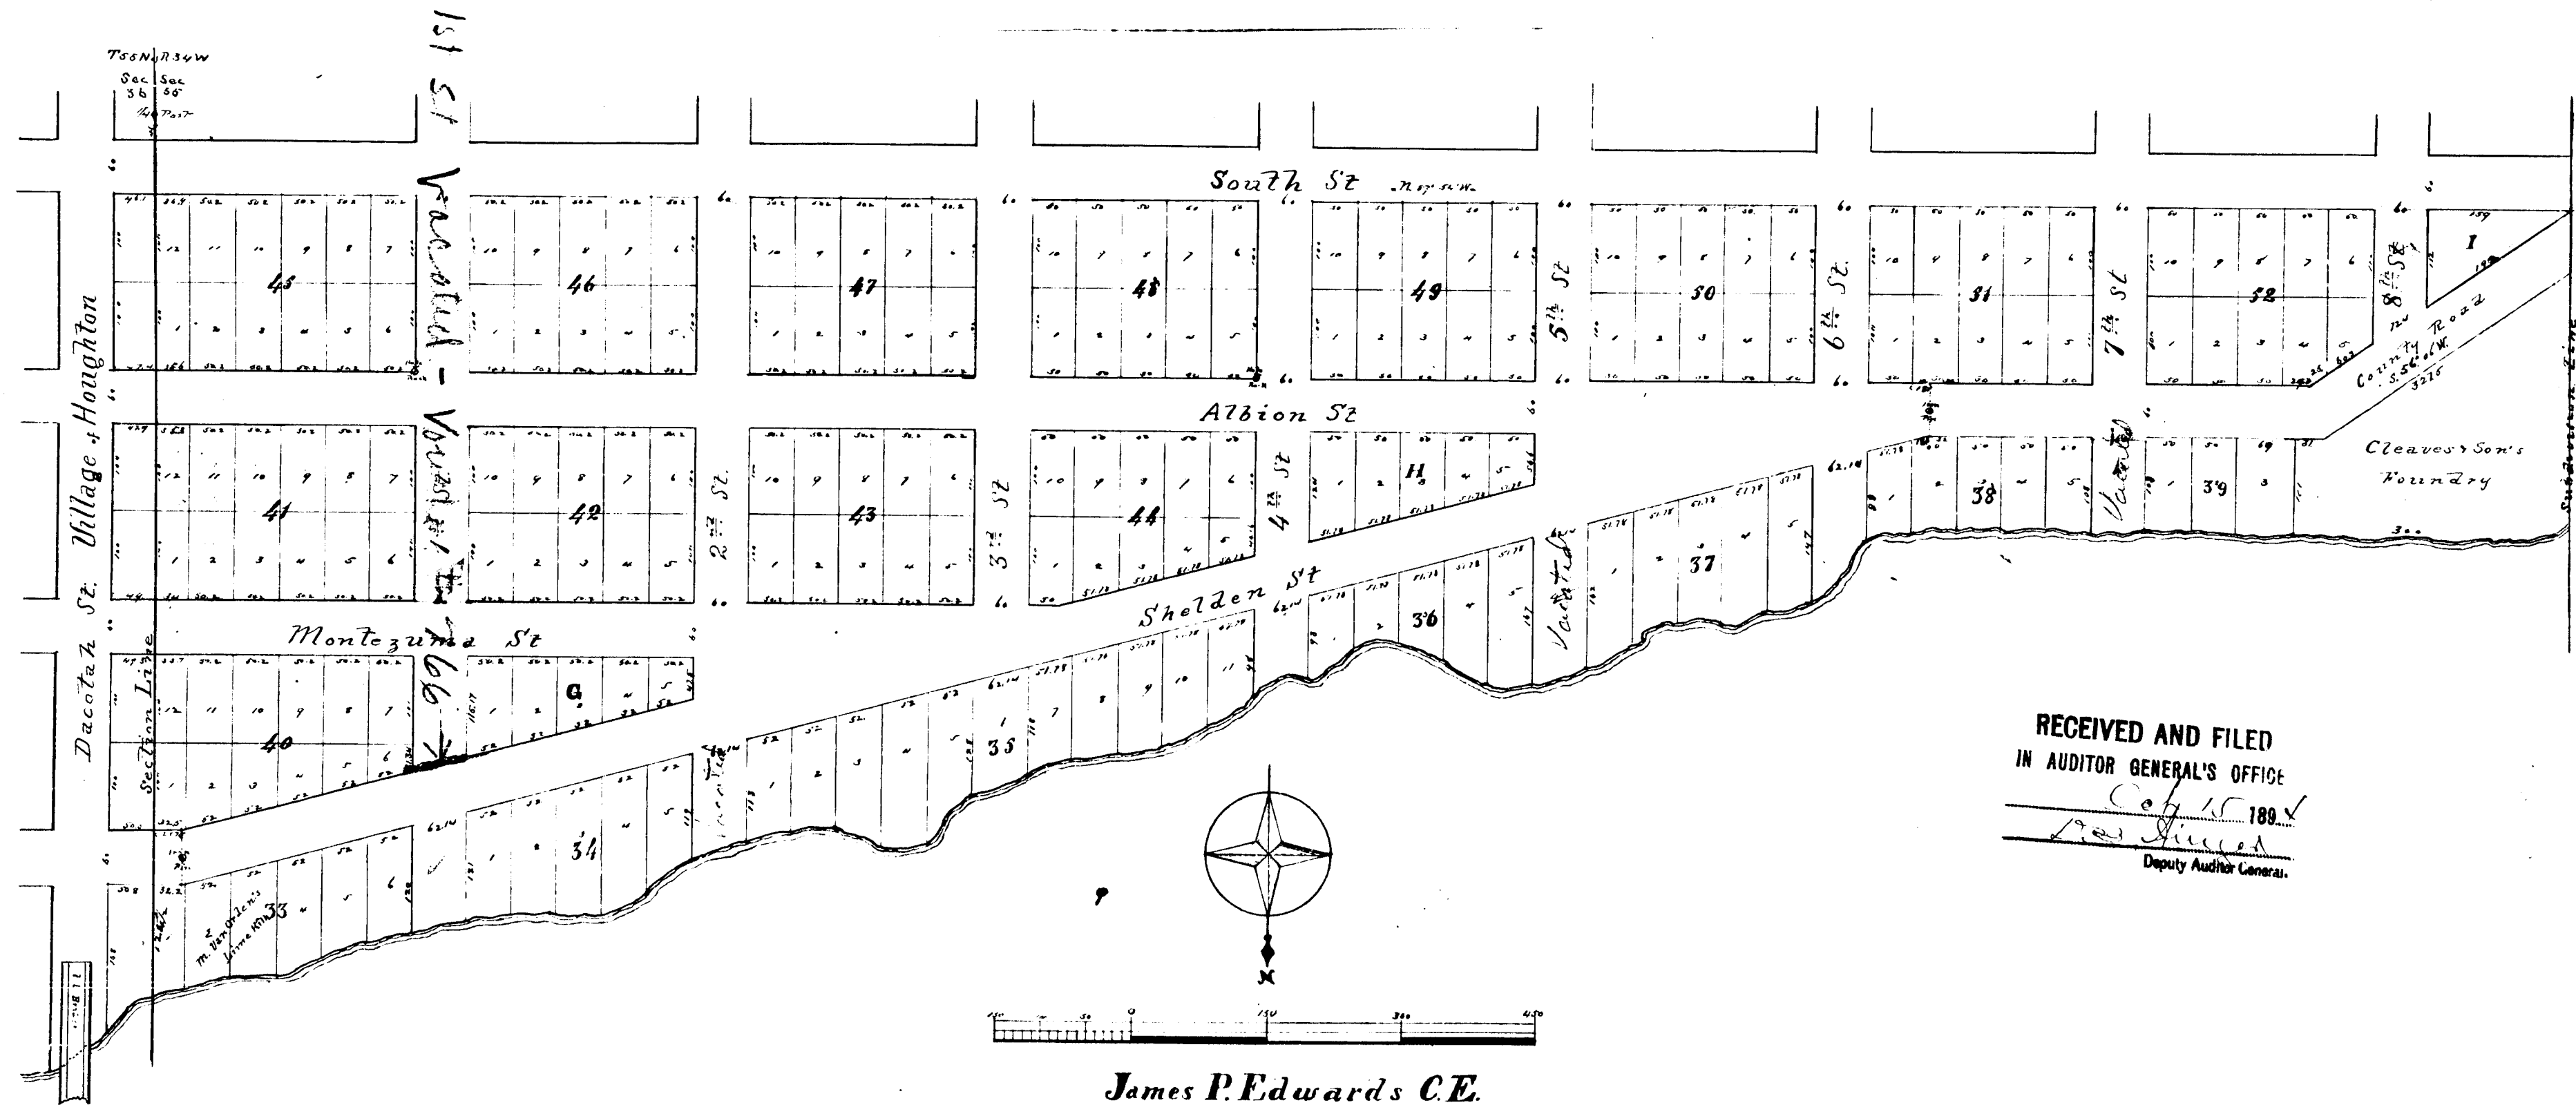

13971

503

RESOLUTION # 95-743

At a regular meeting of the City Council of Houghton, Michigan, held at the City Hall on 4-12-95; the following resolution was offered by member Blumhardt, and supported by member Peterson.

NOW THEREFORE IT IS RESOLVED:

In accordance with Section 560.256 of Act 288, P.A. 1967, as amended, that portion of Lakeshore Drive lying within Blocks 7 and 8 of the Plat of the Village of Houghton, Liber 1, Page 17 of Plats; and also lying within Blocks 33,34,35,36,37,38, and 39 of the Plat of West Houghton, Liber 1, Page 15 of Plats; is opened, and the City of Houghton, as owner, dedicates this street for public use.

The right-of-way of Lakeshore Drive is described as follows:

A sixty (60) foot right-of-way being thirty (30) feet each side of the following described centerline:

Beginning in the centerline of Quincy Street at a point 53.4 feet north of the South line of Lot 5, Block 7, original Plat of the Village (now City) of Houghton, extended west; thence N-82°-06'-32"-W 30.00 feet to the west right-of-way line of Quincy Street extended north; thence N-86°-18'-09"-W 166.38 feet; thence 95.36 feet along a curve to the left with a delta angle of 18°-12'-46" and a radius of 300.00 feet, having a chord bearing S-84°-35'-28"-W 94.96 feet; thence S-75°-29'-05"-W 532.71 feet; thence 107.01 feet along a curve to the right with a delta angle of 34°-31'-42" and a radius of 177.57 feet, having a chord bearing N-87°-15'-04"-W 105.40 feet; thence 107.01 feet along a curve to the left with a delta angle of 34°-31'-42" and a radius of 177.57 feet, having a chord bearing N-87°-15'-04"-W 105.40 feet; thence S-75°-29'-05"-W 791.15 feet; thence 200.19 feet along a curve to the right with a delta angle of 04°-17'-43" and a radius of 2670.38 feet, having a chord bearing S-77°-37'-56"-W 200.14 feet; thence 200.19 feet along a curve to the left with a delta angle of 04°-17'-43" and a radius of 2670.38 feet, having a chord bearing S-77°-37'-56"-W 200.14 feet; thence S-75°-29'-05"-W 272.85 feet; thence 673.82 feet along a curve to the right with a delta angle of 32°-10'-21" and a radius of 1200.00 feet, having a chord bearing N-88°-25'-45"-W 665.00 feet; thence 230.54 feet along a curve to the left with a delta angle of 94°-20'-45" and a radius of 140.00 feet, having a chord bearing S-60°-29'-00"-W 205.35 feet; thence 191.67 feet along a curve to the left with a delta angle of 40°-40'-27" and a radius of 270.00 feet, having a chord bearing S-07°-01'-37"-E 187.67 feet; thence 250.46 feet along a curve to the left with a delta angle of 84°-24'-51" and a radius of 170.00 feet, having a chord bearing S-69°-34'-16"-E 228.42 feet; thence N-68°-12'-18"-E 173.96 feet; thence N-56°-01'-52"-E 106.52 feet; thence S-89°-59'-36"-E 30.97 feet; thence N-68°-13'-20"-E 80.00 feet; thence 46.68 feet along a curve to the right with a delta angle of 53°-29'-29" and a radius of 50.00 feet, having a chord bearing S-85°-01'-56"-E 45.00 feet to the northerly right-of-way line of Highway M-26, which is the point of ending of this centerline description.

Resolution duly adopted

Kurt Kuus
(City Clerk)

Certified to be a true copy,

4-13-95
(Date)

Kurt Kuus
(City Clerk)



U.P. ENGINEERS & ARCHITECTS, Inc.
ENGINEERING ARCHITECTURE PLANNING
100 Portage Street • Houghton, Michigan 49931
(906) 482-4610 • WATS (800) 562-7684 • FAX (906) 482-9799

MAY 18 1995
memo
13971

Date: May 15, 1995


To: Maynard R. Dyer, P.S., Manager
Subdivision Control Unit
P.O. Box 30004
Lansing, Michigan 48909

Subject: Project No. 480
Plat of Lake Shore South
Recorded copy of resolution opening
Lake Shore Drive

Please find enclosed recorded copy of City of Houghton Resolution # 95-743 for your files. Thank you for your help in getting this matter squared away and the plat recorded.

☐ Please reply ☐ No reply necessary

Dennis R. Destrampe
SIGNATURE Dennis R. Destrampe, P.S.

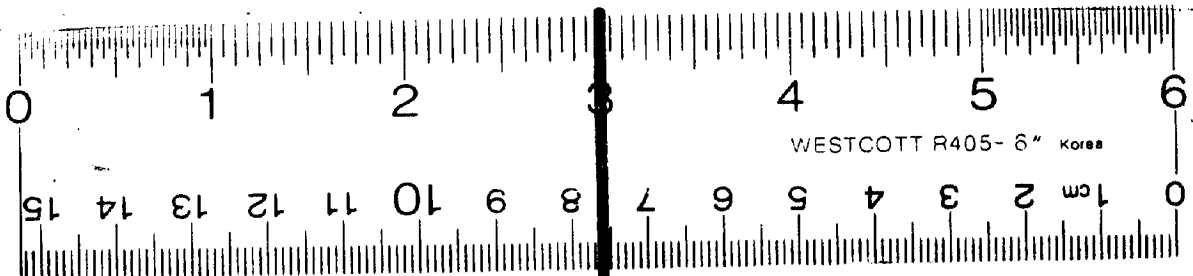

16 X

✓ PLAT - WEST HOUGHTON

In re petition)
Anna Smith et al
to Vacate 8th)
Street in part)

ORDERED : That the following described portion of 8th Street, a street appearing on the plat of West Houghton, of record in office of Register of Deeds for Houghton County, recorded therein November 21, 1884 to wit; 8th Street from a point in said Street where it joins the Street marked "County Road" to the point in said 8th Street where it joins the Street marked "South Street" be and the same is hereby VACATED and that the title to said land so described and vacated, shall vest in the person or persons owning the property in each side thereof to the center of said Street and shall be attached to the lots bordering in said street in manner aforesaid free and clear from any public easement therein.

Judge Wm B Williams
November 20, 1888
Cal No. 732

And Gen Dept Vol 67/7/
Page 4185 13971

Eddy & Bennett
Plat Examiners
September 1915

✓ PLAT- VILLAGE OF HANCOCK


In re petition)
Quincy Mining Co
to vacate part)
of Plat)

ORDERED: " That Blocks B&C&12 in the Village of Hancock, Houghton County, Michigan and that part of Franklin Street lying between said Blocks C & 12 and West of Ravine Street, also that part of RESERVATION STREET in said Village lying South of Water Street and extending from said Water Street to Portage Lake be and the same are hereby VACATED.

Order Judge D. Goodwin
August 19, 1860
Cal No A
Found in Liber Blank Page
Court Jour. 1848 to 1864

And Gen Dept
Vol 145 11812 ✓
Page 11157-8

Eddy & Bennett
Plat Examiners
September 1915

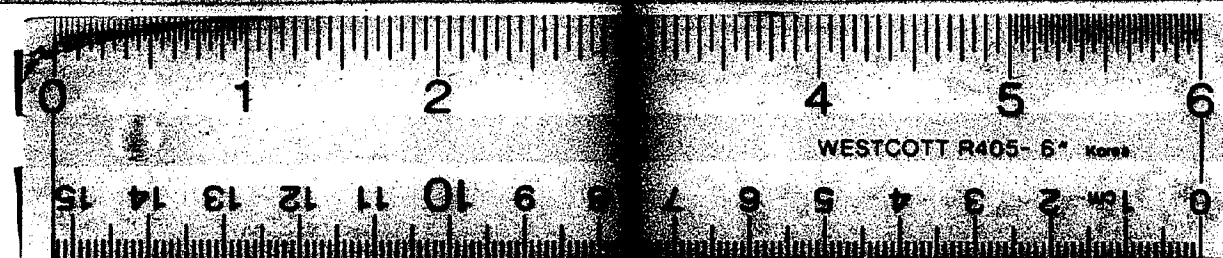

16 X

✓

PLAT - WEST HOUGHTON

In re petition)
Anna Smith et al)
to vacate parts)
of Streets)


Note; The original petition also asked for vacation part of First Street from its intersection with Montezuma Street to Portage Lake, but the Caption of Order omits same as also does the order without explanation)

Order Judge Wm. D. Williams
May 29, 1889 Cal No. 769

ORDERED: That that part of SECOND Street lying between Sheldon Street and Portage Lake; and that part of FIFTH Street lying between Sheldon Street and Portage Lake and that part of SEVENTH STREET lying between Sheldon and Portage Lake in said town of West Houghton, be and the same are hereby VACATED and that the title to said land so vacated shall vest in the person or persons owning the property in each side thereof to the center of said Streets and shall be attached to the lots bordering in said portions of said streets in manner aforesaid and clear from any public easement therein,

Aud Gen Dept Vol. 67 171
Page 4155 13971

Eddy & Bennett
Plat Examiners
September 1915

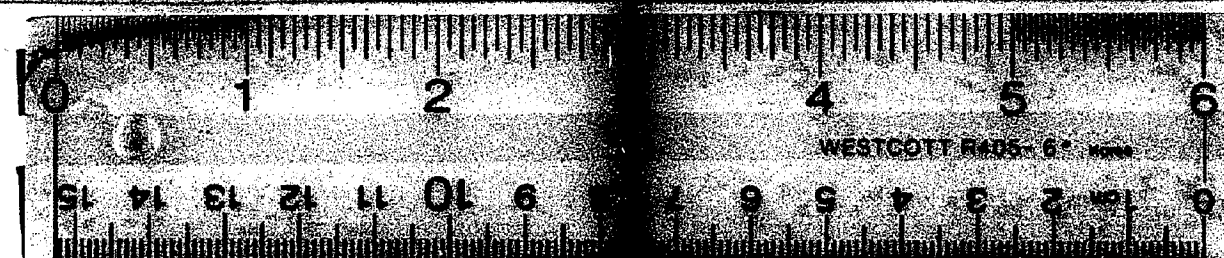

16 X

HOUGHTON County

Vacations and alterations
of
PLATS

PLAT- WM HARRIS ADDITION TO TORCH LAKE CITY

In re petition)
WM Harris to)
Vacate part of)
Harris Street)

ORDERED: That that part of Harris Street in said Addition described as "Commencing at a point in North and South center Section line of Section 6, Town 55 N R 32 W, 417.41 feet, South of Center said Section thence running South on said center section line 15.09 feet, thence North 89° 39' 30" East 56.33 feet, thence in a direct line 57.98 feet to place of beginning, containing an area of 600.89 square feet" be and the same is hereby VACATED and is attached to Lot 12 Block 3, of said Addition.

Order Judge Wm B Williams
May 25, 1886
Cal No. 605

Aud Gen Dept Vol 145
Page 11162
11816✓

E & B Plat Examiners
September 1915

PLAT - WEST HOUGHTON


In re petition)
Anna Smith)
al to Vacate)
part of First Street)

ORDERED: That that portion of said FIRST Street from a point on said Street where it joins the Street marked Montezuma, to the Point on said First Street where the same joins the Street marked "Albion" be and the same is hereby VACATED. The title of said lands so described and vacated shall vest in the person or persons owning the property on each side to the center of said street, and shall be attached to the Lots bordering on said Street.

Order Judge Wm B Williams
May 21, 1888
Cal No. 700

Aud Gen Dept Vol 87 171
Page 4155
13971✓

E and B Plat Examiners
September 1915

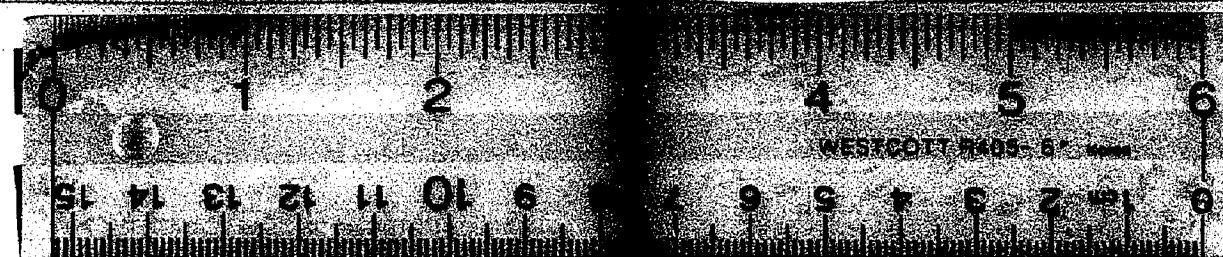

16 X