

AMENDED PLAT OF THE

RECEIVED AND FILED

In Auditor General's Office

December 20 1886

W. H. Pratt

TOWN

OF

GROVER

Lot 2 Sec. 12 T. 55 N. R. 33 W

County of Houghton } ss. This certificate made this 13th day of August 1886.
State of Michigan }

Witnesseth, That the undersigned Dominick A. Sutter and Herman C. Guck are the proprietors of the land embraced in the plat hereon drawn, and that the undersigned James P. Edwards is the Surveyor who made said plat.

That said plat embraces all of Lot two (2) of section twelve (12) in Township fifty-five (55) North of Range thirty-three (33) West of the Meridian of Michigan.

In witness whereof we have set our hands and seals this day above mentioned.

Stephen C. Pinchault }
H. Wilson } { Dominick A. Sutter [ES]
Herman C. Guck [ES]
James P. Edwards [ES]

County of Houghton } ss. On this 13th day of August 1886.
State of Michigan }

Before me the undersigned a Notary Public in and for the said County of Houghton appeared Dominick A. Sutter, Herman C. Guck and James P. Edwards. The persons mentioned in and who subscribed the foregoing Certificate and personally acknowledged the same to be their free act and deed for the uses and purposes intended by the Laws of Michigan in this behalf made.

W. H. Pratt, Notary Public

Examined and Approved Dec 1st 1886. R. H. Pratt Deputy Auditor Genl.

State of Michigan }

County of Houghton } ss. We the D. Meade, Register of Deeds and James P. Edwards Surveyor, hereby certify that we have separately, carefully compared this duplicate plat with the original ^{amended} plat of the Town of Grover and that it is an exact duplicate thereof and of the whole of such map.

W. D. Meade, Register of Deeds
James P. Edwards Surveyor

Registers Office } ss. Received for Record this 13th day of December 1886.

County of Houghton }

State of Michigan } and Recorded in the Plat Book for Towns and Villages Page 2.

County of Houghton } ss. We the D. Meade, Register of Deeds and James P. Edwards Surveyor, hereby certify that we have separately, carefully compared the amended copy with the duplicate plat of the Town of Grover

none of record in the office of said Register of Deeds and that it is a true transcript thereof and of the whole of such duplicate plat as recorded.

W. D. Meade, Register of Deeds
James P. Edwards Surveyor


At a regular term of the Circuit Court for the County of Houghton continued and held at the Court House in the Village of Houghton in said County on Tuesday the twenty seventh day of July in the year of our Lord one thousand eight hundred and eighty six Present

The Honorable William D. Williams
Circuit Judge


The Court opened for business in due form

In the matter of the Petition of D. A. Sutter and others to vacate part of the Town of Grover

On reading the petition of Dominick A. Sutter, Herman C. Guck, Joseph S. Weber, Allan E. Antyre, John C. McDonald, Larkella Mills and James Collicie, duly verified by them and filed in this Court on the 19th day of June A.D. 1886, praying for the vacation and alteration of the Town of Grover hereinafter particularly described to the end that the errors of the plat of the Town of Grover may be corrected and for

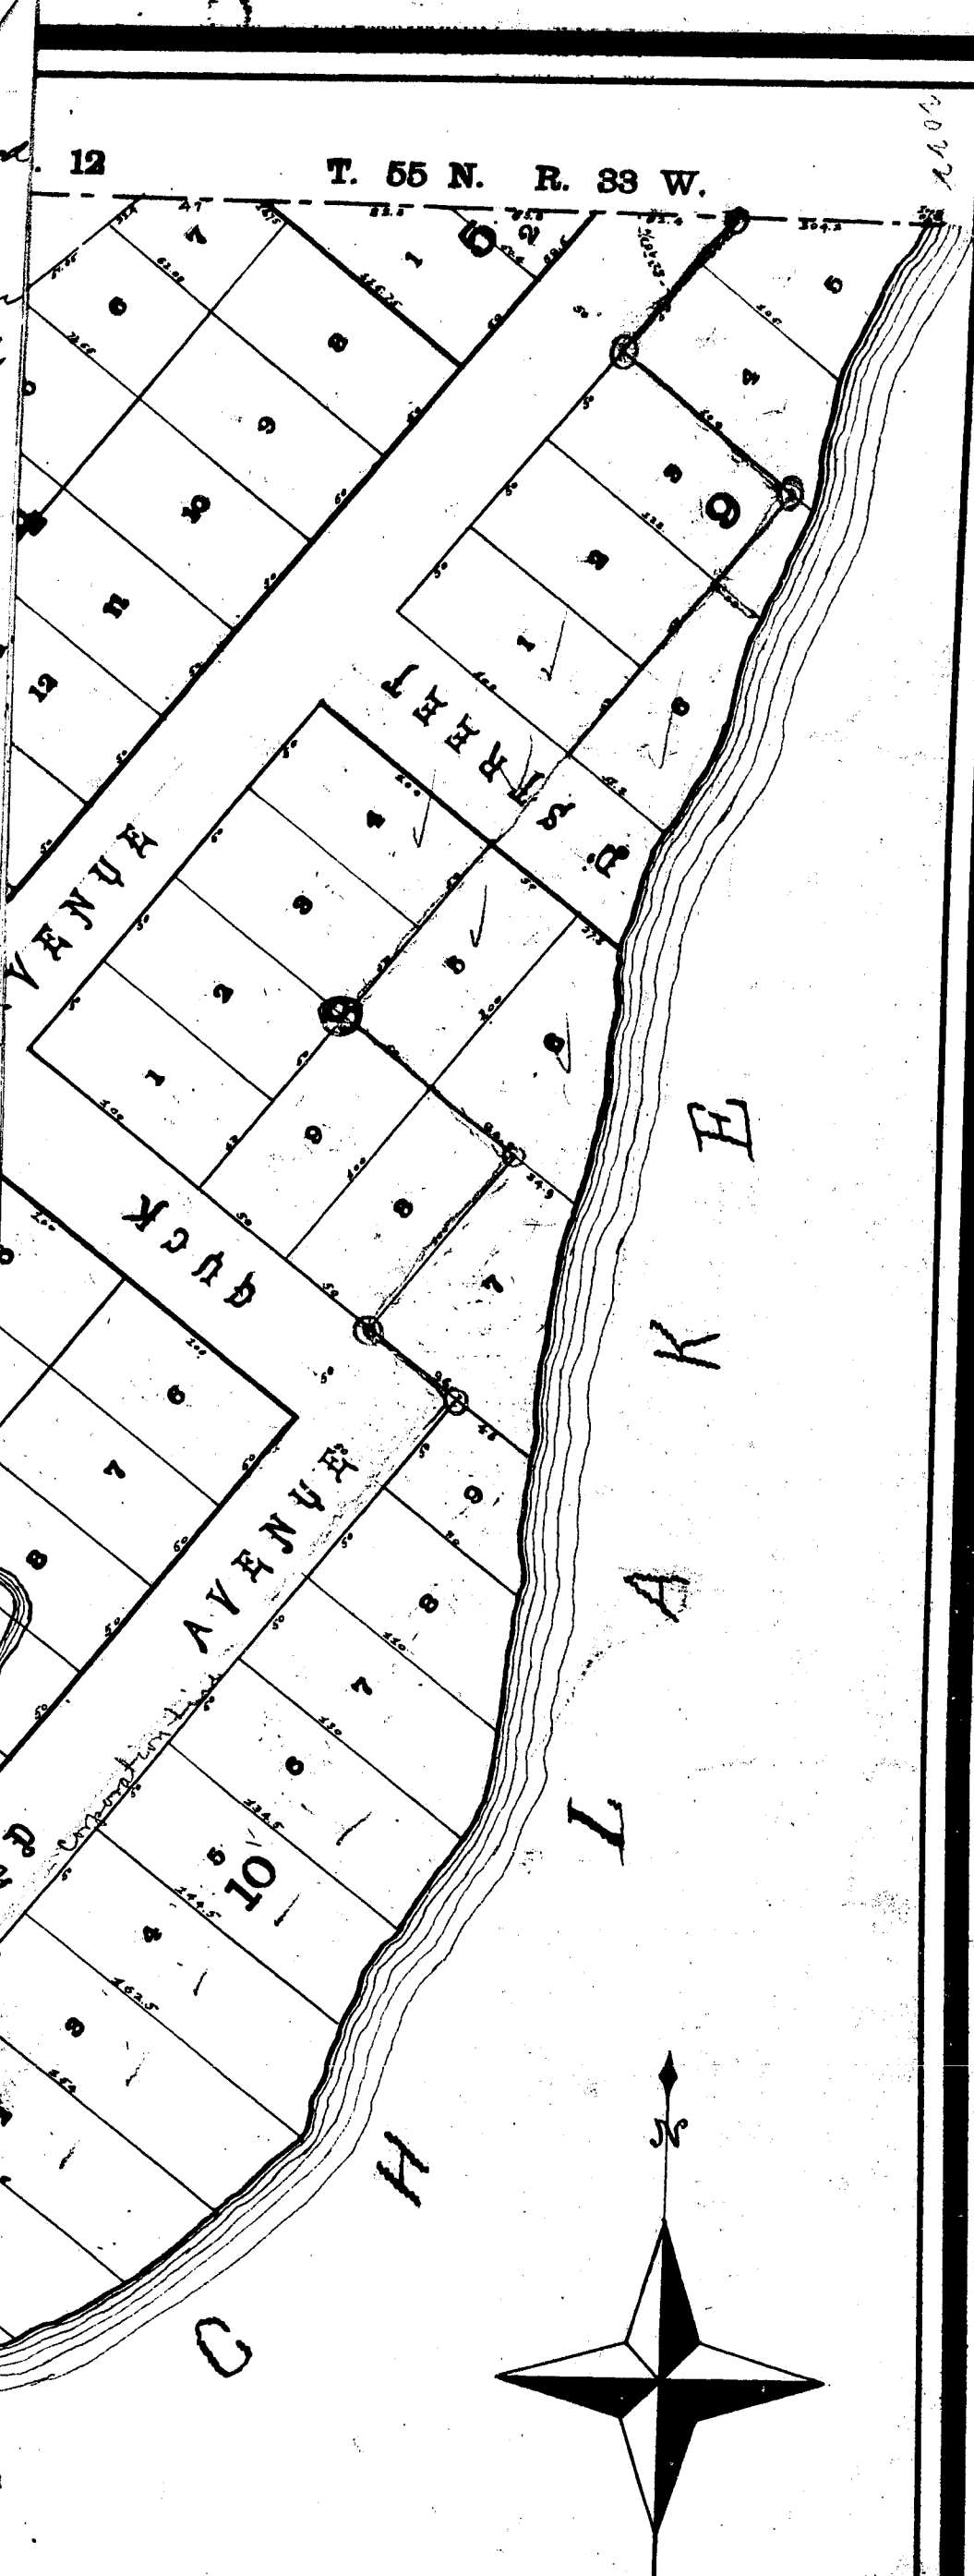

Street On PLAT VACATED
See VOL-2 (1) VACATION
Page 58

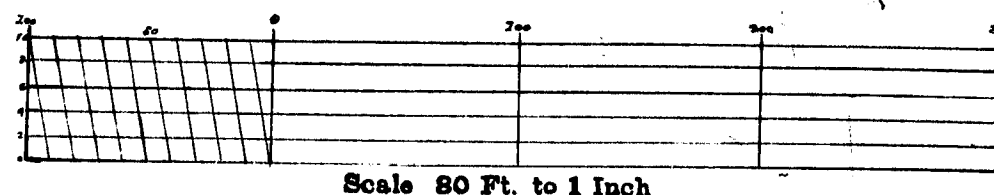

Jas. P. Edwards, C.E.

13977

AMENDED PLAT OF THE

December 20 86
R. H. Batt

TOWN
OF
GROVER

Lot 2 Sec. 12 T. 55 N. R. 33 W

County of Houghton } State of Michigan } ss. This certificate made this 13th day of August 1886
Witness that the undersigned Lemuel A. Satter, Herman C. Quack
and Herman C. Quack are the proprietors of the town embraced in the plat
shown drawn, and that the undersigned James P. Edwards is
the Surveyor who made said plat.

Said plat embraces all of lot two (2) of section twelve (12) in
township fifty-five (55) North of Range thirty-three (33) West of the
Meridian of Michigan.

and we have set our hands and seals this day
above mentioned.

Witness my hand and seal this day
of August 1886.
Lemuel A. Satter (25)
Herman C. Quack (25)
James P. Edwards (25)

County of Houghton } State of Michigan } ss. On this 13th day of August 1886
before me the undersigned a Notary Public in and for the said County
of Houghton, appeared Lemuel A. Satter, Herman C. Quack
and James P. Edwards the persons mentioned in and who sub-
scribed the foregoing certificate and personally acknowledged the
same to be their free act and deed, and the uses and purposes
intended by the laws of Michigan in the behalf made.

Witness my hand and seal this day
of August 1886.
R. H. Batt Deputy Auditor Gen.
State of Michigan.

County of Houghton } ss. The Notary Public, E. J. S. and James
Edwards, who are hereby certify that we have carefully com-
pared this duplicate plat with the original plat of the Town of Grover
and that it is an exact duplicate thereof, and the whole of the map and
the whole of the plat.


Notaries Office } ss. Received for Record this 13th day of December 1886
County of Houghton } and recorded in the Plat Book for Town and Village (Page 21)


I a regular term of the Circuit
Court for the County of Houghton continued
and held at the Court House in the
Village of Houghton in said Territory on
Thursday the twenty seventh day of
the month of June 1886 one thousand
eight hundred and eighty six
Present

The Honorable William L. Edwards
Circuit Judge


The Court of said for business in the form

In the matter of the petition
of L. H. Satter and others
to vacate part of the
Town of Grover

On reading the
petition of Dominick E. Satter, Herman
C. Quack, Joseph E. Satter, John E.
Satter, John E. McDonald, Isabella
Smith and James Satter, duly veri-
fied by them and filed in this Court
on the 19th day of June 1886, praying
for the vacation and relocation of
the Town of Grover hereinafter, but
particularly described to be and that
the errors of the plat of the Town
of Grover may be corrected and for

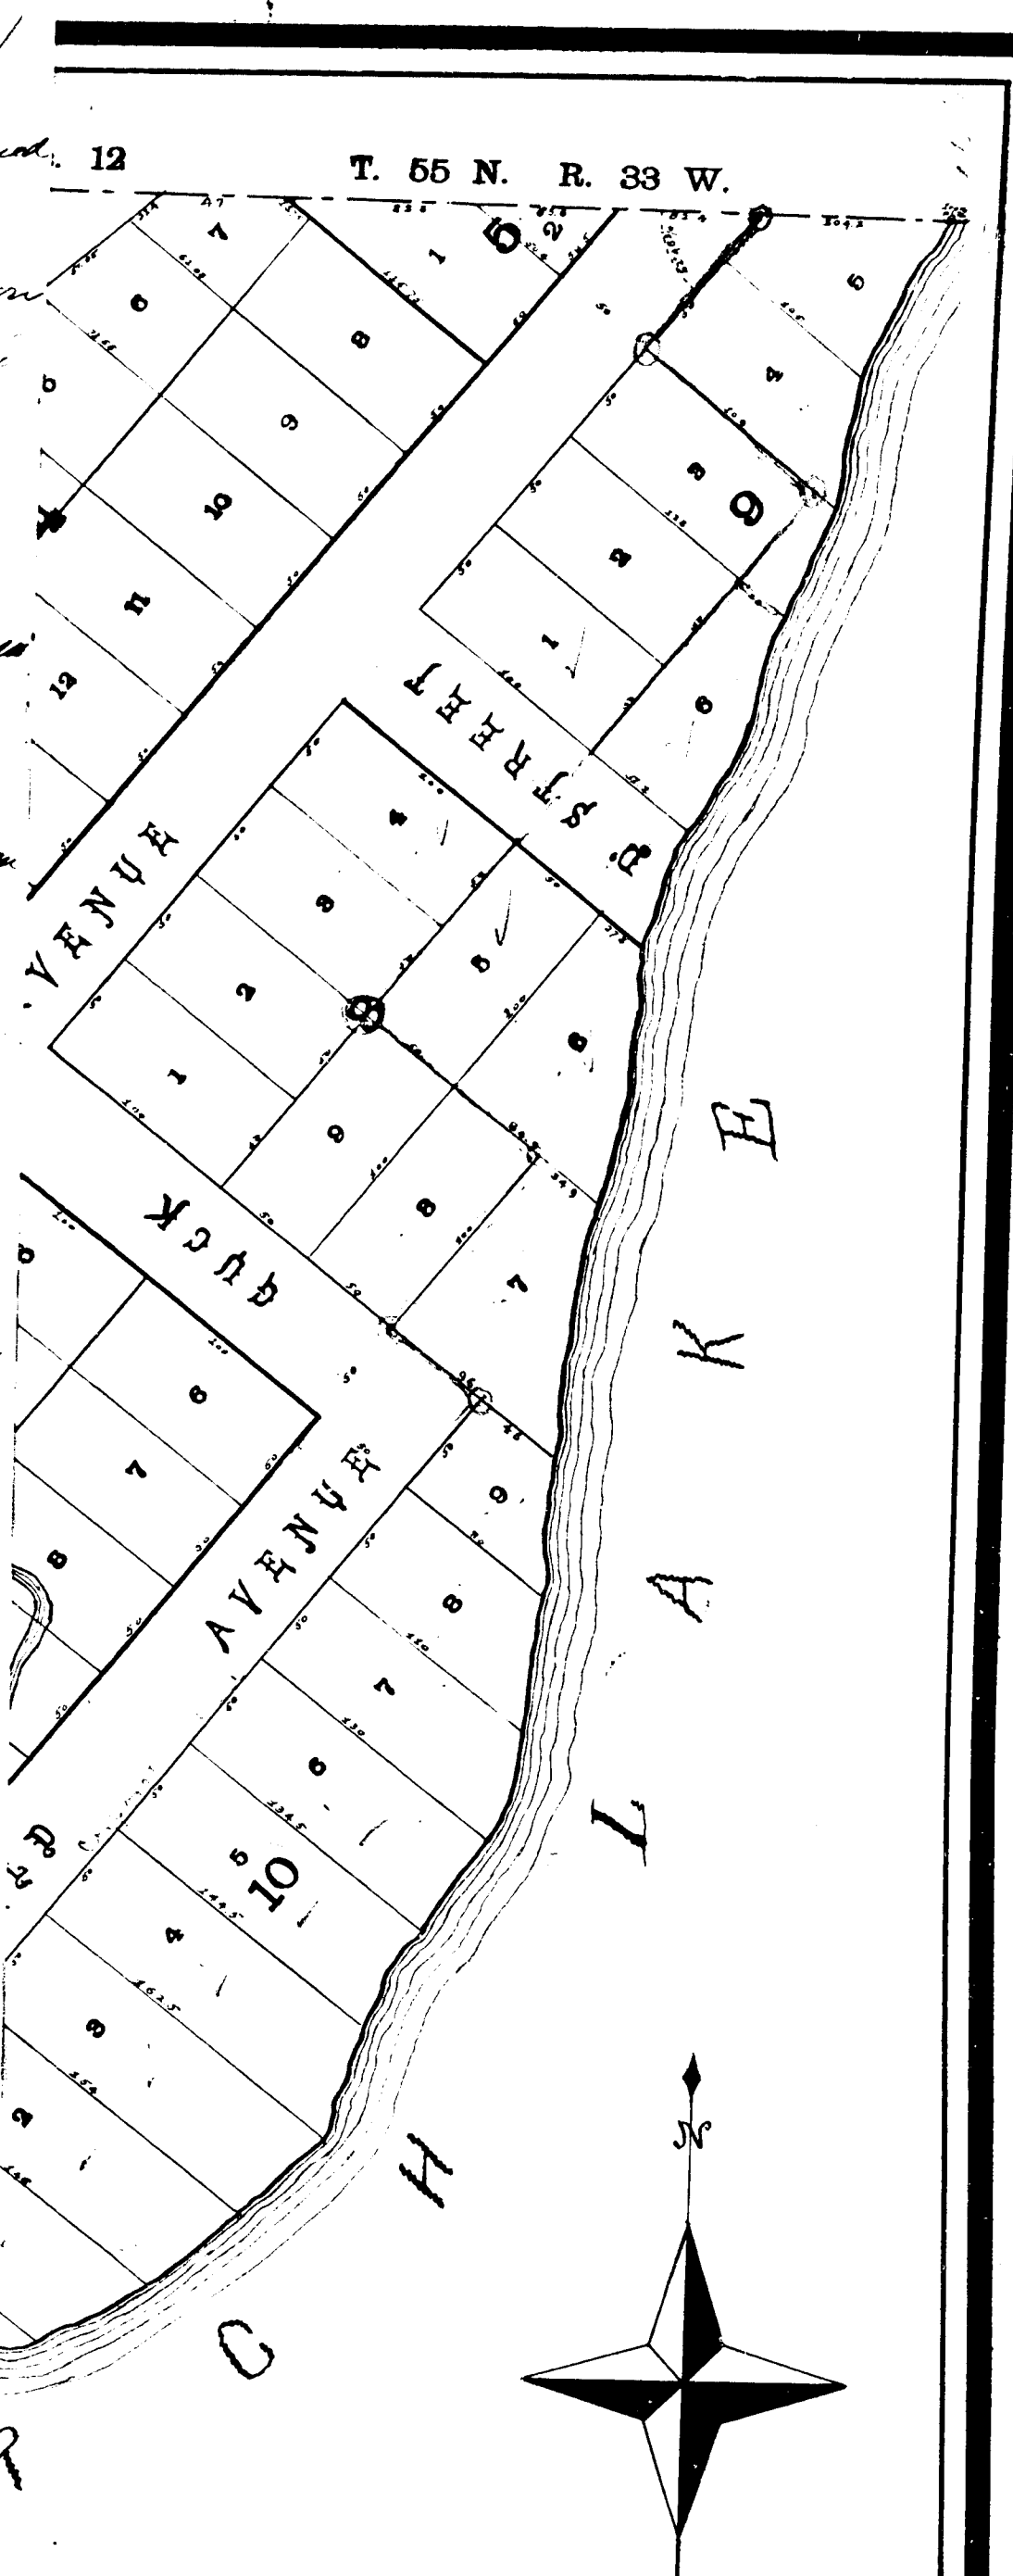

Street On PLAT AND TID
See VOL-2 (1) VACATION
Page 58

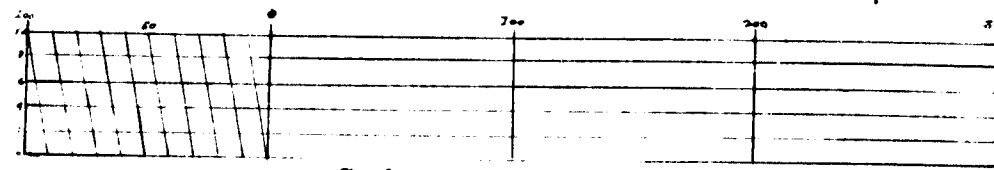

Jas. P. Edwards, C.E.

13977

PLAT - AMENDED PLAT BORN OF GROVER


In re petition)
Calumet & Hecla
Mining Co to vacate
D Street.

ORDERED- That said space marked "D" Street as a fore-
said, and the whole of such space from its junction or place of intersection
with the street or road on said plat marked Grant Avenue, to the shore of Torch
Lake be and the same is hereby VACATED and declared, to be no longer a street
or public place. And it is further ORDERED: That the space and area constituting
said D Street on said plat, so called, shall vest in the owners of the lots
bordering on said D Street as shown by said plat, to wit; in the owners of the
following lots marked upon said plat as lots one(1) and six(6) in block nine(9)
and lots four (4) five (5) and six(6) in block eight(8) and be attached to said
lots as follows; to wit; That the area and territory of said D Street south-
westerly of a line drawn through the center thereof, from the southerly line
of said Grant Avenue, to the shore and waters of Torch Lake, shall become a
part of lots 4,5 and 6 in Block 8, said lot 4 taking such part of the same as
will fall within said centre line and the end lines of lot 4 protracted to
said centre line; said lot 5 taking such part as will fall within said centre
line and the end lines of said lot protracted to said centre line; said lot
6 taking such part as will fall within said centre line, the shore and waters
of Torch Lake, and the boundary line of said lot 6, which runs to D Street at
right angles therein. That the area and territory of said D Street northeast-
erly of a line drawn through the centre thereof from the southerly line of said
Grant Avenue, to the shore and waters of Torch Lake, shall become a part of
lots 1 and 6, in Block 9, said lot 1 taking such part of same as will fall with-
in said centre line and the end lines of said lot 1 protracted to said
centre line and lot 6, in block 9 taking such part as will fall within said
centre line, the shore and waters of Torch Lake, and the boundary line of
said lot 6 in block 9 which runs to D Street, at right angles therewith.

Order of Judge A.T.Streeter
January 15, 1900
Cal No. 1779

And Gen Dept Vol 55171
Page 2022/13977

Eddy and Bennett
Plat Examiners
September 1915

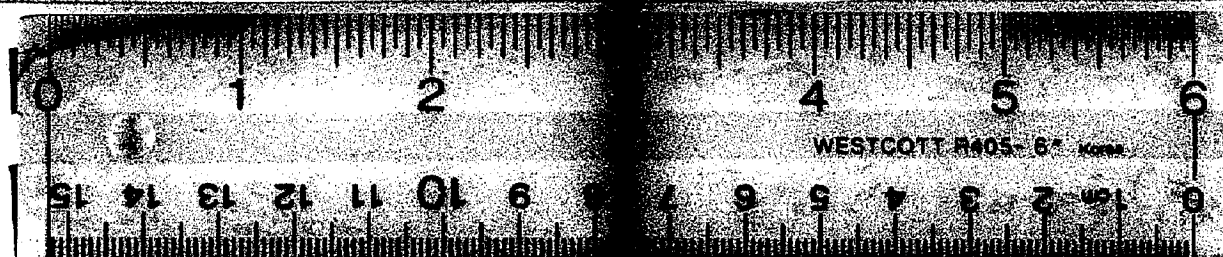

16 X

Continuation of order VACATED the Plat Town of Grover


ITORY INCLUDED in the same be attached to Block "F" as indicated in said "Exhibit B" and numbered lots "1" and "2" and that the tract or parcel of land lying South of said last mentioned lots "1" and "2" and West of said right of Way be and the same is hereby platted and established as Block "F"

That a Street be and hereby is established running North Westerly and South Easterly, called "E" Street and consists of a strip of land fifty feet, in width off the south West side of Block "G" and the remaining portion of Block "G" be platted into lots numbered "1" to "12" inclusive as indicated in said "Exhibit B" by virtue of the Statutes of this State in such case made and provided, and it is here by further ordered that the rights of all parties as existing under the original plat be preserved.

Order of Judge
William D. Williams
July 27, 1886
Cal No. 615

Aud Gen Dept Vol 33/7/
Page 2022/3977 171
Amending original plat Vol 67
Page 4153/3973 ✓

Eddy & Bennett
Plat Examiners
September 1915

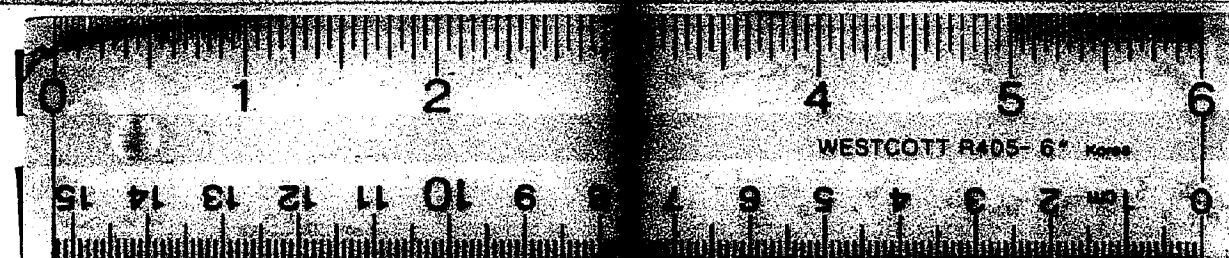

16 X