


# PARK ADDITION


TO THE  
VILLAGE OF HOUGHTON, MICH.

Portions of Lot 6 and S.E. 1/4 of S.W. 1/4 of  
Sec. 31, T. 55, N. R. 33 W.

SCALE 200 FT.=1 IN.

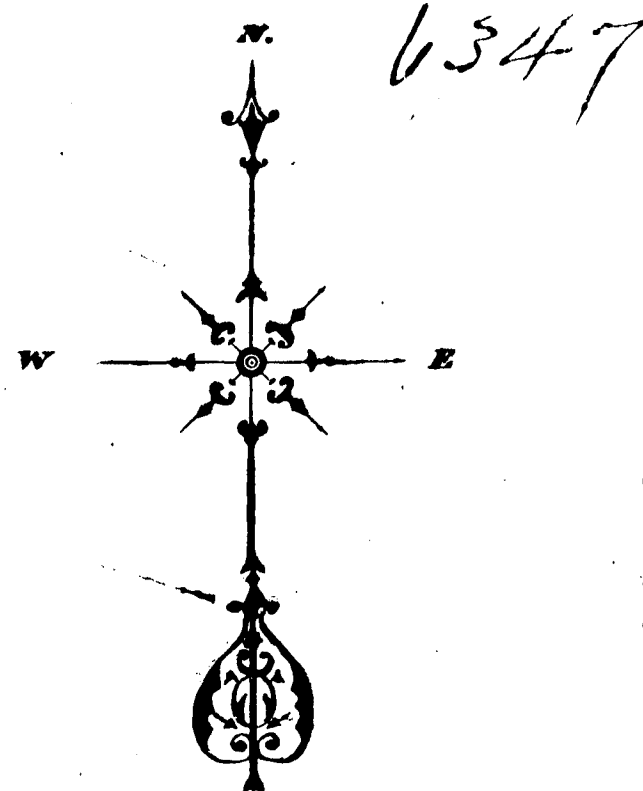

Street On PLAT VACATED  
See VOL 2 of VACATION  
Page-67

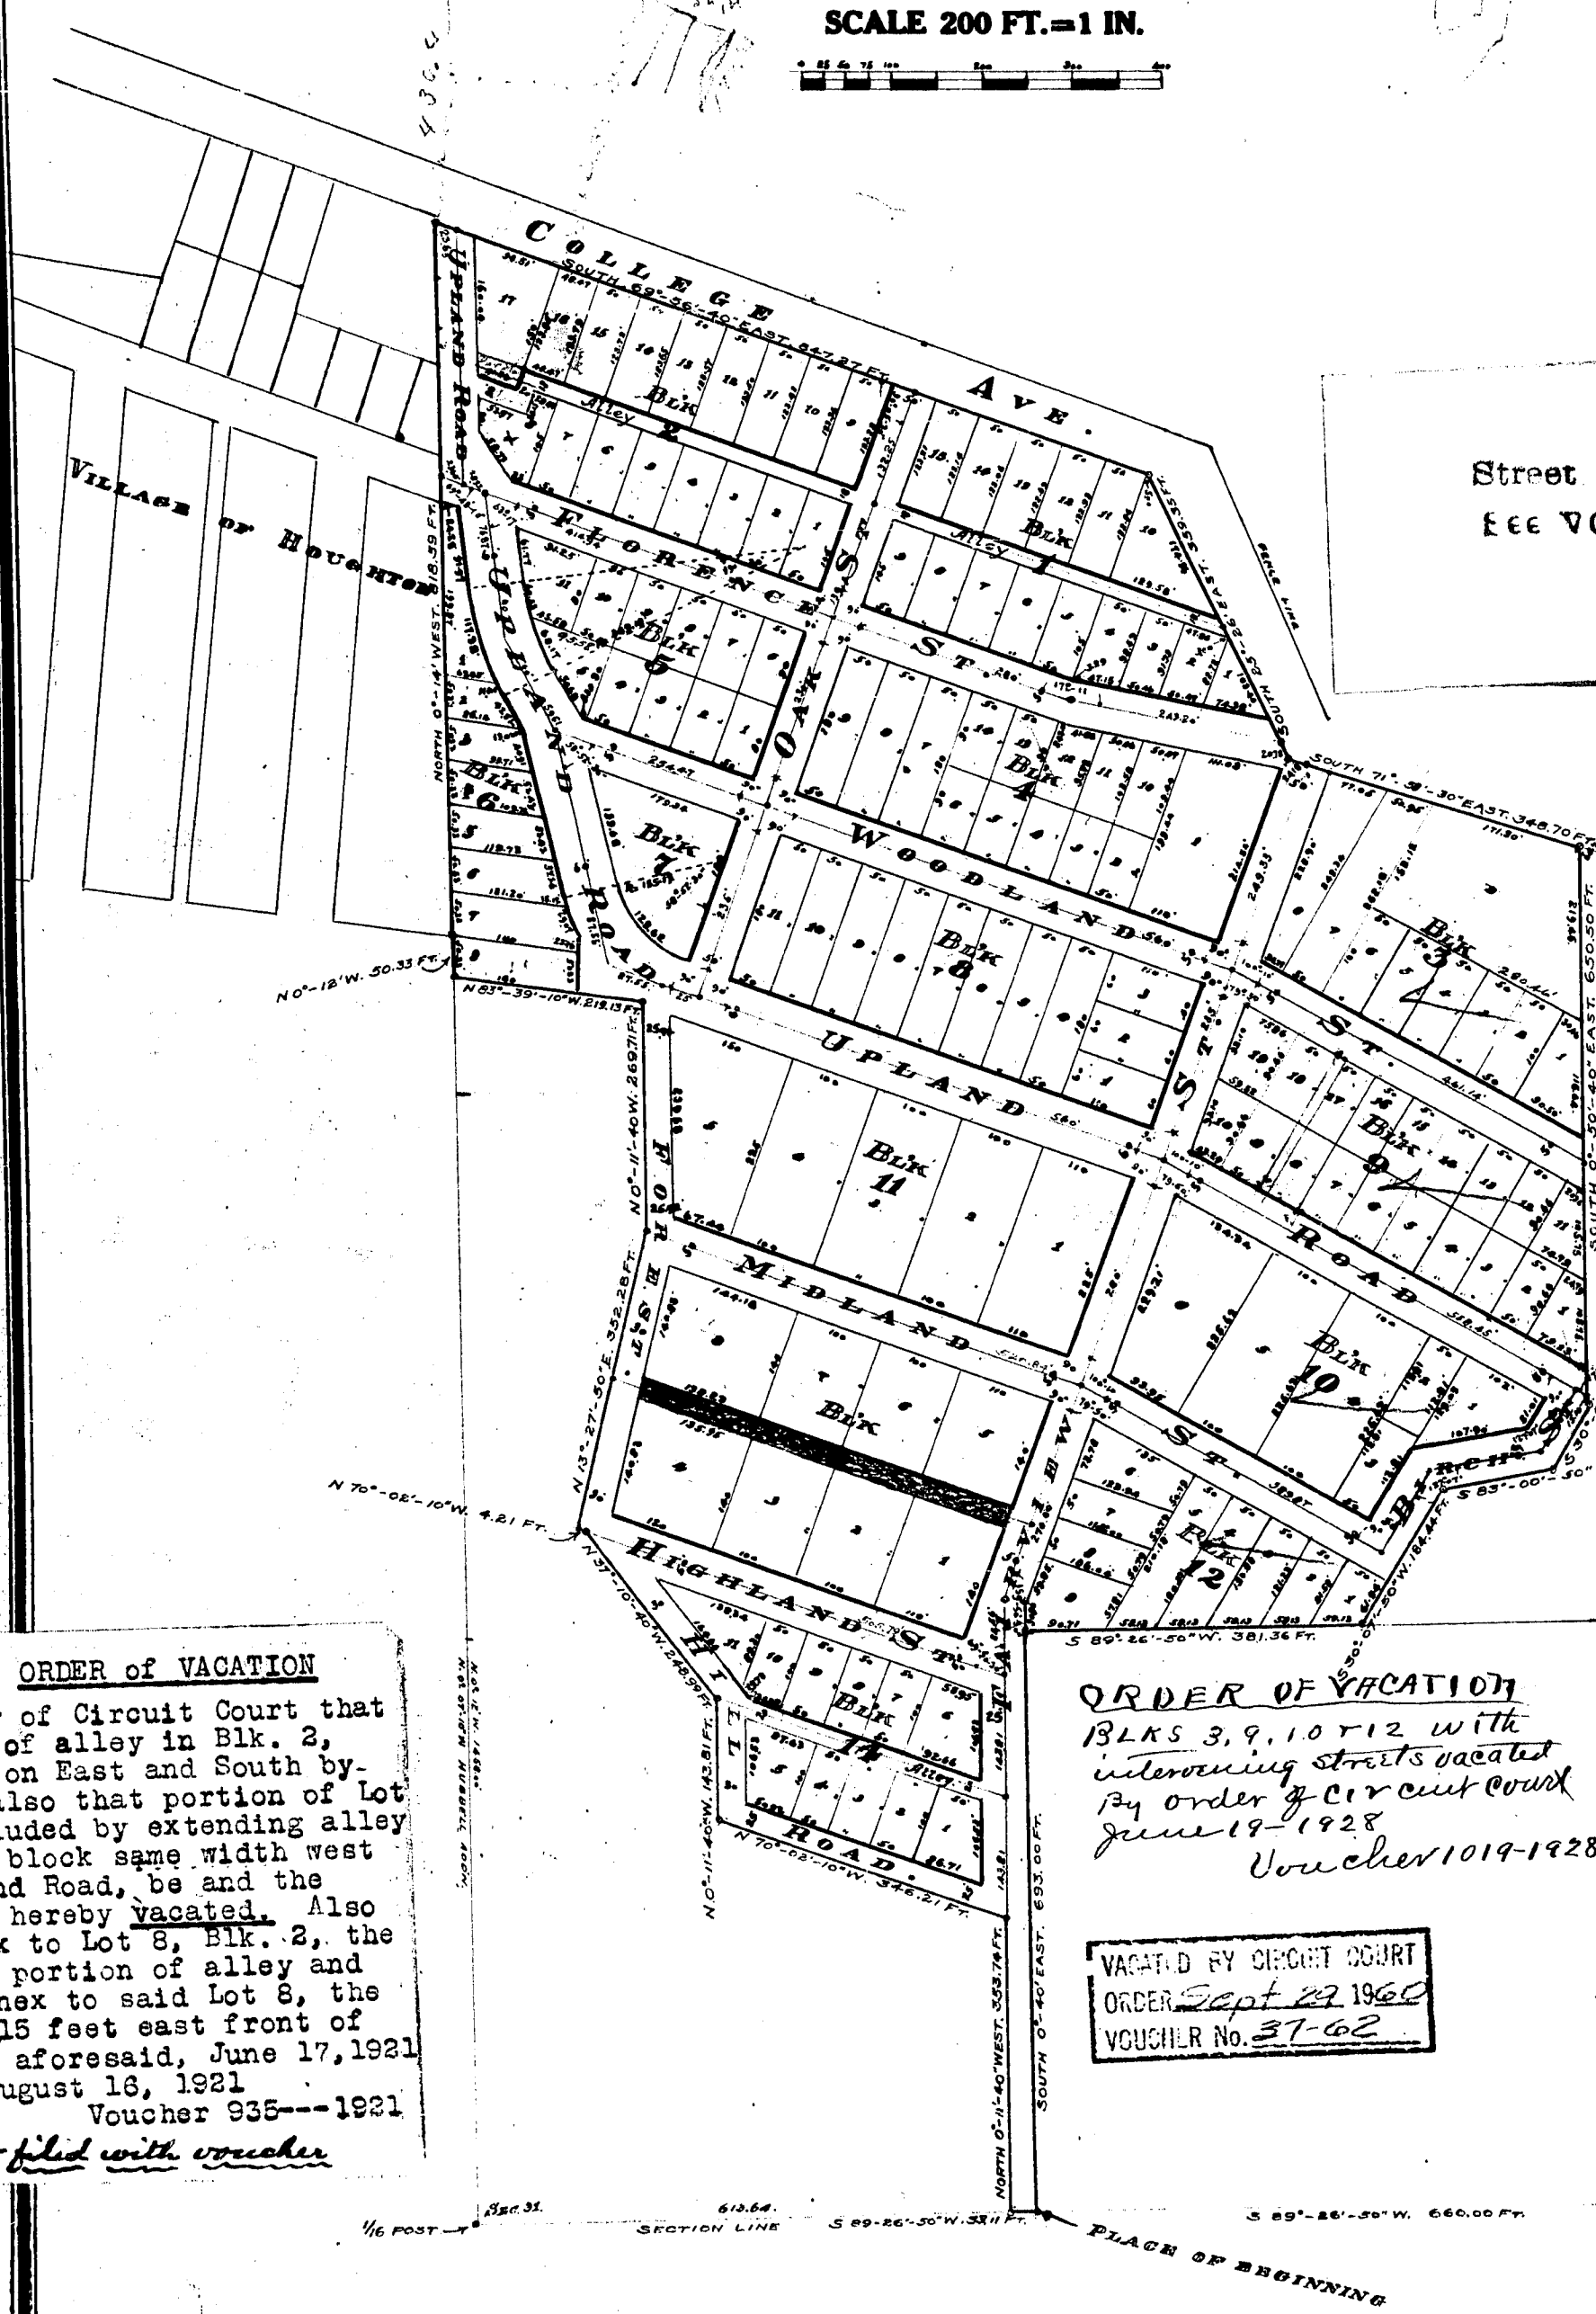

## ORDER of VACATION

By order of Circuit Court that portion of alley in Blk. 2, bounded on East and South by Lot 8; also that portion of Lot 17, included by extending alley in said block same width west to Upland Road, be and the same is hereby vacated. Also to annex to Lot 8, Blk. 2, the vacated portion of alley and also annex to said Lot 8, the South 815 feet east front of Lot 17, aforesaid, June 17, 1921. Filed August 18, 1921. Voucher 935---1921

Replat filed with voucher

## ORDER of VACATION


VACATED BY CIRCUIT COURT  
VOUCHER No. 37-62

RECEIVED AND FILED  
IN AUDITOR GENERAL'S OFFICE  
JAN 9-1909  
J. H. Thompson  
Deputy Auditor General  
Signed MAR 12 1909

## DEDICATION

KNOW ALL MEN BY THESE PRESENTS, That, Fredric W. Nichols, Trustee, has caused the land embraced in the annexed plat to be surveyed, laid out and platted, to be known as "PARK ADDITION TO THE VILLAGE OF HOUGHTON, MICHIGAN," and that the streets and alleys as shown on said plat are hereby dedicated to the use of the public.

IN WITNESS WHEREOF, I have hereunto set my hand this 10th day of December A. D. 1908.

WITNESS:-

Mabel L. Richter  
Mabel L. Richter

Fredric W. Nichols

State of Michigan,  
County of Houghton.

Trustee [L.S.]  
Proprietor, owner of legal title with authority to make plat and dedication and to convey.

## ACKNOWLEDGEMENT

On this 10th day of December A. D. 1908, before me a Notary Public in and for said County, personally came the above named Fredric W. Nichols, Trustee, personally known to me to be the person who executed the above dedication and acknowledged the same to be his free act and deed.

Mabel L. Richter  
Notary Public,  
Houghton Co., Mich.

My commission expires March 10 A. D. 1910.

## DESCRIPTION

From the South Quarter-post of Section 31, T. 55, N. R. 33 W., go South Eighty-nine Degrees, Twenty-six Minutes and Fifty Seconds, West [S. 89° 26' 50" W.], true meridian, along the section line, Six Hundred Sixty Feet [660.00] to the place of beginning, thence South, Eighty-nine Degrees, Twenty-six Minutes and Fifty Seconds, West [S. 89° 26' 50" W.] along section line Thirty-three and Eleven Hundredths [33.11] Ft., thence North, No Degrees, Eleven Minutes and Forty Seconds, West [N. 0° 11' 40" W.], Three Hundred Fifty-three and Seventy-four Hundredths [353.74] Ft., thence North, Seventy Degrees, Two Minutes and Ten Seconds, West [N. 70° 02' 10" W.], Three Hundred Forty-six and Twenty-one Hundredths [346.21] Ft., thence North, No Degrees, Eleven Minutes and Forty Seconds, West [N. 0° 11' 40" W.], One Hundred Forty-three and Eighty-one Hundredths [143.81] Ft., thence North, Thirty-seven Degrees, Ten Minutes and Forty Seconds, West [N. 37° 10' 40" W.], Two Hundred Forty-eight and Ninety-nine Hundredths [248.99] Ft., thence North, Seventy Degrees, Two Minutes and Ten Seconds, West [N. 70° 02' 10" W.], Four and Twenty-one Hundredths [4.21] Ft., thence North, Thirteen Degrees, Twenty-seven Minutes and Fifty Seconds, East [N. 13° 27' 50" E.], Three Hundred Fifty-two and Twenty-eight Hundredths [352.28] Ft., thence North, No Degrees, Eleven Minutes and Forty Seconds, West [N. 0° 11' 40" W.], Two Hundred Sixty-nine and Seventy-one Hundredths [269.71] Ft., thence North, Eighty-three Degrees, Thirty-nine Minutes and Ten Seconds, West [N. 83° 39' 10" W.], Two Hundred Nineteen and Thirteen Hundredths [219.13] Ft., thence North, No Degrees and Twelve Minutes, West [N. 0° 12' W.], Fifty and Thirty-three Hundredths [50.33] Ft., thence North, No Degrees and Fourteen Minutes, West [N. 0° 14' W.], Eight Hundred Eighteen and Fifty-nine Hundredths [818.59] Ft., thence South, Sixty-nine Degrees, Fifty-six Minutes and Forty Seconds, East [S. 69° 56' 40" E.], Eight Hundred Forty-seven and Twenty-seven Hundredths [847.27] Ft., thence South, Twenty-five Degrees and Twenty-six Minutes, East [S. 25° 26' E.], Three Hundred Fifty-nine and Thirty-five Hundredths [359.35] Ft., thence South, Seventy-one Degrees, Fifty-nine Minutes and Thirty Seconds, East [S. 71° 59' 30" E.], Three Hundred Forty-eight and Seven Tenth [348.70] Ft., thence South, No Degrees, Fifty Minutes and Forty Seconds, East [S. 0° 50' 40" E.], Six Hundred Fifty and Five Tenth [650.50] Ft., thence South, Thirty Degrees, Seven Minutes and Fifty Seconds, West [S. 30° 07' 50" W.], Eighty-seven and Nine Tenth [87.90] Ft., thence South, Eighty-three Degrees, No Minutes, and Fifty Seconds, West [S. 83° 00' 50" W.], One Hundred Twenty-seven and Nine Tenth [127.90] Ft., thence South, Thirty Degrees, Seven Minutes and Fifty Seconds, West [S. 30° 07' 50" W.], One Hundred Eighty-four and Forty-four Hundredths [184.44] Ft., thence South, Eighty-nine Degrees, Twenty-six Minutes and Fifty Seconds, West [S. 89° 26' 50" W.], Three Hundred Eighty-one and Thirty-six Hundredths [381.36] Ft., thence South, No Degrees and Forty Minutes, East [S. 0° 40' E.], Six Hundred Ninety-three [693.00] Ft., to the place of beginning.

## SURVEYOR'S CERTIFICATE

I hereby certify that the plat hereon delineated is a correct one and that permanent monuments consisting of 3/8" round iron pins, set in concrete in six (6) inch tile pipe, two feet long have been placed at all points marked thus O, as thereon shown at the angles in the boundaries of the land platted, and at all intersections of streets or streets and alleys.

J. H. Thompson  
Surveyor.

## AUDITOR GENERAL

Examined and approved. Jan 7th A. D. 1909.

John F. Wickham  
Auditor General.

## TREASURER'S CERTIFICATE

I hereby certify that I have examined the records in my office relating to description of lands in the within dedication and from such examination it appears that the state and county taxes have been fully paid for the five years preceding the date of said dedication.

J. H. Thompson  
County Treasurer.

## REGISTER'S CERTIFICATE

State of Michigan,  
County of Houghton.

Houghton, Mich., Dec. 30, A. D. 1908.  
I hereby certify that the certificate required by Sec. No. 135 of Act No. 206 of the Public Acts of 1893 was presented to me at the same time said dedication was presented.

Clyde S. Mackenzie  
Register.

Register's Office  
Houghton Co., Mich.

Received for record this 30th day of December A. D. 1908, at 3:30 o'clock P. M.  
and recorded in Vol. 2, of Plats, page 18.

Clyde S. Mackenzie  
Register.

State of Michigan,  
County of Houghton.

We, Clyde S. Mackenzie, Register and H. W. Fesing, Surveyor, hereby certify that we have each carefully compared this copy with the original Plat of PARK ADDITION TO THE VILLAGE OF HOUGHTON, MICH., and that it is an exact copy thereof and of the whole of such original plat.

Clyde S. Mackenzie  
Register.  
H. W. Fesing  
Surveyor.

State of Michigan,  
County of Houghton.

We, Clyde S. Mackenzie, Register and H. W. Fesing, Surveyor, hereby certify that we have each carefully compared the annexed copy with the plat of PARK ADDITION TO THE VILLAGE OF HOUGHTON, MICH., now of record in the office of said Register, and that it is a true transcript therefrom and of the whole of such record.

Clyde S. Mackenzie  
Register.  
H. W. Fesing  
Surveyor.

# PARK ADDITION


TO THE

## VILLAGE OF HOUGHTON, MICH.


Portions of Lot 6 and S. E. 1/4 of S. W. 1/4 of  
Sec. 31, T. 55, N. R. 33 W.

SCALE 200 FT.=1 IN.

1" = 200 FT.

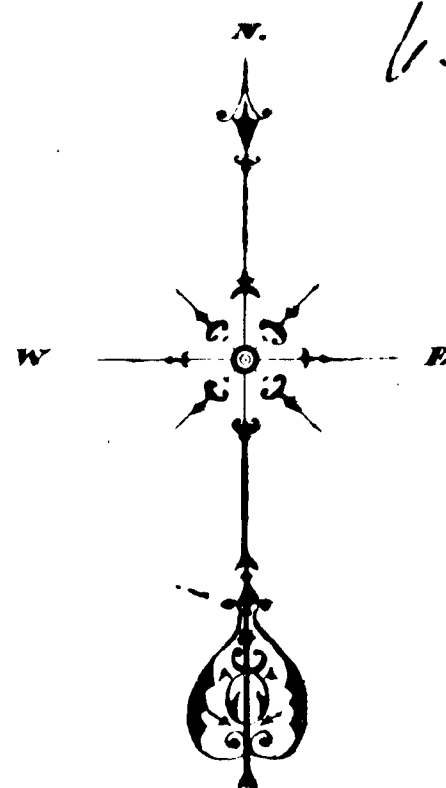

Street On PLAT VACATED  
IN VOL 2 OF VACATED  
PAGE 67

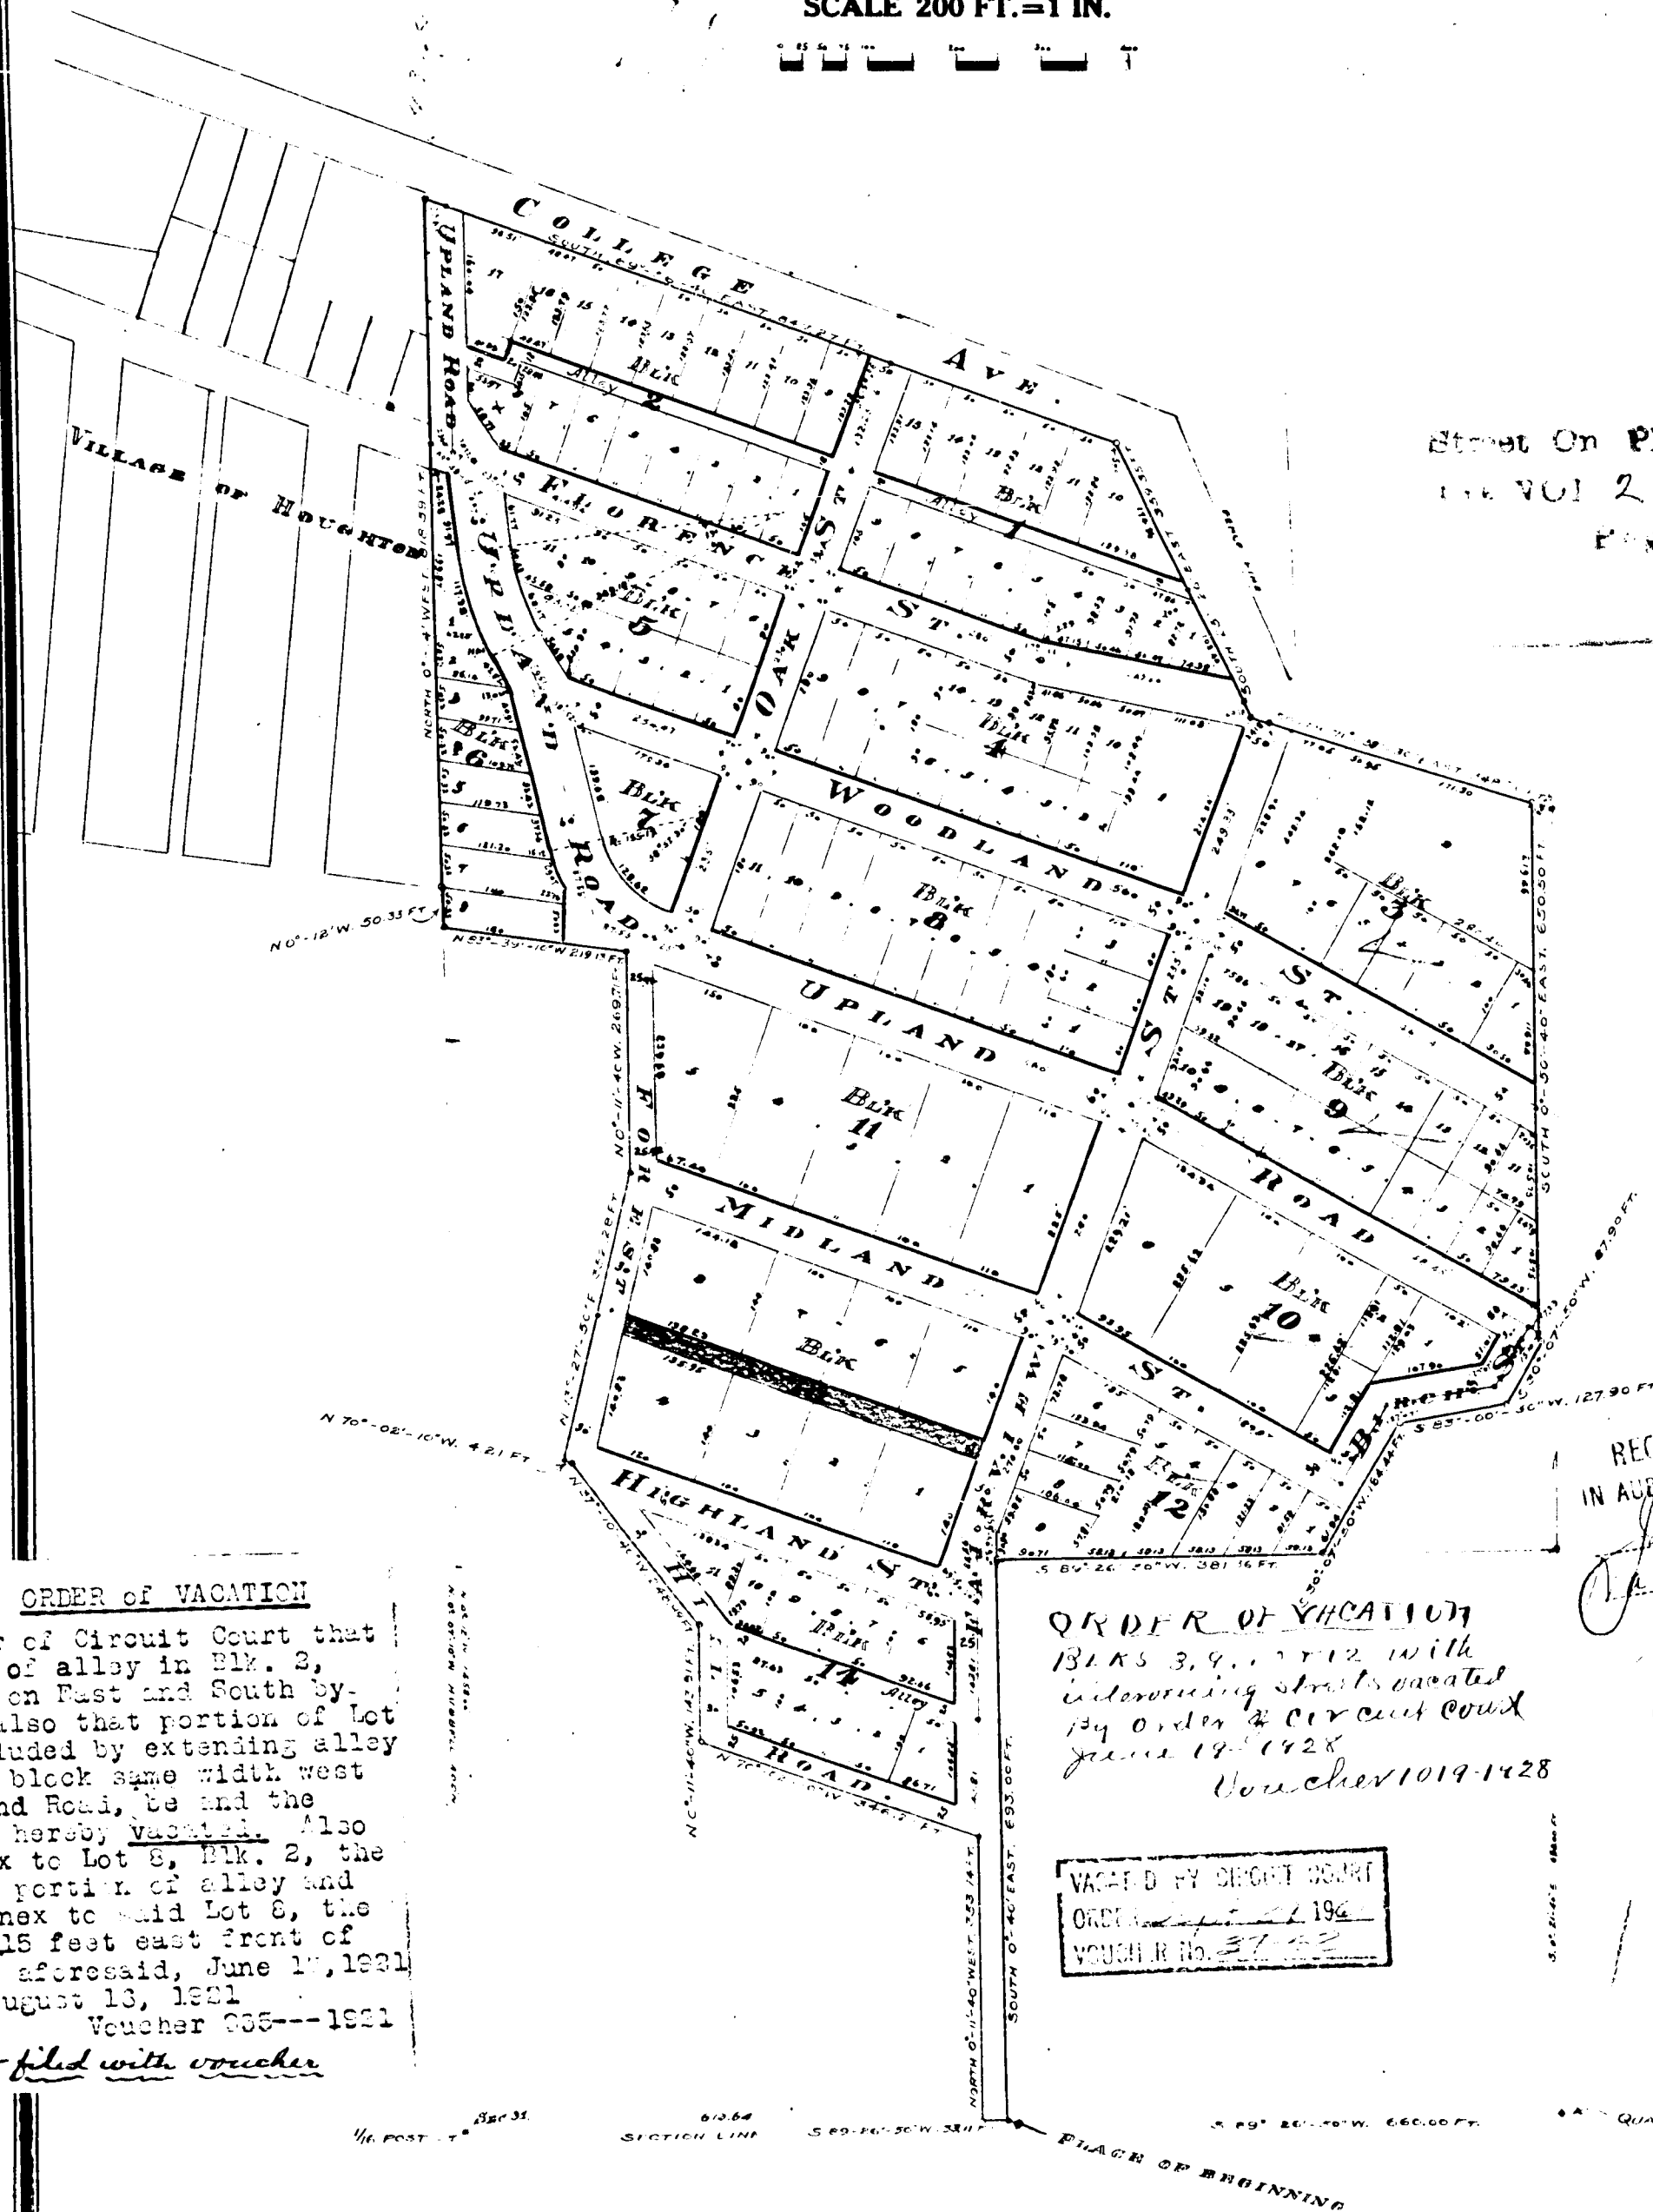

### ORDER OF VACATION

By order of Circuit Court that portion of alley in Blk. 2, bounded on East and South by Lot 8, also that portion of Lot 17, included by extending alley in said block same width west to Upland Road, be and the same is hereby vacated. Also to annex to Lot 8, Blk. 2, the vacated portion of alley and also annex to said Lot 8, the South 815 feet east front of Lot 17, aforesaid, June 17, 1921 Filed August 13, 1921 Voucher 636--1921

Replat filed with voucher

ORDER OF VACATION  
Voucher 1019-1928

VACATED BY CIRCUIT COURT  

RECEIVED AND FILED  
IN AUDITOR GENERAL'S OFFICE  
J. H. Fesing  
Auditor General  
MAR 12 1909

### DEDICATION

KNOW ALL MEN BY THESE PRESENTS, That, Fredric W. Nichols, Trustee, has caused the land embraced in the annexed plat to be surveyed, laid out and platted, to be known as "PARK ADDITION TO THE VILLAGE OF HOUGHTON, MICHIGAN," and that the streets and alleys as shown on said plat are hereby dedicated to the use of the public.

IN WITNESS WHEREOF, I have hereunto set my hand this 10th day of December, A. D. 1908.

WITNESS:-

Mabel H. Fesing  
Houghton Co., Mich.

Fredric W. Nichols  
Trustee [L. S.]  
Proprietor, owner of legal title with authority to make  
plat and dedication and to convey.

State of Michigan,  
County of Houghton.

### ACKNOWLEDGEMENT

On this 11th day of December, A. D. 1908, before me a Notary Public in and for said County, personally came the above named Fredric W. Nichols, Trustee, personally known to me to be the person who executed the above dedication and acknowledged the same to be his free act and deed.

Mabel H. Fesing  
Notary Public,  
Houghton Co., Mich.

My commission expires March 10, A. D. 1912.

### DESCRIPTION

From the South Quarter-post of Section 31, T. 55, N. R. 33 W., go South Eighty-nine Degrees, Twenty-six Minutes and Fifty Seconds, West [S. 89° 26' 50" W.], true meridian, along the section line, Six Hundred Sixty Feet [660.00] to the place of beginning, thence South, Eighty-nine Degrees, Twenty-six Minutes and Fifty Seconds, West [S. 89° 26' 50" W.], along section line Thirty-three and Eleven Hundredths [33.11] Ft., thence North, No Degrees, Eleven Minutes and Forty Seconds, West [N. 0° 11' 40" W.], Three Hundred Fifty-three and Seventy-four Hundredths [353.74] Ft., thence North, Seventy Degrees, Two Minutes and Ten Seconds, West [N. 70° 02' 10" W.], Three Hundred Forty-six and Twenty-one Hundredths [346.21] Ft., thence North, No Degrees, Eleven Minutes and Forty Seconds, West [N. 0° 11' 40" W.], One Hundred Forty-three and Eighty-one Hundredths [143.81] Ft., thence North, Thirty-seven Degrees, Ten Minutes and Forty Seconds, West [N. 37° 10' 40" W.], Two Hundred Forty-eight and Ninety-nine Hundredths [248.99] Ft., thence North, Seventy Degrees, Two Minutes and Ten Seconds, West [N. 70° 02' 10" W.], Four and Twenty-one Hundredths [4.21] Ft., thence North, Thirteen Degrees, Twenty-seven Minutes and Fifty Seconds, East [N. 13° 27' 50" E.], Three Hundred Fifty-two and Twenty-eight Hundredths [352.28] Ft., thence North, No Degrees, Eleven Minutes and Forty Seconds, West [N. 0° 11' 40" W.], Two Hundred Sixty-nine and Seventy-one Hundredths [269.71] Ft., thence North, Eighty-three Degrees, Thirty-nine Minutes and Ten Seconds, West [N. 83° 39' 10" W.], Two Hundred Nineteen and Thirteen Hundredths [219.13] Ft., thence North, No Degrees and Twelve Minutes, West [N. 0° 12' W.], Fifty and Thirty-three Hundredths [50.33] Ft., thence North, No Degrees and Fourteen Minutes, West [N. 0° 14' W.], Eight Hundred Eighteen and Fifty-nine Hundredths [818.59] Ft., thence South, Sixty-nine Degrees, Fifty-six Minutes and Forty Seconds, East [S. 69° 56' 40" E.], Eight Hundred Forty-seven and Twenty-seven Hundredths [847.27] Ft., thence South, Twenty-five Degrees and Twenty-six Minutes, East [S. 25° 26' E.], Three Hundred Fifty-nine and Thirty-five Hundredths [359.35] Ft., thence South, Seventy-one Degrees, Fifty-nine Minutes and Thirty Seconds, East [S. 71° 59' 30" E.], Three Hundred Forty-eight and Seven Tenths [348.70] Ft., thence South, No Degrees, Fifty Minutes and Forty Seconds, East [S. 0° 50' 40" E.], Six Hundred Fifty and Five Tenths [650.50] Ft., thence South, Thirty Degrees, Seven Minutes and Fifty Seconds, West [S. 30° 07' 50" W.], Eighty-seven and Nine Tenths [87.90] Ft., thence South, Eighty-three Degrees, No Minutes, and Fifty Seconds, West [S. 83° 00' 50" W.], One Hundred Twenty-seven and Nine Tenths [127.90] Ft., thence South, Thirty Degrees, Seven Minutes and Fifty Seconds, West [S. 30° 07' 50" W.], One Hundred Eighty-four and Forty-four Hundredths [184.44] Ft., thence South, Eighty-nine Degrees, Twenty-six Minutes and Fifty Seconds, West [S. 89° 26' 50" W.], Three Hundred Eighty-one and Thirty-six Hundredths [381.36] Ft., thence South, No Degrees and Forty Minutes, East [S. 0° 40' E.], Six Hundred Ninety-three [693.00] Ft., to the place of beginning.

### SURVEYOR'S CERTIFICATE

I hereby certify that the plat hereon delineated is a correct one and that permanent monuments consisting of 3/4" round iron pins, set in concrete in six (6) inch tile pipe, two feet long have been placed at all points marked thus O, as thereon shown at the angles in the boundaries of the land platted, and at all intersections of streets or streets and alleys.

J. H. Fesing  
Surveyor.

### AUDITOR GENERAL

Examined and approved, Dec 26, A. D. 1908.

John F. Wickham  
Auditor General.

### TREASURER'S CERTIFICATE

I hereby certify that I have examined the records in my office relating to description of lands in the within dedication and from such examination it appears that the state and county taxes have been fully paid for the five years preceding the date of said dedication.

Jessie J. Foley  
County Treasurer.

### REGISTER'S CERTIFICATE

State of Michigan,  
County of Houghton.

Houghton, Mich., Dec 30, A. D. 1908.  
I hereby certify that the certificate required by Sec. No. 135 of Act No. 206 of the Public Acts of 1893 was presented to me at the same time said dedication was presented.

Clyde S. Mackenzie  
Register.

Register's Office  
Houghton Co., Mich.

Received for record this 30th day of December, A. D. 1908, at 3:30 o'clock P. M.

Clyde S. Mackenzie  
Register.

State of Michigan,  
County of Houghton.

We, Clyde S. Mackenzie, Register and H. W. Fesing, Surveyor, hereby certify that we have each carefully compared this copy with the original Plat of PARK ADDITION TO THE VILLAGE OF HOUGHTON, MICH., and that it is an exact copy thereof and of the whole of such original plat.

Clyde S. Mackenzie  
Register.  
H. W. Fesing  
Surveyor.

State of Michigan,  
County of Houghton.

We, Clyde S. Mackenzie, Register and H. W. Fesing, Surveyor, hereby certify that we have each carefully compared the annexed copy with the plat of PARK ADDITION TO THE VILLAGE OF HOUGHTON, MICH., now of record in the office of said Register, and that it is a true transcript thereof and of the whole of such record.

Clyde S. Mackenzie  
Register.  
H. W. Fesing  
Surveyor.

PLAT - PARK ADDITION TO THE VILLAGE OF HOUGHTON


In re petition )  
H Stewart Goode )  
ll et al to vac )  
ate part of Plat

ORDERED: That all that portion of MIDLAND STREET being a portion of the town or town plat situated in the said County of Houghton, called and known as the PARK ADDITION, Houghton County, Michigan, according to the plat thereof of record in office of Register of Deeds said County, from the Easterly boundary line of Forest Hill Road as shown upon said plat, to the Westerly boundary line of Fairview Street, as shown upon said plat, being the portion of said Midland Street lying between Block Thirteen(13) and Block Eleven (11) of said Plat and further particularly described as follows:  
All that portion of MIDLAND STREET from the Easterly boundary line of Forest Hill Road to the Westerly boundary line of Fairview Street in the Park Addition, according to the recorded plat of PARK ADDITION of record in office of Register of Deeds of Houghton County, Michigan, be and the same is hereby VACATED. Further ORDERED that the same be attached to the lots grounds included in said plat and bordering on the said portion of Midland Street and the same being land included in said plat on opposite sides of portion of said Midland Street and that the title to said portion of said Midland Street so vacated, as aforesaid, shall and does hereby vest in the persons owning the property on each side thereof to the center of said portion of said Midland Street.

Order of Judge Patrick H.O'Brien  
November 4, 1912-Cal No. 3865

And Gen Dept Vol. 190/72  
Page 6347/14060 ✓

Eddy & Bennett  
Plat Examiners  
September 1915

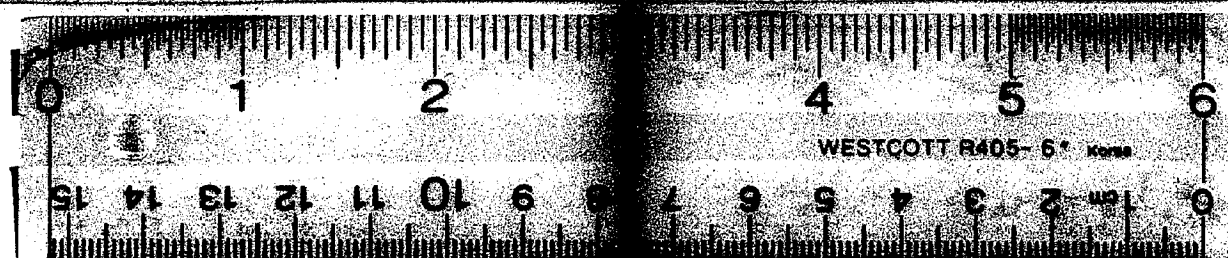

16 X