

RECEIVED AND FILED

In Auditor General's Office

February 20, 1884

Attest

Dep. Aud. Genl.



MAP OF

PHILLIP SIMONS SUBDIVISION



OF Sec. 28, T.14 N.R.5 E.

Bay City, Michigan

Know all men by these presents that I, George Turner, civil engineer and surveyor of Bay City, Bay County, and State of Michigan, on the application and request of Carolina Simon, proprietress of the land described in said plat, and that the same was my free act and deed and that this plat is correct to the best of my knowledge and belief. In testimony whereof I have hereunto set my hand and seal this 24th day of September A.D. 1883.


George Turner
Surveyor and Engineer

Know all men by these presents that I, Carolina Simon, of Bay City, Bay County, Michigan, am the proprietress of the land embraced and described in this plat and that I caused said land to be surveyed and said map or plat to be made by George Turner, civil engineer and surveyor of Bay City, Bay County, Michigan, for the purpose of laying out said land into a subdivision, called Phillip Simon's Subdivision of out lots of James Turner's lot 4 of section 28, Township 14 North, Range 5 East, Bay County, Michigan, and the same is now in force and that I intend the same for the purpose of conveying and uses in said plat or map named, resented and intended and for no other uses or purposes whatever and that the same is my own free act and deed. In testimony whereof I have hereunto set my hand and seal this 24th day of September A.D. 1883.

Carolina Simon
Proprietress

Be it remembered, that on this 24th day of September A.D. 1883, before me, a Notary Public in and for said County of Bay, person, fully appeared Carolina Simon, known to me to be the person who executed the foregoing acknowledgment of this plat and acknowledged the same to be her free act and deed.

Wm. J. Fisher
Notary Public

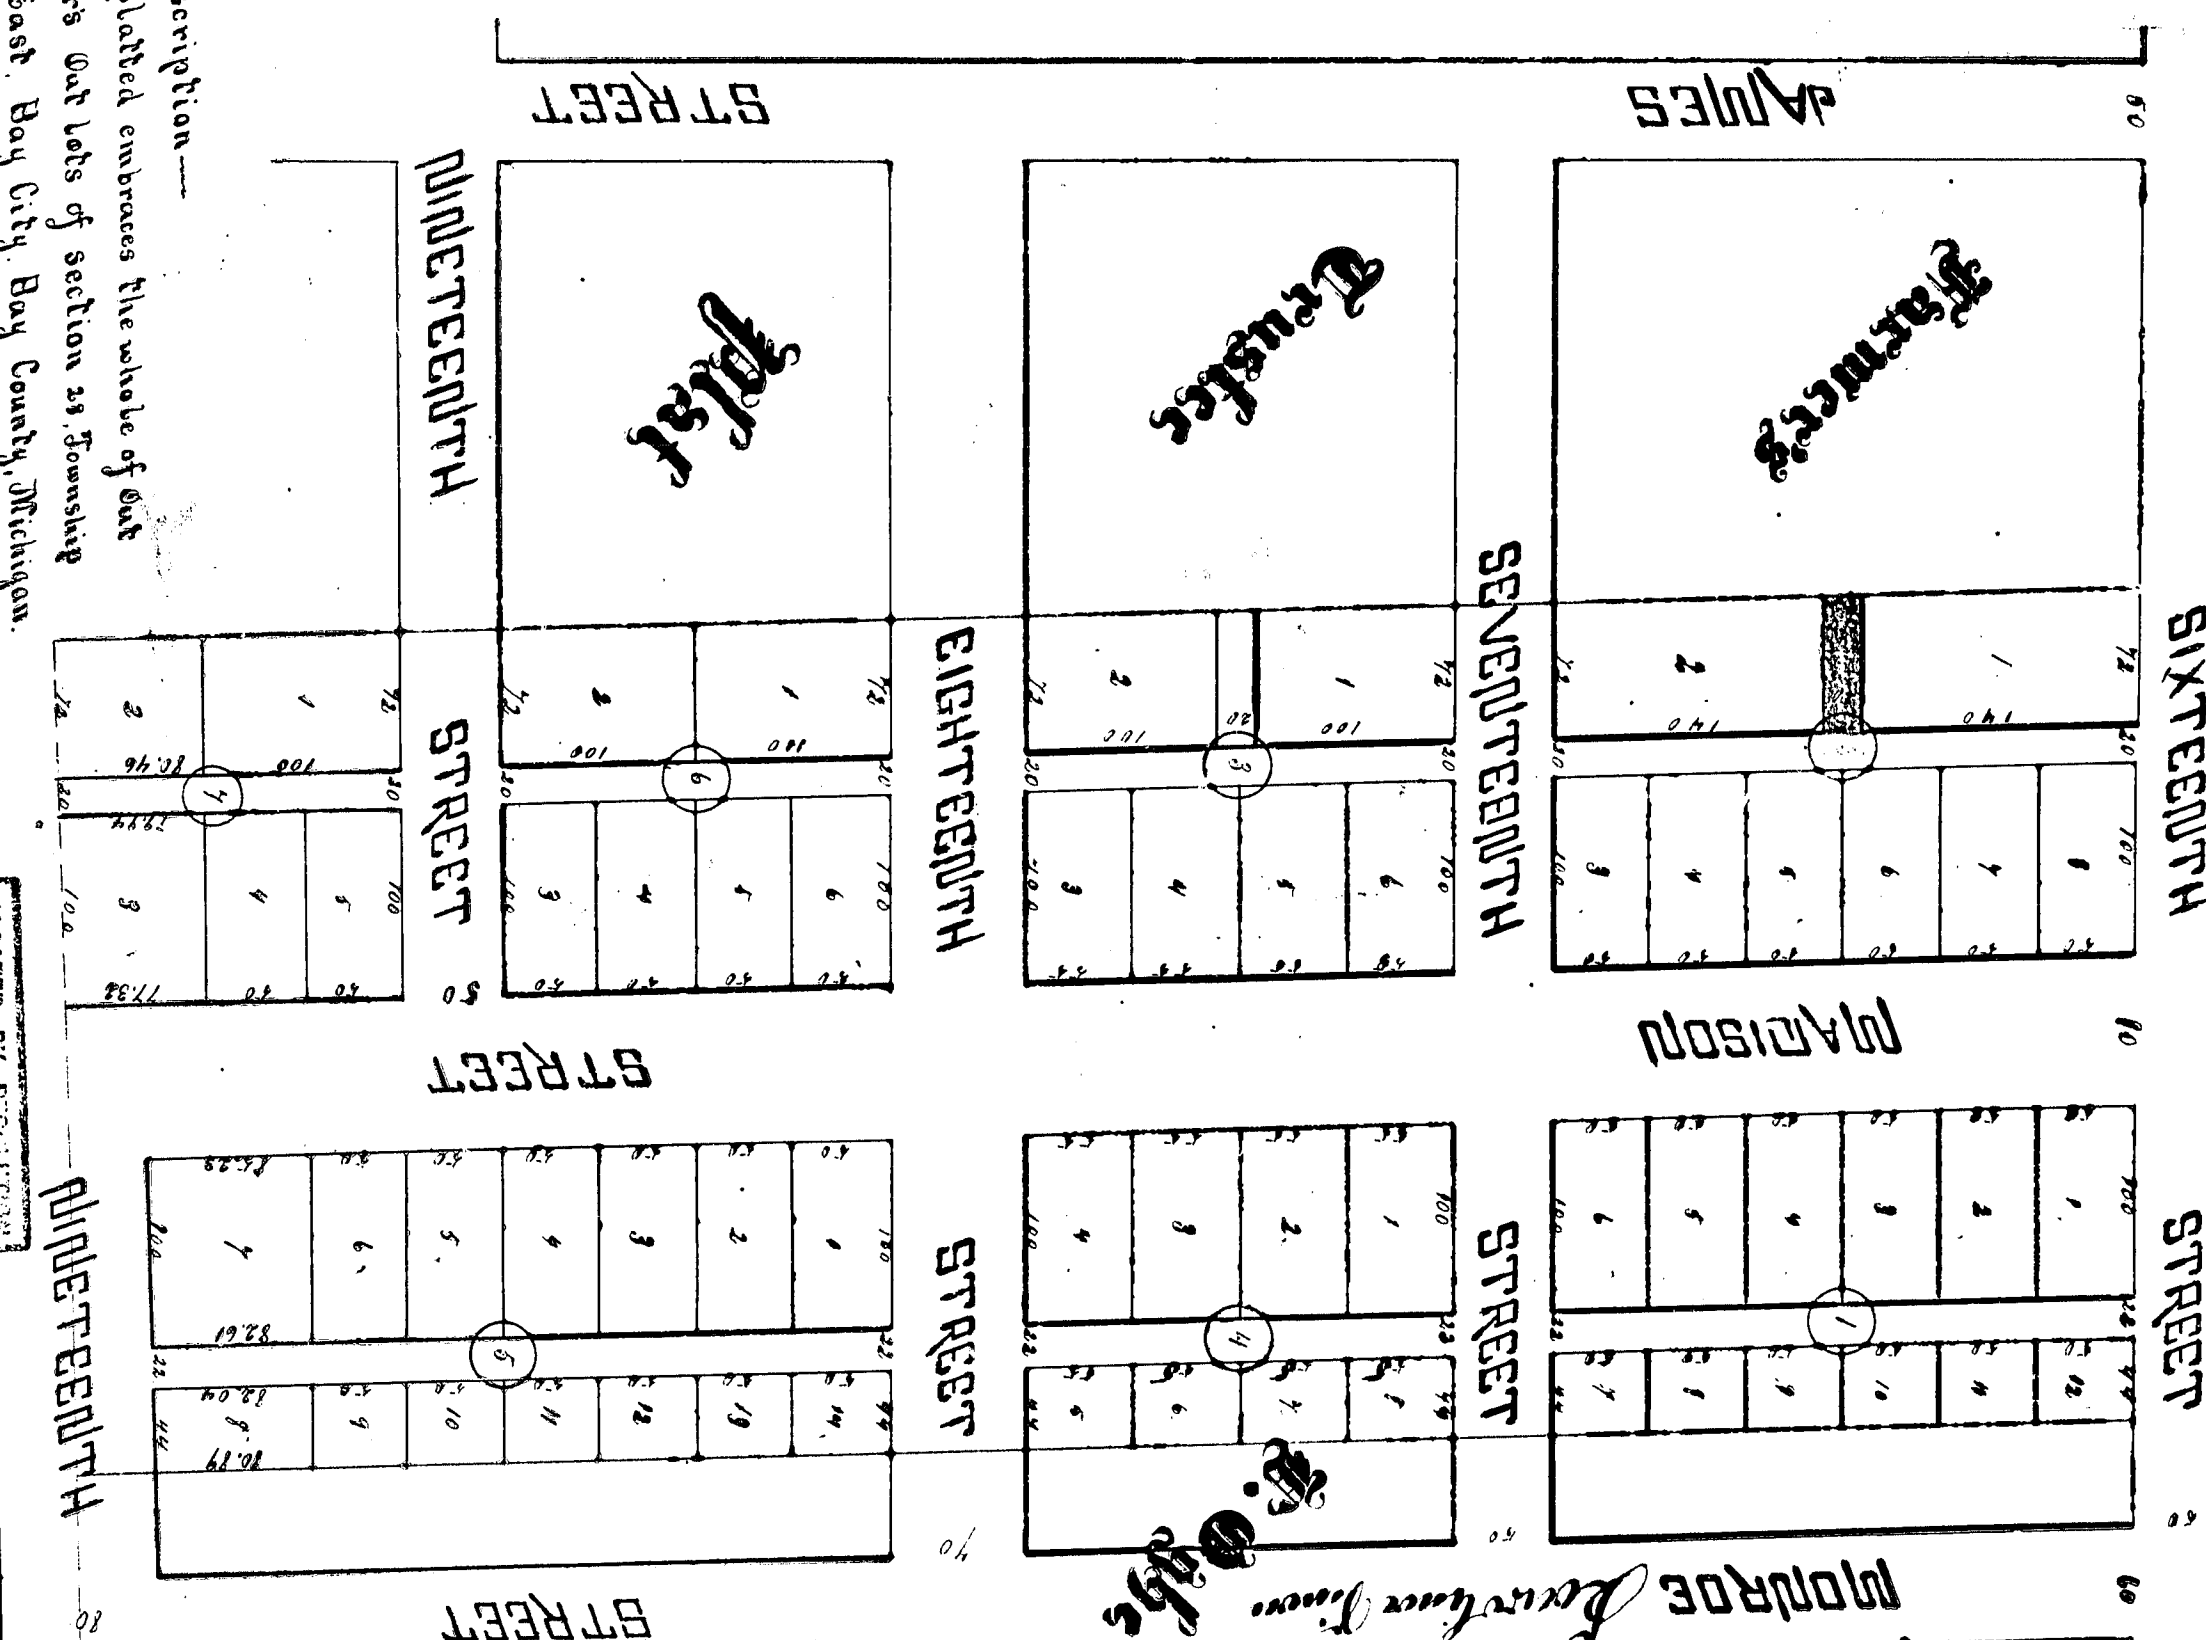

State of Michigan, J. S. S.
County of Bay.
On this 24th day of September A.D. 1883 before me, a Notary Public in and for said County person, personally appeared George Turner, civil engineer and surveyor, known to me to be the same person described in the foregoing certificate and he acknowledged the same to be his free act and deed. In testimony whereof I have hereunto set my hand and affixed my seal this 24th day of September A.D. 1883.

Wm. J. Fisher
Notary Public

Description—
The land here platted embraces the whole of out lot no. 4 of James Turner's out lots of section 28, Township 14 North, Range 5 East, Bay City, Bay County, Michigan.

State of Michigan, J. S. S.
County of Bay.
We, the Board of Supervisors of Bay County, Michigan, do hereby certify that we have carefully compared the annexed plat with the plat of Phillip Simon's Subdivision of out lots of James Turner's out lots of section 28, Township 14 North, Range 5 East, Bay City, Bay County, Michigan, and find it to be a true and correct representation of said lots and it is a true and correct representation of the same.

Wm. J. Fisher
Register of Deeds

Received.
at Bay City, Michigan, on the 24th day of September A.D. 1883.

Wm. J. Fisher
Register

REGISTERED BY REGISTRATION
OFFICE OF THE REGISTER
MAY 7, 1884
RECORDED IN 277-44


The plat of Phillip Simon's Subdivision of out lots of James Turner's out lots of section 28, Township 14 North, Range 5 East, Bay City, Bay County, Michigan, is approved by the Common Council of Bay City, Bay County, Michigan, this 24th day of November A.D. 1883.

Chas. A. B. B. B.
Mayor

Placed on file
L. S. Compiler

RECEIVED AND FILED

In presence of James S. Off. 20
February 20, 1884
Attest
Dep. and Genl.

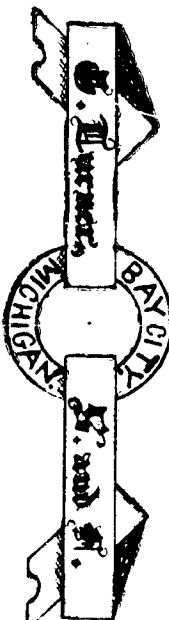

RAP OF

PHILLIP SIMONS' SUBDIVISION



OF Sec. 28, T.14 N. R. 5 E.

Bay City, Michigan.

Know all men by these presents that I, George Turner, civil engineer and surveyor of Bay City, Bay County, and State of Michigan, on the application and request of Carolina Simon, proprietress of the land described in this plat and in the month of August A. D. 1883, survey and plat said land as it appears in said plat, and that the same was my free act and deed and that this plat is correct to the best of my knowledge and belief. In testimony whereof I have hereunto set my hand and seal this 24th day of September A. D. 1883.
George Turner
Surveyor and Engineer





Know all men by these presents that I, Carolina Simon, of Bay City, Bay County, Michigan, am the proprietress of the land embraced and described in this plat and that I caused said land to be surveyed and said map or plat to be made by George Turner, civil engineer and surveyor of Bay City, Bay County, Michigan, for the purpose of laying out said land into a subdivision, called Phillip Simons' Subdivision, of out lots of James Fraser and lots of section 28, Township no. 14 North, Range no. 5 East, Bay County, Michigan, under and by virtue of Chapter 23 of the Compiled Laws of the State of Michigan and the amendments thereto now in force and that I intend the same for the purpose of laying out and uses in said plat or map named, expressed and intended and for no other uses or purposes whatever and that the same is my own free act and deed. In testimony whereof I have hereunto set my hand and seal this 24th day of September A. D. 1883.
Carolina Simon
Proprietress

Be it remembered that on this 24th day of September A. D. 1883 before me, a Notary Public in and for said County of Bay, personally appeared Carolina Simon, known to me to be the person who executed the foregoing acknowledgment of this plat and acknowledged the same to be her free act and deed.
George Turner
Notary Public

State of Michigan)
County of Bay
We the Board
Register of Deeds, and Notary Public, hereby certify that we have carefully compared the annexed plat with the plat of Phillip Simons' Subdivision of section 28, Township no. 14 North, Range no. 5 East, Bay County, Michigan, and find it to be a true and correct copy of the original of said Record, and it is a true and correct copy of the original of said Record.
George Turner
Notary Public

Received.
at Clerk and recorded on page
of Plat Book No.
U.S. Register of Deeds.
Bay County, Michigan.

The plat of Phillip Simons' Subdivision of out lots of section 28, Township no. 14 North, Range no. 5 East, Bay County, Michigan, is approved by the Common Council of Bay City, Bay County, Michigan this 24th day of December A. D. 1883.
Carolina Simon
Owner



CITY OF BAY CITY

BAY CITY, MICHIGAN 48706

Area Code 517 893, 7511

November 7, 1980

Department of Treasury
Bureau of Local Government Services
2nd Floor, Treasury Building
Lansing, Michigan 48922

Gentlemen:

Pursuant to Section 256 of the new Subdivision Act of 267 (Public Act 288), we hereby submit a certified copy of the resolution vacating the N/S alley and the East 50 feet of the E/W alley in the east half of the block bounded by 17th, 18th, Madison and Fitzhugh Streets. The alley is located in Phillip Simons Sub of Out Lot 4 of James Fraser's out lots, also, the Village of Portsmouth.

A sketch from the Planning office which identifies the area is also herewith attached.

Yours very truly,

CITY OF BAY CITY

Walter Wozniak, Jr.
City Clerk

W:ve

enc.

CLB-3c

LIBER 893 PAGE 814

CITY OF BAY CITY, MICH.
OFFICE OF CITY CLERK
(AFFIDAVIT)

STATE OF MICHIGAN
COUNTY OF BAY
CITY OF BAY CITY

TO CORRECT PROPERTY DESCRIPTION LANGUAGE
IN AFFIDAVIT FILED SEPTEMBER 16, 1980.

I, Walter Wozniak, Jr., Clerk of the City of Bay

City, County and State aforesaid, Do hereby Certify, that I have compared the

annexed excerpt from the regular meeting of the City Commission of Bay City

held September 8, 1980

with the original on file in this office and that it is a true and correct transcript therefrom and of the whole of such original.

In Witness Whereof, I have hereunto set my hand affixed the

Corporate Seal of the City of Bay City, Mich., this

17th day of September 1980

Walter Wozniak, Jr.
City Clerk

Of Commission as a Whole:

Whereas, the Planning Commission held a public hearing to consider vacating the N/S alley and the East 50 feet of the E/W alley in the east half of the block bounded by 17th, 18th, Madison and Fitzhugh Streets, and

Whereas, the Planning Commission recommended that same be closed and vacated, and

Whereas, a resolution was adopted by the City Commission on July 28, 1980, ordering publication of notices and the holding of a hearing, said notices having been published in the Bay City Democrat, the official newspaper of the City of Bay City, on August 14, 21, 28 and September 4, 1980, relative to the aforesaid hearing and certified notices thereof having been mailed to the public utilities and abutting property owners, and

Whereas, a public hearing was held by the City Commission on September 8, 1980, relative to the aforesaid petition for said vacation,

Now, Therefore, Be It Resolved And Ordered, by the City Commission that:

The north-south alley and east 50 feet of the east-west alley in the east half of block bounded by 17th, 18th, Madison and Fitzhugh Streets

be and hereby is closed with all utility easements being retained and on condition that no permanent buildings or structures be erected. If fences are erected they must be designed to be readily removable and the cost of removing fences or other obstructions on the utility easement are the responsibility of the property owner and not the utility company.

Rules Suspended


Commissioner Sullivan moved that rules be suspended and Public Hearing be held to permit interested parties to be heard. There was no objection.

Mrs. Delphine Kolat, 820 - 17th, requested that the alley be accessible for the first 50 feet to permit access for Dorothy Hilderbrand and Michael Jaskowski. She requested that a sign be placed next to the utility pole in

deleting that the alley is closed both at 17th and 18th Streets.

Commissioner Gieda moved adoption of resolution including that the request of Mrs. Kolat be granted.

Adopted by the following vote --
Yes, Commissioners Sullivan, Vandervell, Snyder, Gieda, Winters, Teth, Buda, Kleinbaum, 8.
No, None.

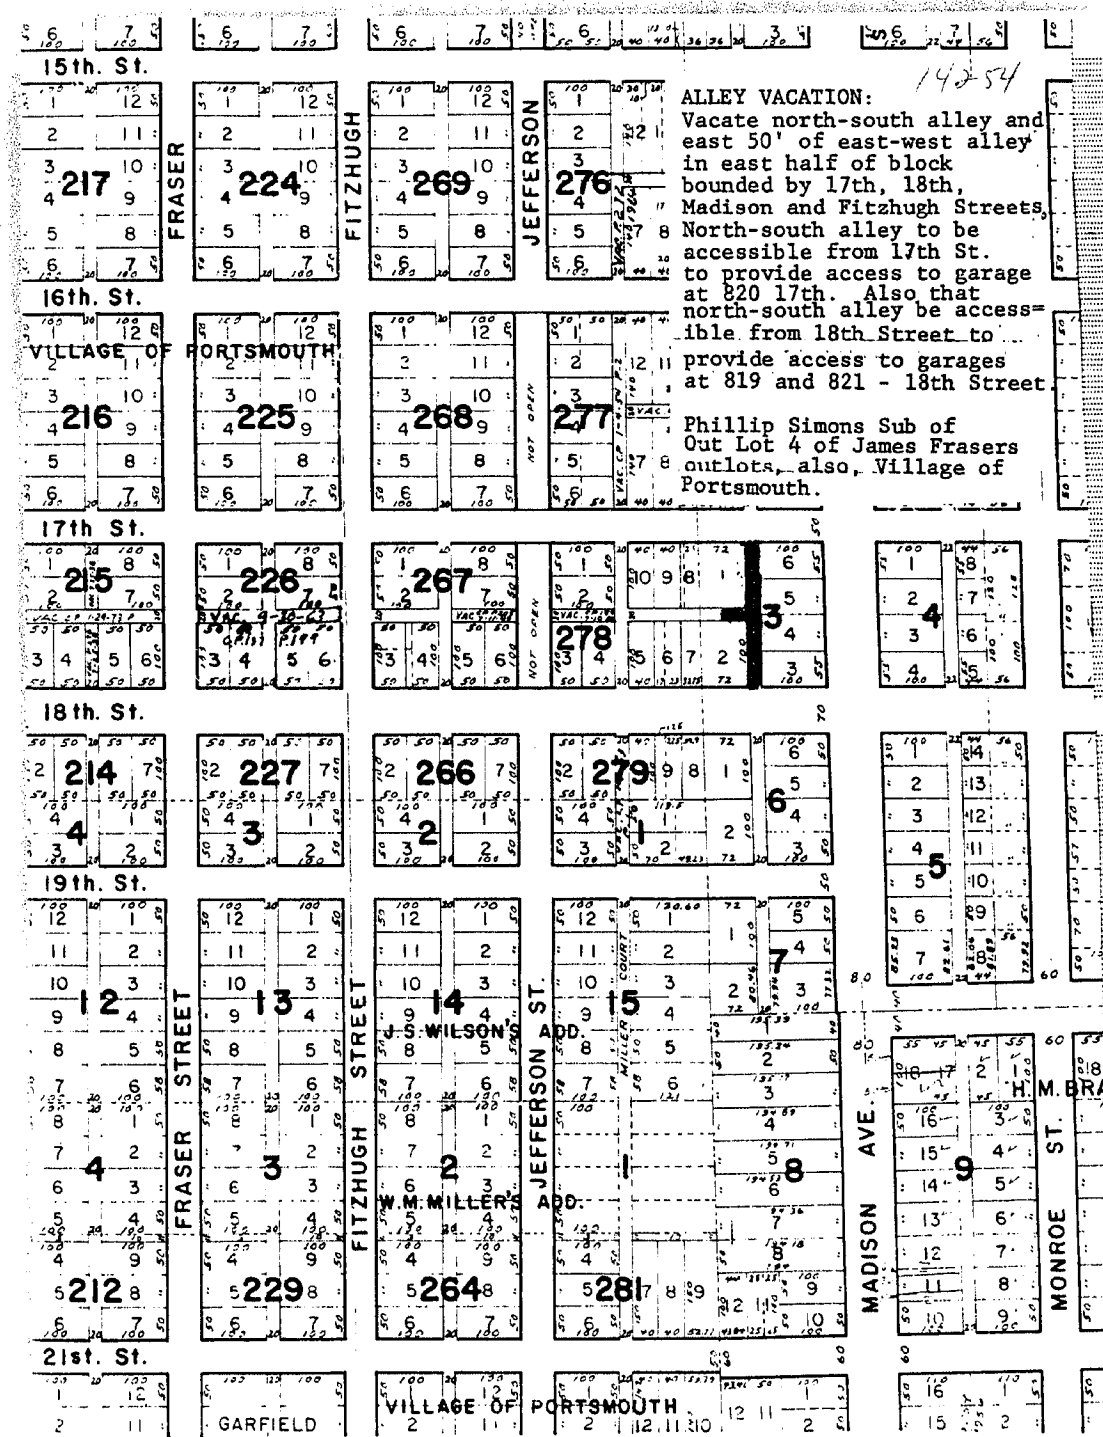

ALLEY VACATION:
Vacate north-south alley and east 50' of east-west alley in east half of block bounded by 17th, 18th, Madison and Fitzhugh Streets. North-south alley to be accessible from 17th St. to provide access to garage at 820 17th. Also that north-south alley be accessible from 18th Street to provide access to garages at 819 and 821 - 18th Street. Phillip Simons Sub of Out Lot 4 of James Fraser's out lots, also, Village of Portsmouth.